

CODE ANALYSIS
 CODE: 2012 International Building Code
 Arkansas Fire Prevention Code

OCCUPANCY TYPES
 TYPE 1 - R-2 RESIDENTIAL GROUP
 TOTAL SQFT 4,168
 TYPE 2 - S-2 STORAGE
 TOTAL SQFT 4,183

BUILDING CONSTRUCTION
 CONSTRUCTION: TYPE VB
 SPINKLED

ALLOWABLE SQ FT
 (BASED ON R-2 OCCUPANCY,
 MOST STRINGENT) 7000 SQ FT

Allowable Building Square Footage Increase Calculations:
 $Aa = \{ At + [At \times If] + [At \times Is] \}$
 $Aa = \{ 7,000 + [7,000 \times .75] + [7,000 \times 2] \}$
 $Aa = 7,000 + 5,250 + 14,000$
 $Aa = 26,250$

ACTUAL BUILDING SQUARE FOOTAGE:
 8,350 SQ FT < 26,250 SQ FT ALLOWABLE

ACTUAL BUILDING HEIGHT:
 26'-8" < 40'-0" ALLOWABLE HEIGHT

FIRE SEPARATION BETWEEN USES
 Station to Apparatus:
 2 hr fire barrier requirement with 1 hr reduction for sprinkler system.

1 HOUR RATED ASSEMBLY
 UL #U364 ABOVE UL #U305 ABOVE UL #U905

Battalion to Apparatus:
 2 hr fire barrier requirement with 1 hr reduction for sprinkler system.

1 HOUR RATED ASSEMBLY
 UL #U305 ABOVE UL #U905

OCCUPANCY LOADS & EGRESS:
 STATION
 3650 SQ FT / 200 = 19 PEOPLE
 (0.27) X (19 PPL) = 3.8" < 108" ACTUAL EGRESS
 APPARATUS:
 4,183 SQ FT / 200 = 21 PEOPLE
 (0.27) X (21 PPL) = 4.2" < 108" ACTUAL EGRESS
 BATTALION:
 518 SQ FT / 200 = 3 PEOPLE
 (0.27) X (3 PPL) = .6" < 36" ACTUAL EGRESS

Travel Distances (Sprinkled) 250 ft
 Actual Farthest Distance 75 ft

PLUMBING COUNTS
 STATION
 Occupancy 19 PEOPLE
 Req'd Toilets & Lav (1 per 10) 2
 Actual Toilets & Lav 3
 Req'd Showers (1 per 8) 3
 Actual Showers 3
 Drinking Fountain 1
 Service Sink 1

FEC CALCULATIONS
 Max Floor Area/Extinguisher 11,250 SQFT
 Extinguishers Required 1
 Actual FECs 3
 Max travel Distance 75'

NORTH LITTLE ROCK FIRE DEPARTMENT STATION 8


LOCATION

CIVIL	STRUCTURAL	ARCHITECTURAL	ELECTRICAL	FIRE PROTECTION	PLUMBING
C100 DEMOLITION PLAN	S1.0 GENERAL NOTES & SCHEDULES	A100 SITE PLAN	E100 ELECTRICAL POWER AND LIGHTING LEGEND	FP100 FIRE PROTECTION NOTES AND DETAIL	P100 PLUMBING NOTES, SCHEDULES, AND LEGENDS
C200 SITE PLAN	S1.1 INSPECTION TABLE, & FOUNDATION DETAILS	A101 PLAN	E201 ELECTRICAL SITE PLAN	FP101 FIRE PROTECTION FLOOR PLAN	P101 PLUMBING SITE PLAN
C300 GRADING PLAN	S1.2 FOUNDATION PLAN	A102 RCP	E301 ELECTRICAL LIGHTING PLAN- APPARATUS BAY		P201 SANITARY WASTE PLAN- APPARATUS BAY
C400 UTILITY PLAN	S2.1 FOUNDATION DETAILS	A107 ROOF PLAN	E302 ELECTRICAL LIGHTING PLAN- FIRE HOUSE	MECHANICAL	P202 SANITARY WASTE PLAN- FIRE HOUSE
C500 EROSION CONTROL PLAN	S2.1 FOUNDATION DETAILS	A108 ROOF DETAILS	E303 ELECTRICAL LIGHTING PLAN- MEZZANINE	M100 MECHANICAL NOTES AND LEGENDS	P301 WATER/GAS PLAN- APPARATUS BAY
C501 EROSION CONTROL DETAILS	S3.1 ROOF & MEZZANINE FRAMING PLAN	A201 OVERALL ELEVATIONS	E401 ELECTRICAL POWER PLAN- APPARATUS BAY	M101 HVAC OVERALL PLAN	P302 WATER/GAS PLAN- FIRE HOUSE
C600 SEWER DETAILS	S3.1 FRAMING DETAILS	A301 BUILDING SECTIONS	E402 ELECTRICAL POWER PLAN- FIREHOUSE	M201 HVAC PLAN- APPARATUS BAY	P303 WATER/GAS PLAN- FIRE HOUSE
C700 DETAILS	S4.1 FRAMING DETAILS	A302 BUILDING SECTIONS	E403 ELECTRICAL POWER PLAN- MEZZANINE	M202 HVAC PLAN- FIRE HOUSE	P304 WATER/GAS PLAN- MEZZANINE
	S4.2 FRAMING DETAILS	A401 WALL SECTIONS	E501 ELECTRICAL SYSTEMS PLAN- APPARATUS BAY	M203 HVAC MEZZANINE PLAN	P401 PLUMBING SECTIONS
	S4.3 FRAMING DETAILS	A402 WALL SECTIONS	E502 ELECTRICAL SYSTEMS PLAN- FIRE HOUSE	M301 HVAC SCHEDULES	P402 PLUMBING RISER I - DWV
	S4.4 FRAMING DETAILS	A403 WALL SECTIONS	E503 ELECTRICAL SYSTEMS PLAN- MEZZANINE	M401 MECHANICAL DETAILS I	P403 PLUMBING RISER II- DOMESTIC WATER
	S5.1 TRUSS PROFILES	A404 WALL SECTIONS	E601 MECHANICAL POWER PLAN- APPARATUS BAY	M402 MECHANICAL DETAILS II	P404 PLUMBING RISER III- DOMESTIC WATER
		A405 WALL SECTIONS	E602 MECHANICAL POWER PLAN- FIREHOUSE	M501 MECHANICAL SECTIONS	P501 PLUMBING RISER IV- NATURAL GAS
		A406 WALL SECTIONS	E603 MECHANICAL POWER PLAN- MEZZANINE		P502 PLUMBING DETAILS I
		A407 WALL SECTIONS	E701 ELECTRICAL ONE-LINE AND PANEL SCHEDULES		
		A408 WALL SECTIONS	E702 ELECTRICAL PANEL SCHEDULES II		
		A501 ENLARGED PLANS	E801 ELECTRICAL DETAILS I		
		A502 INTERIOR ELEVATIONS	E802 ELECTRICAL DETAILS II		
		A503 INTERIOR ELEVATIONS			
		A504 INTERIOR ELEVATIONS & STAIR SECTIONS			
		A505 INTERIOR PARTITIONS			
		A601 DOOR & FINISH SCHEDULE			
		A602 WINDOW ELEVATIONS			
		A701 MISC. DETAILS			
		A702 ENTRY PLAZA DETAILS			
		A703 SITE & FENCING DETAILS			
		A704 FENCING DETAILS			

LANDSCAPE
 LP-1 LANDSCAPE PLAN
 LP-2 LANDSCAPE PLAN DETAIL
 LP-3 PLANT SCHEDULE & CONSTRUCTION NOTES

General Notes

NORTH LITTLE ROCK FIRE DEPARTMENT STATION 8 LOCATION, ARKANSAS

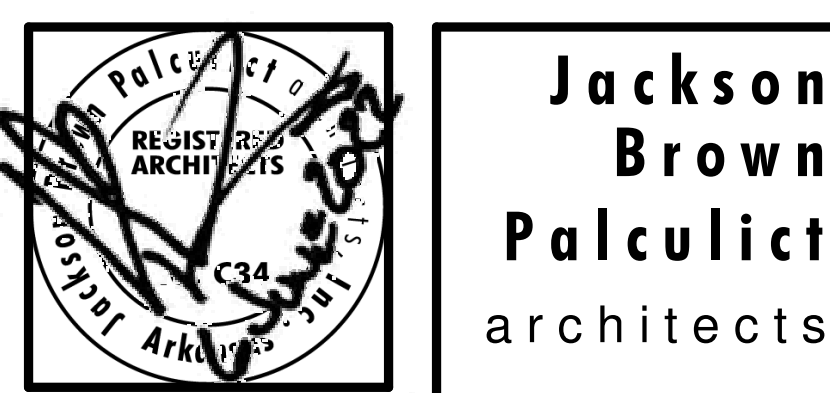

Jackson Brown Palculict architects

Date
6/6/22
 Revisions


Sheet Title
TITLE

Sheet Number
T100

CIVIL THOMAS ENGINEERING COMPANY CONSULTING ENGINEERS 3810 LOOKOUT RD NORTH LITTLE ROCK, AR 72216 (501) 753-4463	LANDSCAPE THOMAS ENGINEERING COMPANY CONSULTING ENGINEERS 3810 LOOKOUT RD NORTH LITTLE ROCK, AR 72216 (501) 753-4463	STRUCTURAL ENGINEERING CONSULTANTS, INC CONSULTING ENGINEERS 401 W. CAPITOL, SUITE 305 LITTLE ROCK, AR 72201 (501) 376-3752	ARCHITECTURAL JACKSON BROWN PALCULICT ARCHITECTS, INC. 12921 CANTRELL ROAD, SUITE 201 LITTLE ROCK, AR 72223 (501) 664-8700	MECHANICAL BROWN ENGINEERS, LLC CONSULTING ENGINEERS 17200 CHENAL PKWY SUITE 300, PMB 324 LITTLE ROCK ARKANSAS (501) 448-0100	PLUMBING BROWN ENGINEERS, LLC CONSULTING ENGINEERS 17200 CHENAL PKWY SUITE 300, PMB 324 LITTLE ROCK ARKANSAS (501) 448-0100	ELECTRICAL BROWN ENGINEERS, LLC CONSULTING ENGINEERS 17200 CHENAL PKWY SUITE 300, PMB 324 LITTLE ROCK ARKANSAS (501) 448-0100
---	---	--	---	--	--	--

12921 Cantrell Road, Suite 201
 Little Rock, AR 72223
 501.664.8700 tel
 501.664.5189 fax
 www.jbparchitects.com

SCHEDULE OF SPECIAL INSPECTION SERVICES				
NORTH LITTLE ROCK FIRE DEPARTMENT STATION 8				
MATERIAL / ACTIVITY	SERVICE	APPLICABLE TO THIS PROJECT		
		EXTENT	AGENT*	DATE COMPLETED
1708.2 Structural Steel Construction				
1. Material verification of structural steel.	Shop (3) and field inspection	Periodic	2,4	
2. Anchor Rods and other Embedment(s) (Verify diameter, grade, type, length, embedment. See 1708.2 for anchors)	Field Inspection	Continuous	2	
1708.3 Concrete Construction				
a. Inspection tasks Prior to Welding (Observe, or perform for each welded joint or member; the GA tasks listed in ASCE 580, Table NS-4-1)				
Shop (3) and field inspection	Observe or Perform as noted (4)		2	
b. Inspection tasks During Welding (Observe, or perform for each welded joint or member; the GA tasks listed in ASCE 580, Table NS-4-2)				
Shop (3) and field inspection	Observe (4)		2	
c. Inspection tasks After Welding (Observe, or perform for each welded joint or member; the GA tasks listed in ASCE 580, Table NS-4-3)				
Shop (3) and field inspection	Observe or Perform as noted (4)		2	
1708.4 Masonry Construction				
1. Verify compliance with approved submittals	Field inspection	Periodic	2	
2. Verification of F_u and $F_{u,c}$ prior to construction	Testing by unit strength method or prism test method	Periodic	2	
3. Verification of proportions of materials in premixed or preblended mortar, prestressing grout, and grout other than self-consolidating grout, as delivered to the project site	Field inspection	Continuous		
4. Verify placement of masonry units	Field inspection	Periodic	2	
5. Verification of Slump Flow and Visual Stability Index (VSI) of self-consolidating grout as delivered to the project	Field testing	Continuous		
6. Verify compliance with approved submittals	Field inspection	Periodic	2	
7. Verify grade, type, and size of reinforcement and anchor bolts, and prestressing tendons and anchorages	Field inspection	Periodic	2	
8. Verify construction of mortar joints	Field inspection	Periodic	2	
9. Verify grout space prior to grouting	Field inspection	Periodic	2	
10. Verify type, size, and location of anchors, including details of anchorage of masonry to structural members, frames, or other construction.	Field inspection	Periodic		
11. Verify preparation, construction, and protection of masonry during cold weather (temperature below 40° F) or hot weather (temperature above 90° F)	Field inspection	Periodic		
12. Prepare grout and mortar specimens	Field testing	Periodic		
13. Observe preparation of prisms	Field inspection	Periodic		
1708.5 Wood Construction				
1. Inspection of the fabrication process of wood structural elements and assemblies in accordance with Section 1704.2.9	In-plant review (3)	Periodic	5	
2. Verification of grade and thickness of structural panel sheathing.	Field inspection	Periodic	2	
3. For high-load diaphragms, verify nominal size of framing members at adjoining panel edges, nail or staple diameter and length, number of fastener lines, and nail spacing between fasteners in each line and at edge margins agrees with approved diag plans.	Field inspection	Periodic		
4. Metal-plate-connected wood trusses spanning 60 feet or greater; verify temporary and permanent restraining bracing are installed in accordance with the approved truss submittal package	Field inspection	Periodic		
1708.6 Soils				
1. Verify materials below shallow foundations are adequate to achieve the design bearing capacity.	Field inspection	Periodic	1	
2. Verify excavations are extended to proper depth and have reached proper material.	Field inspection	Periodic	1	
3. Perform classification and testing of controlled fill materials.	Field inspection	Periodic	1	
4. Verify use of proper materials, densities, and lift thicknesses during placement and compaction of compacted fill.	Field inspection	Continuous		
5. Prior to placement of controlled fill, observe subgrade and verify that site has been prepared properly.	Field inspection	Periodic	1	
1708.10 Wind-Resisting Components				
1. Roof cladding	Shop (3) and field inspection	Periodic	2	
2. Wall cladding	Shop (3) and field inspection	Periodic	2	
1708.11 Architectural Components Special Inspections for Seismic Resistance				
1. Inspection during the erection and fastening of interior and exterior non-load bearing walls.	Field inspection	Periodic	2	
* INSPECTION AGENTS				
1. TESTING AGENCY	FIRM			
2. TESTING AGENCY	GEOTECHNICAL ENGINEER			
3. ARCHITECT	TO BE SELECTED			
4. STRUCTURAL ENGINEER	JACKSON BROWN PALCULICT ENGINEERING CONSULTANTS, INC.			
5. TRUSS MANUFACTURER	TO BE SELECTED			

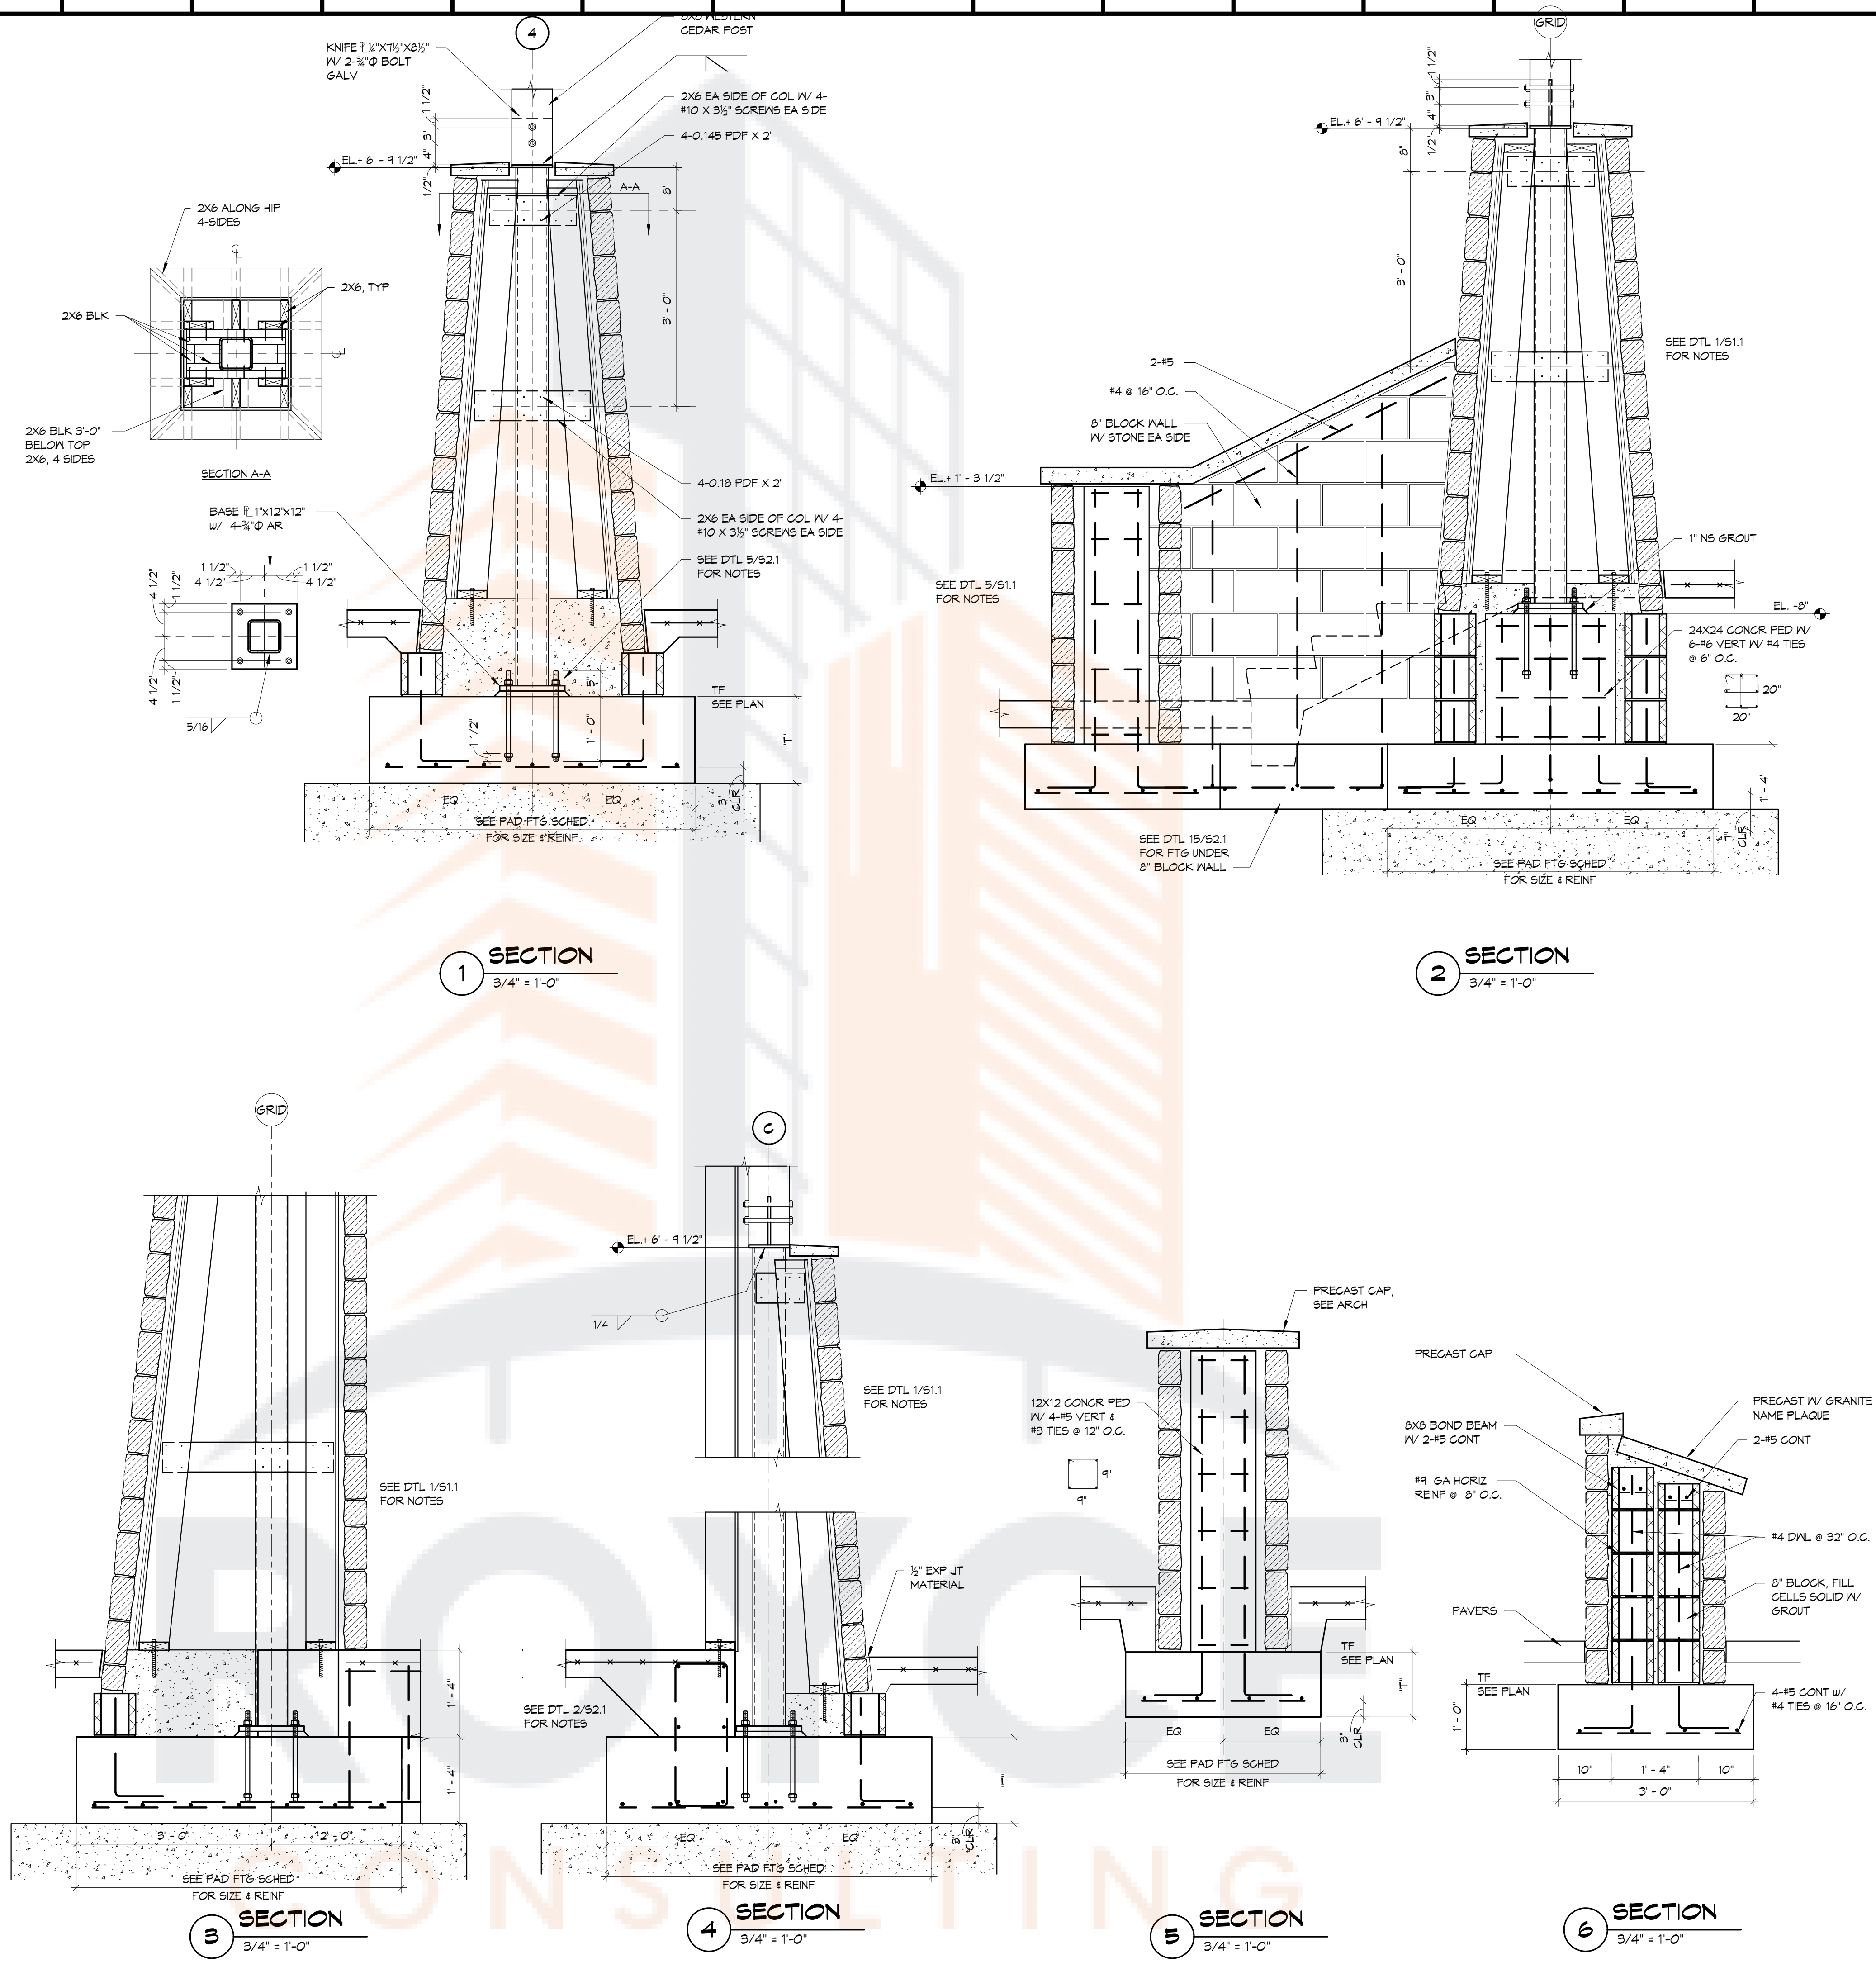

General Notes

CERTIFICATE OF AUTHORITY
ENGINEERING CONSULTANTS, INC.
No. 26
ARKANSAS-ENGINEER

STATE OF ARKANSAS
REGISTERED PROFESSIONAL ENGINEER
No. 9882
STEPHEN HARRISON
4/25/22

ENGINEERING CONSULTANTS INC.
401 WEST CAPITOL AVE SUITE #305
LITTLE ROCK AR 72201-3459

NORTH LITTLE ROCK FIRE DEPARTMENT STATION 8


**Jackson
Brown
Palculict
architects**

Date 4/25/22
Revisions
JOB NUMBER Project Number

Sheet Title INSPECTION TABLE & FOUNDATION DETAILS

Sheet Number S1.1

12921 Cantrell Road, Suite 201
Little Rock, AR 72203
501.664.8700 tel
501.664.5189 fax
www.jbparchitects.com

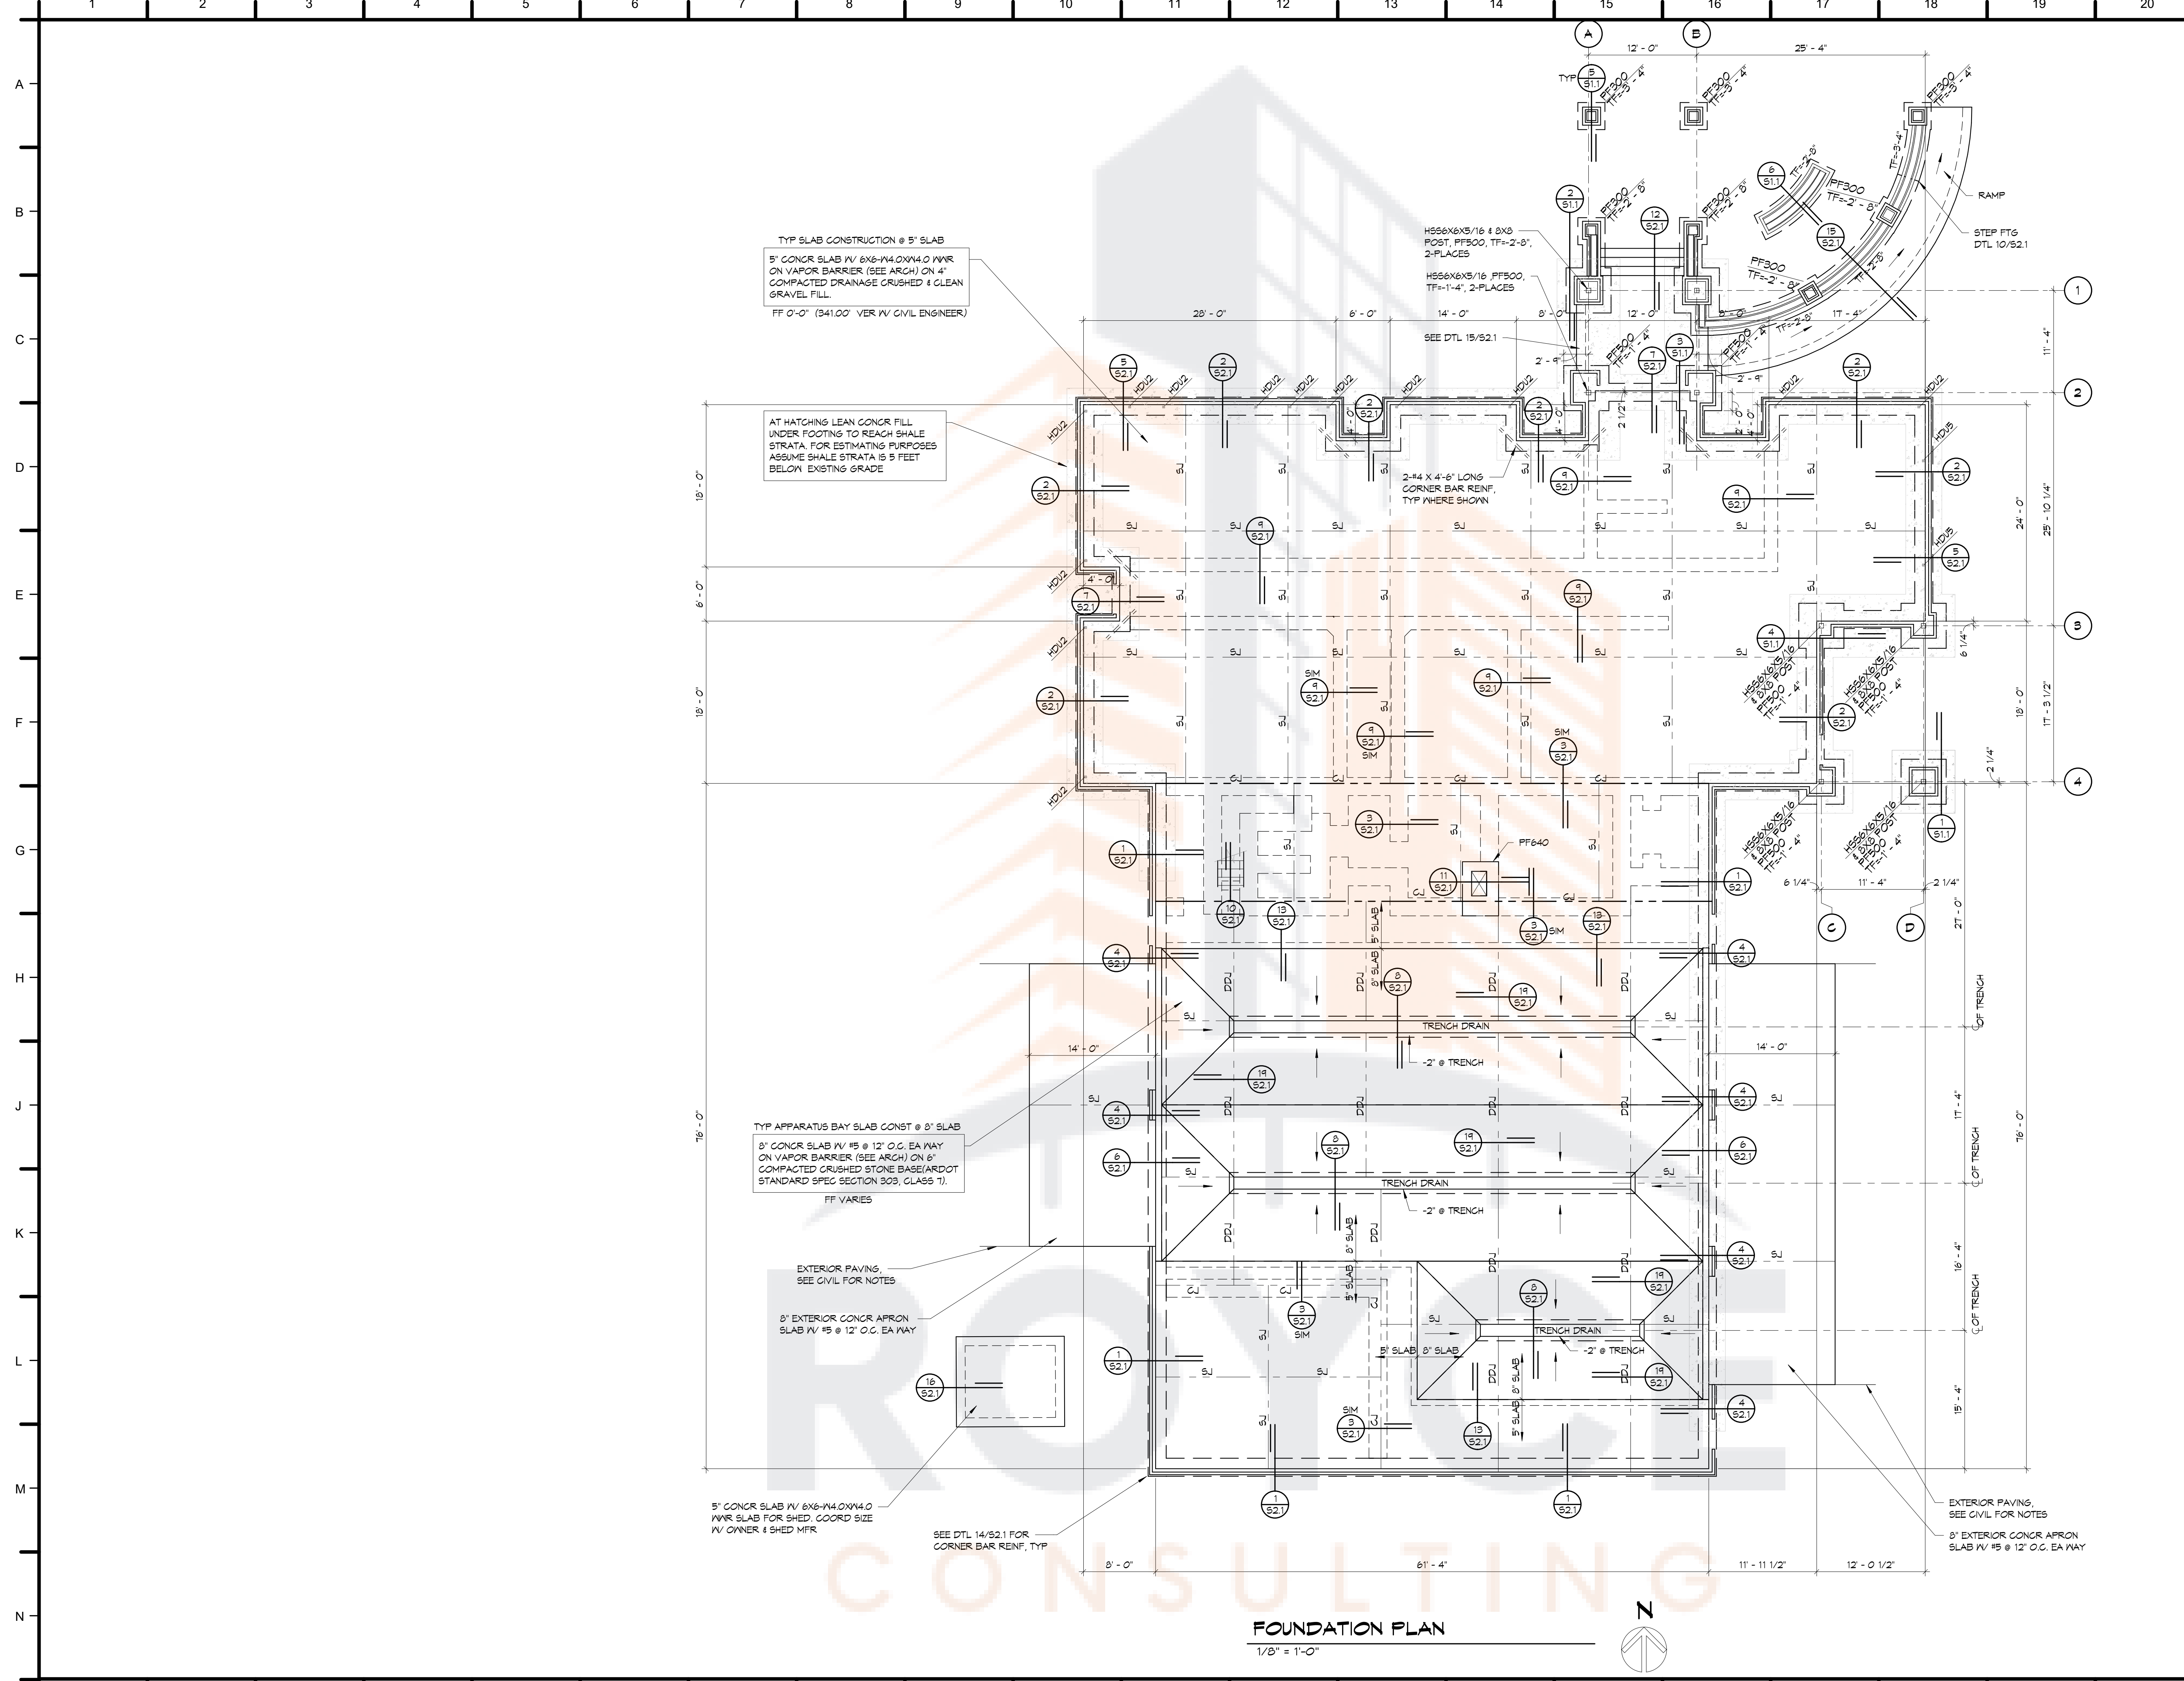

General Notes

CERTIFICATE OF AUTHORITY
ENGINEERING CONSULTANTS, INC.
No. 26
ARKANSAS-ENGINEER

STATE OF ARKANSAS
REGISTERED PROFESSIONAL ENGINEER
No. 9682
STEPHEN HARRISON
4/25/22

ENGINEERING CONSULTANTS INC.
401 WEST CAPITOL AVE SUITE #305
LITTLE ROCK AR 72201-3459

**NORTH LITTLE ROCK
FIRE DEPARTMENT
STATION 8**

**Jackson
Brown
Palculict
architects**

Date
4/25/22
Revisions


JOB NUMBER Project Number


Sheet Title
FOUNDATION PLAN

Sheet Number
S1.2

12921 Cantrell Road, Suite 201
Little Rock, AR 72223
501.664.8700 tel
501.664.5189 fax
www.jbparchitects.com

FOUNDATION PLAN
1/8" = 1'-0"

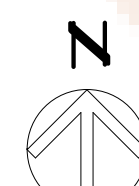

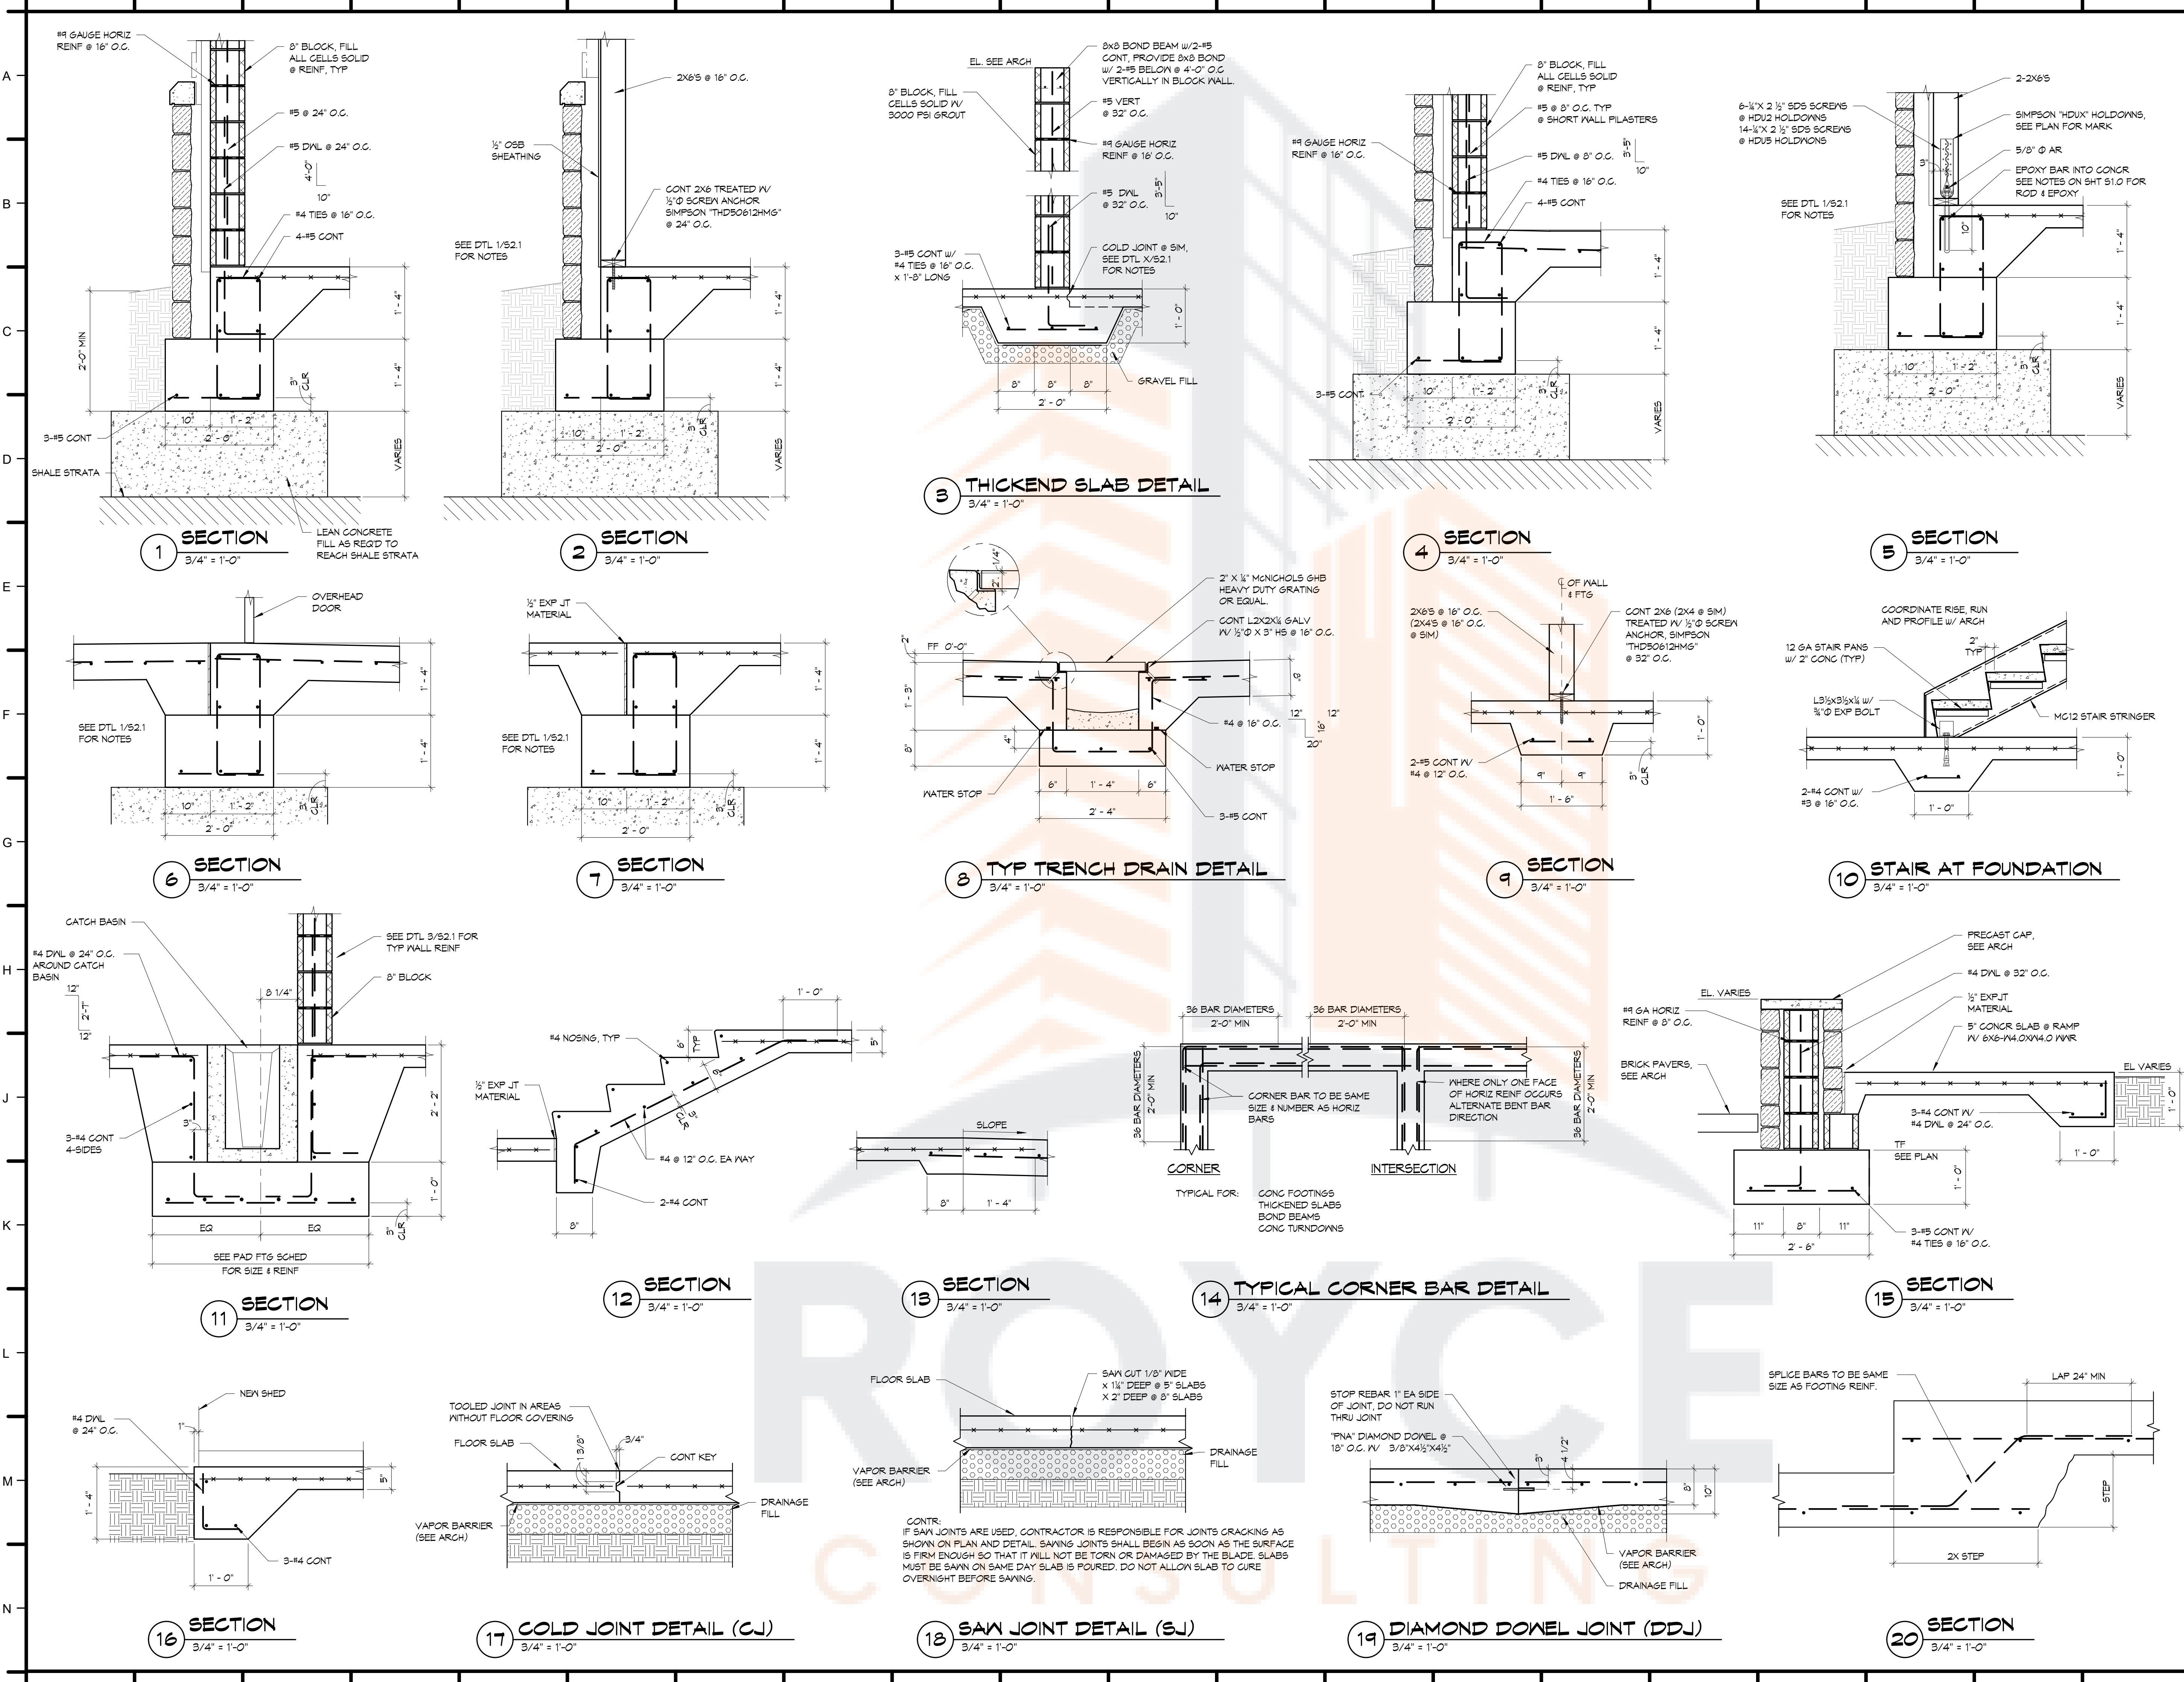

General Notes

CERTIFICATE OF AUTHORITY
ENGINEERING CONSULTANTS, INC.
No. 26
ARKANSAS-ENGINEER

STATE OF ARKANSAS
REGISTERED PROFESSIONAL ENGINEER
No. 9882
STEPHEN HARRISON
4/25/22

ENGINEERING CONSULTANTS INC.
401 WEST CAPITOL AVE SUITE #305
LITTLE ROCK AR 72201-3459

**NORTH LITTLE ROCK
FIRE DEPARTMENT
STATION 8**

**Jackson
Brown
Palculict
architects**

Date
4/25/22
Revisions


JOB NUMBER Project Number

Sheet Title
**FOUNDATION
DETAILS**

Sheet Number
S2.1

12921 Cantrell Road, Suite 201
Little Rock, AR 72223
501.664.8700 tel
501.664.5189 fax
www.jbparchitects.com

Copyright 2020 JBP

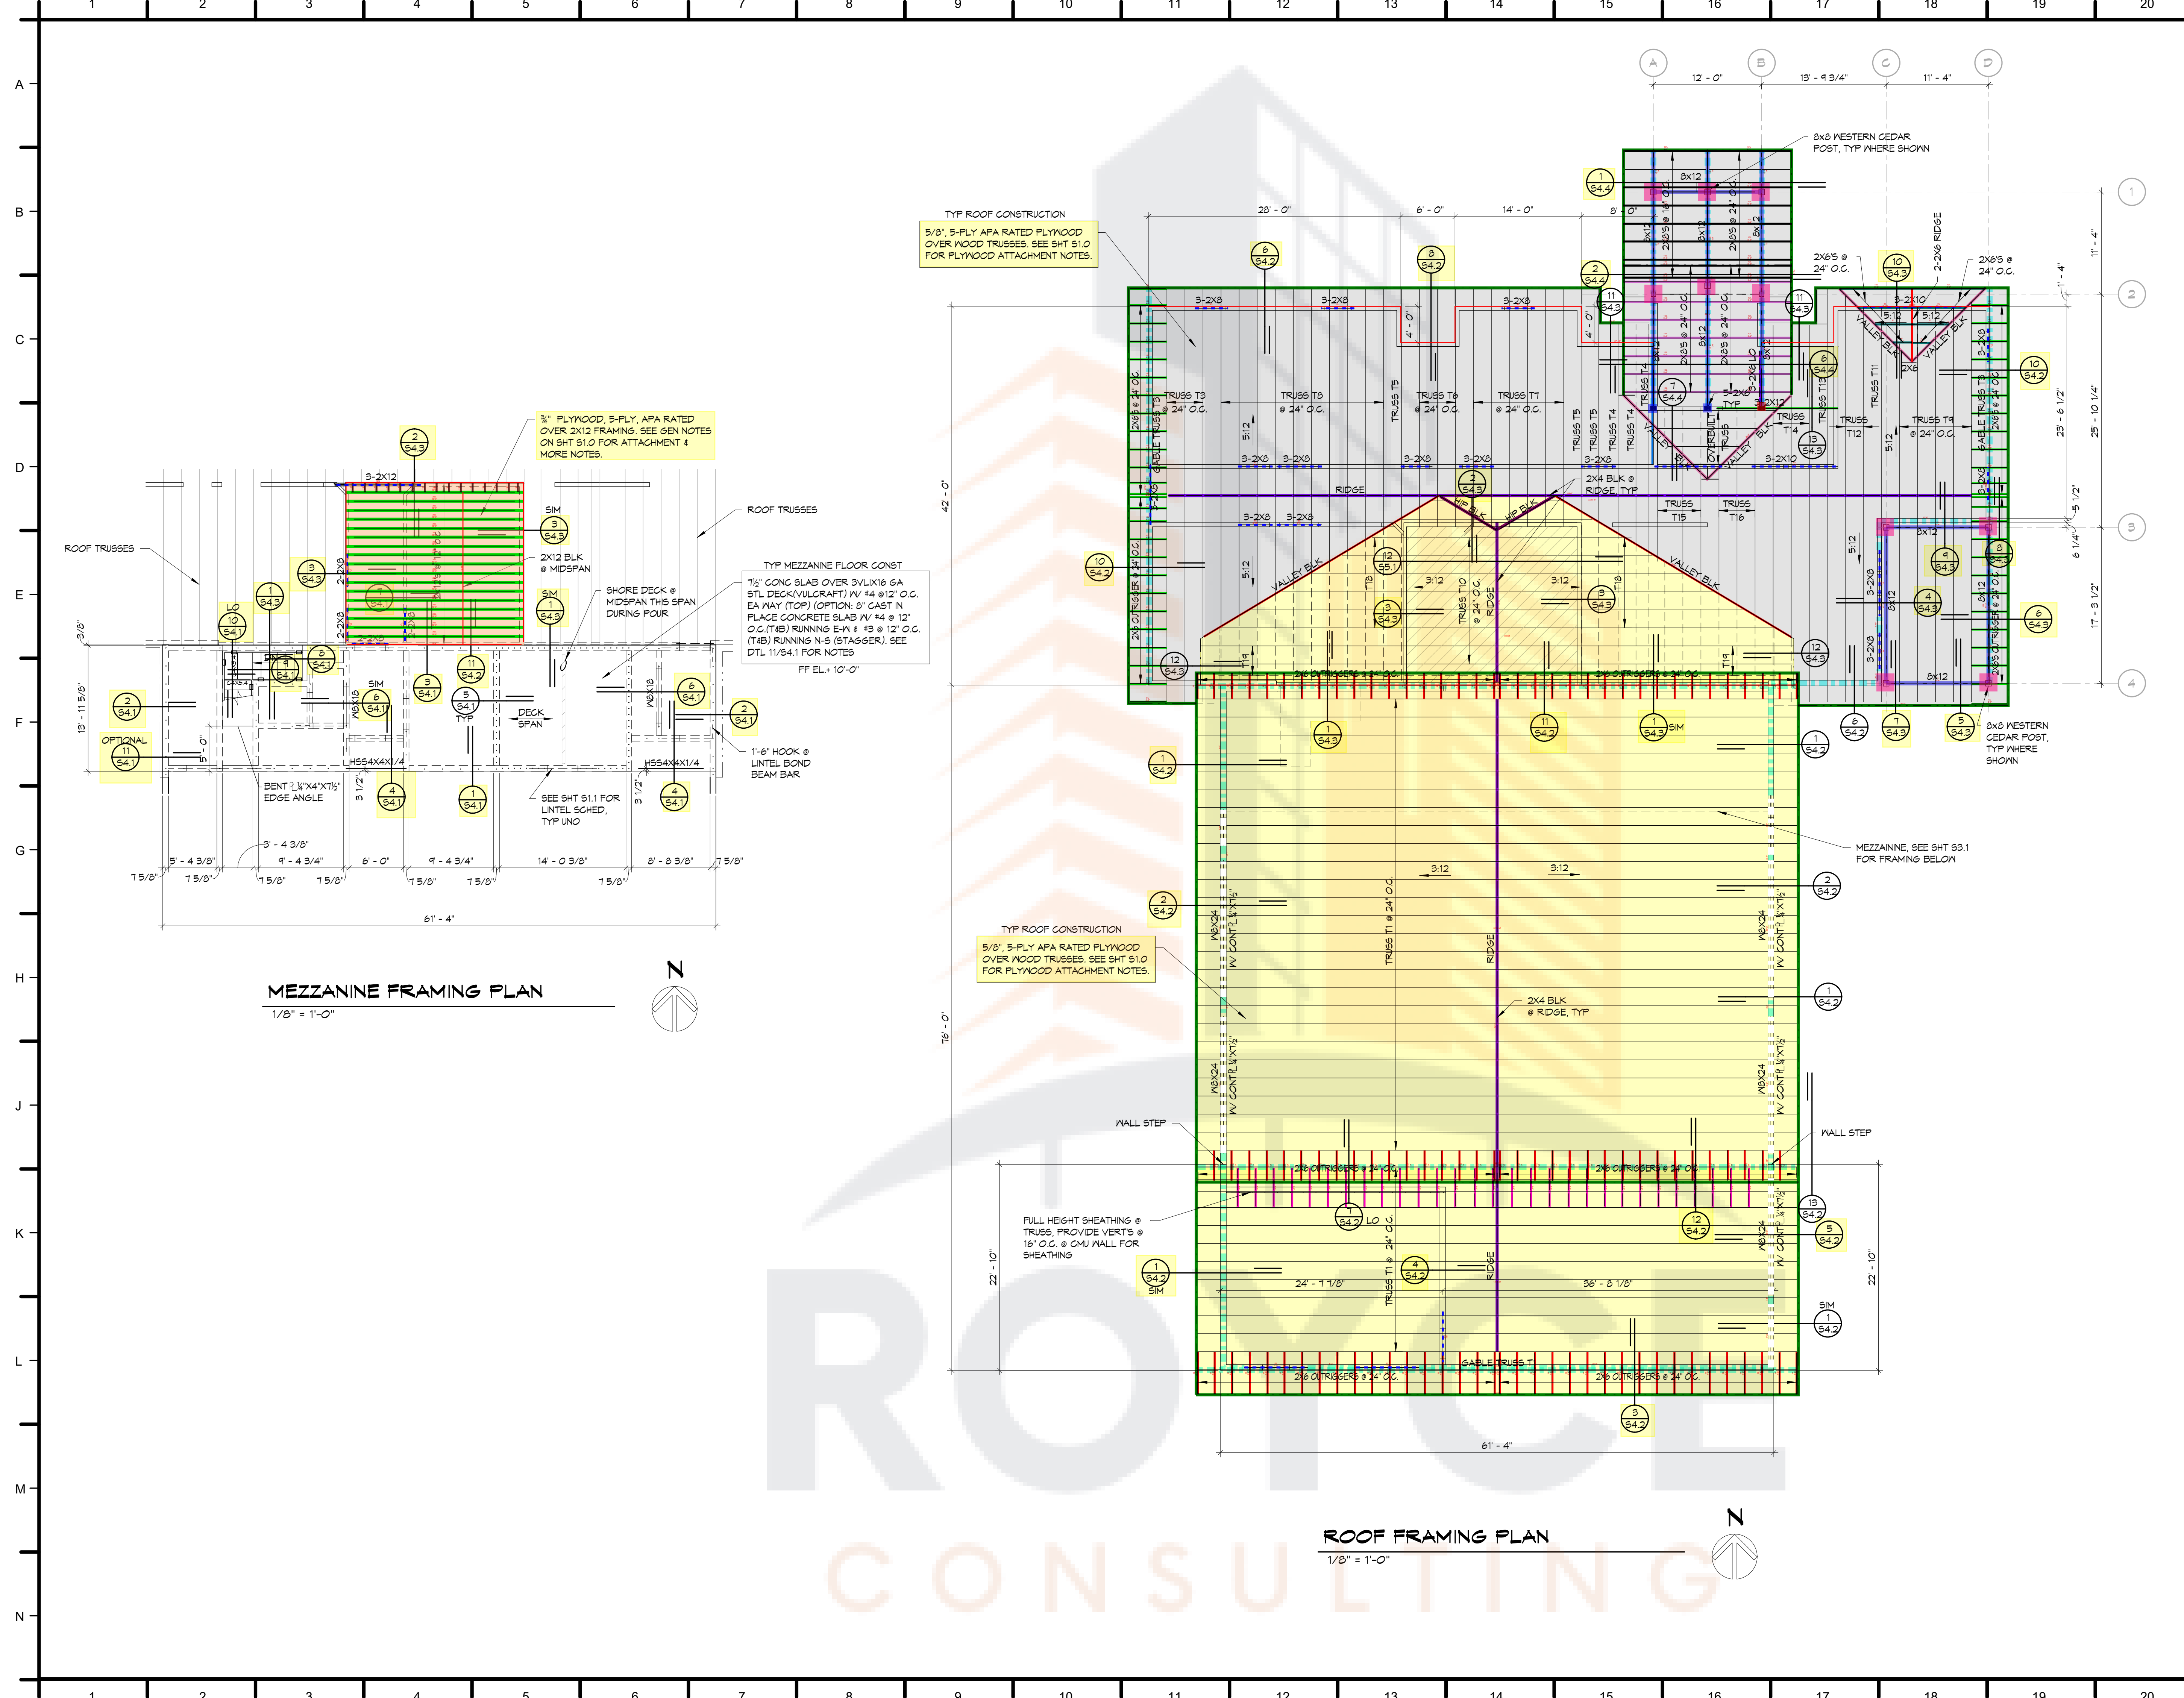

General Notes

CERTIFICATE OF AUTHORITY
ENGINEERING CONSULTANTS, INC.
No. 26
ARKANSAS-ENGINEER

STATE OF ARKANSAS
REGISTERED PROFESSIONAL ENGINEER
No. 9682
STEPHEN HARRISON

4/25/22

ENGINEERING CONSULTANTS INC.
401 WEST CAPITOL AVE SUITE #305
LITTLE ROCK AR 72201-3459

**NORTH LITTLE ROCK
FIRE DEPARTMENT
STATION 8**

**Jackson
Brown
Palculict
architects**


Date
4/25/22
Revisions


JOB NUMBER Project Number

Sheet Title
**ROOF &
MEZZANINE
FRAMING PLAN**

Sheet Number
S3.1

12921 Cantrell Road, Suite 201
Little Rock, AR 72223
501.664.8700 tel
501.664.5189 fax
www.jbpaarchitects.com

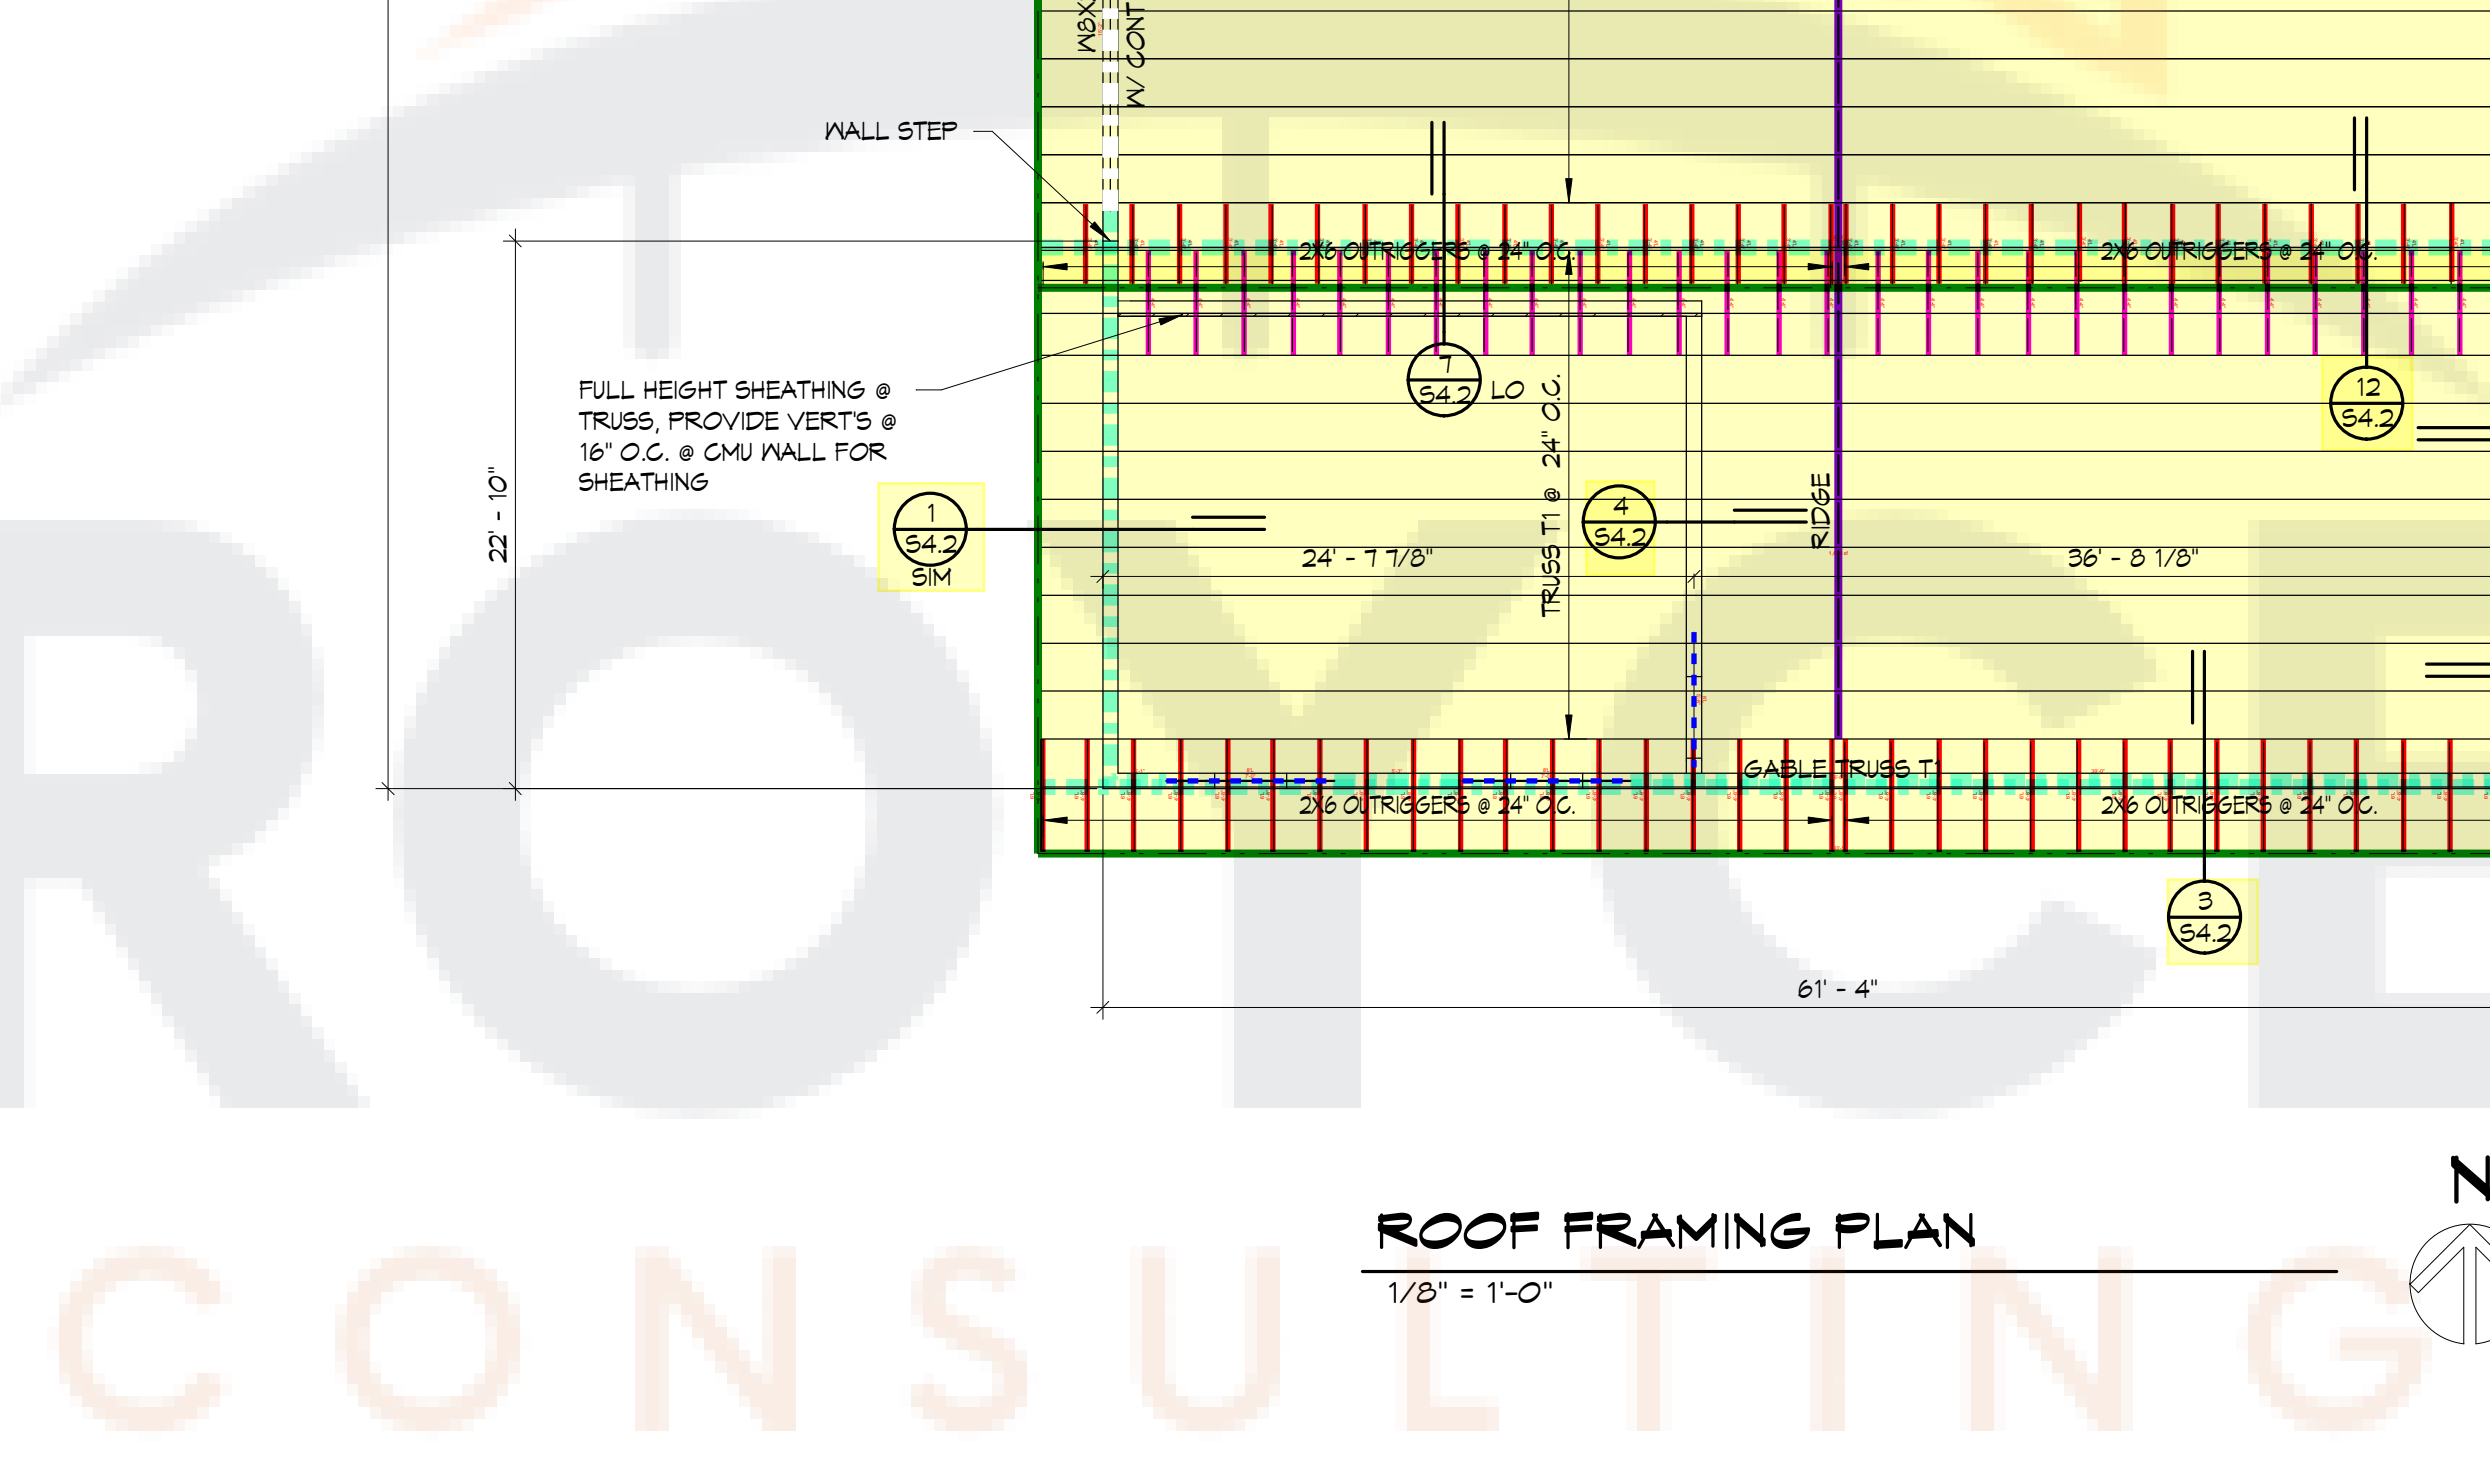

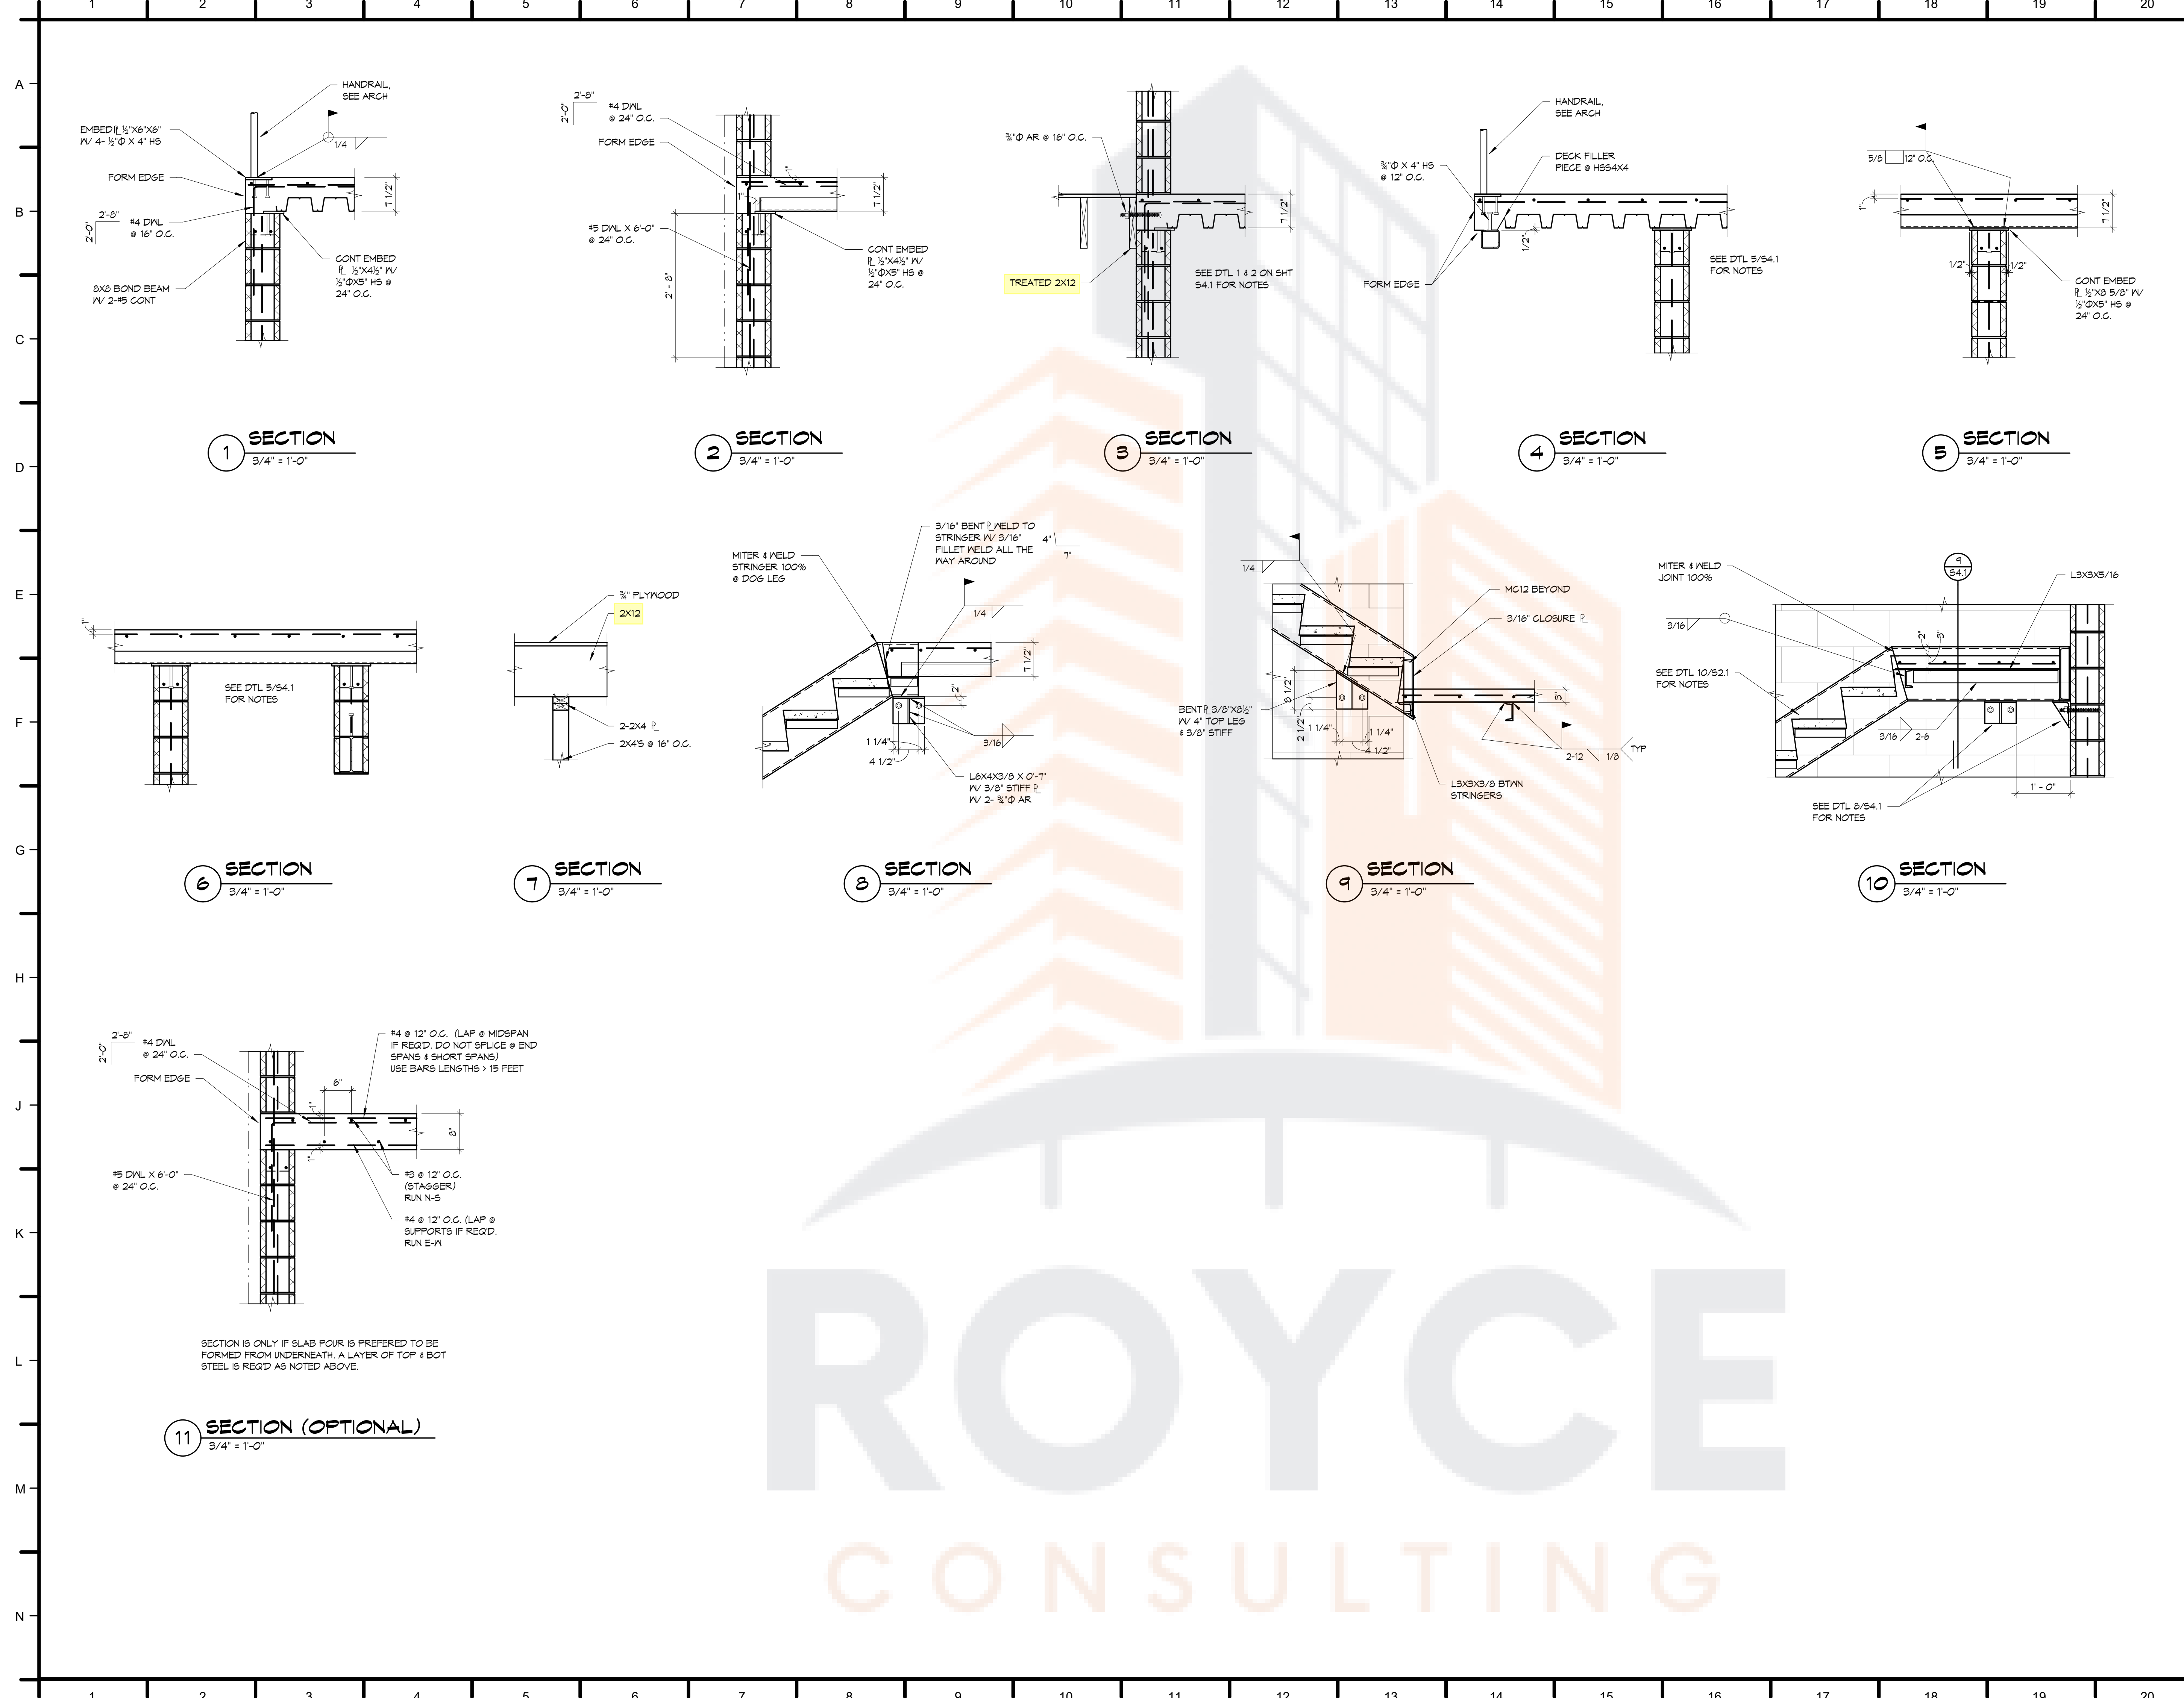

General Notes

CERTIFICATE OF AUTHORITY

ENGINEERING CONSULTANTS, INC.

No. 26

ARKANSAS-ENGINEER

STATE OF ARKANSAS

REGISTERED PROFESSIONAL ENGINEER

No. 9682

STEPHEN HARRISON

4/25/22

ENGINEERING CONSULTANTS, INC.
401 WEST CAPITOL AVE SUITE #305
LITTLE ROCK AR 72201-3459

**NORTH LITTLE ROCK
FIRE DEPARTMENT
STATION 8**

**Jackson
Brown
Palculict**
architects

Date
4/25/22
Revisions


Job Number Project Number

Sheet Title
**FRAMING
DETAILS**

Sheet Number
S4.1

12921 Cantrell Road, Suite 201
Little Rock, AR 72223
501.664.8700 tel
501.664.5189 fax
www.jbparchitects.com

ROYCE
CONSULTING

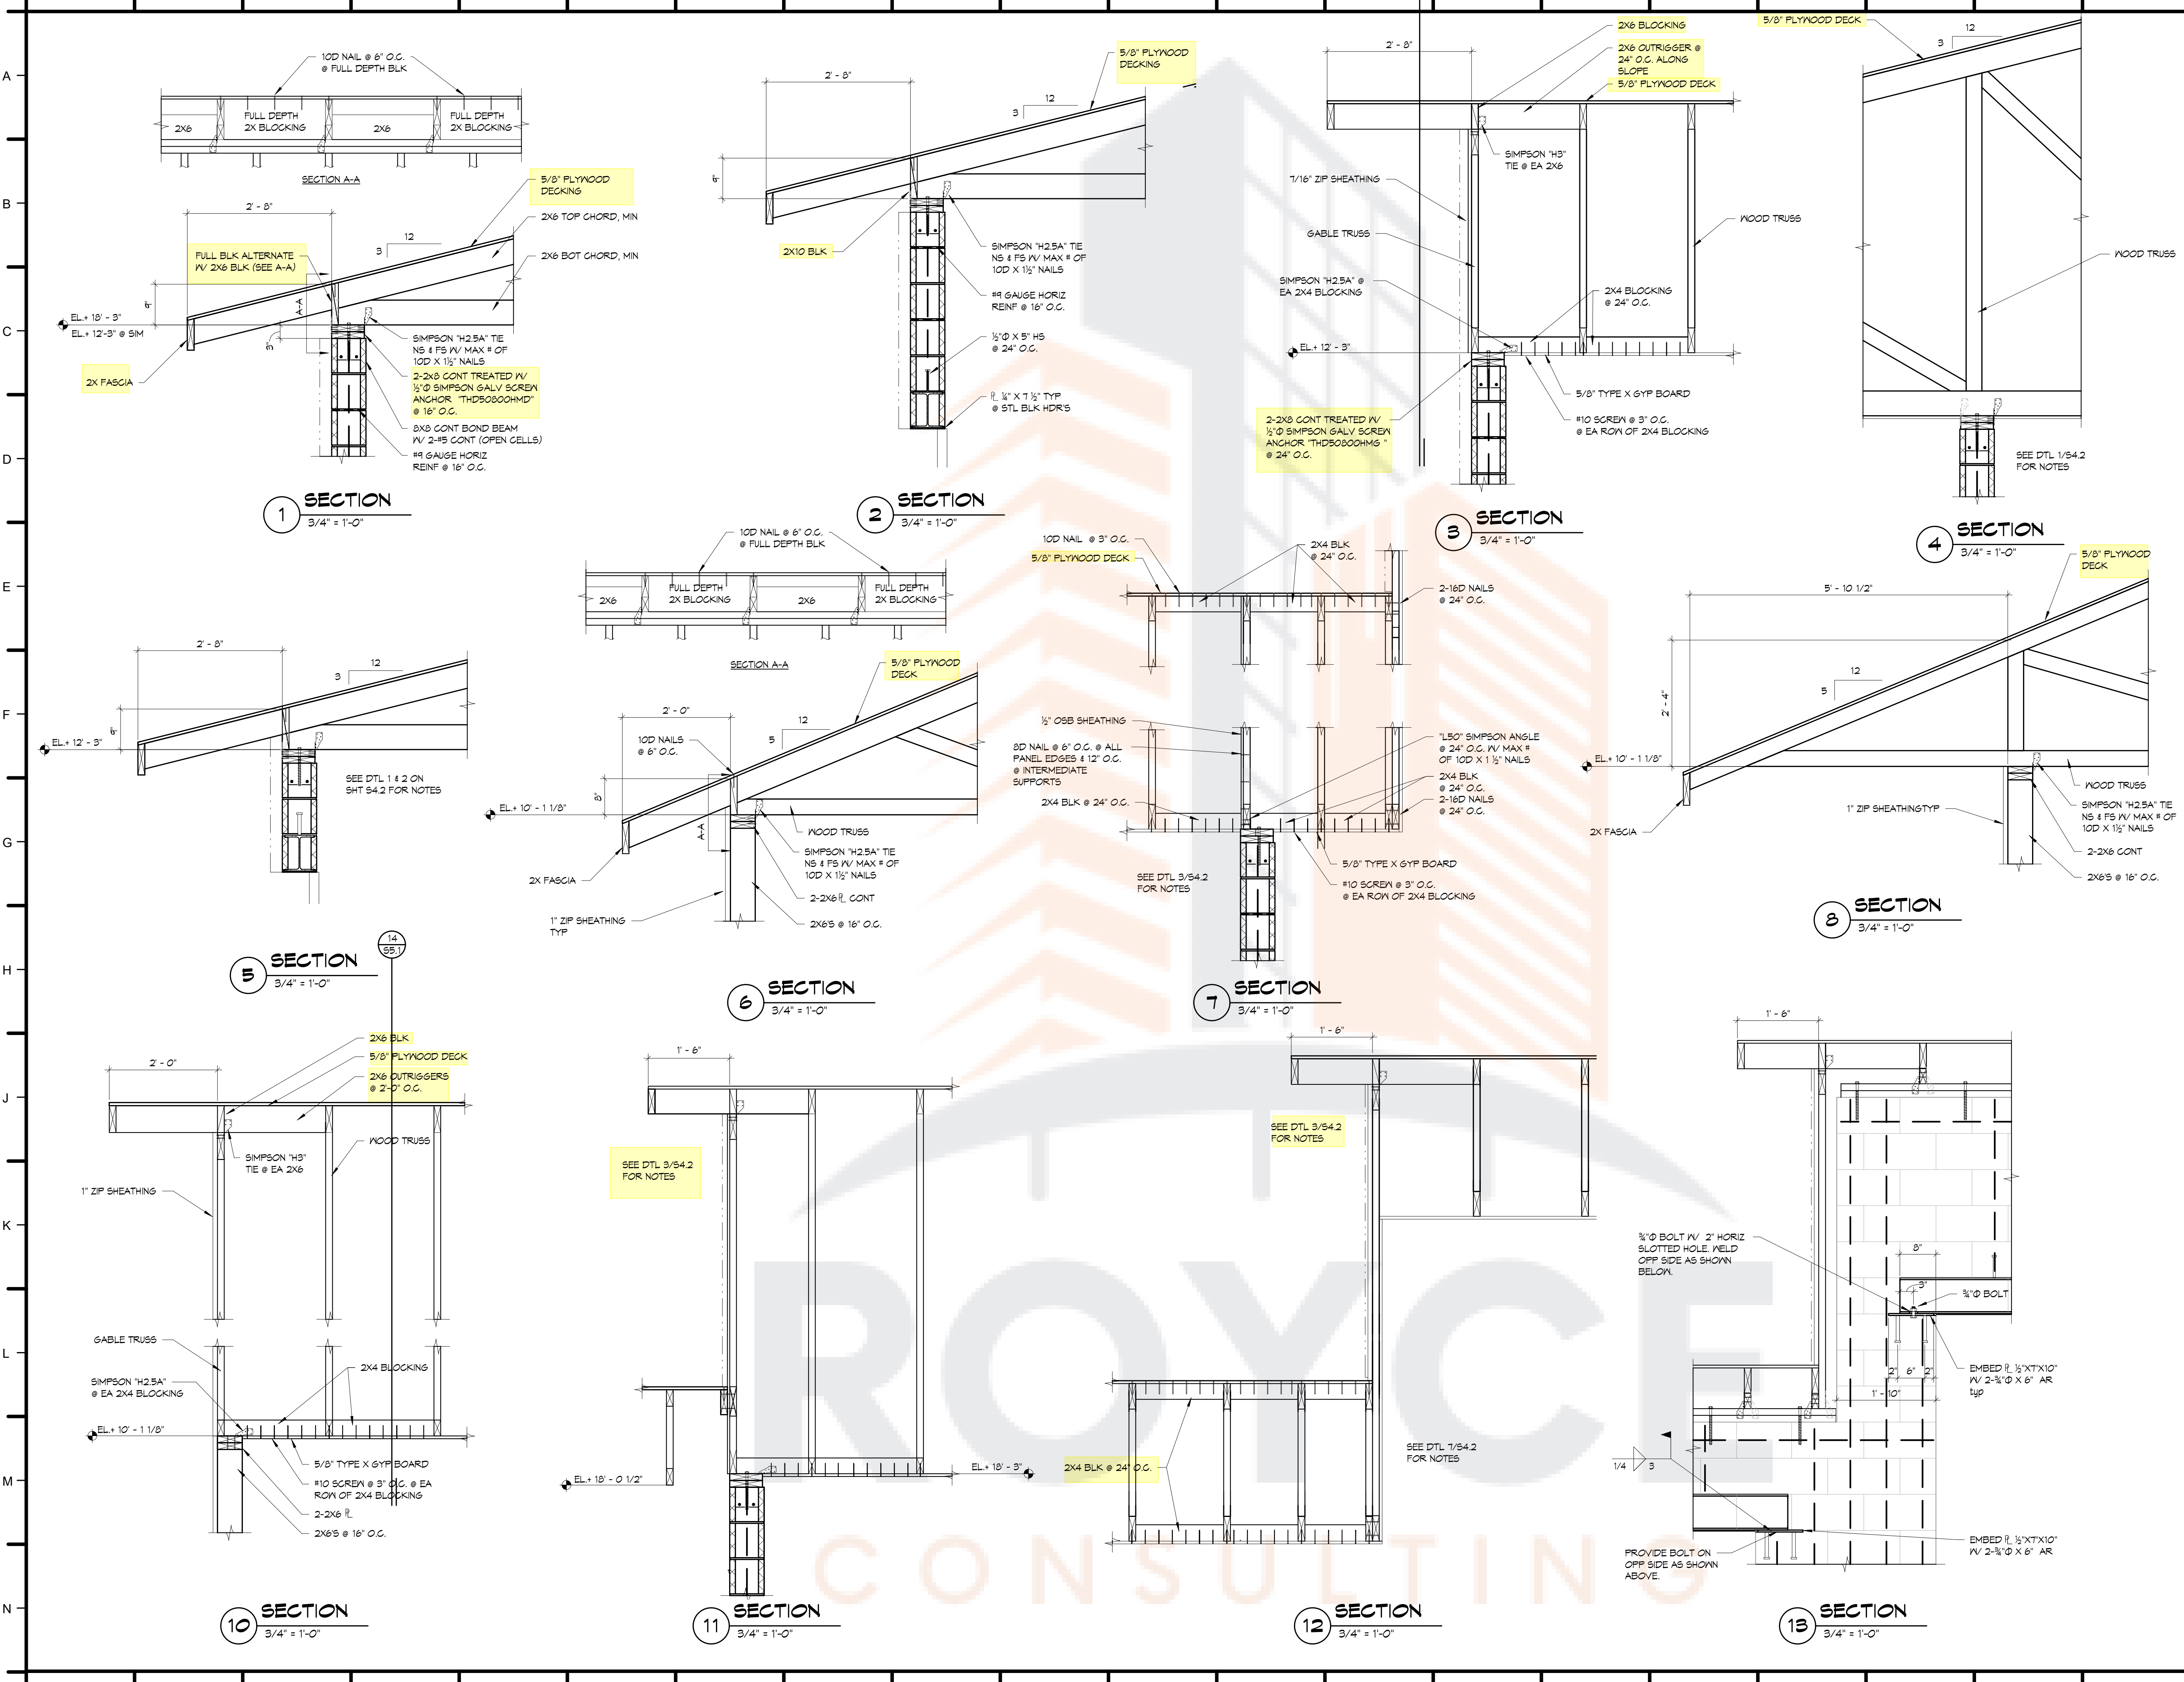

General Notes

CERTIFICATE OF AUTHORITY
 ENGINEERING CONSULTANTS, INC.
 No. 26
 ARKANSAS-ENGINEER

STATE OF ARKANSAS
 REGISTERED PROFESSIONAL ENGINEER
 No. 9882
 STEPHEN HARRISON
 4/25/22

ENGINEERING CONSULTANTS INC.
 401 WEST CAPITOL AVE SUITE #305
 LITTLE ROCK AR 72201-3459

NORTH LITTLE ROCK FIRE DEPARTMENT STATION 8

**Jackson
 Brown
 Palculict**
 architects

Date
4/25/22
 Revisions

JOB NUMBER Project Number


Sheet Title
FRAMING DETAILS

Sheet Number

S4.2

12921 Cantrell Road, Suite 201
 Little Rock, AR 72223
 501.664.8700 tel
 501.664.5189 fax
 www.jbparchitects.com

Copyright 2020 JBP

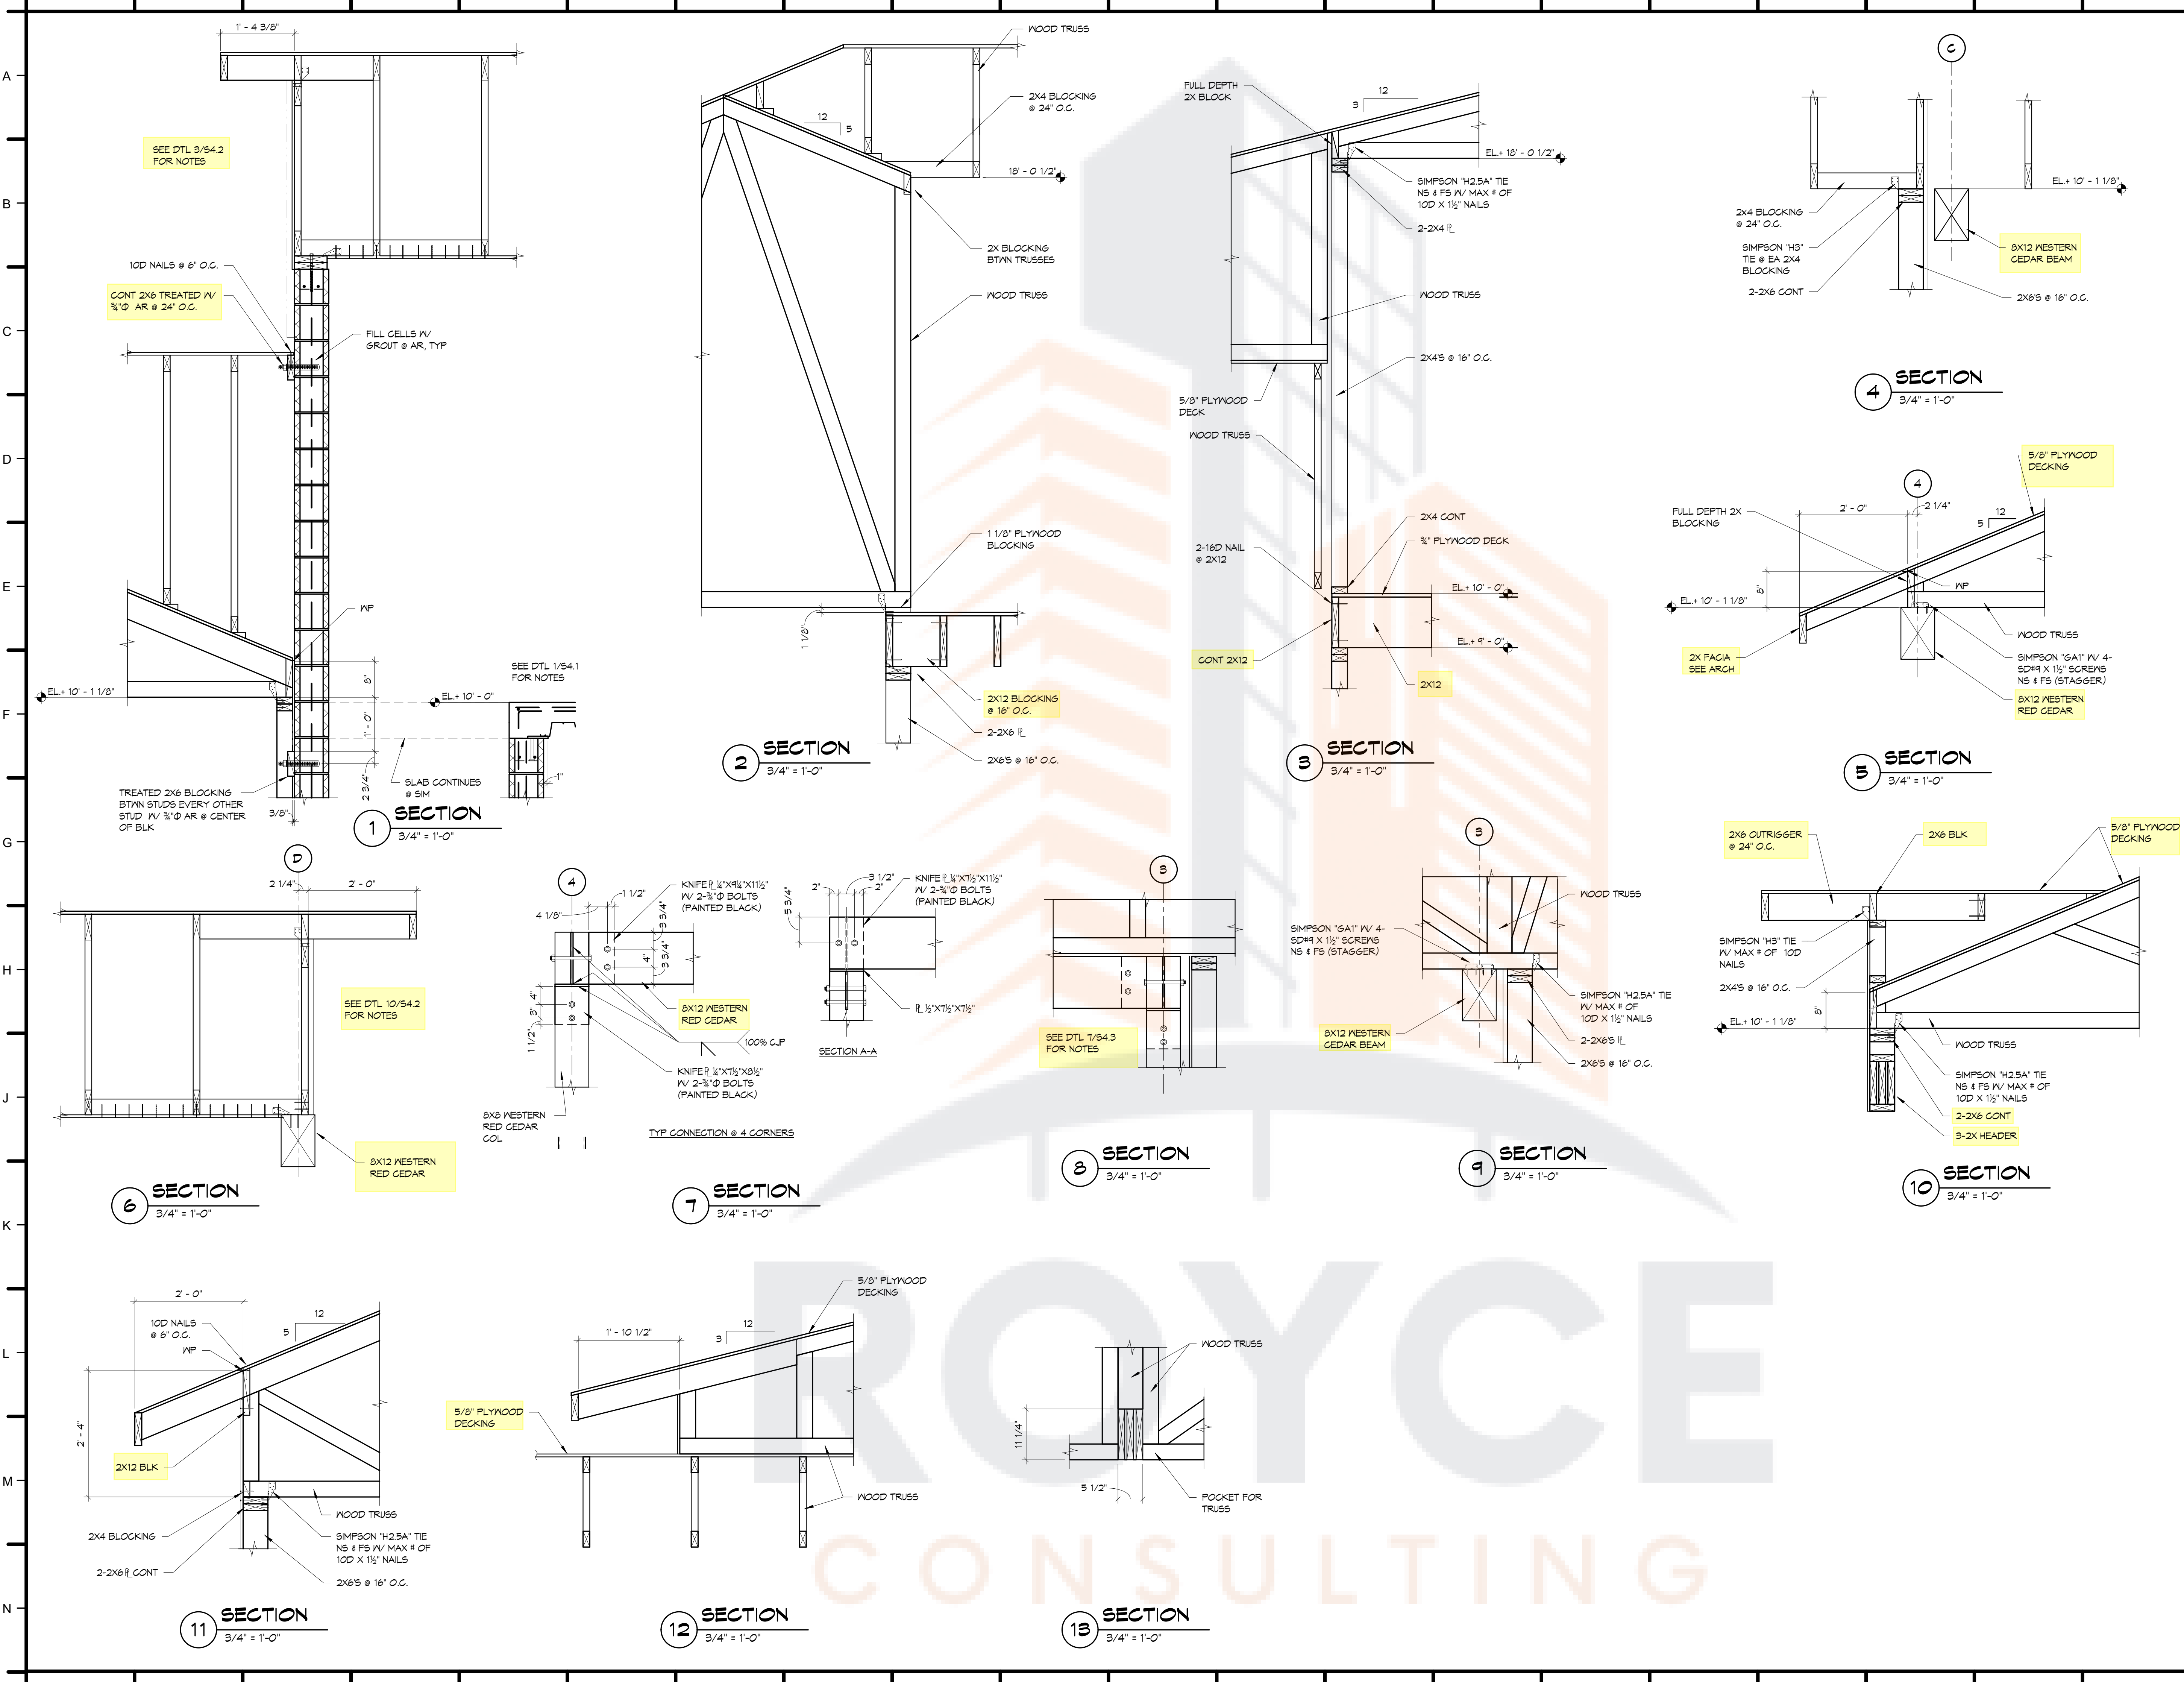

General Notes

CERTIFICATE OF AUTHORITY
 ENGINEERING CONSULTANTS, INC.
 No. 26
 ARKANSAS-ENGINEER

STATE OF ARKANSAS
 REGISTERED PROFESSIONAL ENGINEER
 No. 9682
 STEPHEN HARRISON
 4/25/22


ENGINEERING CONSULTANTS INC.
 401 WEST CAPITOL AVE SUITE #305
 LITTLE ROCK AR 72201-3459

NORTH LITTLE ROCK FIRE DEPARTMENT STATION 8


**Jackson
 Brown
 Palculict**
 architects

Date 4/25/22 Revisions	
JOB NUMBER	Project Number
Sheet Title FRAMING DETAILS	
Sheet Number S4.3	
Copyright 2020 JBP	


12921 Cantrell Road, Suite 201
 Little Rock, AR 72223
 501.664.8700 tel
 501.664.5189 fax
 www.jbparchitects.com

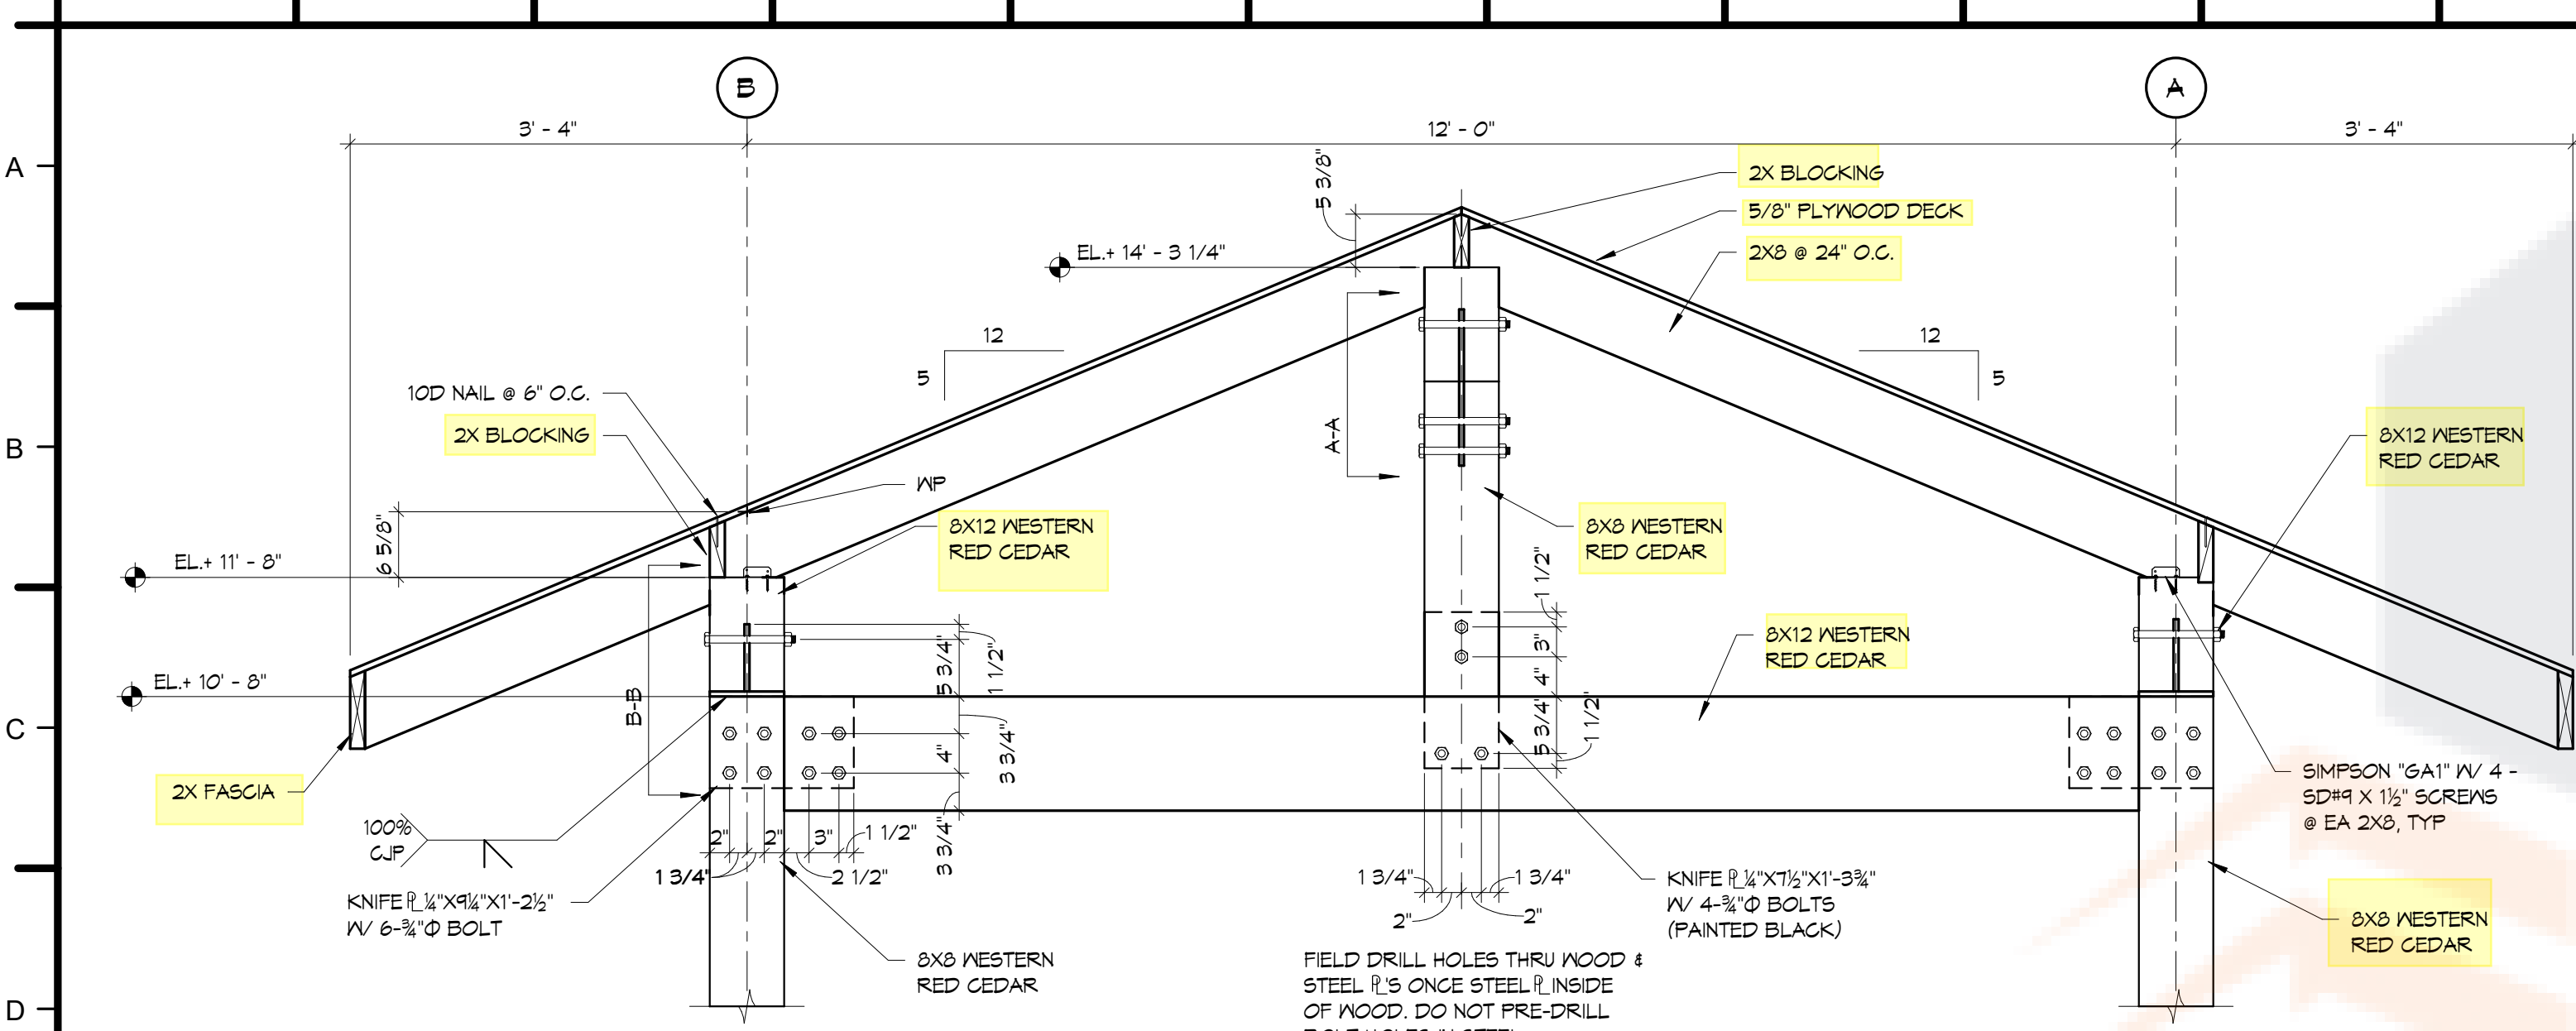


1 ELEVATION @ KING POST TRUSS
3/4" = 1'-0"

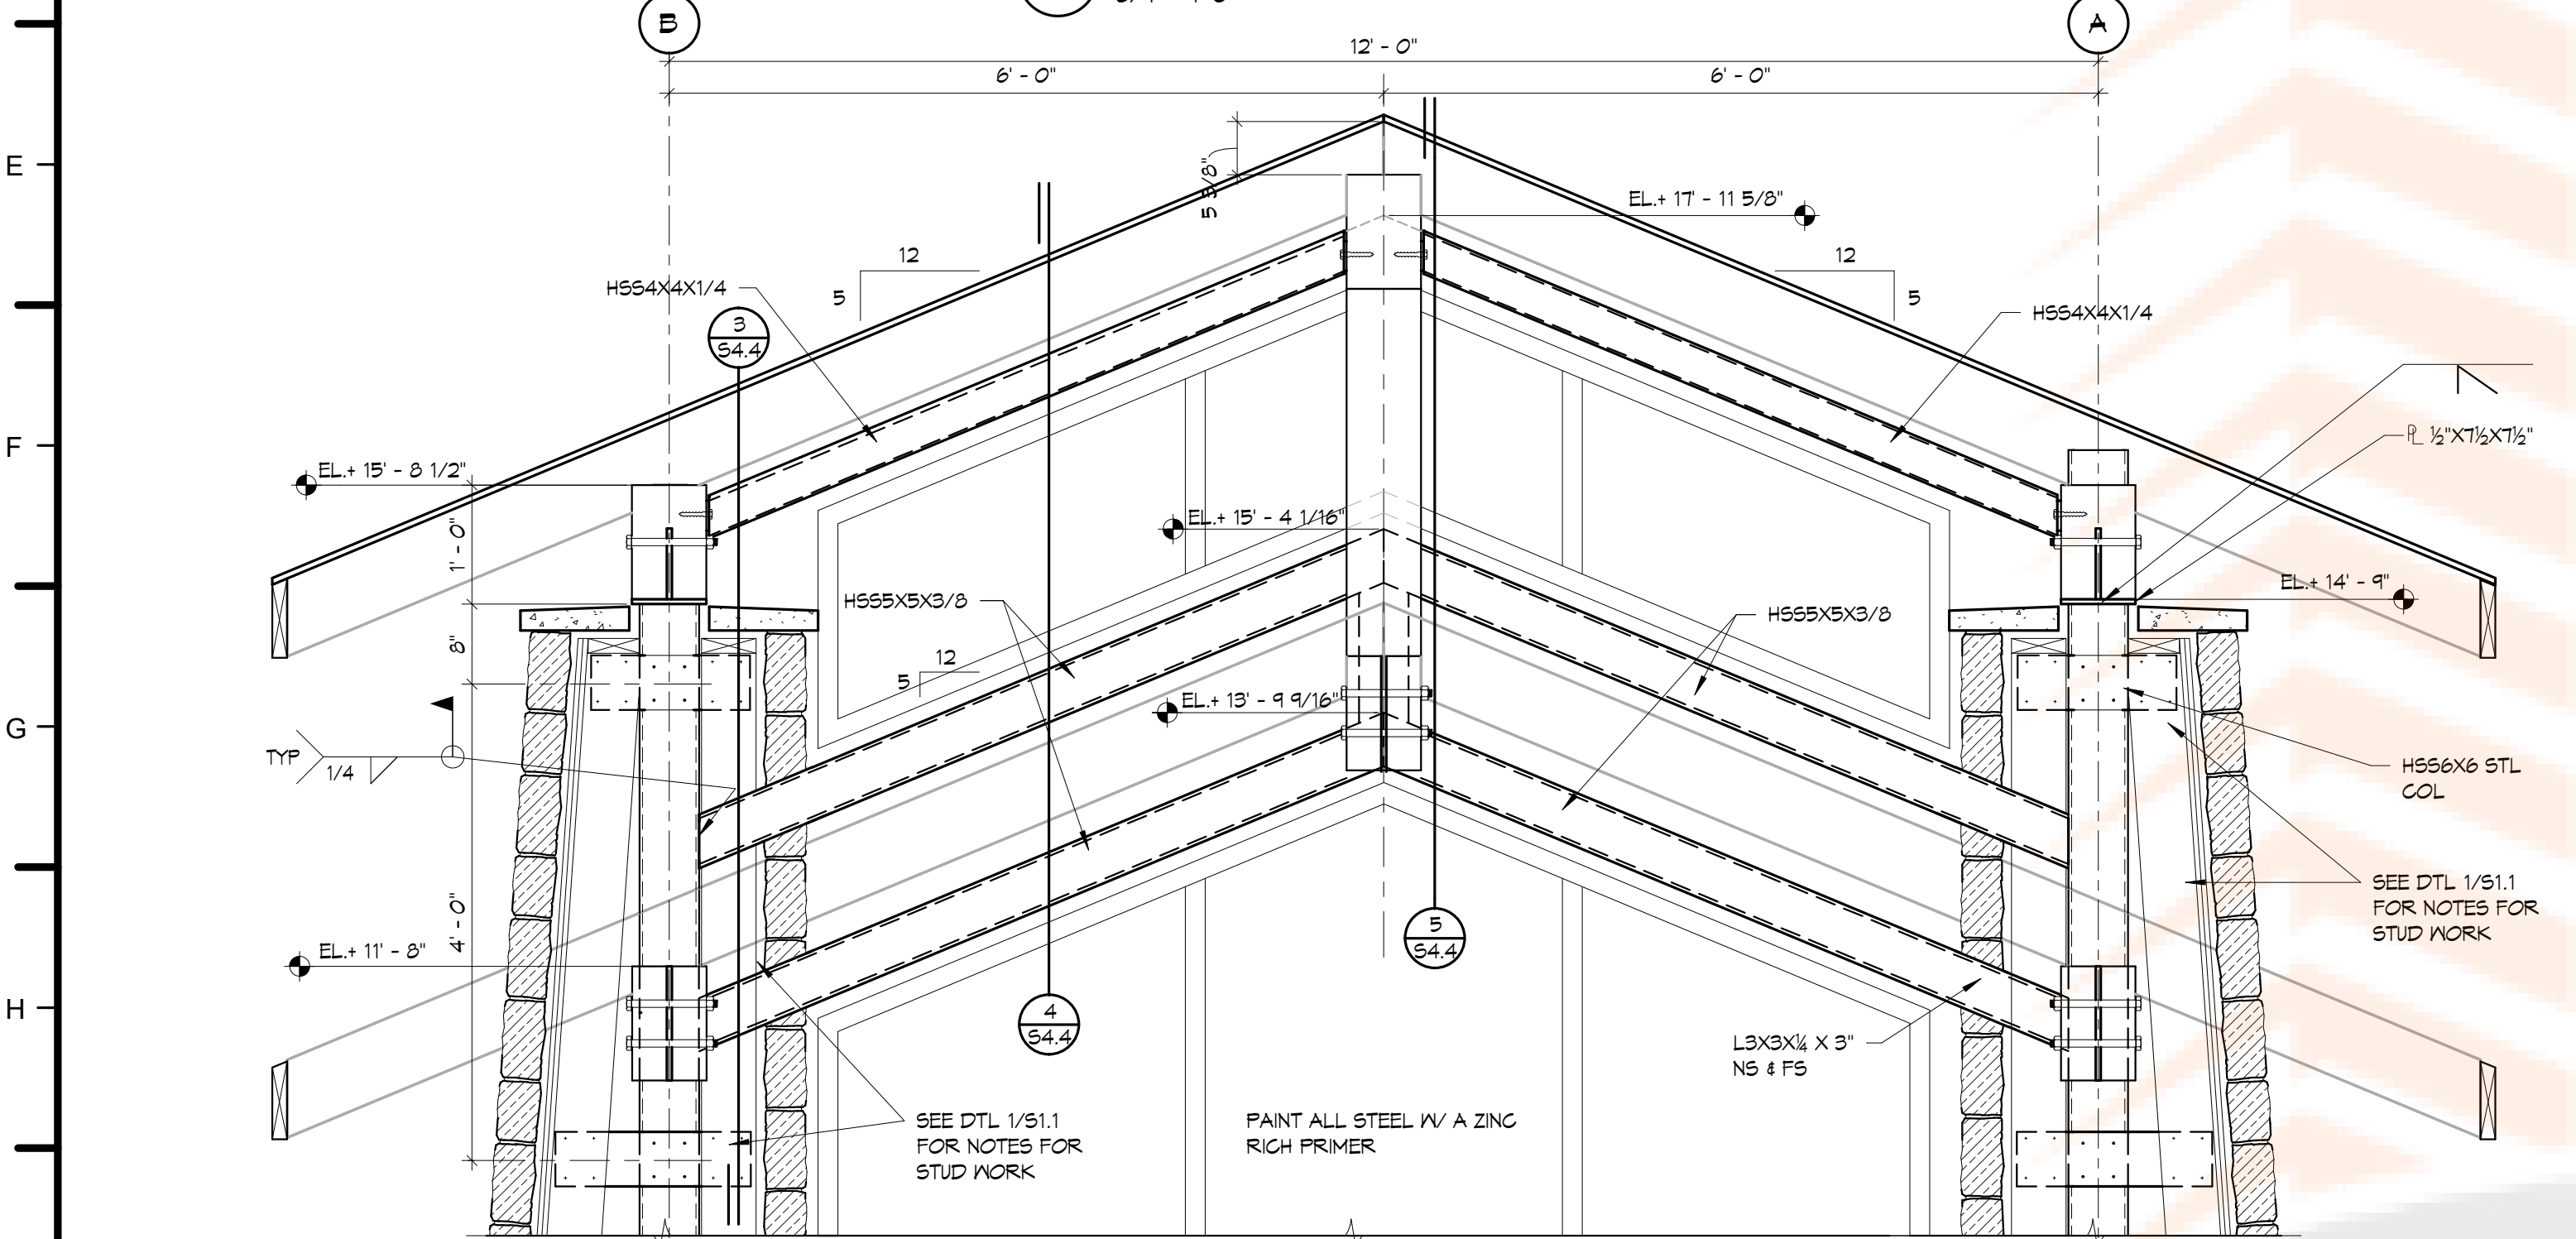


2 ELEVATION @ ENTRY CURTAIN WALL
3/4" = 1'-0"

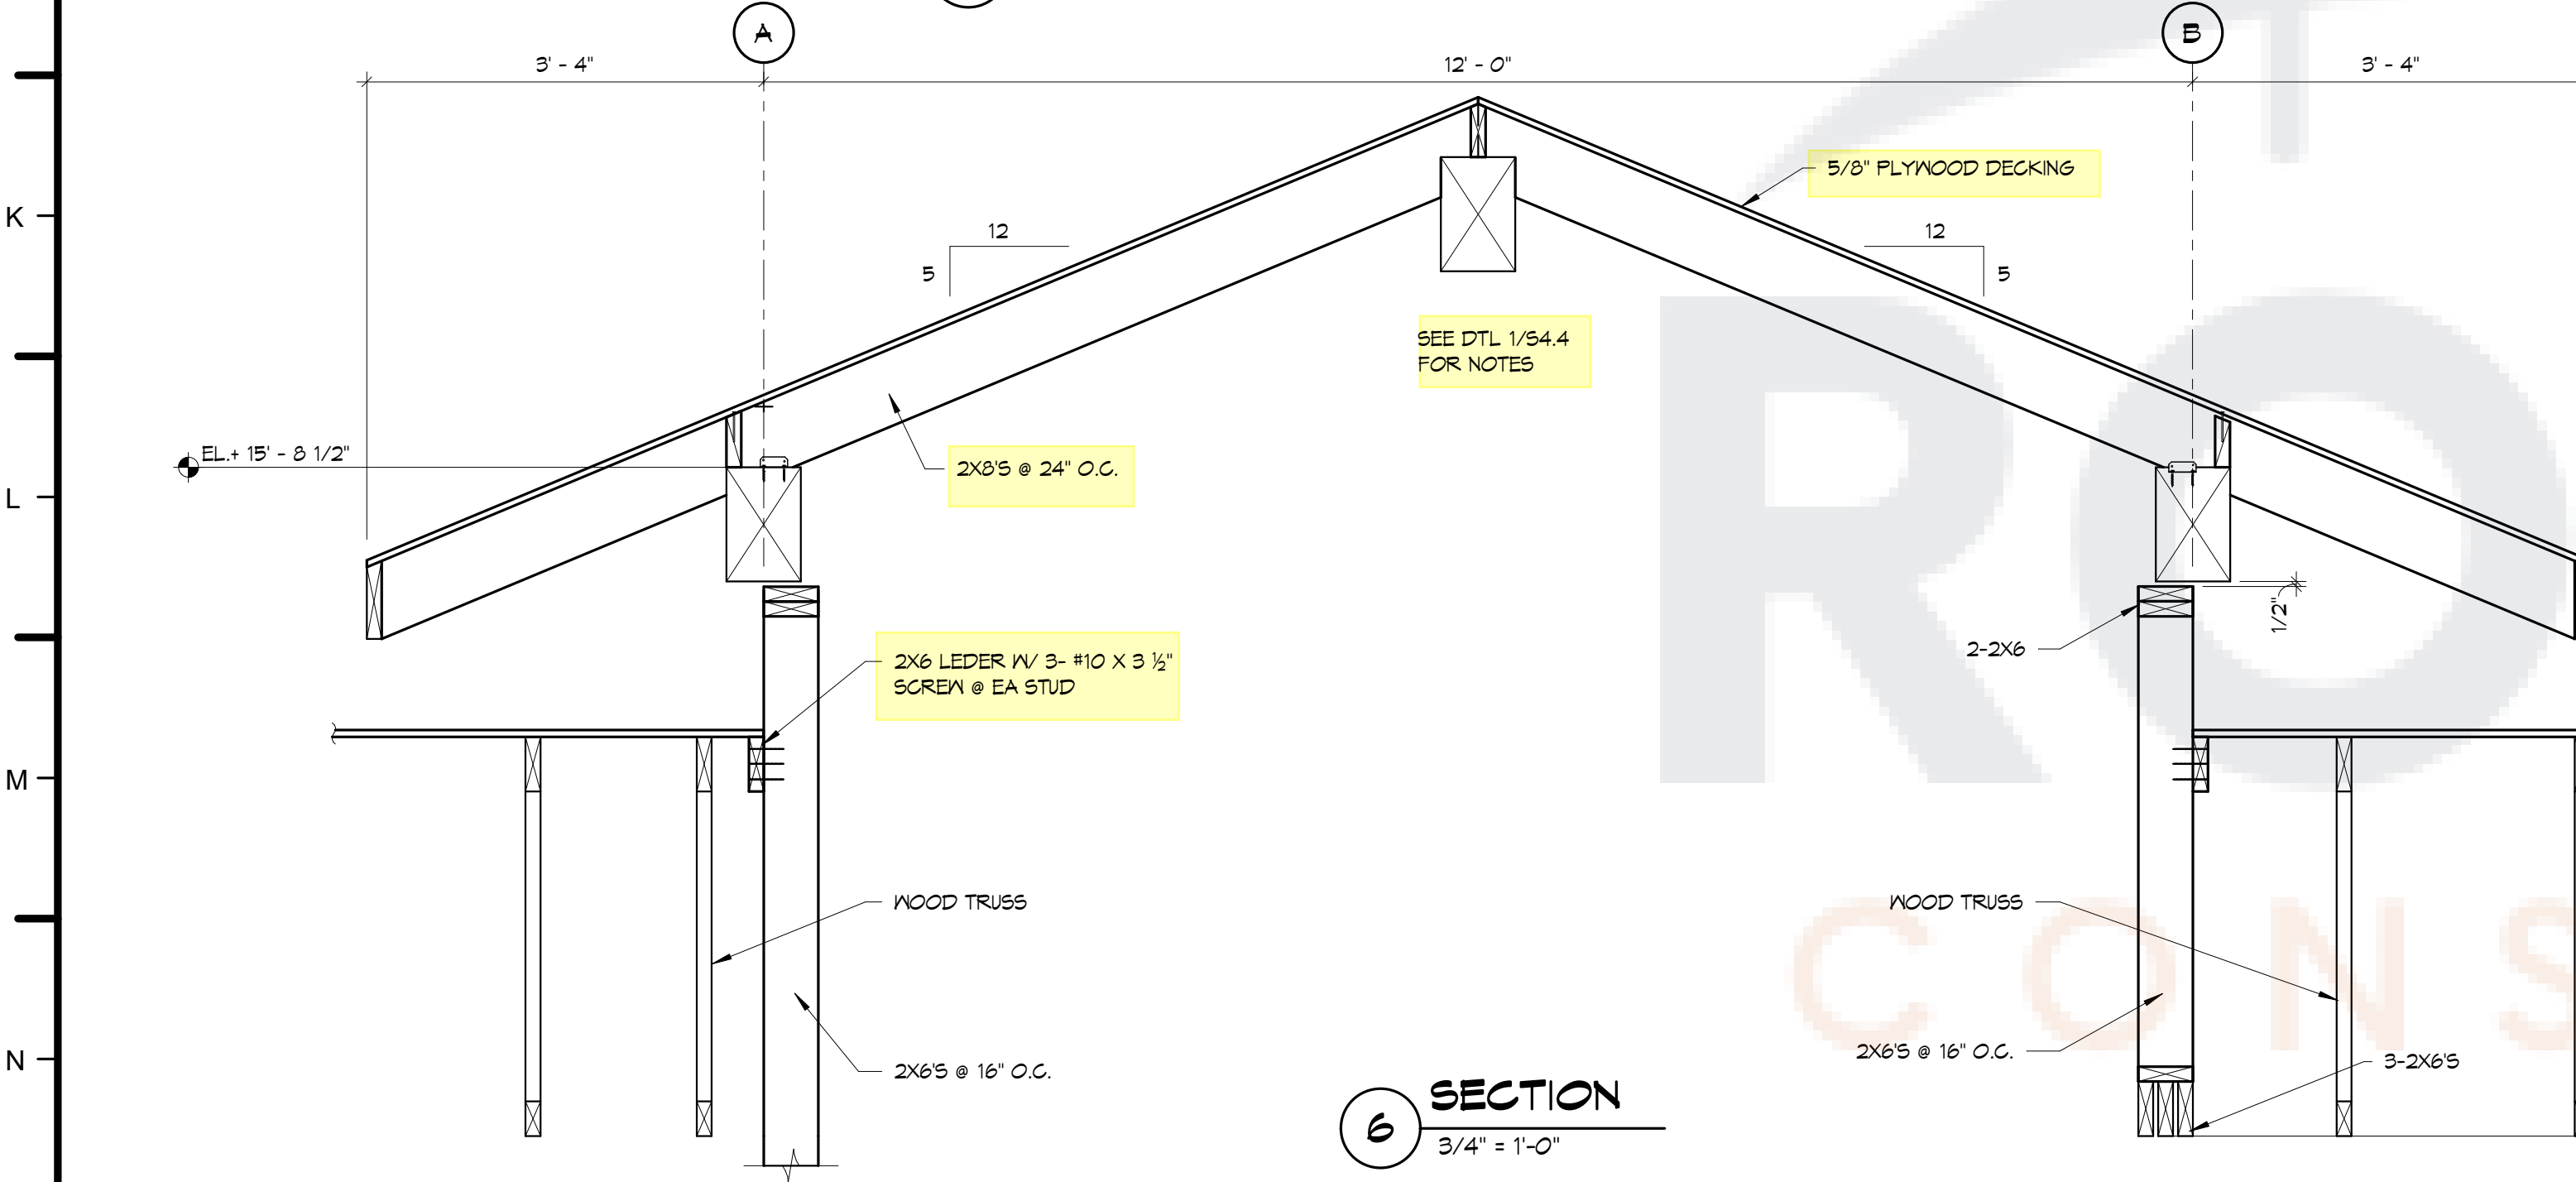


6 SECTION
3/4" = 1'-0"

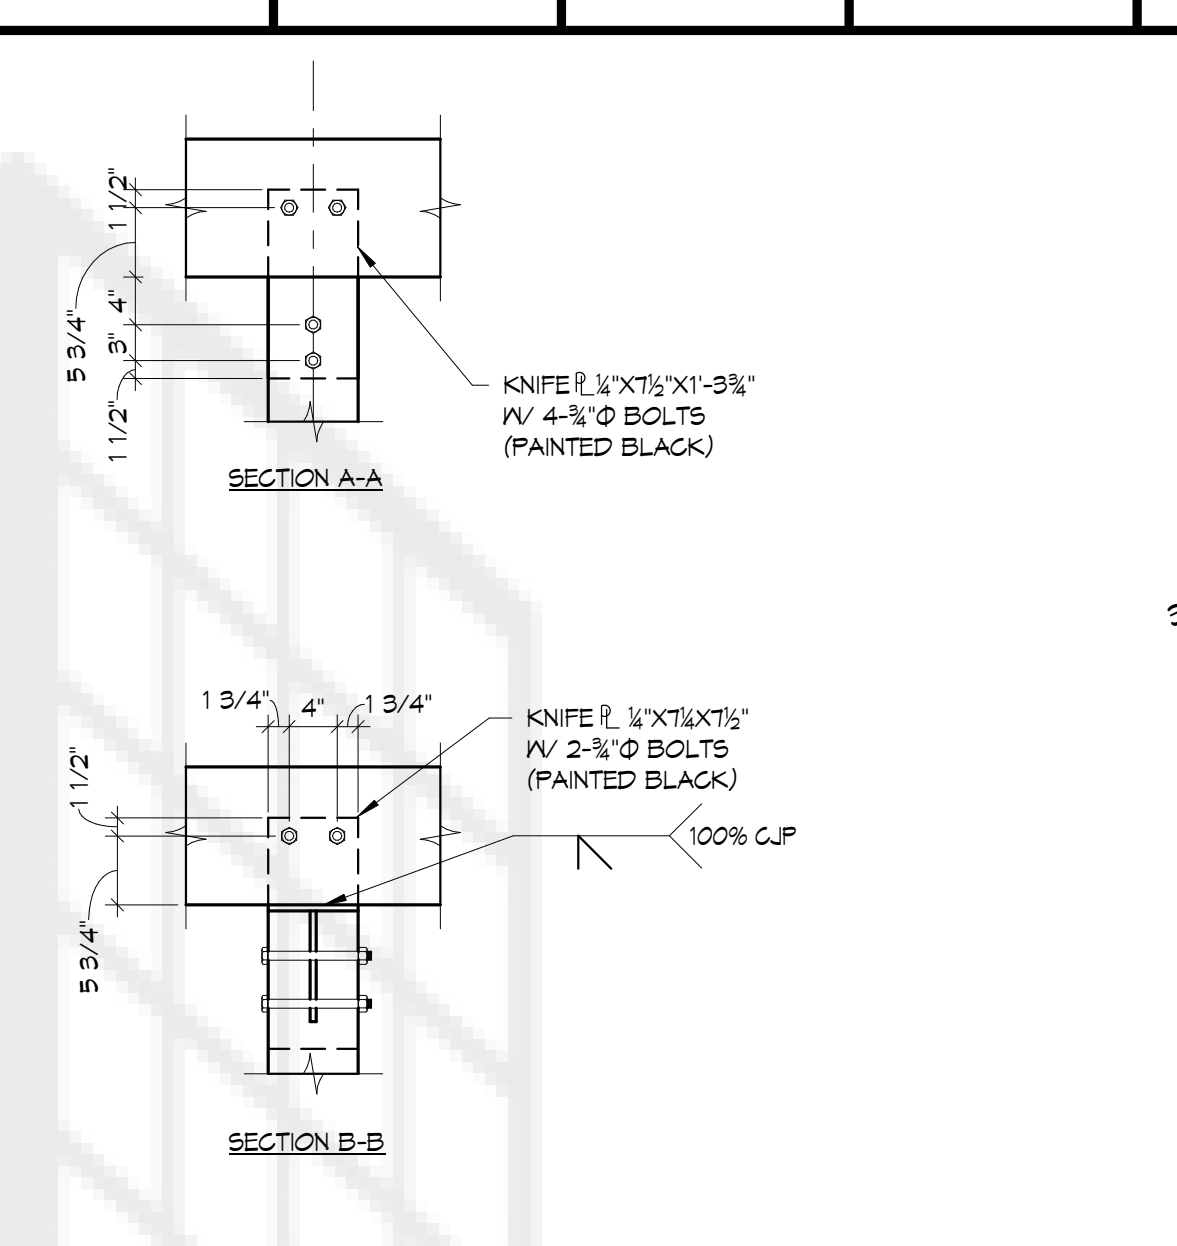


SECTION A-A
SECTION B-B

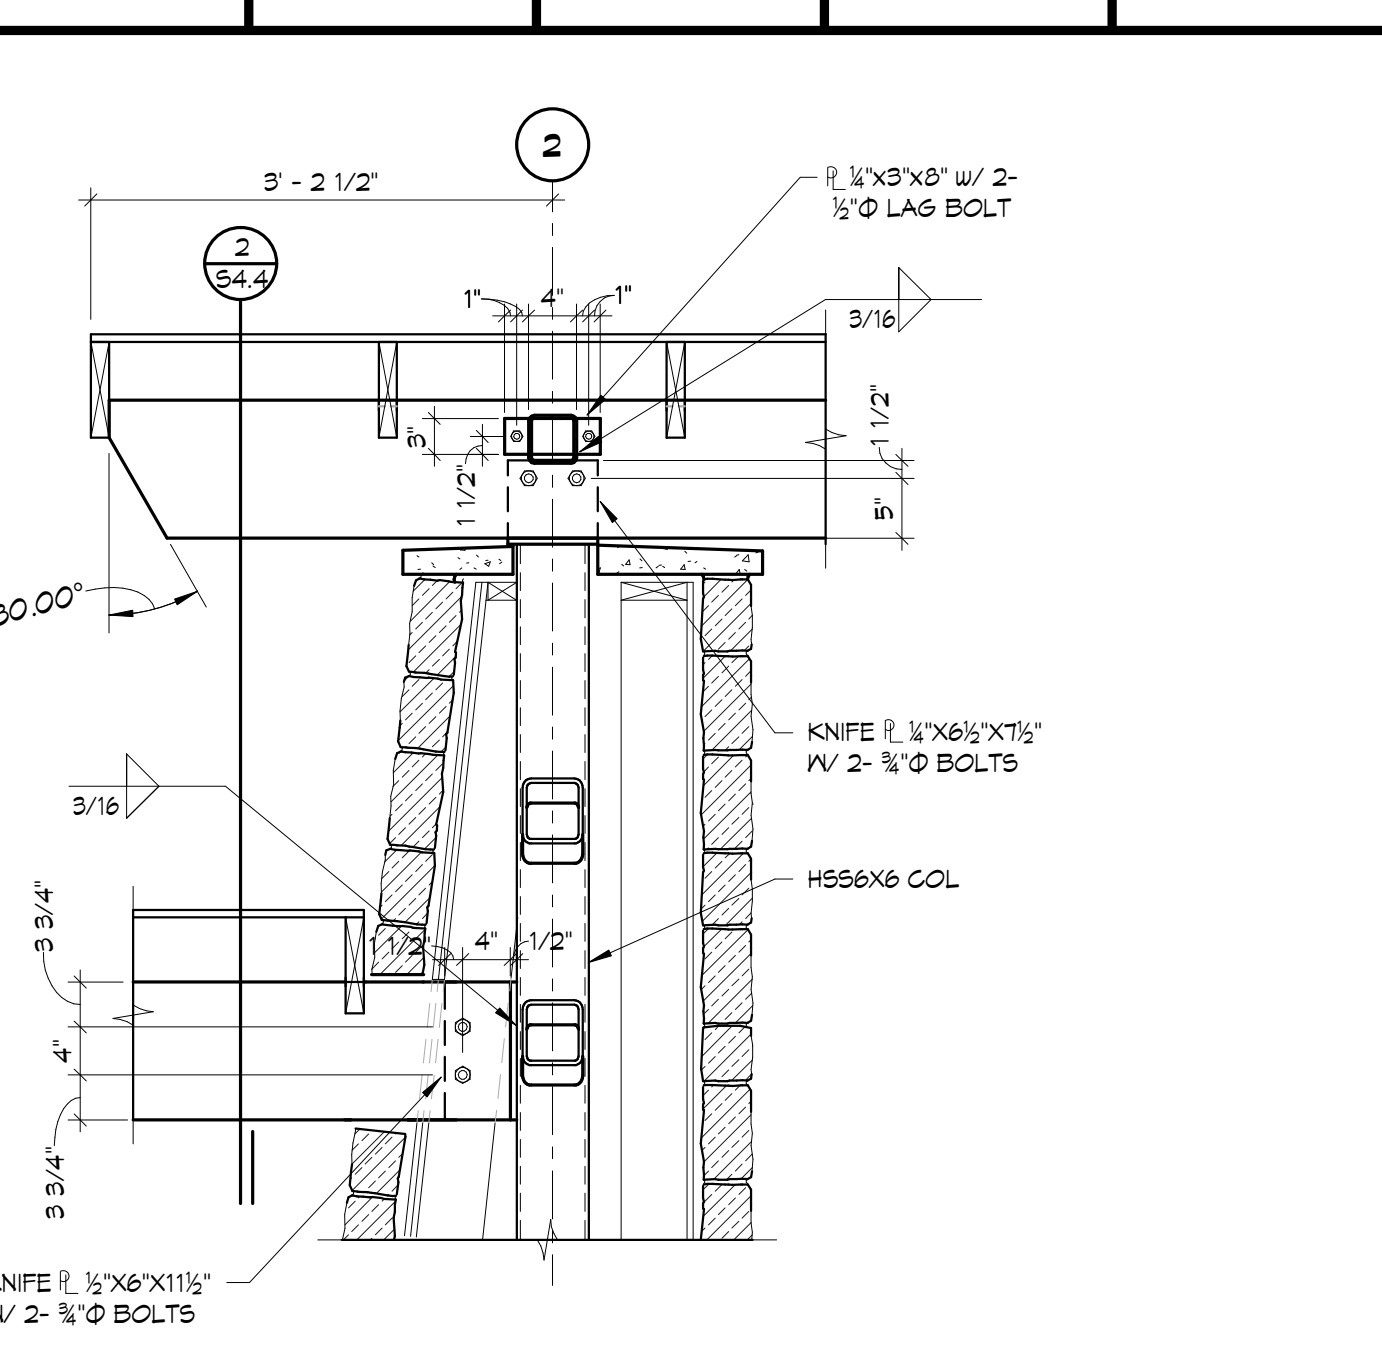


3 SECTION
3/4" = 1'-0"

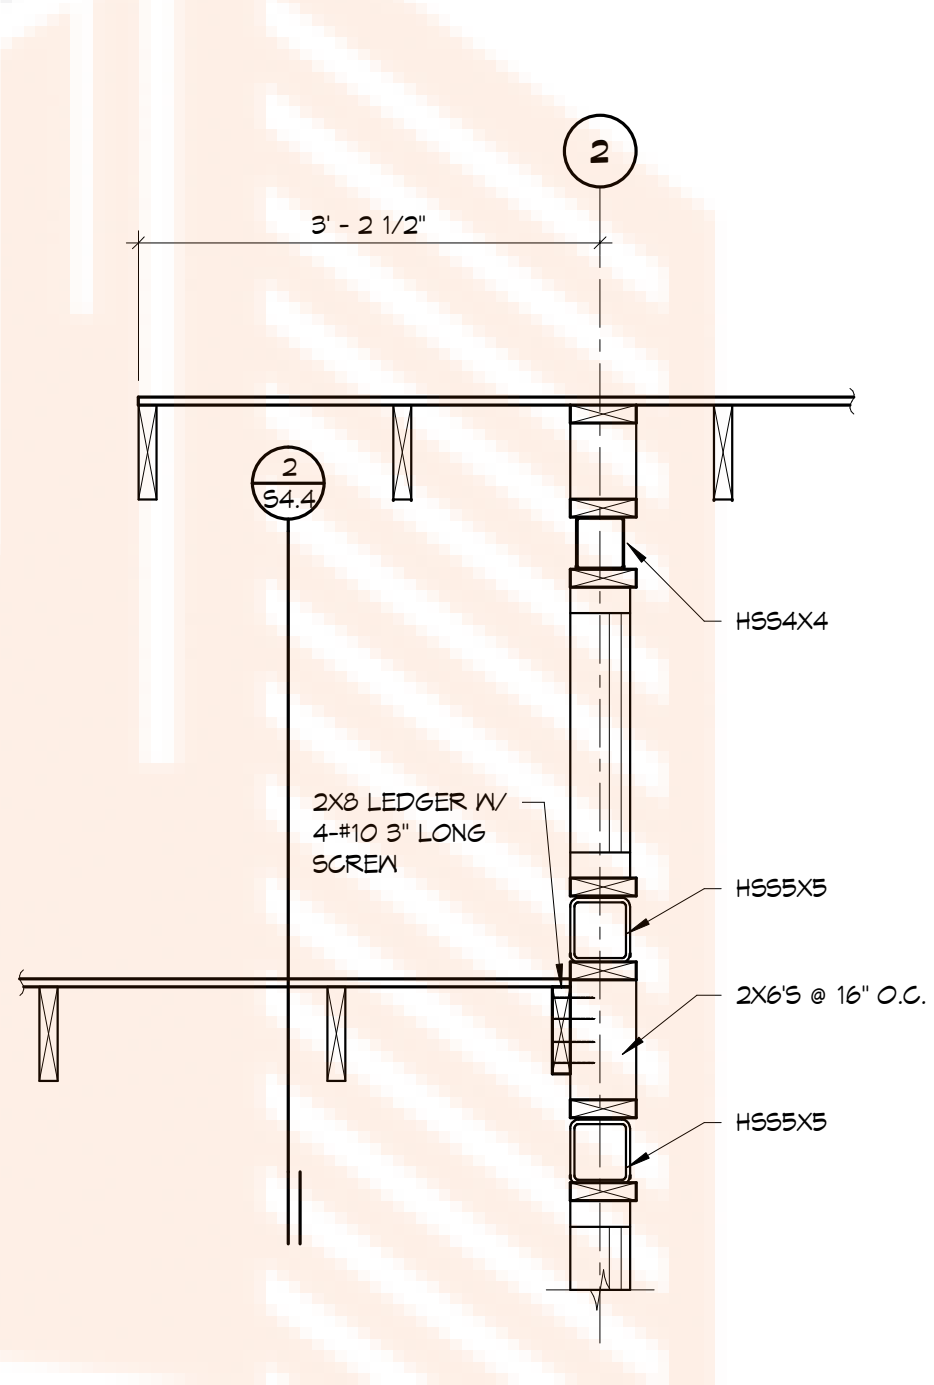

4 SECTION
3/4" = 1'-0"

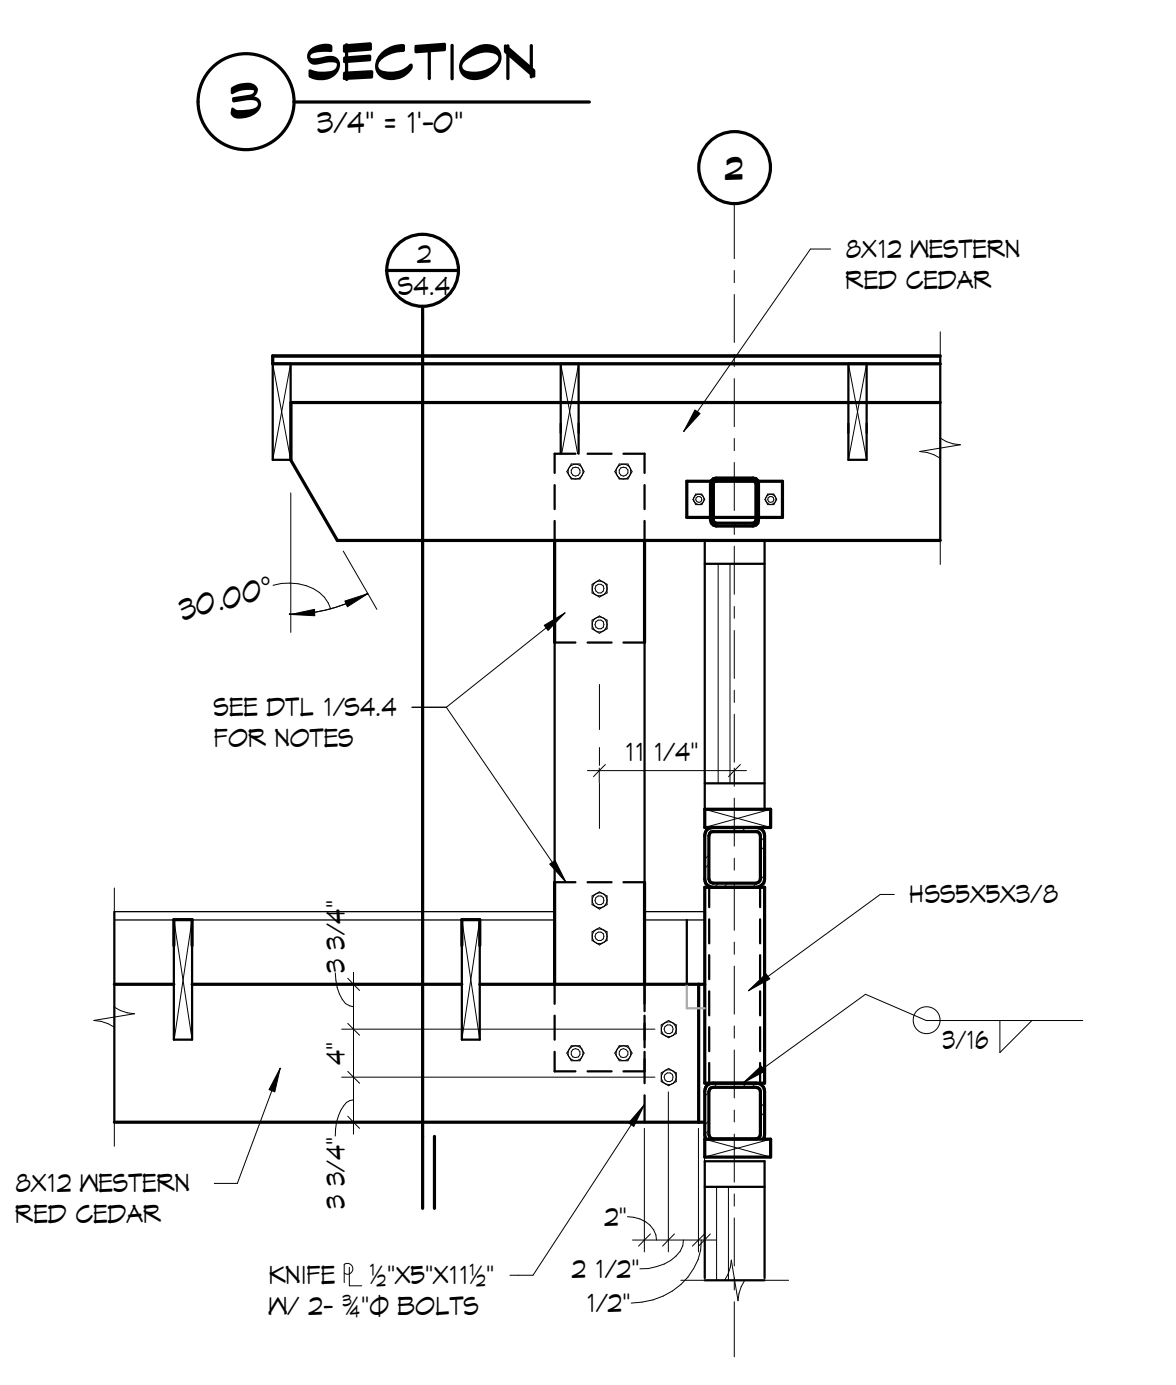

5 SECTION
3/4" = 1'-0"

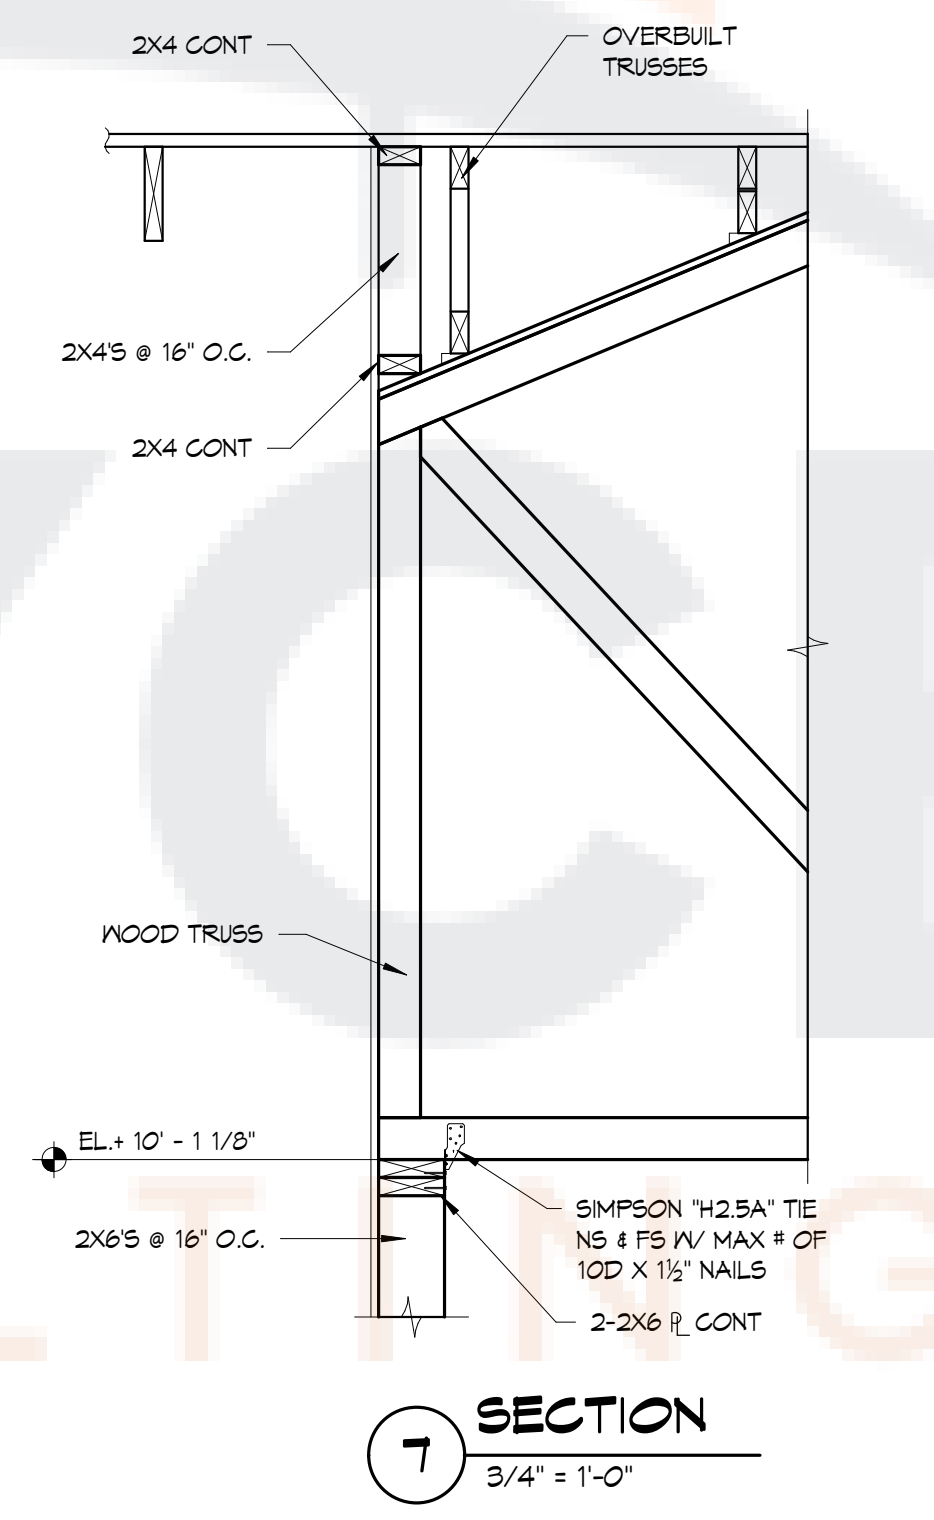

7 SECTION
3/4" = 1'-0"

General Notes

ENGINEERING CONSULTANTS INC.
401 WEST CAPITOL AVE SUITE #305
LITTLE ROCK AR 72201-3459

**NORTH LITTLE ROCK
FIRE DEPARTMENT
STATION 8**


**Jackson
Brown
Palculict**
architects

Date
4/25/22
Revisions

Sheet Title
**FRAMING
DETAILS**

Sheet Number
S4.4

12921 Cantrell Road, Suite 201
Little Rock, AR 72223
501.664.8700 tel
501.664.5189 fax
www.jbparchitects.com

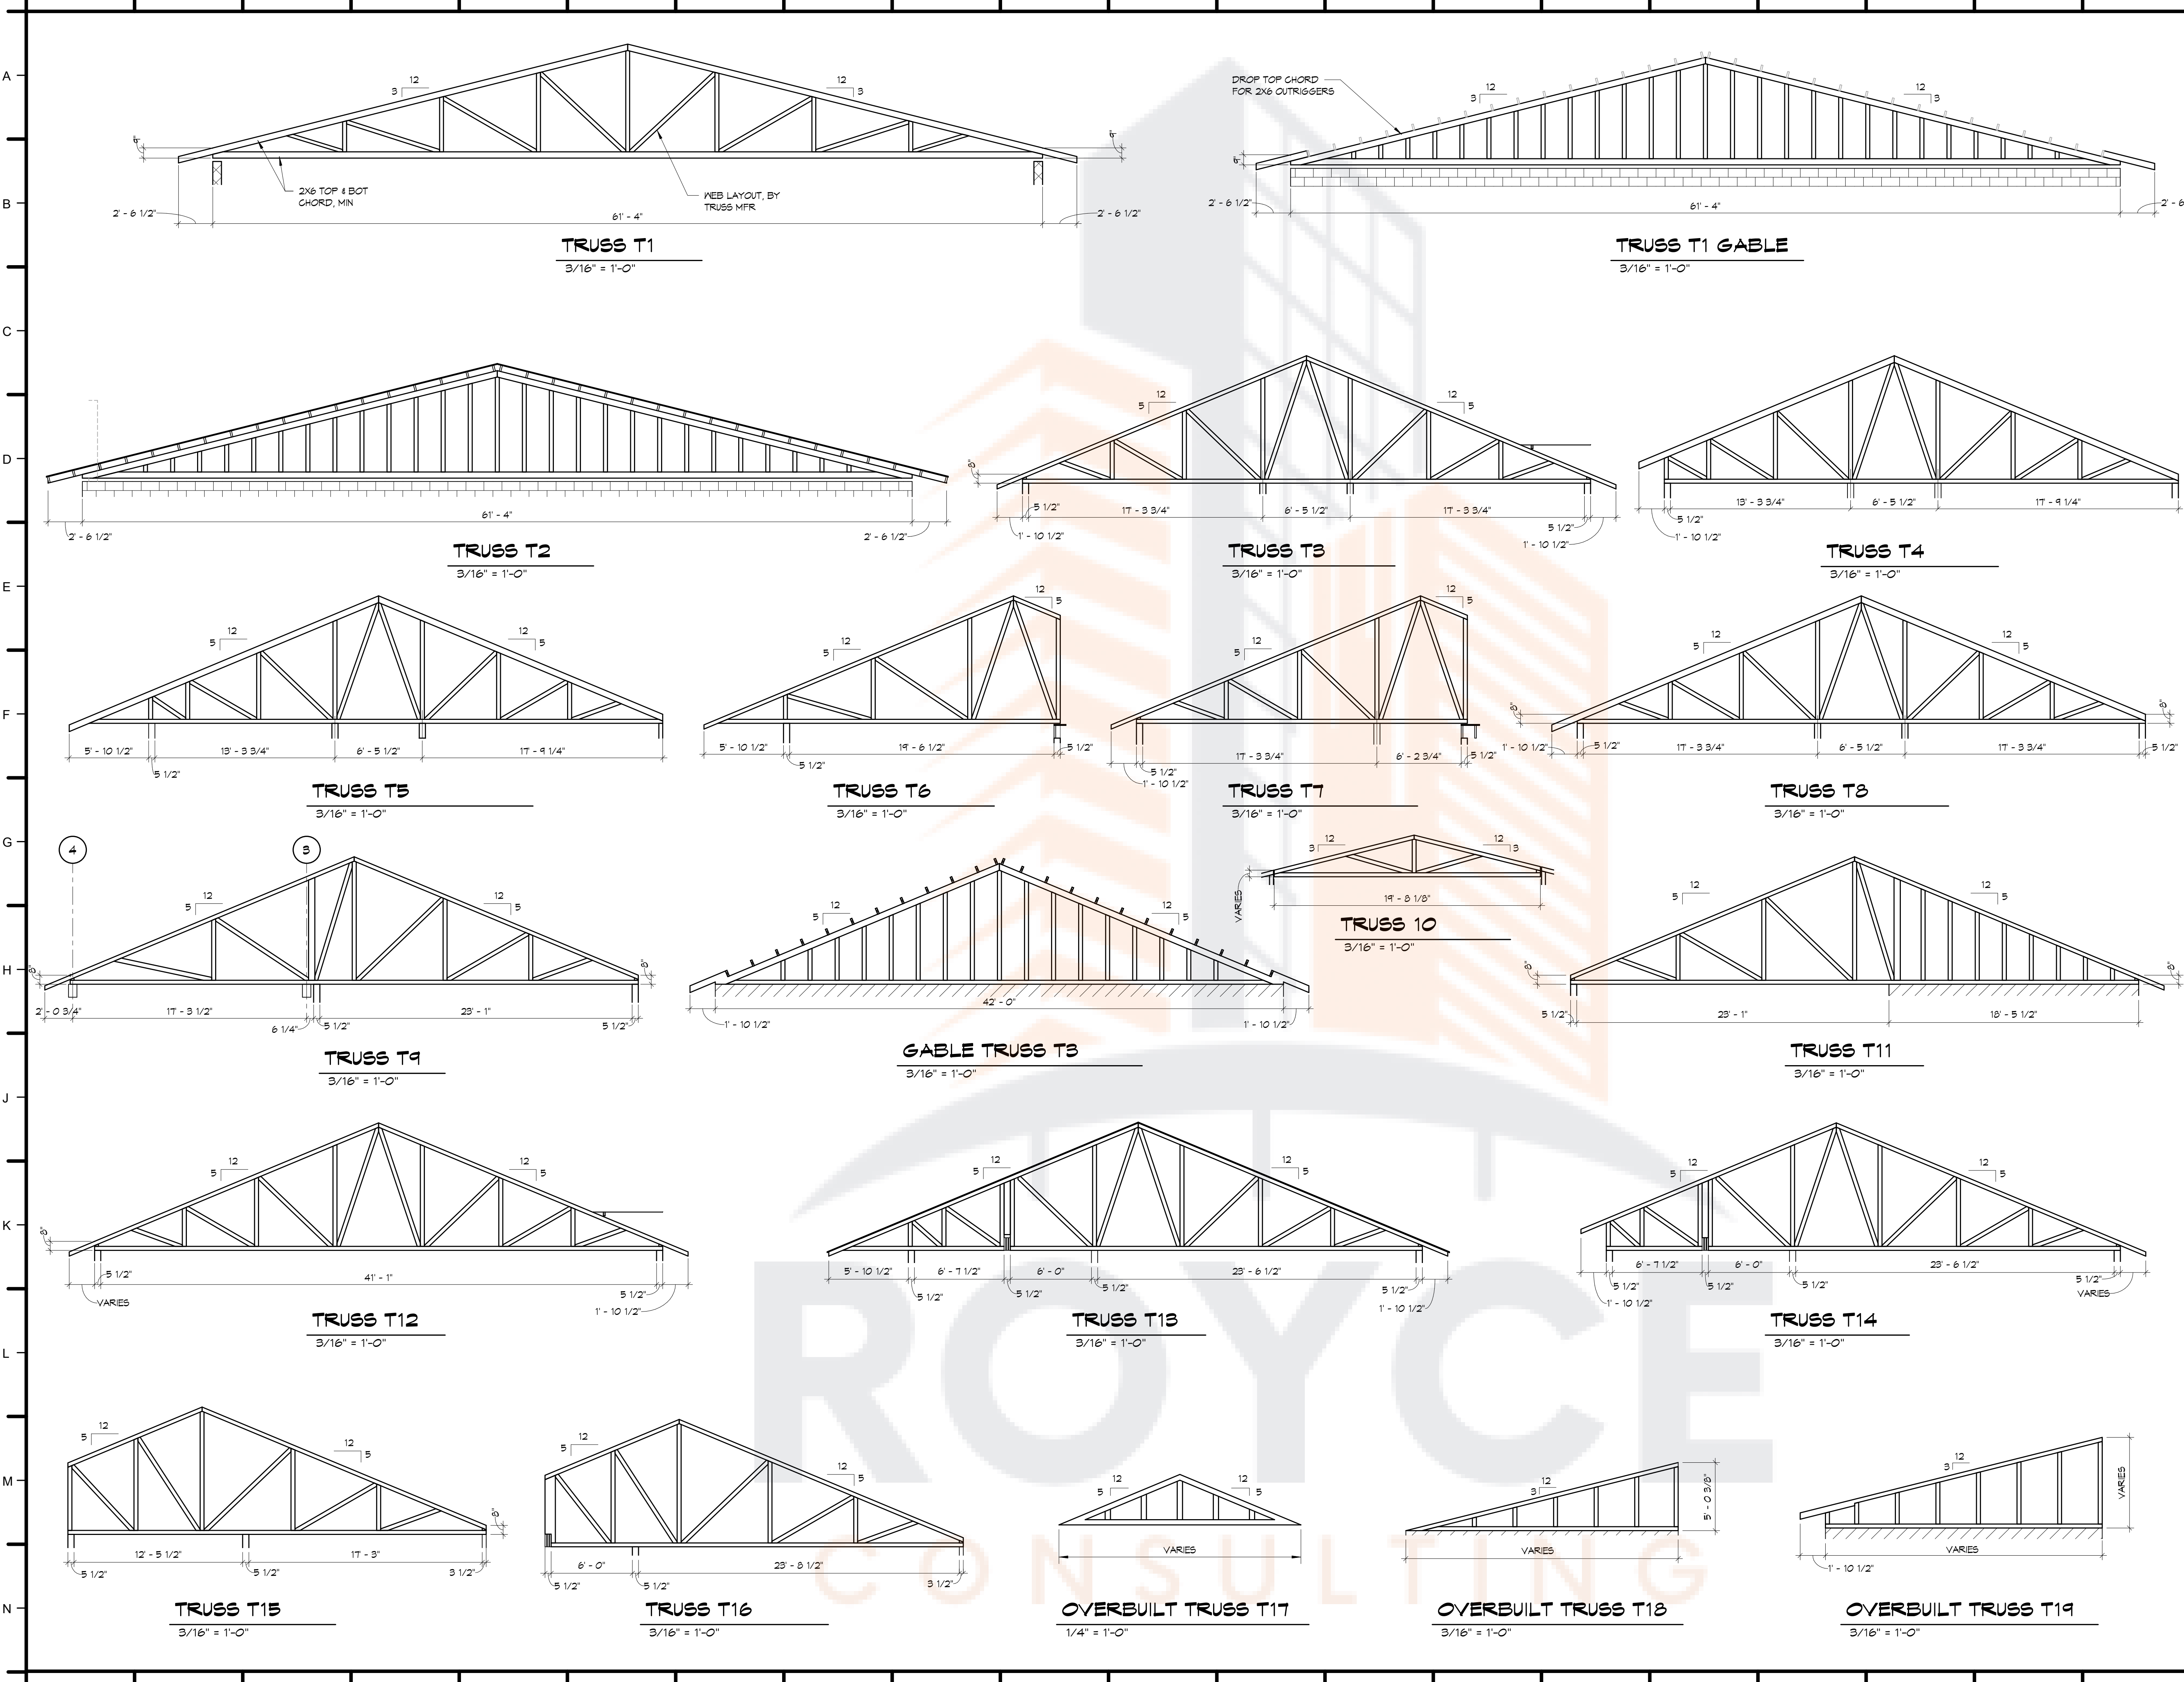

General Notes

STATE OF ARKANSAS
REGISTERED PROFESSIONAL ENGINEER
No. 9682
STEPHEN HARRISON

4/25/22
ENGINEERING CONSULTANTS INC.
401 WEST CAPITOL AVE SUITE #305
LITTLE ROCK AR 72201-3459

**NORTH LITTLE ROCK
FIRE DEPARTMENT
STATION 8**

**Jackson
Brown
Palculict
architects**


Date
4/25/22
Revisions

JOB NUMBER Project Number

Sheet Title
TRUSS PROFILES

Sheet Number
S5.1

12921 Cantrell Road, Suite 201
Little Rock, AR 72223
501.664.8700 tel
501.664.5189 fax
www.jbparchitects.com

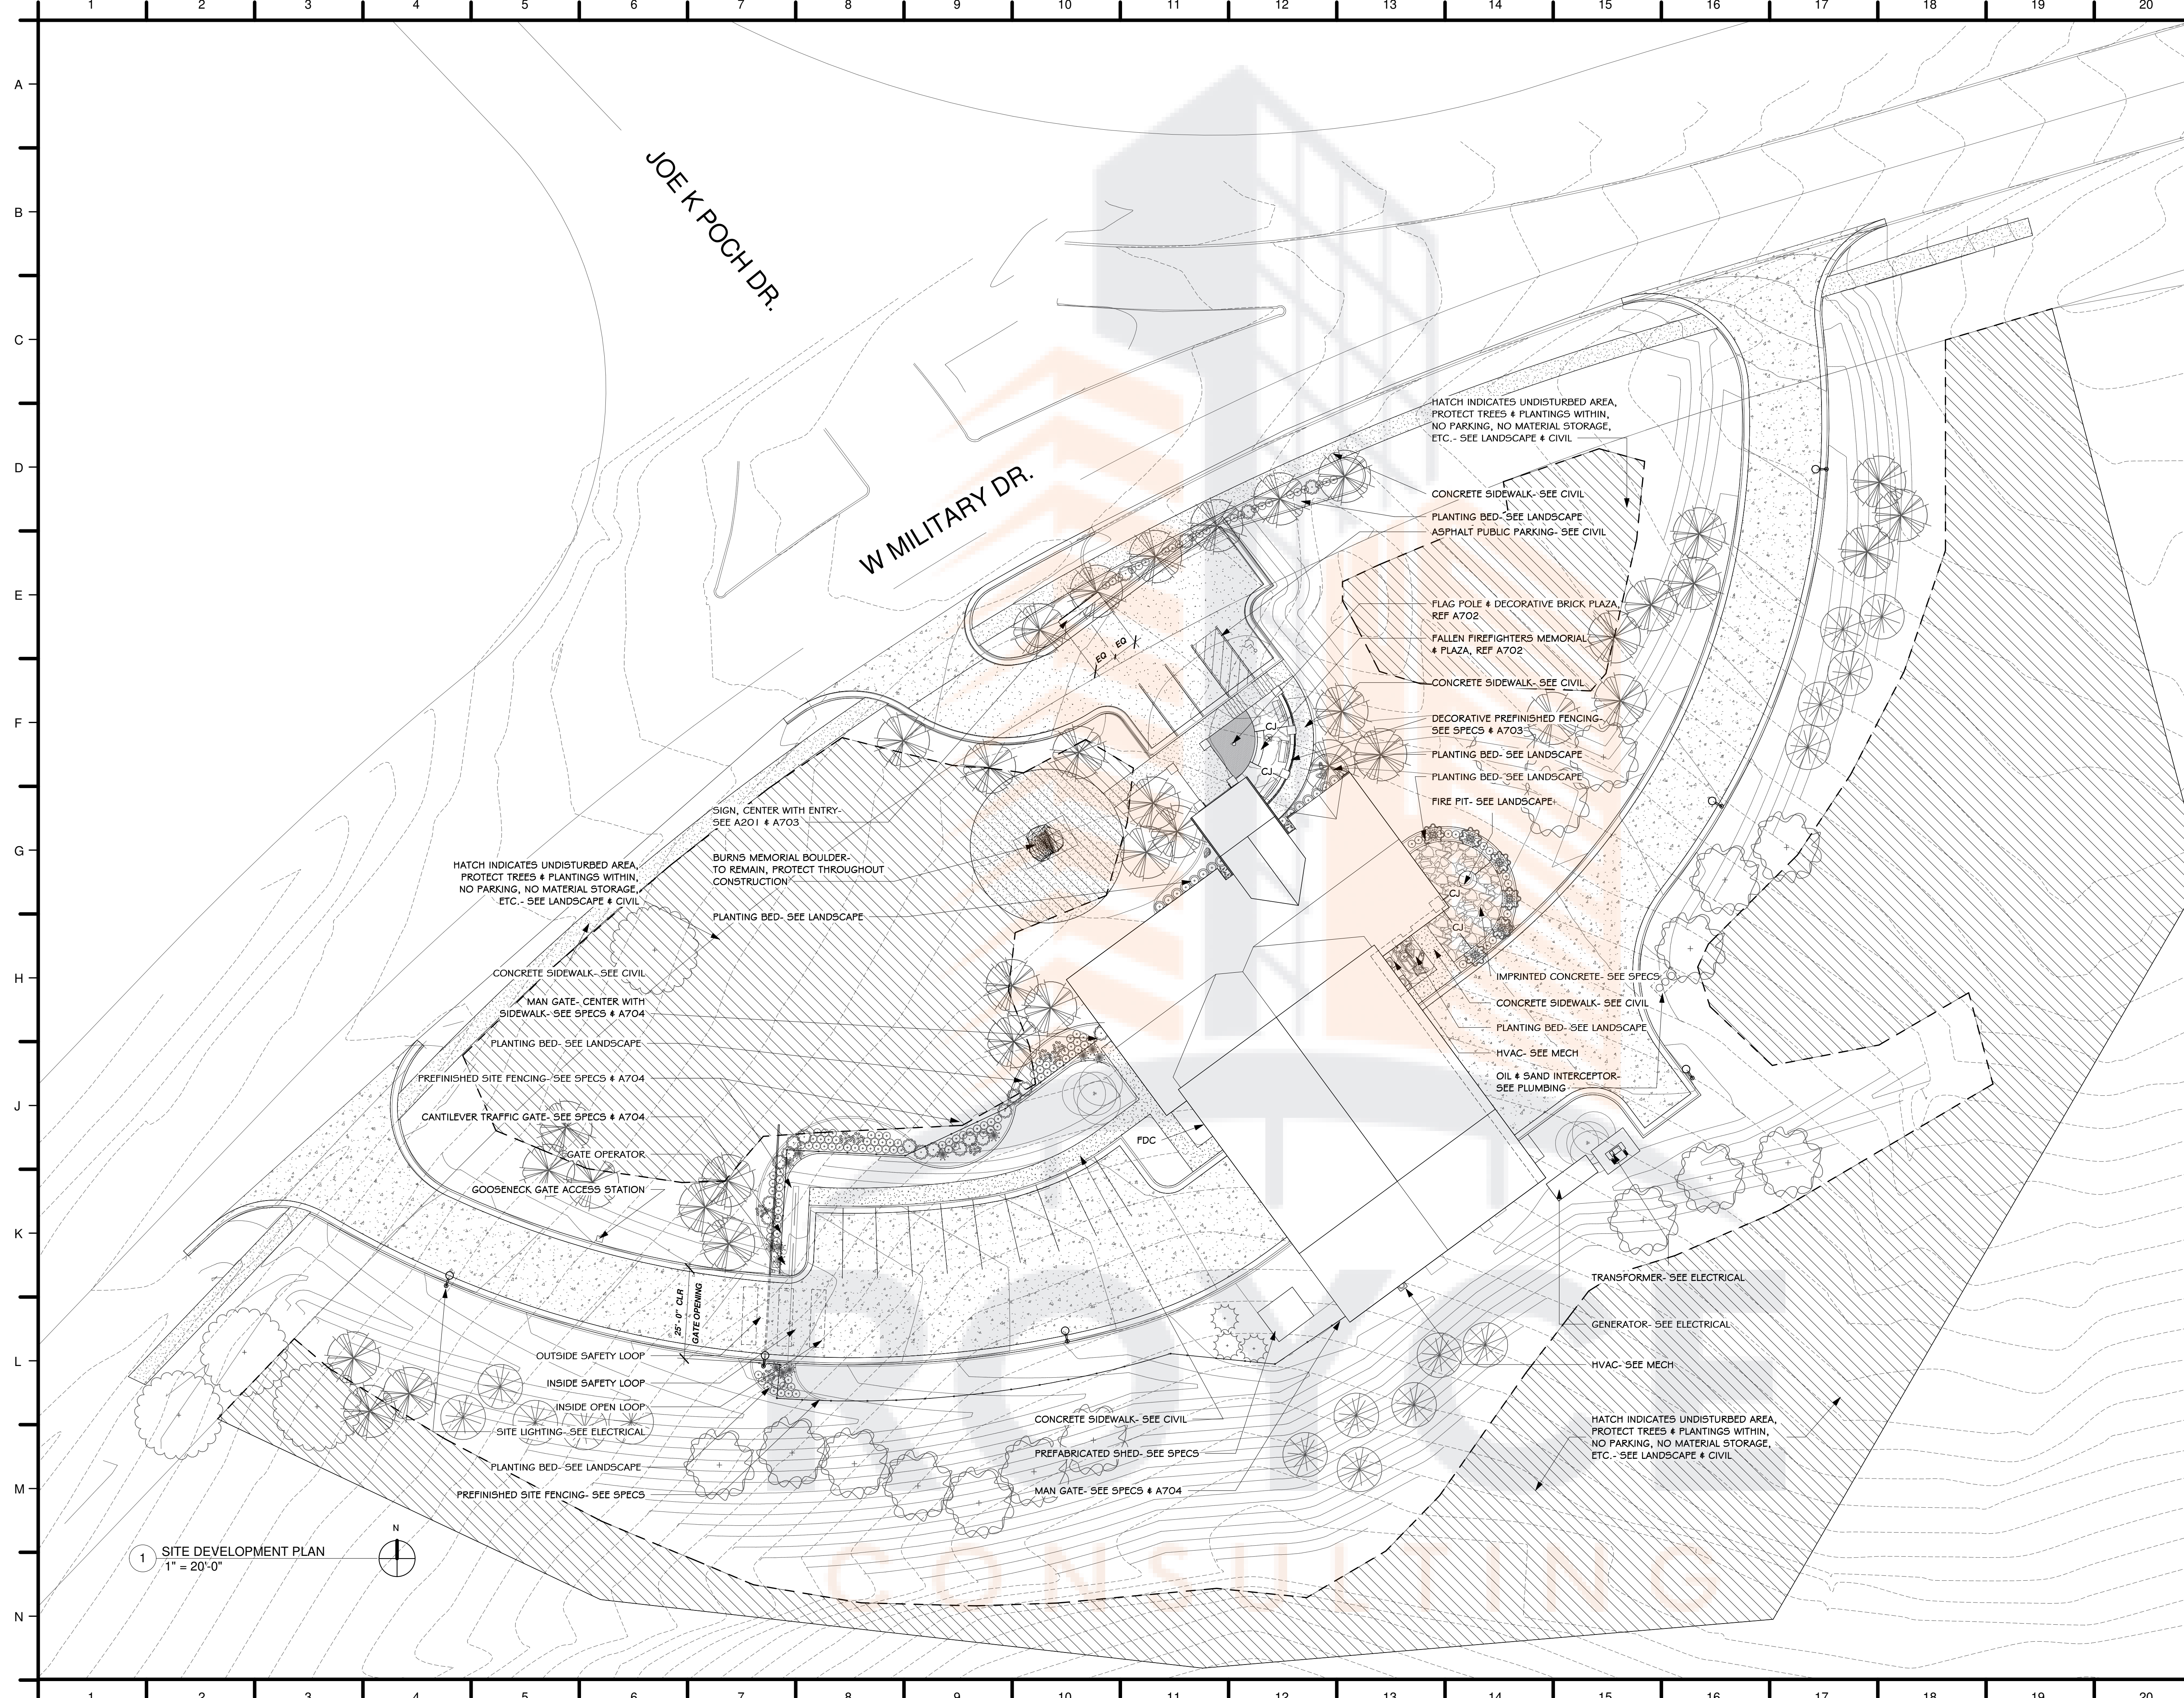

General Notes

**NORTH LITTLE ROCK
FIRE DEPARTMENT
STATION 8**

**Jackson
Brown
Palculict
architects**

Date
4/11/22
Revisions


JOB NUMBER 2203


Sheet Title
**SITE
DEVELOPMENT
PLAN**

Sheet Number
A100

12921 Cantrell Road, Suite 201
Little Rock, AR 72223
501.664.8700 tel
501.664.5189 fax
www.jbpaarchitects.com


1 SITE DEVELOPMENT PLAN
1" = 20'-0"

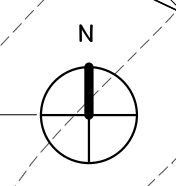

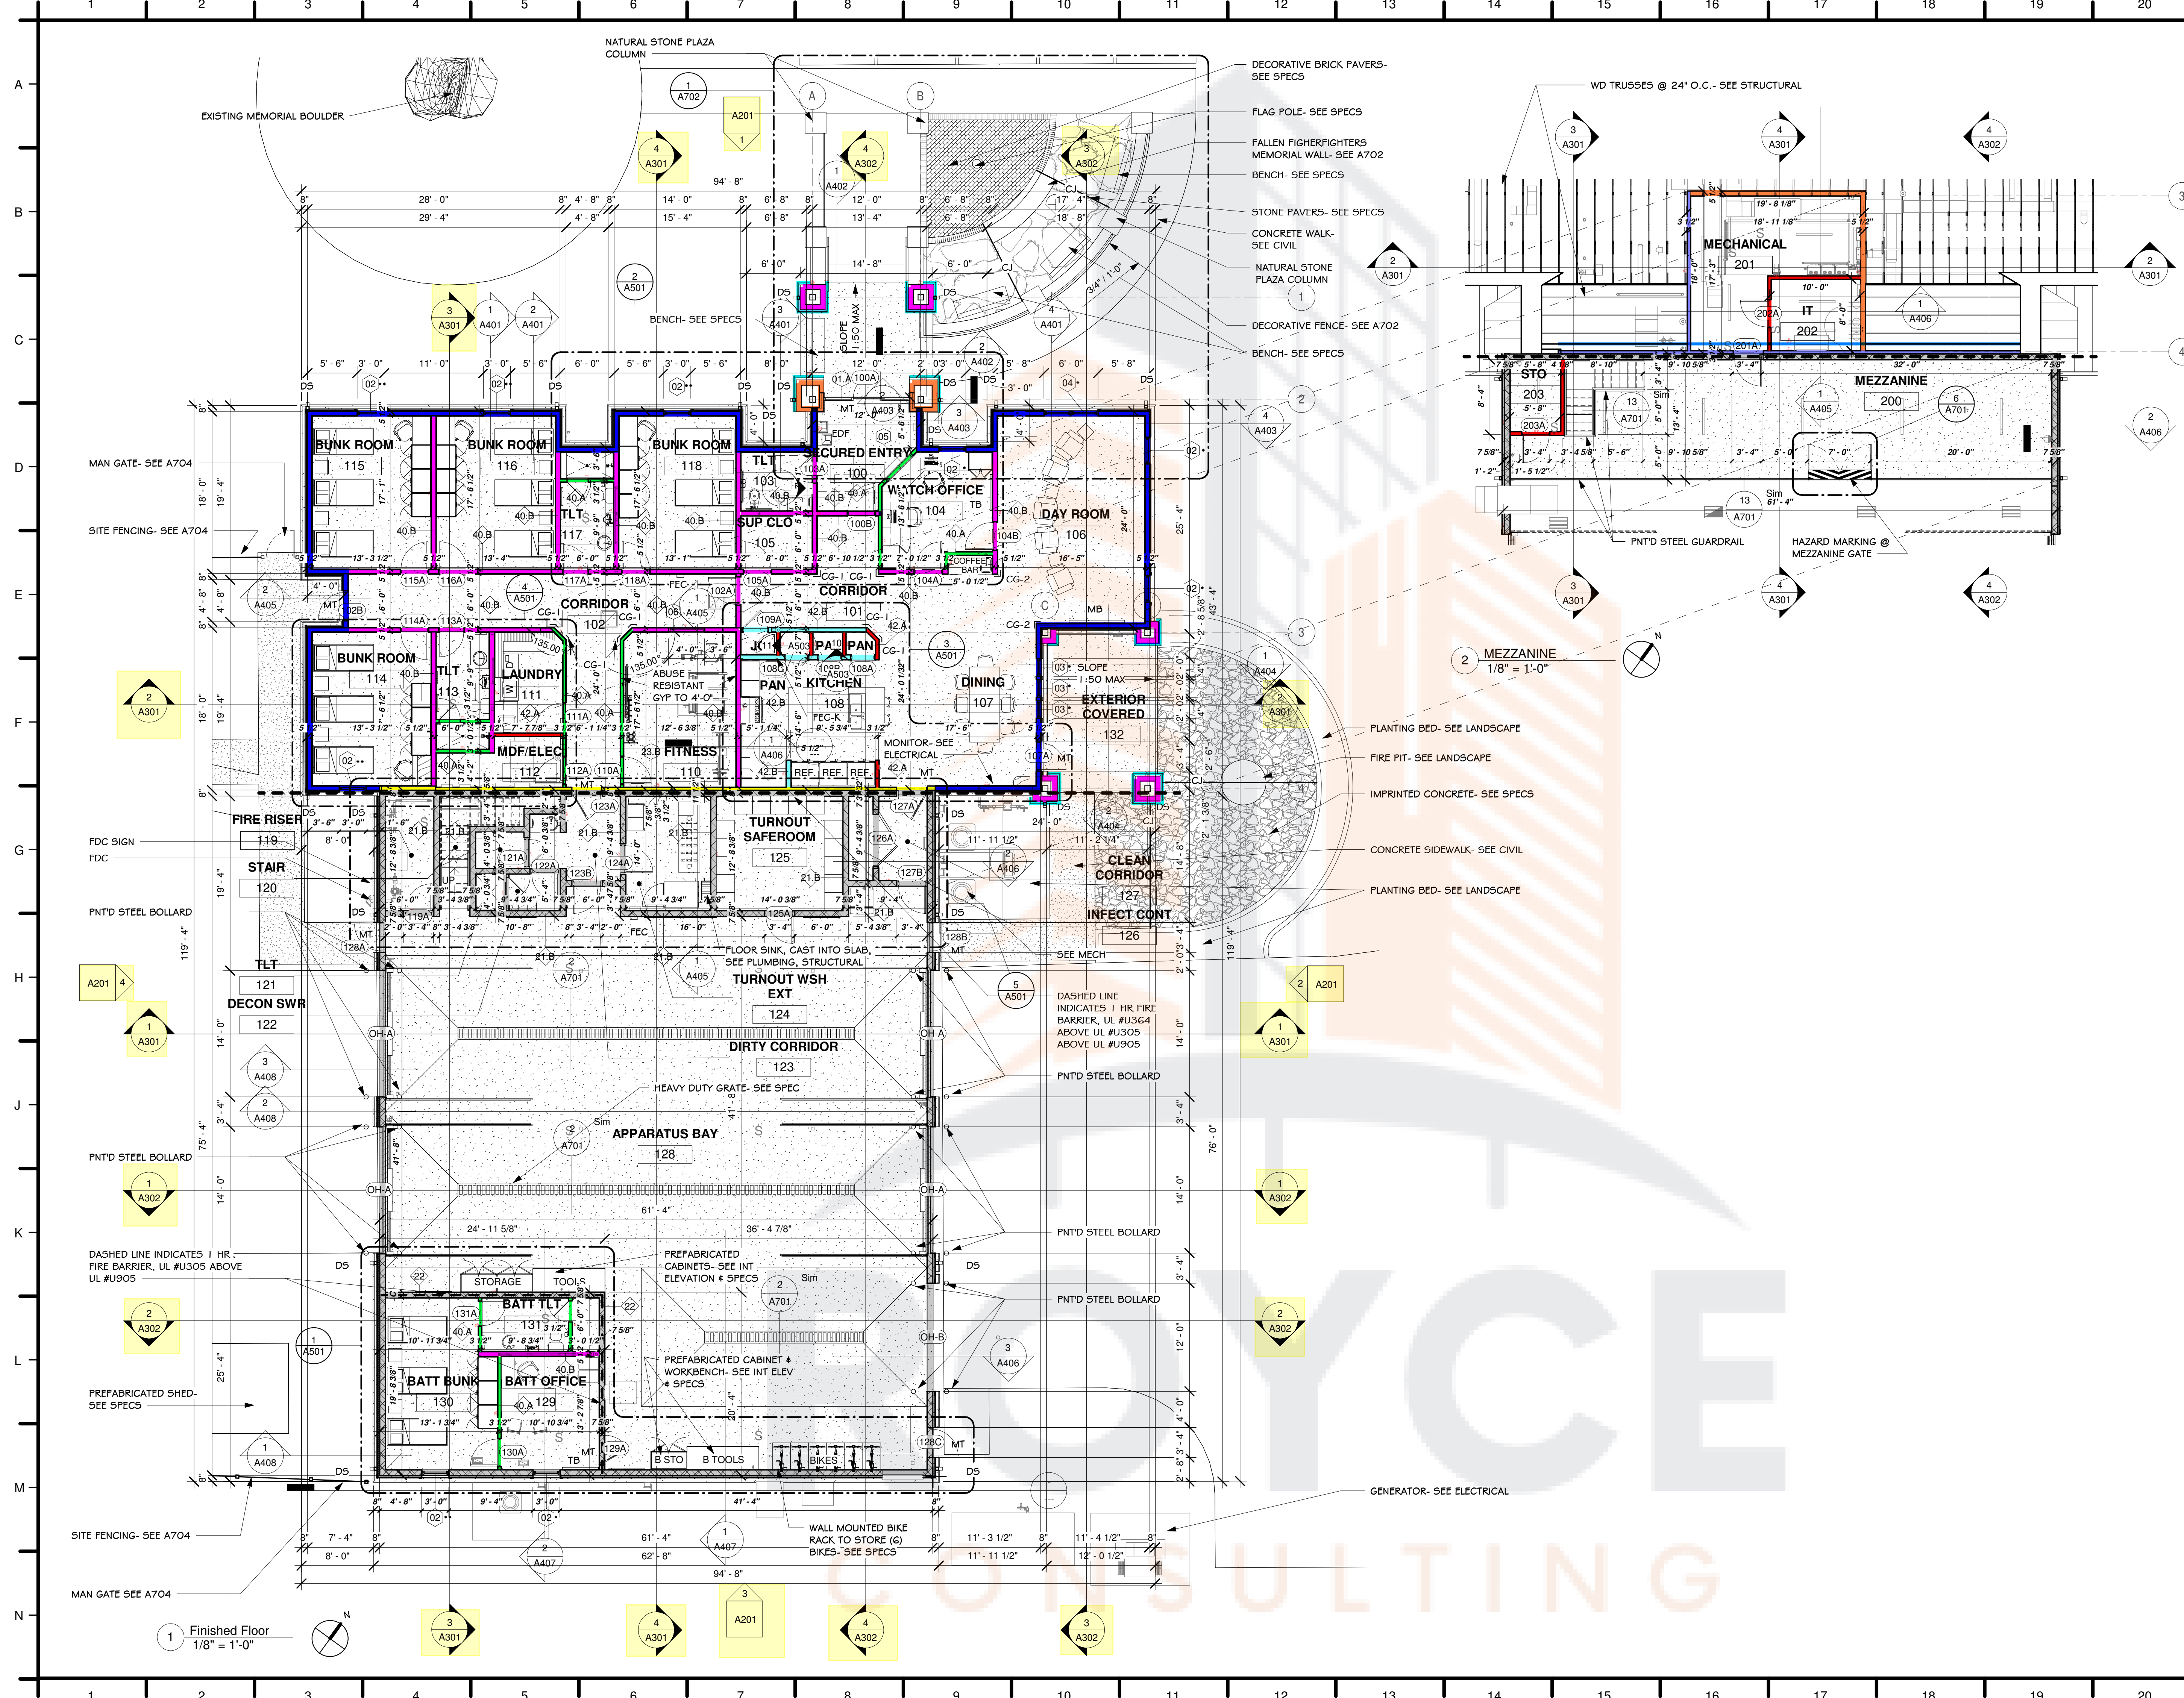

- General Notes**
- ALL DIMENSIONS ARE TO THE FACE OF STUD OR BLOCK.
 - FIRE EXTINGUISHER CABINETS (FEC) ARE TO BE MOUNTED 48" A.F.F. TO THE TOP OF THE CABINET.
 - ALL SWITCHES TO BE MOUNTED NO HIGHER THAN 48" A.F.F.
 - MOUNT THERMOSTATS 54" A.F.F. MAX.
 - FURNITURE N.I.C. SHOWN FOR REFERENCE ONLY.
 - ALL DOOR HARDWARE TO MEET ADA REQUIREMENTS.
 - PROVIDE 3" TALL HELVETICA LETTERS STENCILED AT ALL RATED WALLS, STENCILING TO READ AS FOLLOWS: "FIRE AND SMOKE BARRIER PROTECT ALL OPENINGS". INCLUDE UL NUMBERS TYPICAL OF ALL RATED WALLS.
 - "MT" INDICATES METAL THRESHOLD, PROVIDE AT ALL EXTERIOR DOORS.
 - A.T.P. INDICATES ADA TRAP PROTECTION, PROVIDE ON ALL EXPOSED SINK/AV TRAPS.
 - PROVIDE FIELD PAINTING OF HANGERS, EXPOSED STEEL, AND IRON WORK, OF PRIMED METAL SURFACES AND EXPOSED-TOP VIEW METAL SURFACES OF ITEMS, AS REQUIRED TO MATCH ADJACENT SURFACES AND EQUIPMENT INSTALLED UNDER MECHANICAL AND ELECTRICAL WORK. THIS INCLUDES BUT IS NOT LIMITED TO, ALL EXPOSED CONDUIT, FIRE SPRINKLER PIPING, HANGERS, DUCTWORK, SUPPORTS, ETC. IF IT CAN BE SEEN, PAINT IT. ARCHITECT TO SELECT COLOR OR COLORS.
 - "CJ" INDICATES CONTROL JOINT, SEE SPECS FOR DESCRIPTION OF METHODS AND LOCATIONS.
 - "*" INDICATES WINDOWS THAT ARE TO RECEIVE ROLLER SHADES.
 - "**" INDICATES WINDOWS THAT ARE TO RECEIVE ROLLER SHADES WITH BLACKOUT SHADE.
 - TACKBOARDS ARE INDICATED AS "TB", MARKER BOARDS ARE INDICATED AS "MB". ALL ARE TO BE MOUNTED AT 2'-10" A.F.F.
 - DOWNSPOUTS ARE INDICATED AS "DS".
 - SLOPE ALL FLOORS TO FLOOR DRAINS.
 - PROVIDE TRANSITION STRIPS AT ALL DOOR FRAMES WHERE FLOOR MATERIAL CHANGES.
 - PROVIDE BULLNOSE CMU AT ALL OUTSIDE CORNERS AND DOOR JAMBS, EXCEPT OVERHEAD DOOR JAMBS.
 - CG-1 + CG-2 INDICATE CORNER GUARDS, SEE SPECIFICATIONS.
 - AREAS TO RECEIVE ABUSE RESISTANT GYP TO 8'-0".
 1. EITHER SIDE OF CORNERS TO RECEIVE CORNER GUARDS.
 2. KITCHEN ISLAND GYP + STUD WALL AT SEATING.
 3. PNTD GYP WALLS AT MEZZANINE.

**NORTH LITTLE ROCK
FIRE DEPARTMENT
STATION 8**

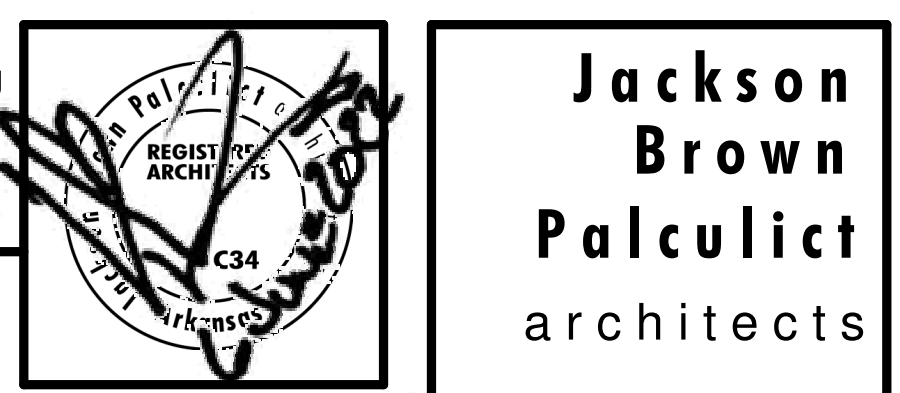

**Jackson
Brown
Palculict
architects**


Date
6/6/22
Revisions

JOB NUMBER 2203


Sheet Title
PLAN

Sheet Number
A101

12921 Cantrell Road, Suite 201
Little Rock, AR 72223
501.664.8700 tel
501.664.5189 fax
www.jbparthitects.com

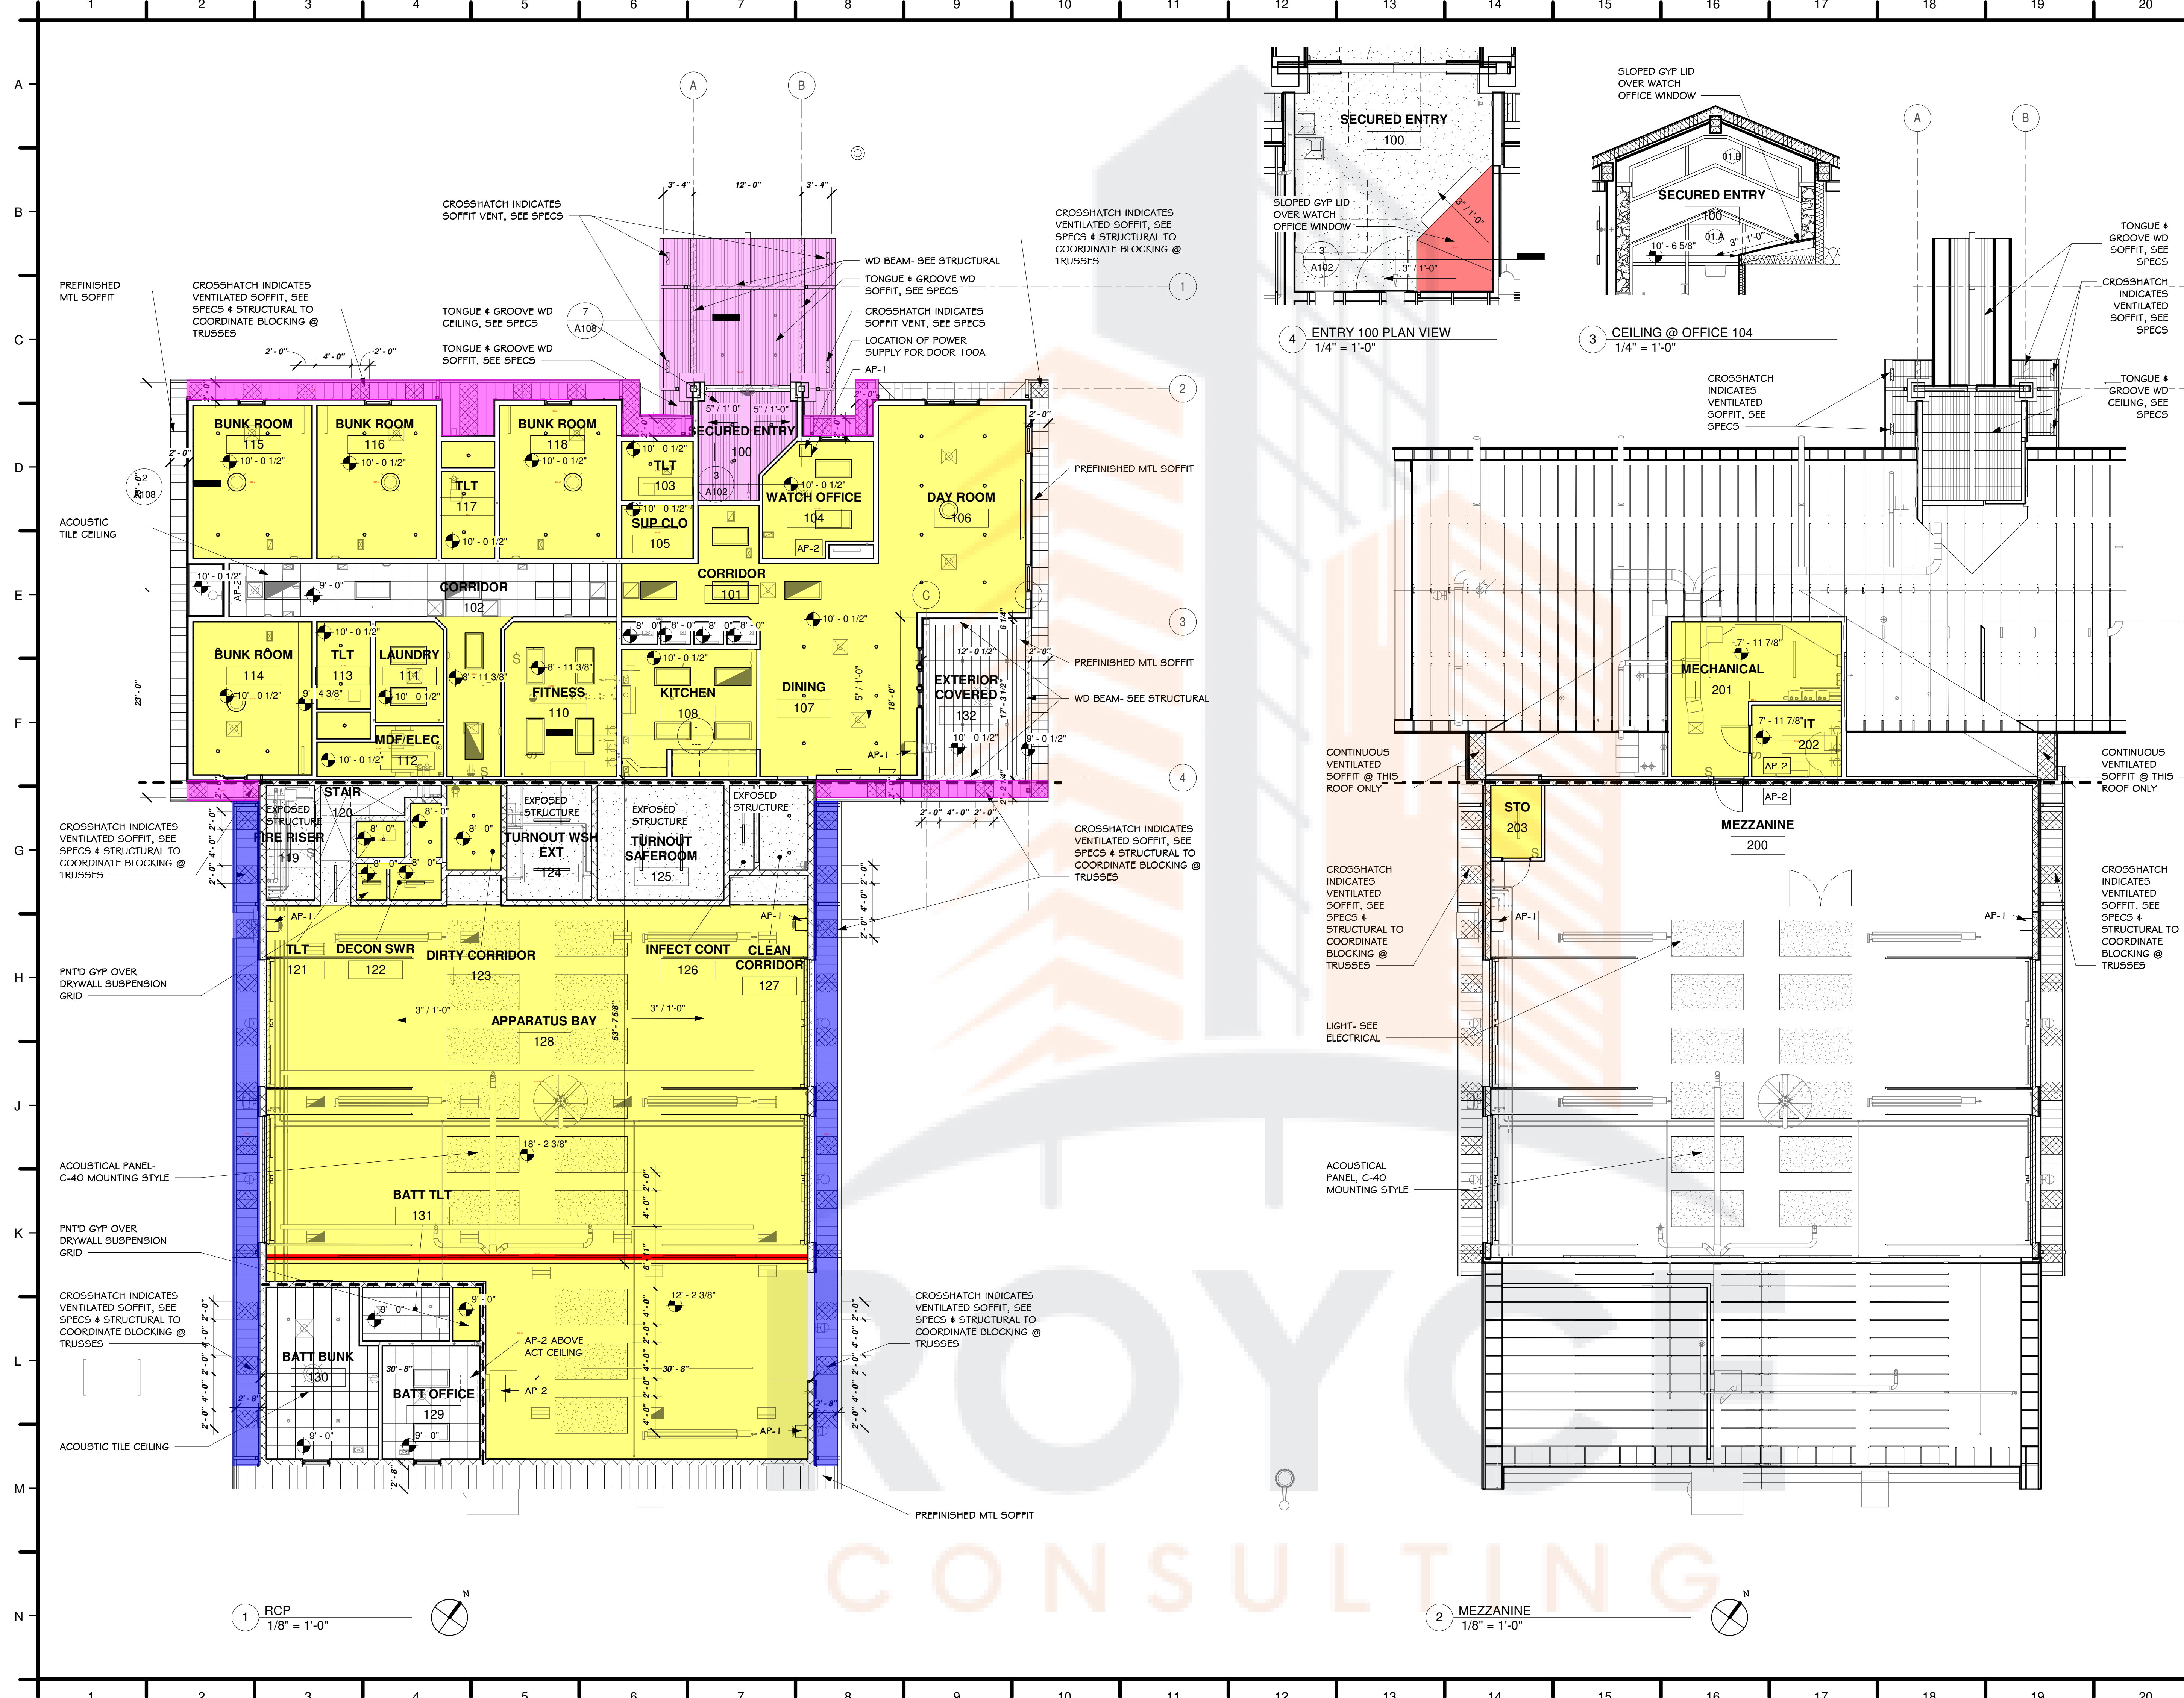

**NORTH LITTLE ROCK
FIRE DEPARTMENT
STATION 8**

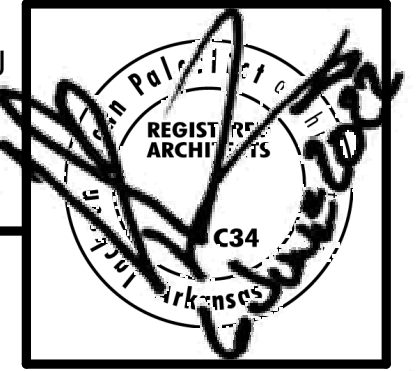

**Jackson
Brown
Palculict
architects**

Date
6/6/22
Revisions


JOB NUMBER 2203

Sheet Title
RCP

Sheet Number
A102

12921 Cantrell Road, Suite 201
Little Rock, AR 72223
501.664.8700 tel
501.664.5189 fax
www.jbparchitects.com

Copyright 2019 JBP

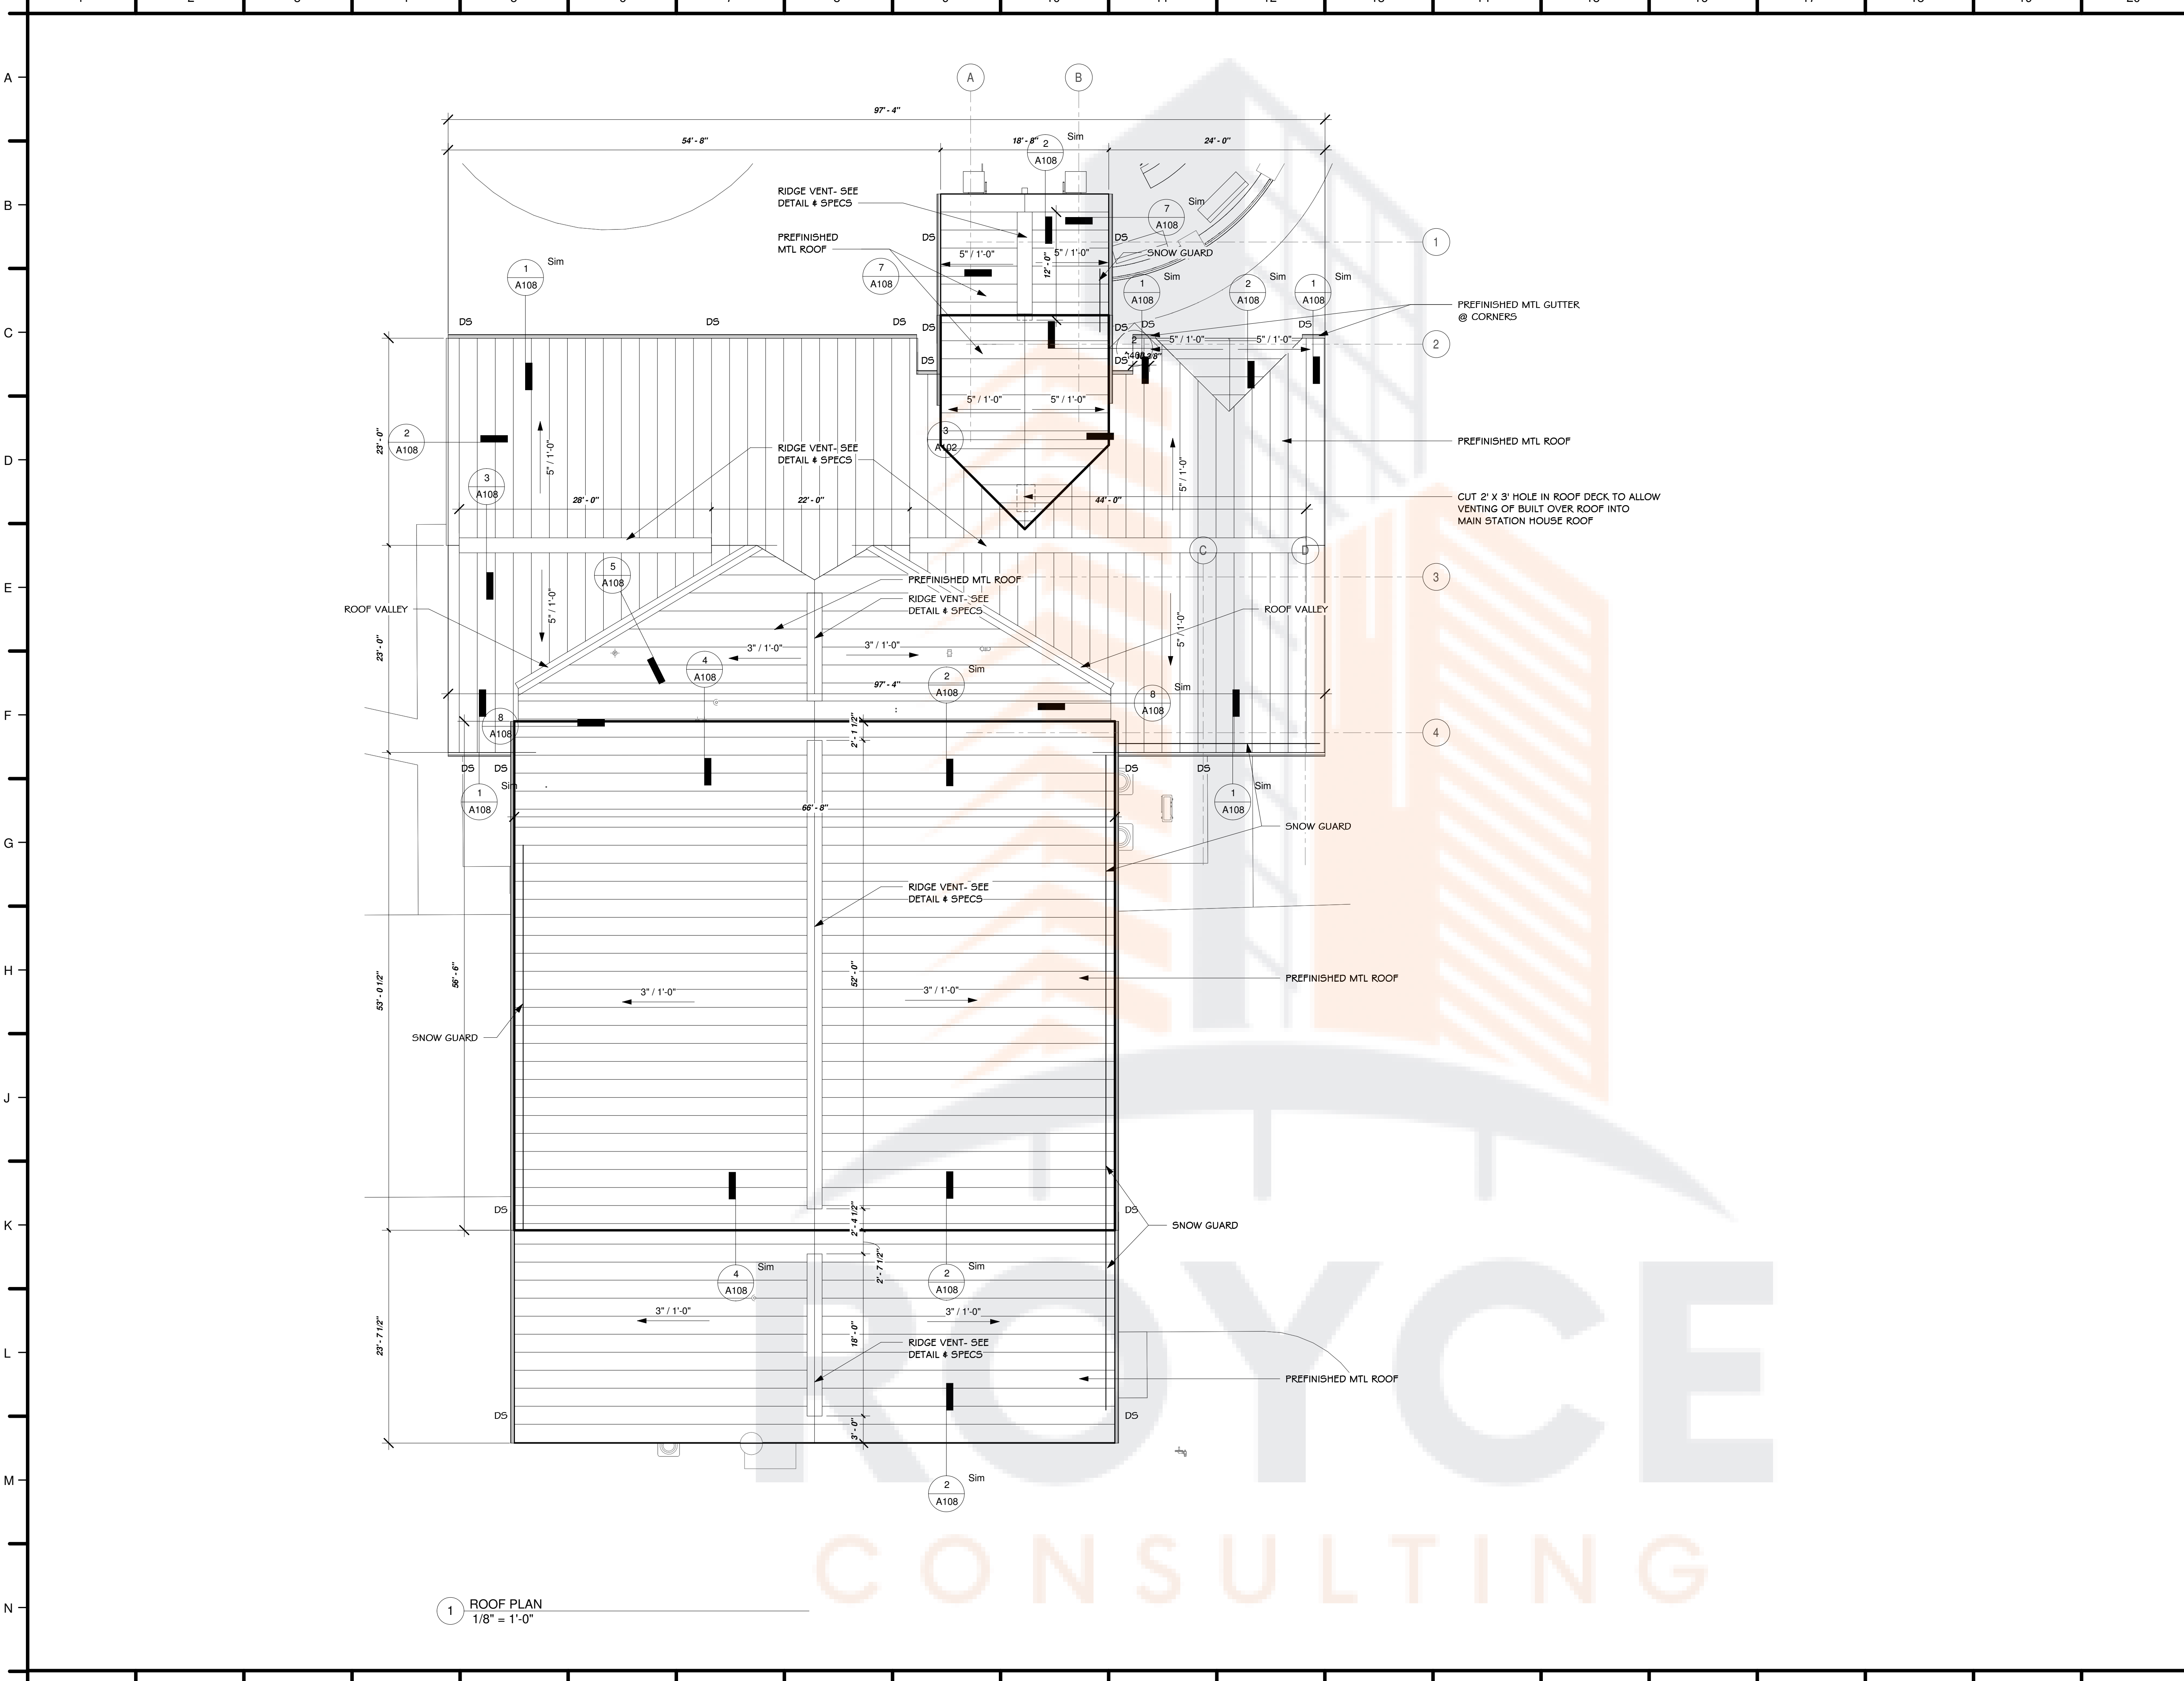


1 ROOF PLAN
1/8" = 1'-0"

General Notes

1. PROVIDE FIELD PAINTING OF HANGERS, EXPOSED STEEL AND IRON WORK, OF PRIMED METAL SURFACES AND EXPOSED-TO-VIEW METAL SURFACES OF ITEMS, AS REQUIRED TO MATCH ADJACENT SURFACES, AND EQUIPMENT INSTALLED UNDER MECHANICAL AND ELECTRICAL WORK. THIS INCLUDES BUT IS NOT LIMITED TO, ALL EXPOSED CONDUIT FIRE SPRINKLER PIPING, GAS PIPING, HANGERS DUCTWORK, SUPPORTS, ETC. IF IT CAN BE SEEN PAINT IT. ARCHITECT TO SELECT COLOR OR COLORS.
2. "D5" INDICATES DOWNSPOUTS.

**NORTH LITTLE ROCK
FIRE DEPARTMENT
STATION 8**

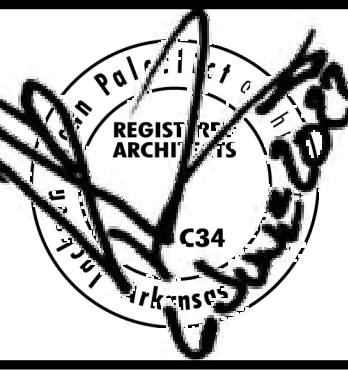

**Jackson
Brown
Palculict
architects**


Date
6/6/22
Revisions

JOB NUMBER 2203

Sheet Title
ROOF PLAN


Sheet Number
A107

12921 Cantrell Road, Suite 201
Little Rock, AR 72223
501.664.8700 tel
501.664.5189 fax
www.jbpaarchitects.com

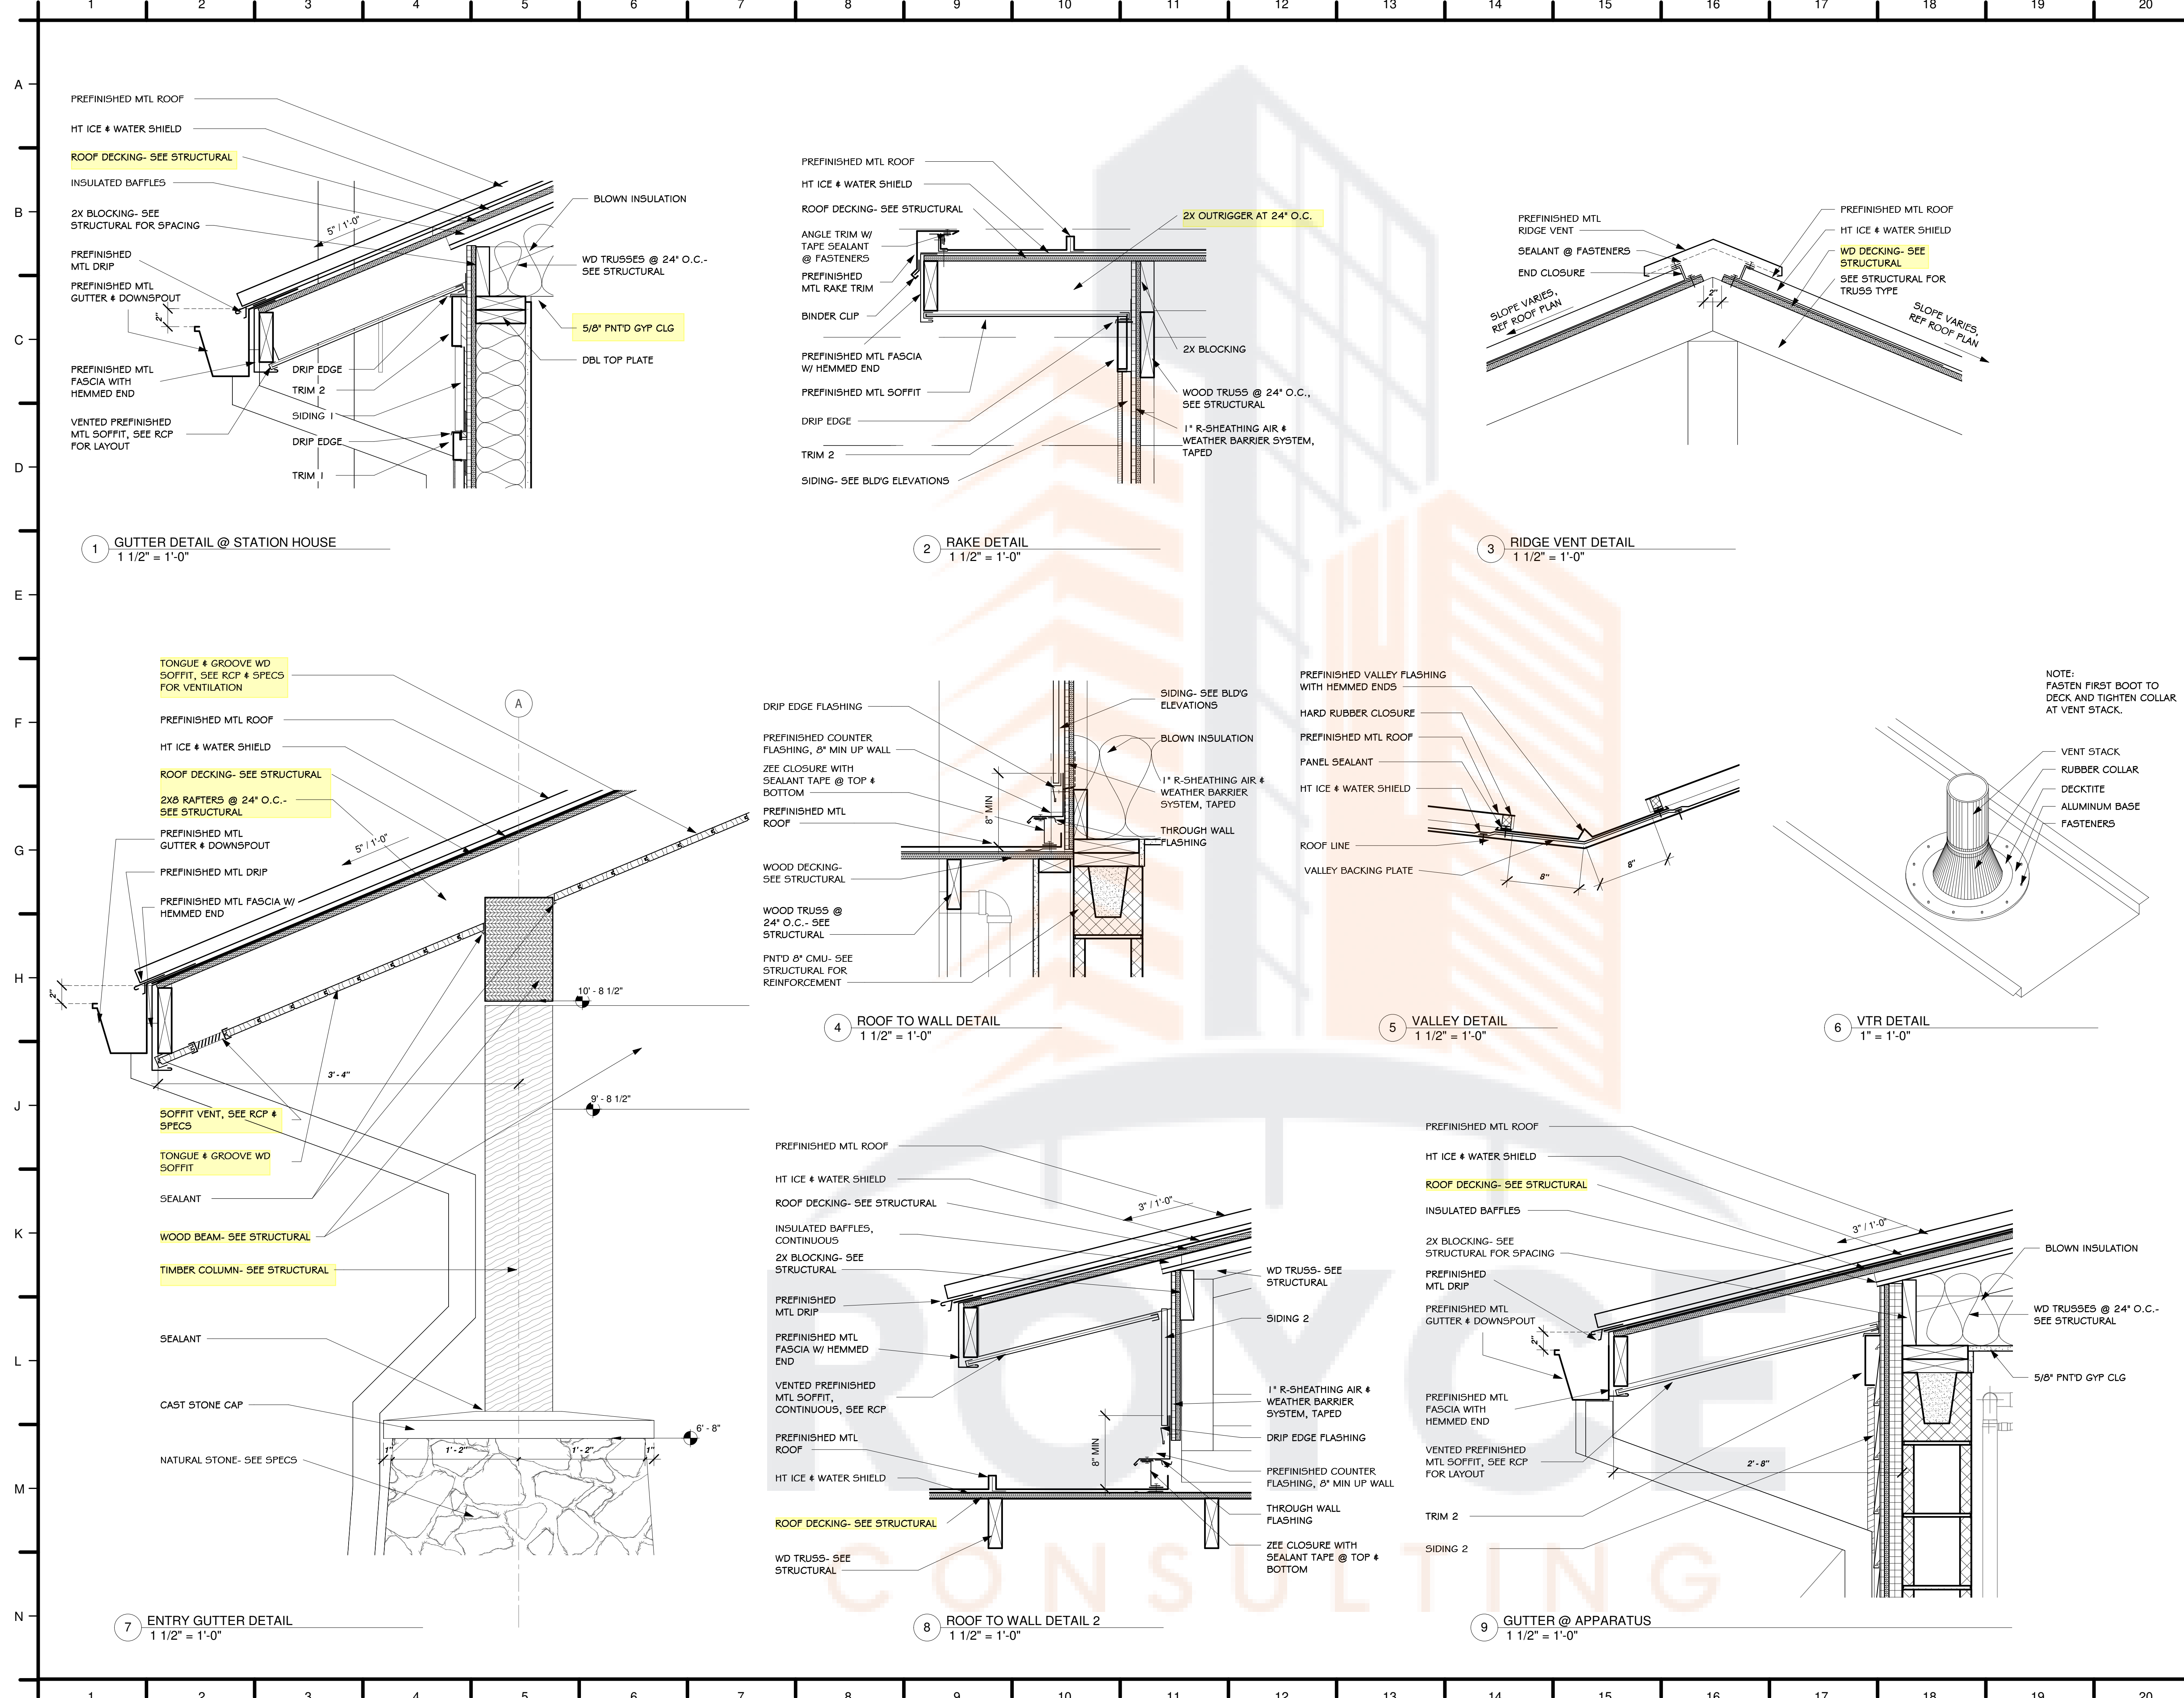

General Notes

**NORTH LITTLE ROCK
FIRE DEPARTMENT
STATION 8**

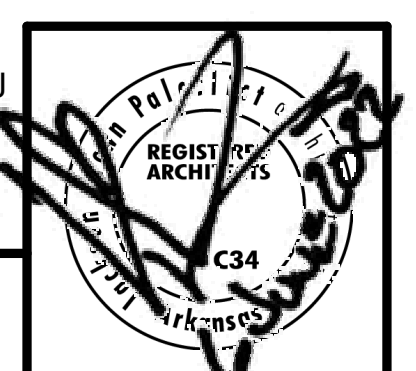

**Jackson
Brown
Palculict
architects**

Date
6/6/22
Revisions


Job Number 2203

Sheet Title
**ROOF
DETAILS**


Sheet Number
A108

12921 Cantrell Road, Suite 201
Little Rock, AR 72223
501.664.8700 tel
501.664.5189 fax
www.jbparcitects.com


CONSULTING

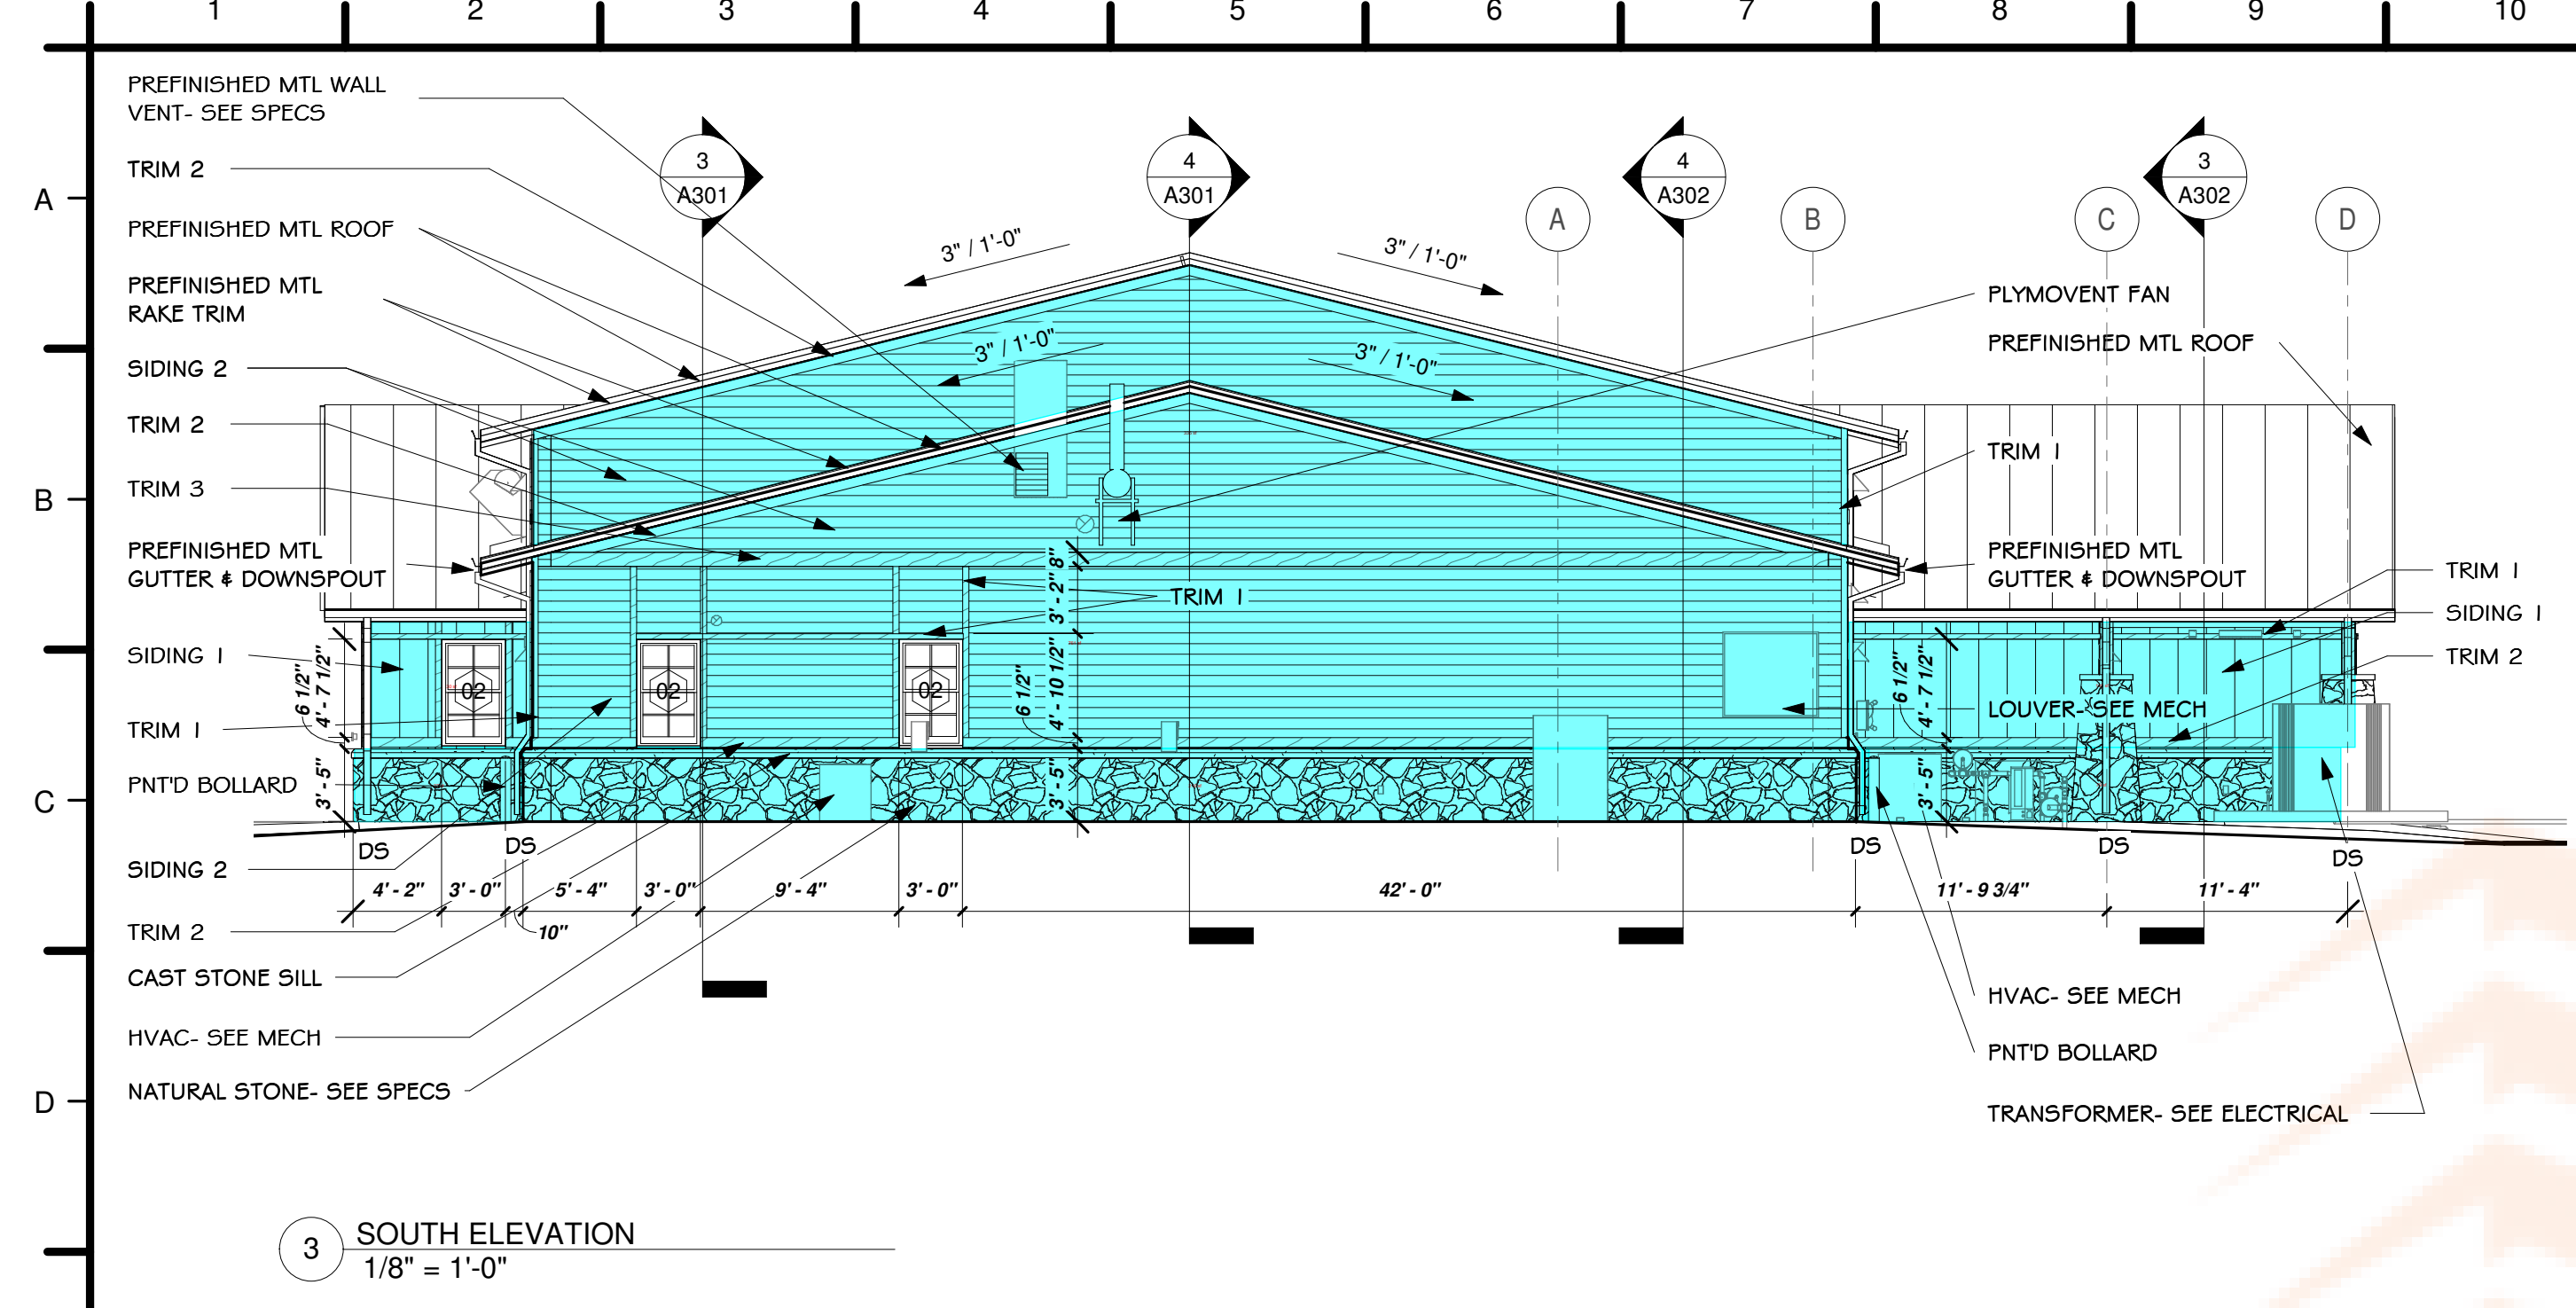


3 SOUTH ELEVATION
1/8" = 1'-0"

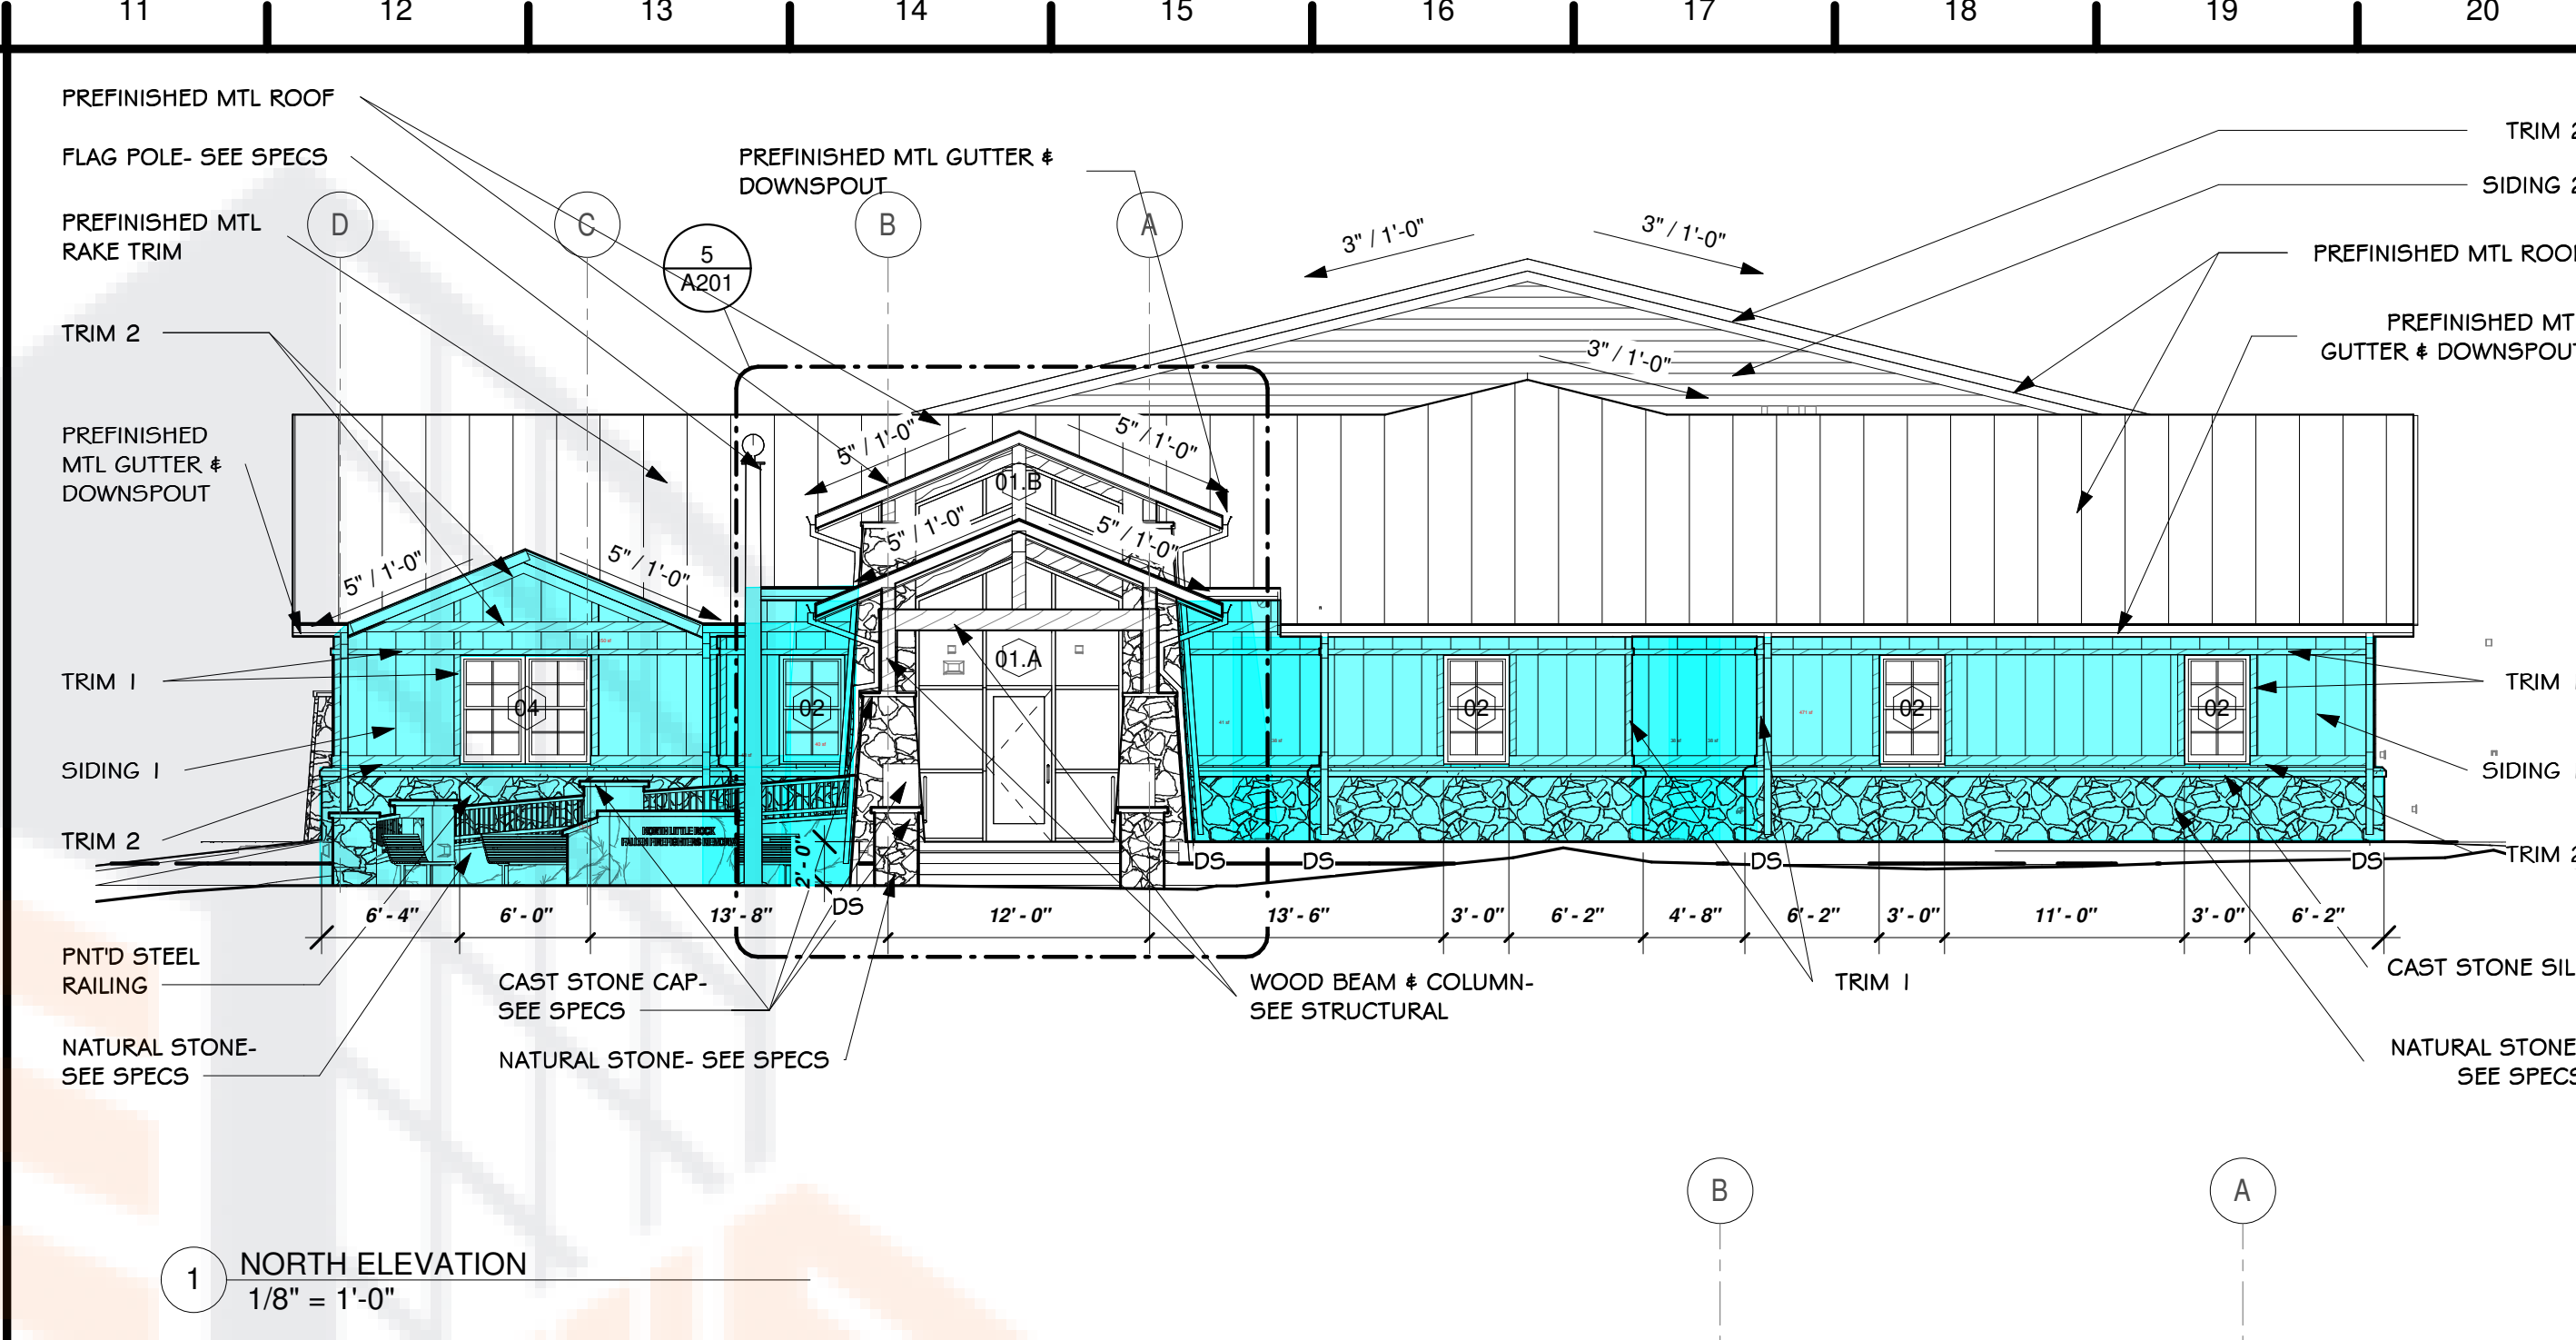


1 NORTH ELEVATION
1/8" = 1'-0"

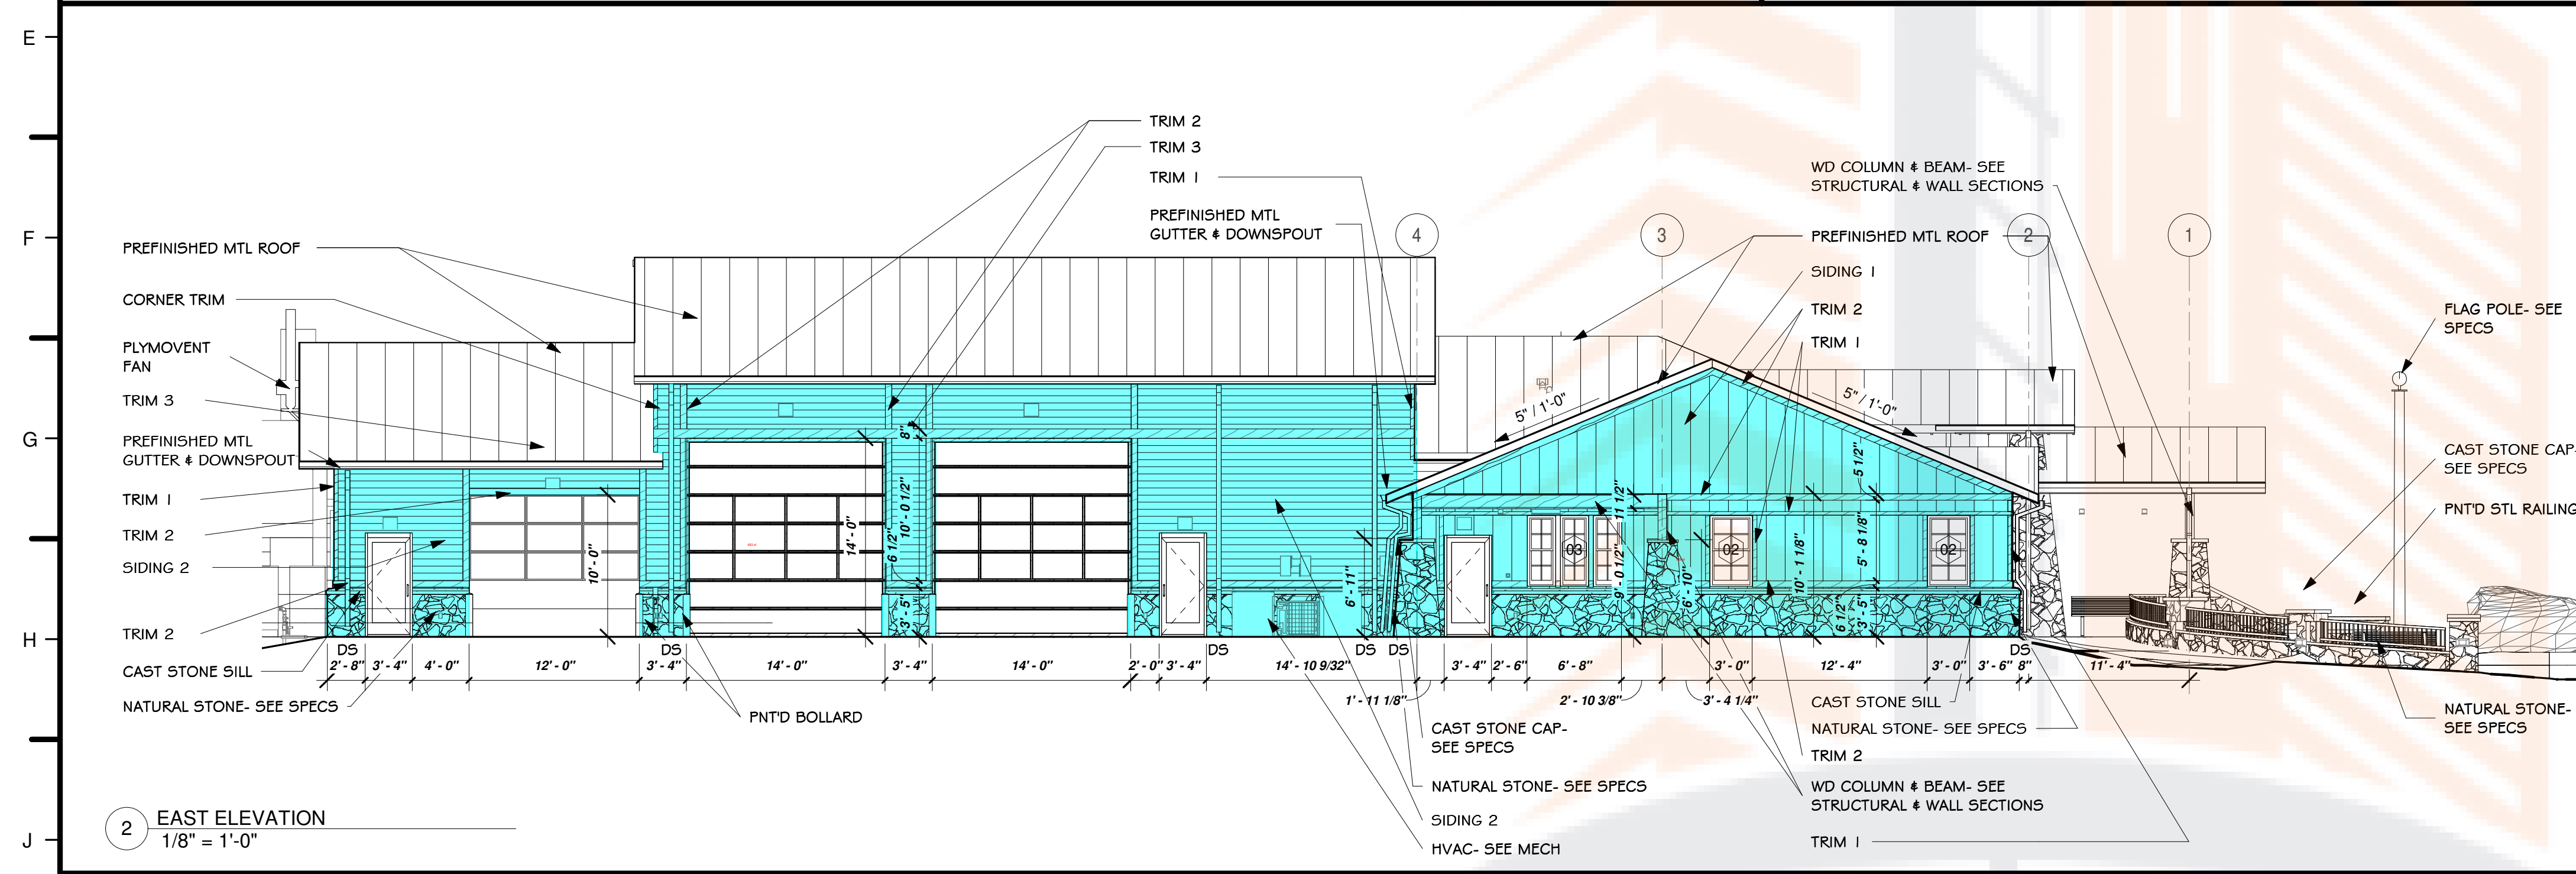


2 EAST ELEVATION
1/8" = 1'-0"

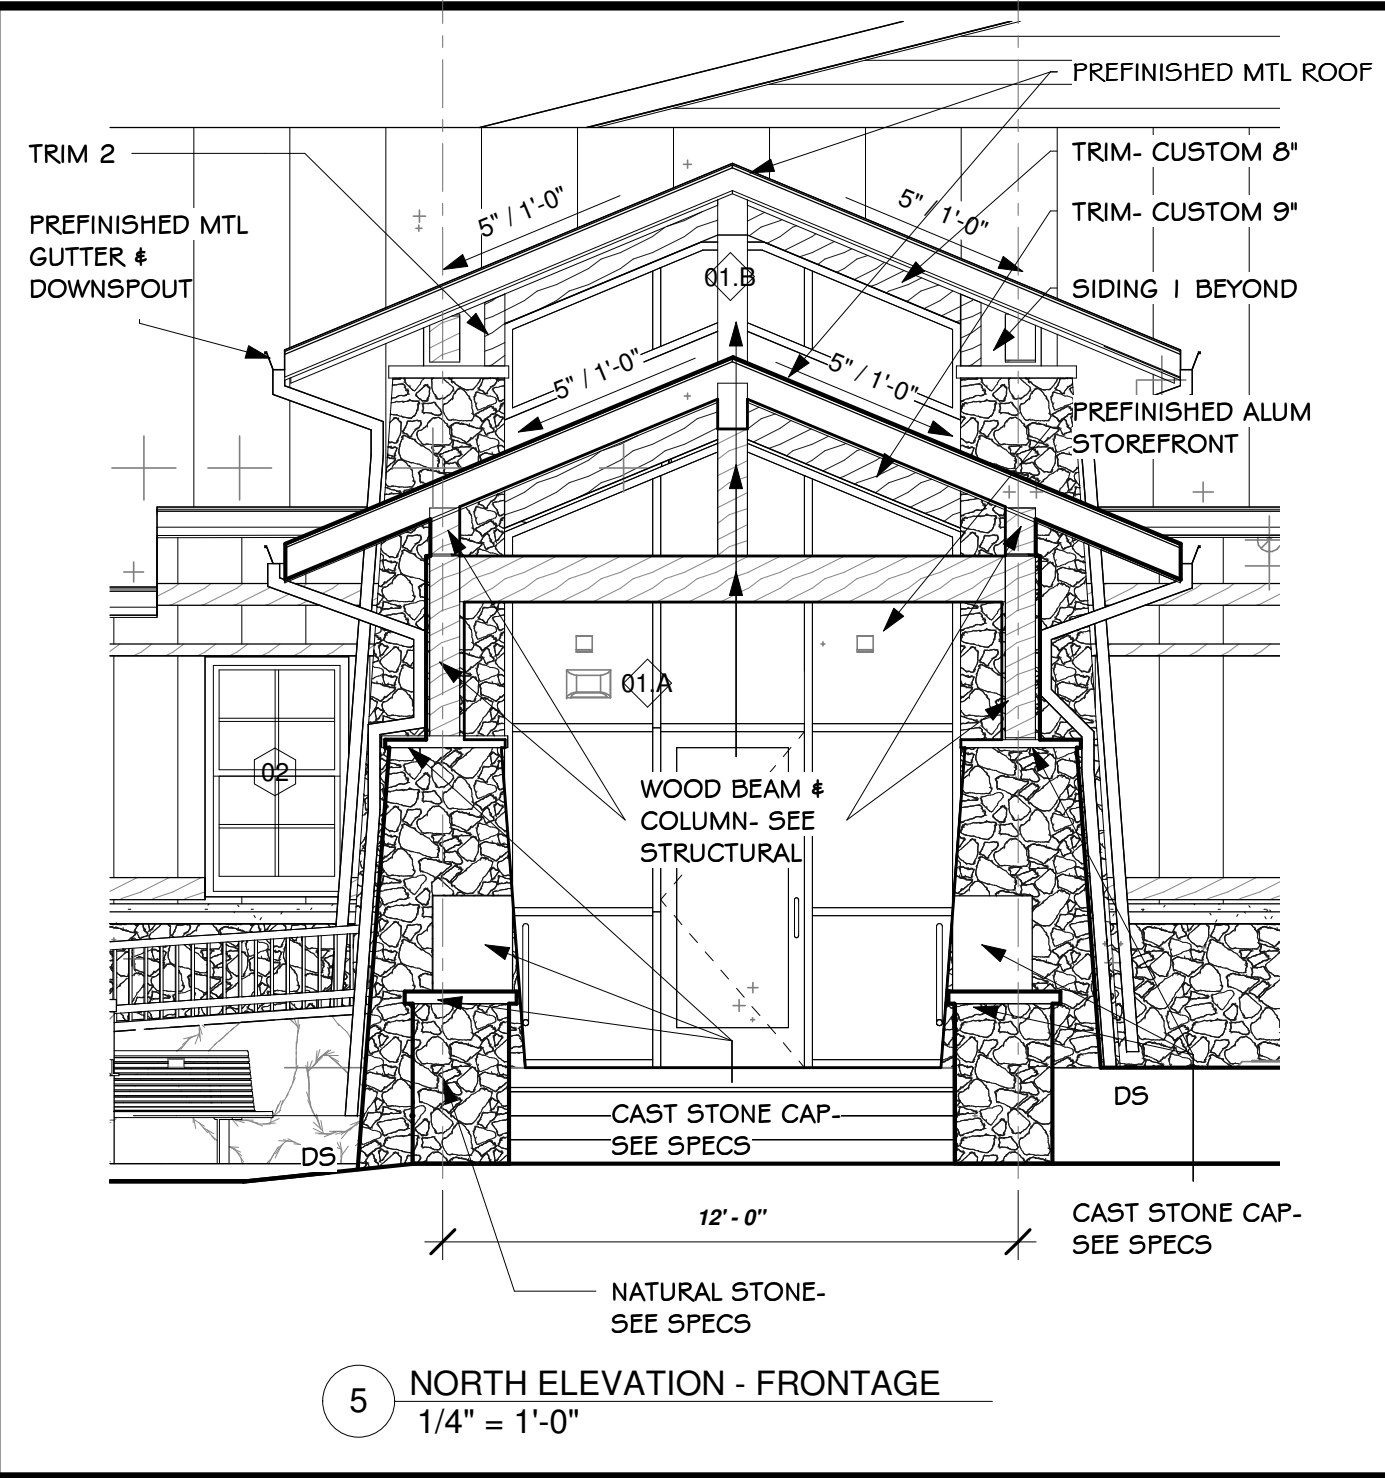

5 NORTH ELEVATION - FRONTAGE
1/4" = 1'-0"

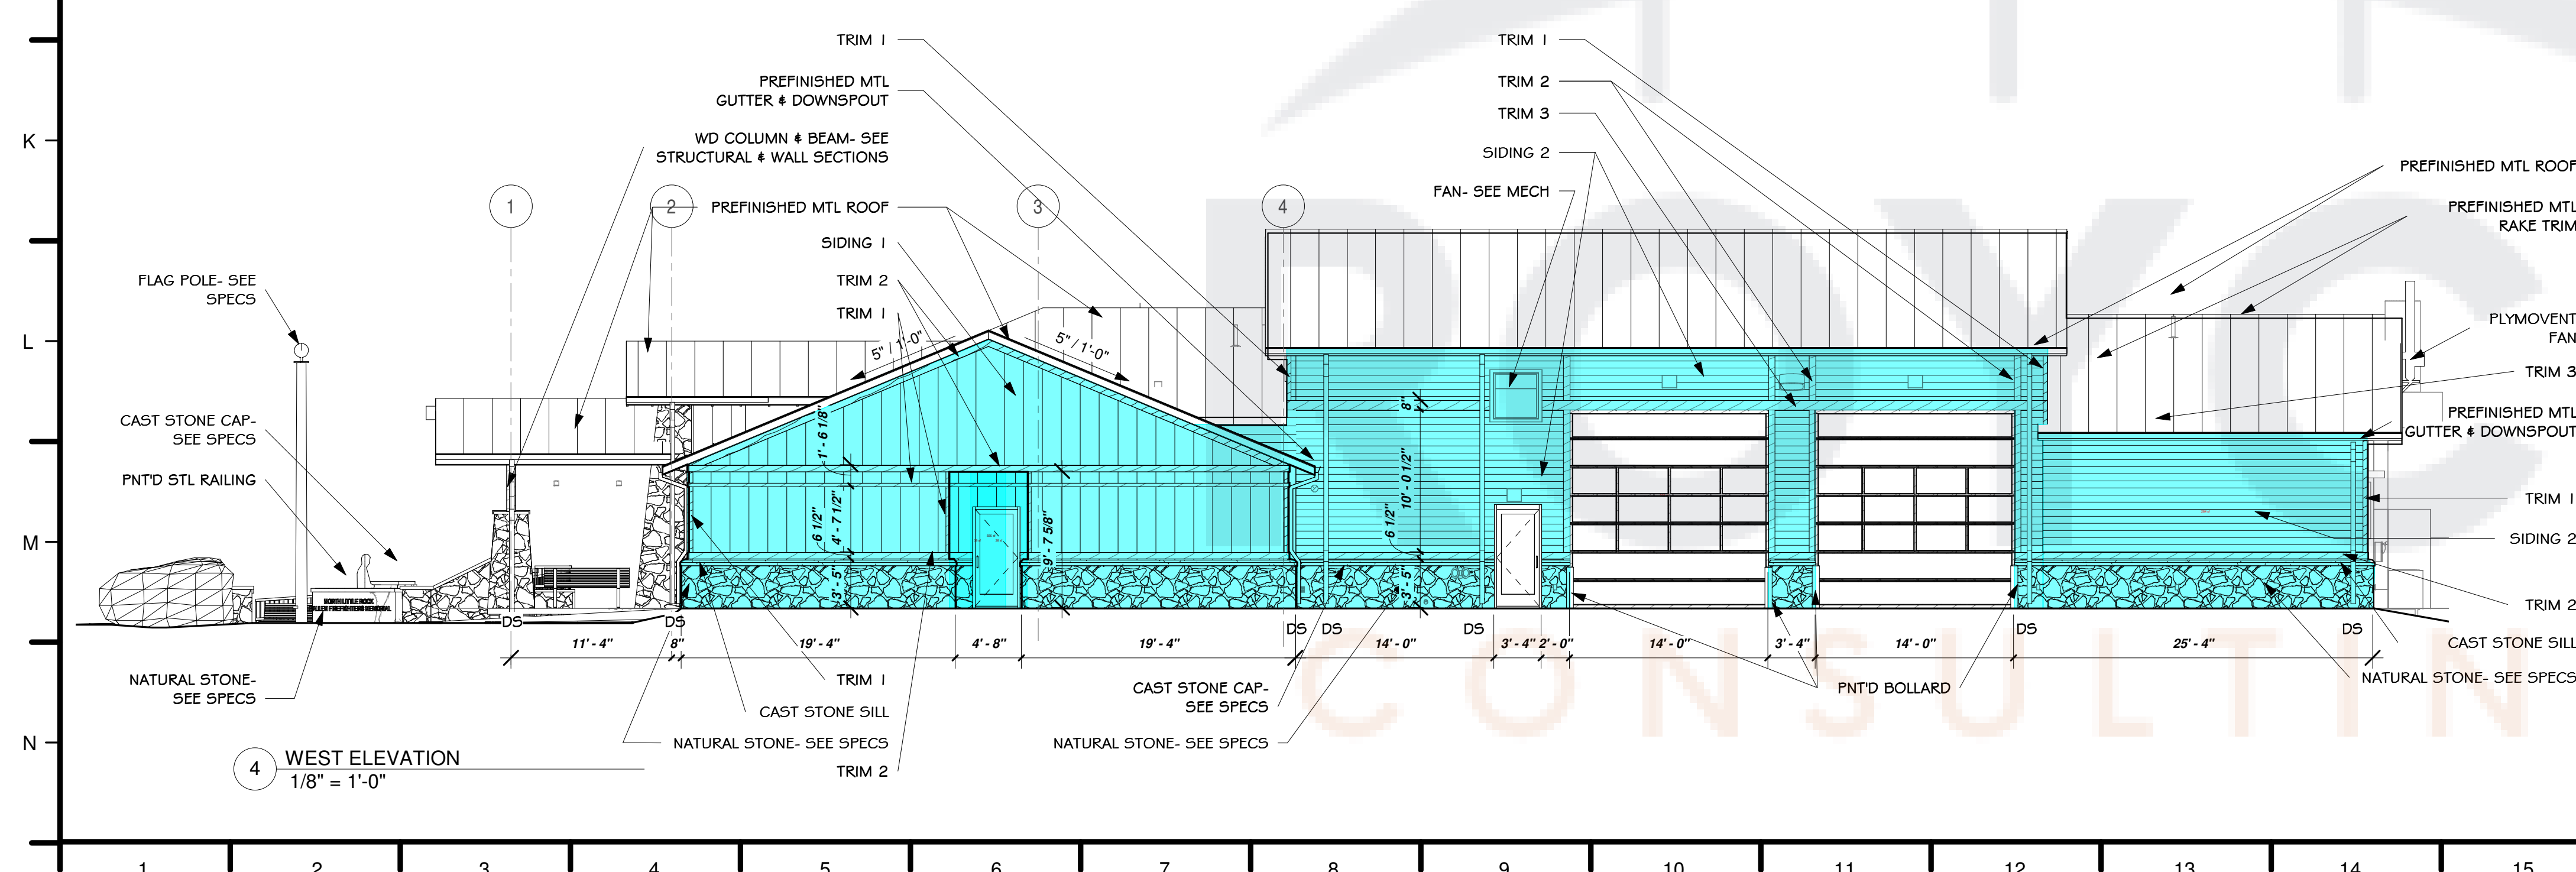

4 WEST ELEVATION
1/8" = 1'-0"

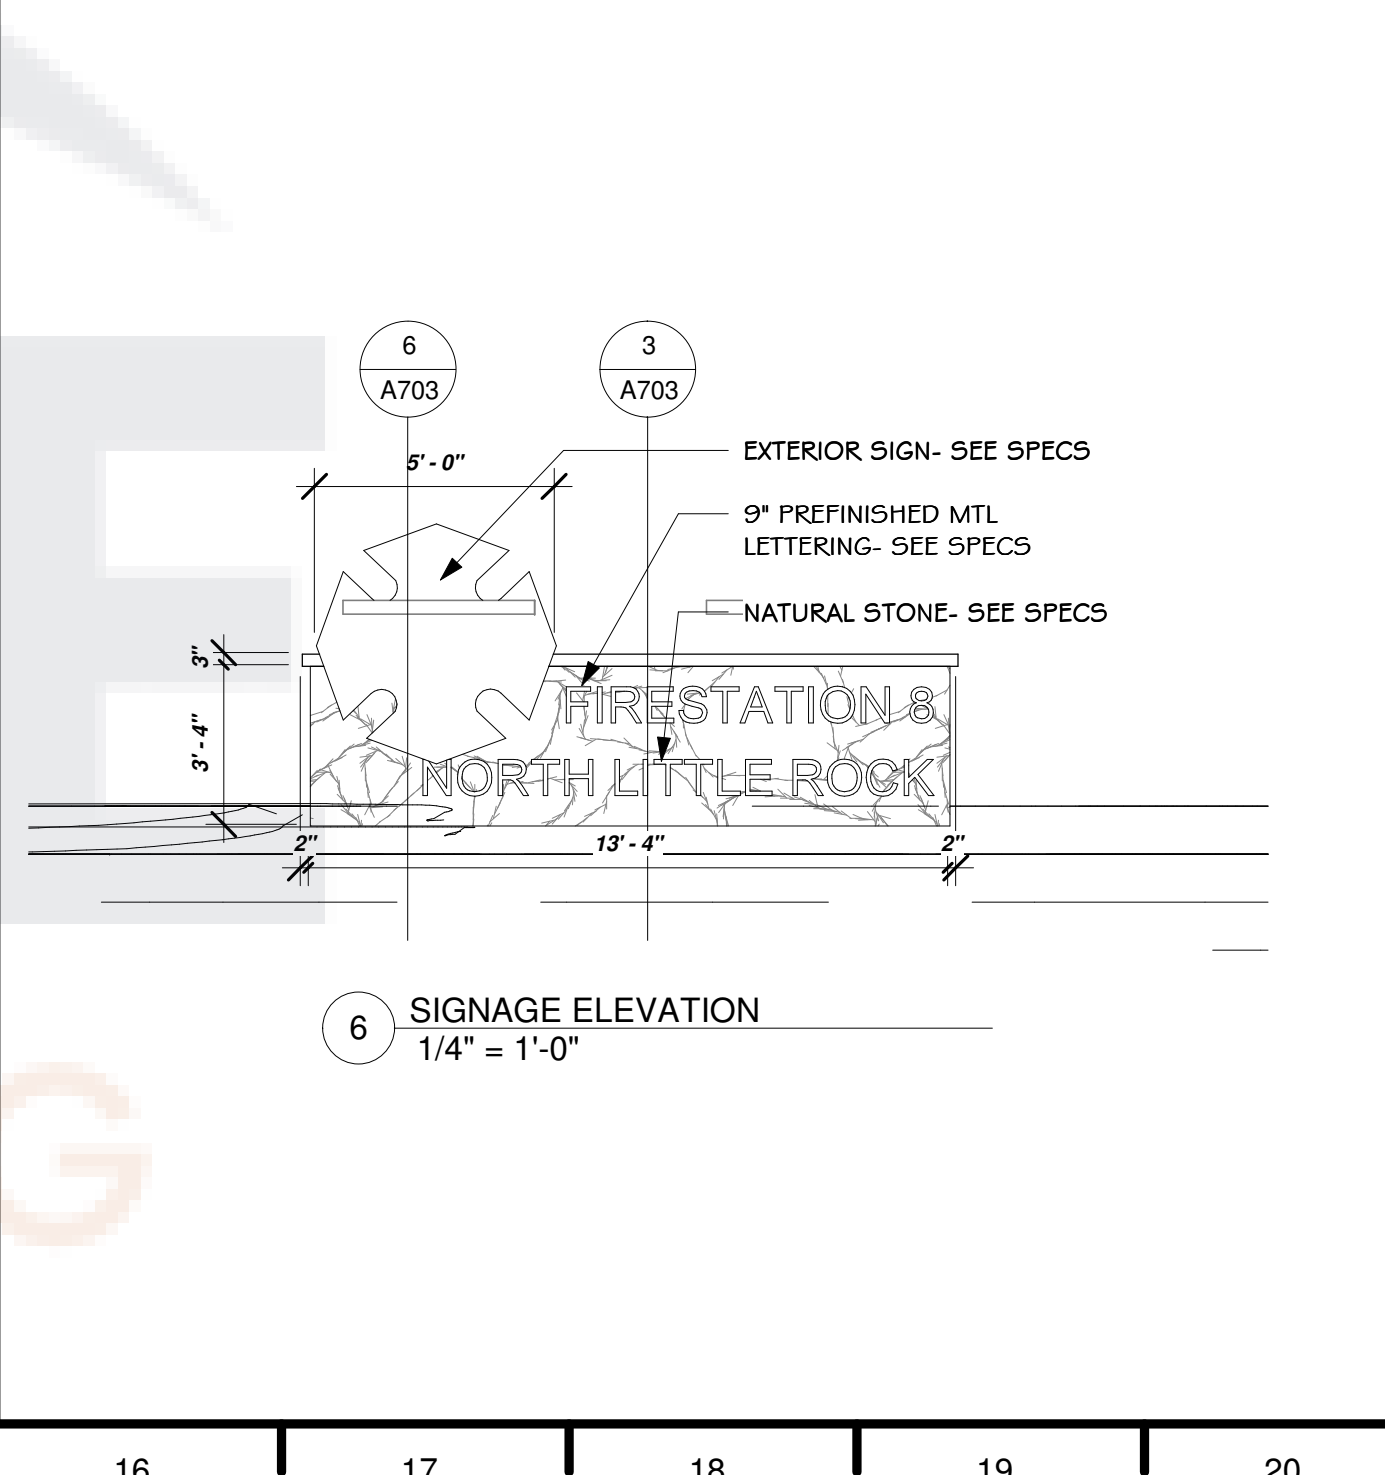


6 SIGNAGE ELEVATION
1/4" = 1'-0"

General Notes

1. PROVIDE FIELD PAINTING OF HANGERS, EXPOSED STEEL, AND IRON WORK, OF PRIMED METAL SURFACES AND EXPOSED-TO-VIEW METAL SURFACES OF ITEMS, AS REQUIRED TO MATCH ADJACENT SURFACES AND EQUIPMENT INSTALLED UNDER MECHANICAL AND ELECTRICAL WORK. THIS INCLUDES BUT IS NOT LIMITED TO, ALL EXPOSED CONDUIT, FIRE SPRINKLER PIPING, HANGERS, DUCTWORK, SUPPORTS, ETC. IF IT CAN BE SEEN, PAINT IT. ARCHITECT TO SELECT COLOR OR COLORS. ALL DIMENSIONS ARE TO FACE OF STUD, GRID LINE, OR BUILDING LINE U.N.O.
2. CONTRACTOR TO COORDINATE REQUIRED INSTALLATION OF ALL BLOCKING FOR (NOT LIMITED TO) ALL FIXTURES, EQUIP, OR SIGNAGE

**NORTH LITTLE ROCK
FIRE DEPARTMENT
STATION 8**

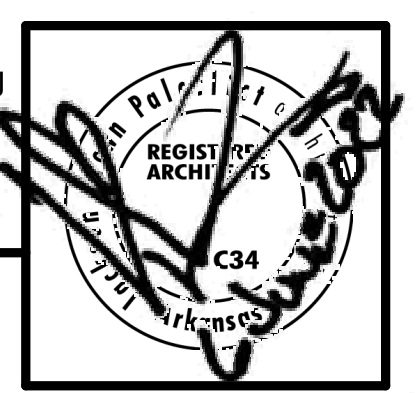

**Jackson
Brown
Palculict
architects**


Date
6/6/22
Revisions

Job Number 2203


Sheet Title
**OVERALL
ELEVATIONS**

Sheet Number
A201


12921 Cantrell Road, Suite 201
Little Rock, AR 72223
501.664.8700 tel
501.664.5189 fax
www.jbparchitects.com

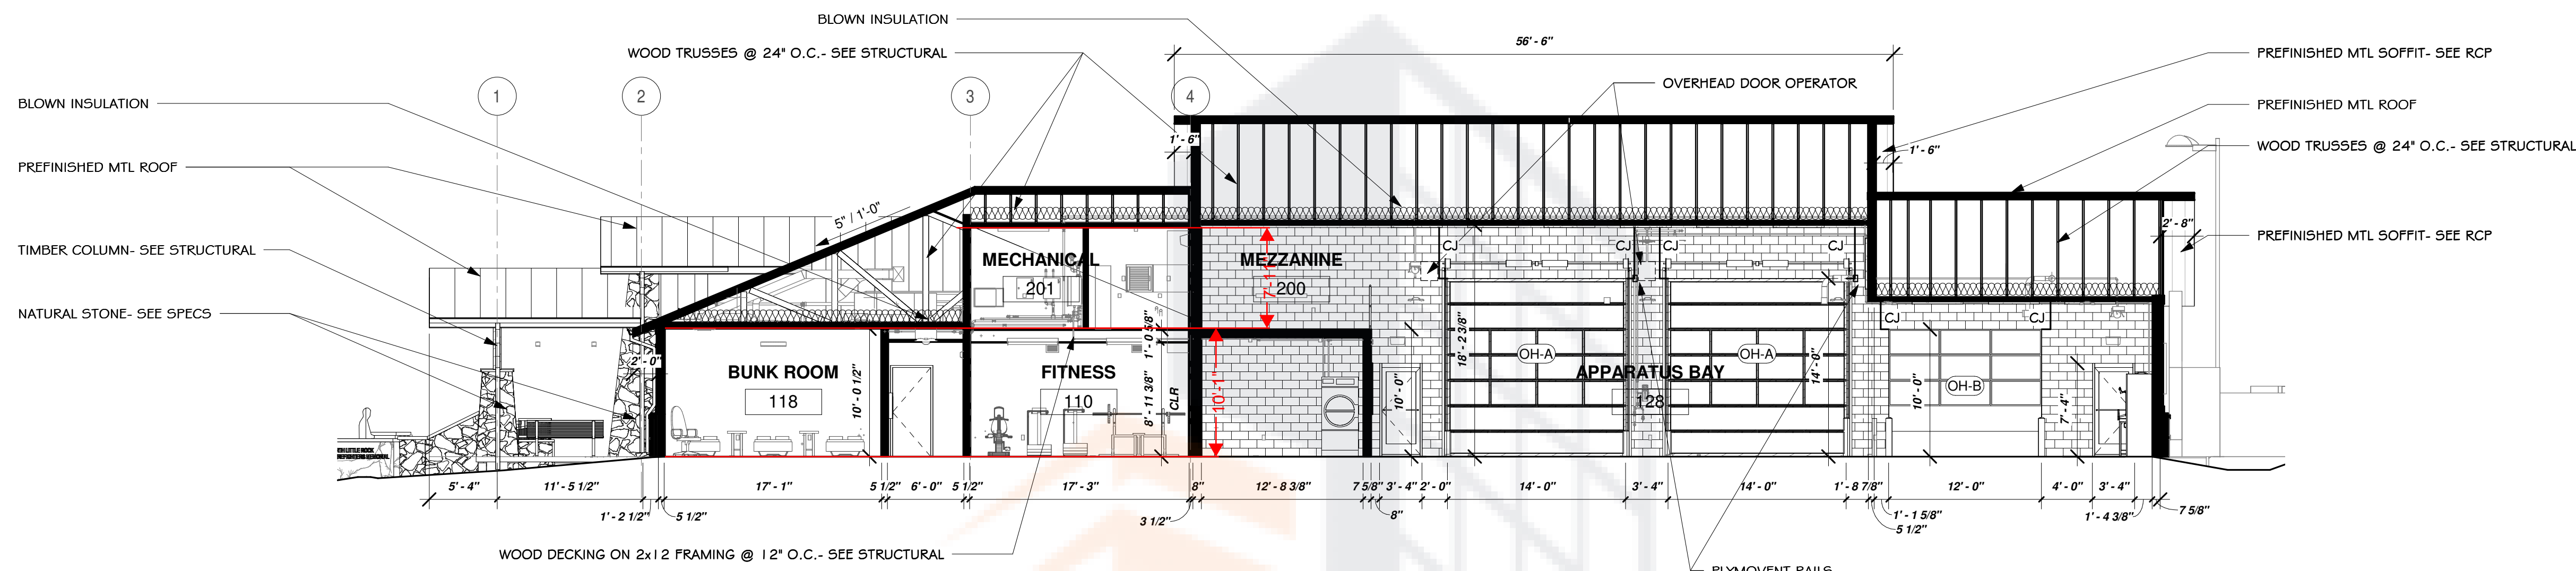


4 BUILDING SECTION 1
1/8" = 1'-0"

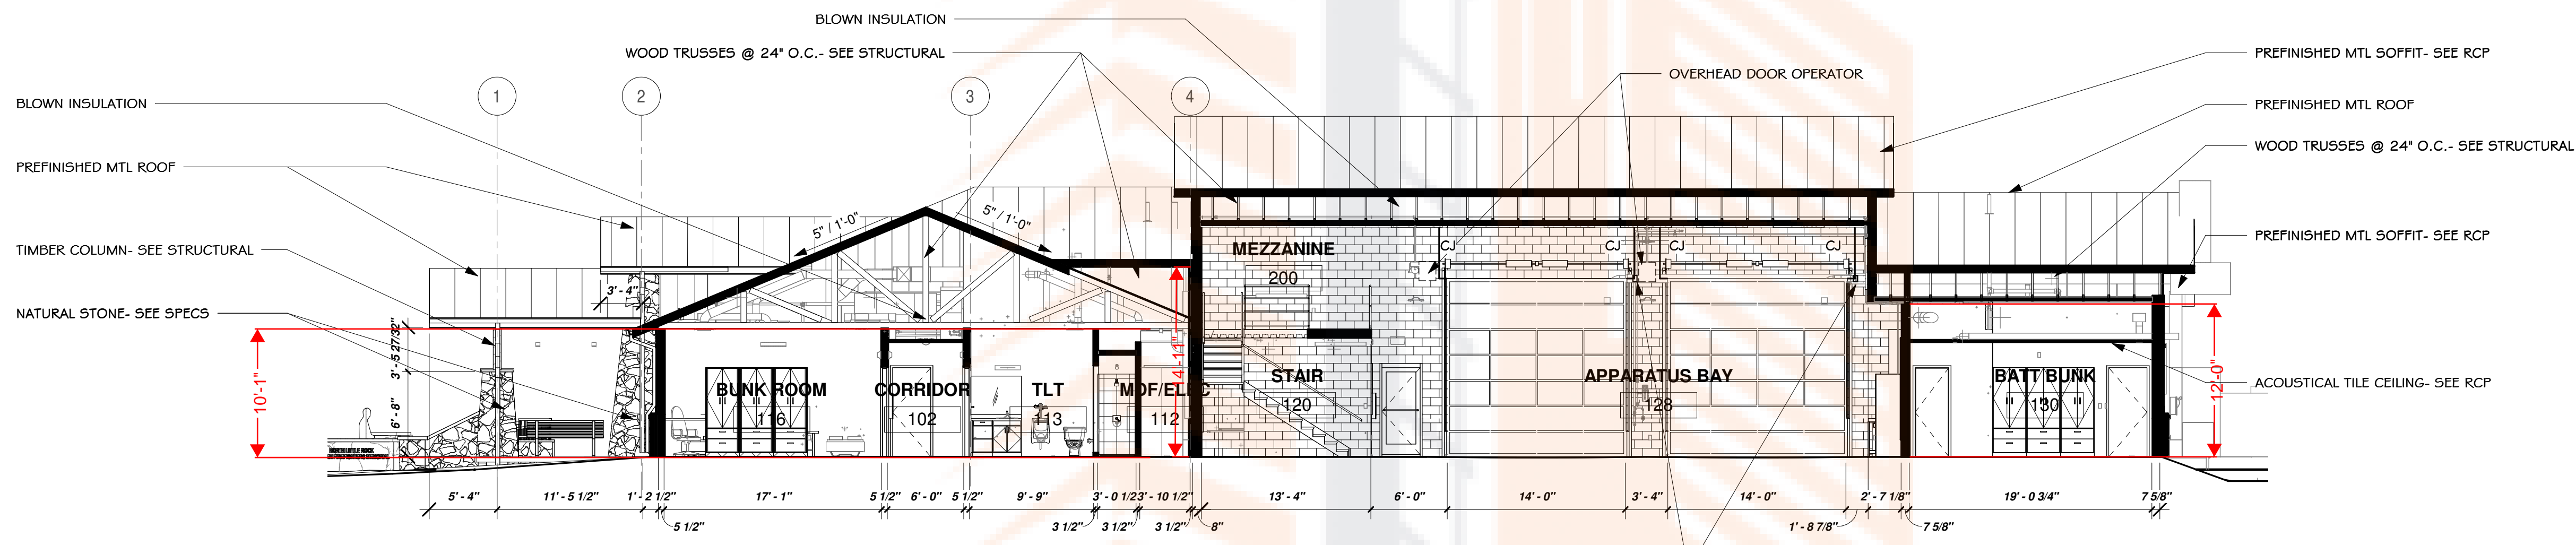

3 BUILDING SECTION 2
1/8" = 1'-0"

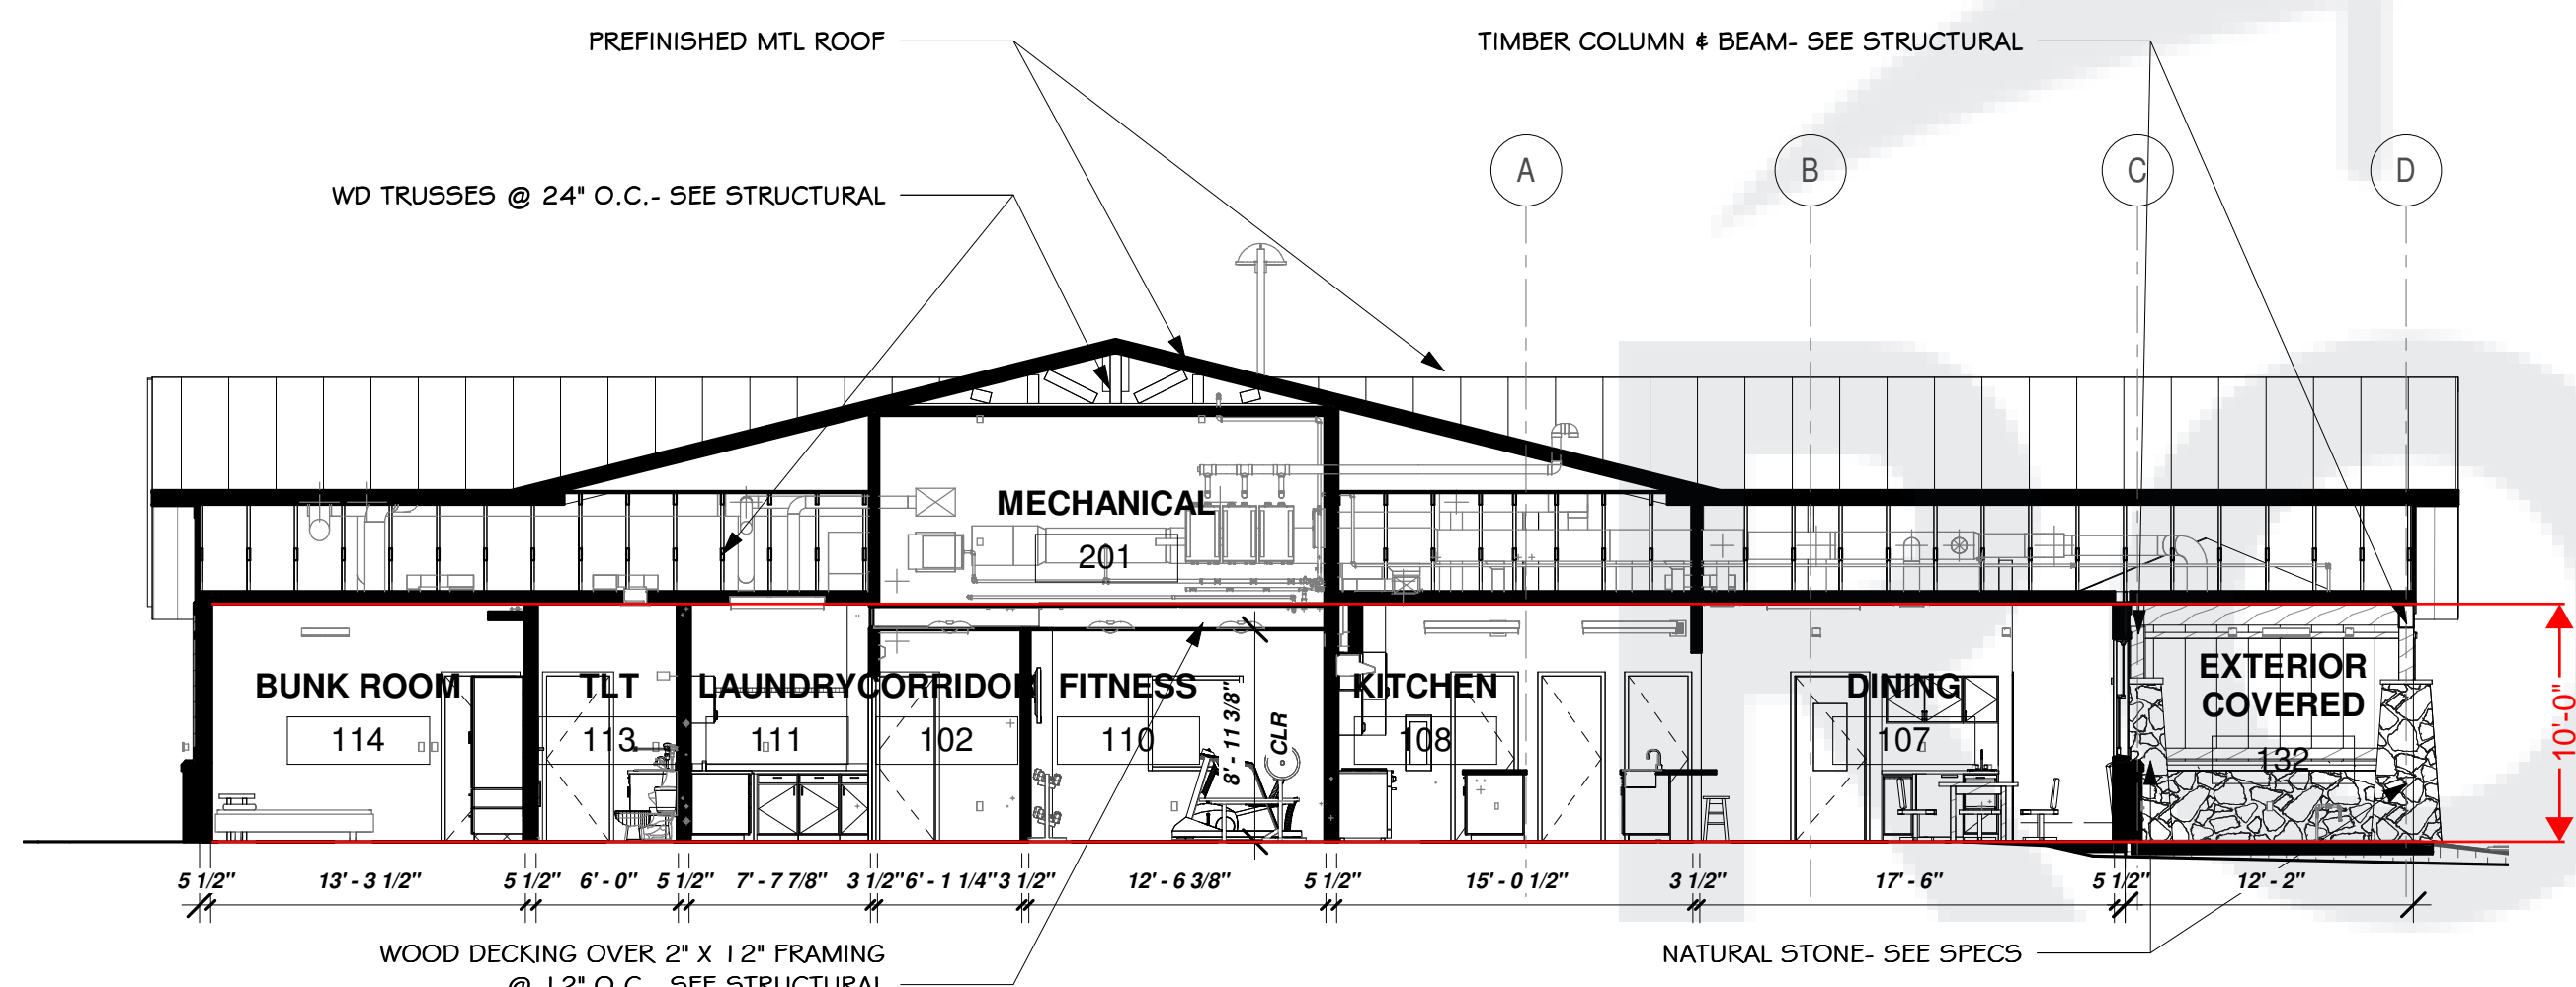


2 BUILDING SECTION 3
1/8" = 1'-0"

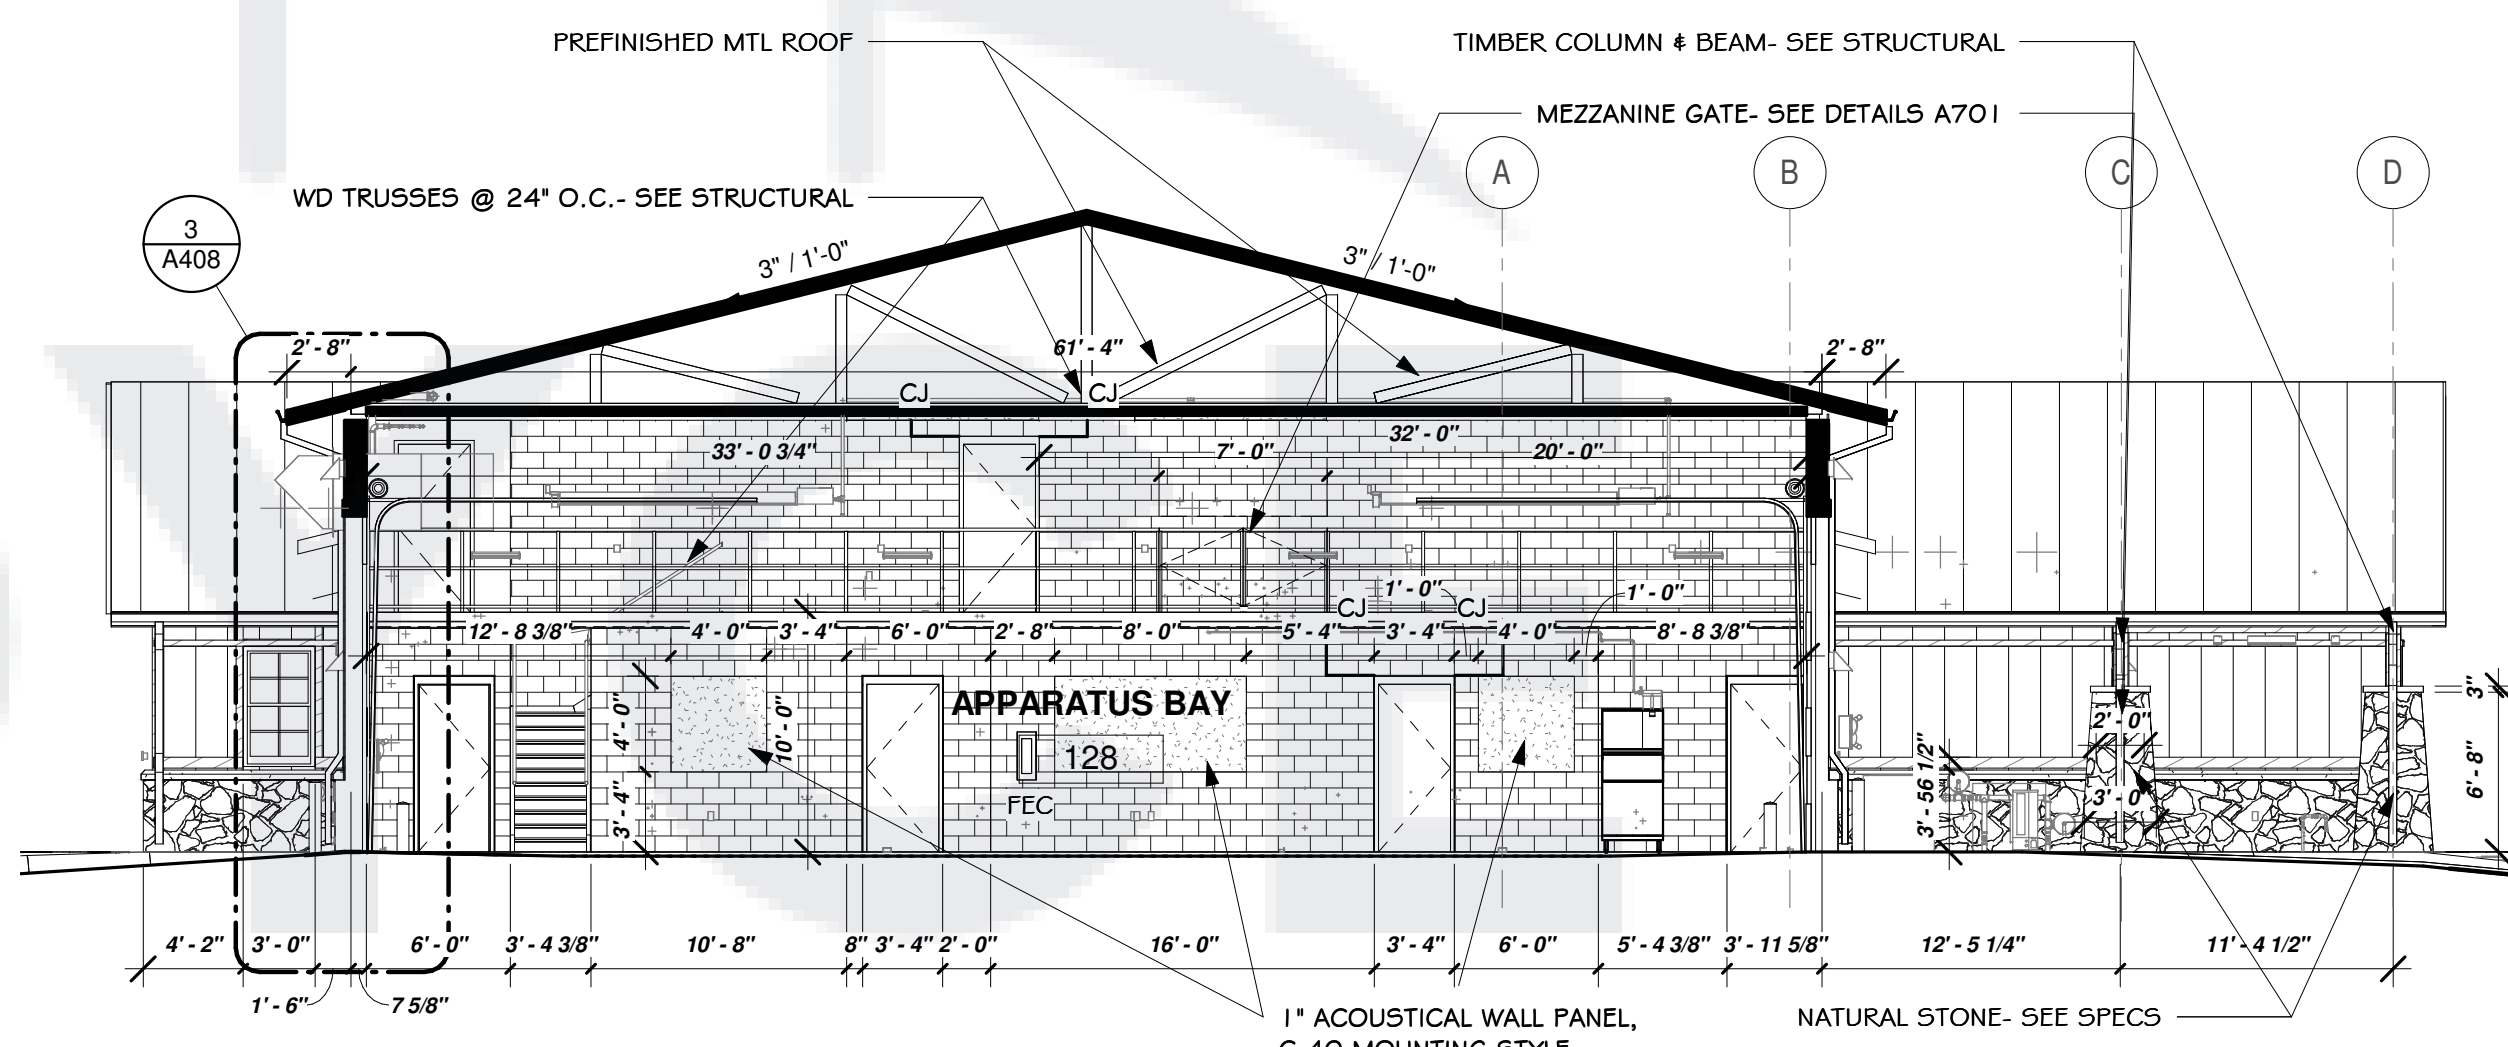

1 BUILDING SECTION 4
1/8" = 1'-0"

- General Notes**
1. PROVIDE FIELD PAINTING OF HANGERS AND EXPOSED-TO-VIEW METAL SURFACES OF ITEMS, AS REQUIRED TO MATCH ADJACENT SURFACES AND EQUIPMENT INSTALLED UNDER MECHANICAL AND ELECTRICAL WORK. THIS INCLUDES BUT IS NOT LIMITED TO, ALL EXPOSED CONDUIT, FIRE SPRINKLER PIPING, HANGERS, DUCTWORK, SUPPORTS, ETC. IF IT CAN BE SEEN, PAINT IT. ARCHITECT TO SELECT COLOR OR COLORS.
 2. ALL DIMENSIONS ARE TO FACE OF STUD, OR CAMU U.N.O. ("CJ" INDICATES CONTROL JOINT. SEE SPECIFICATIONS FOR DESCRIPTION OF METHODS AND LOCATIONS PERTAINING TO REQUIREMENTS.
 3. CONTRACTOR TO COORDINATE REQUIRED INSTALLATION OF ALL BLOCKING FOR (NOT LIMITED TO) ALL FIXTURES, EQUIP, OR SIGNAGE.
 4. PROVIDE 3" TALL HELVETICA LETTERS STENCILED AT ALL RATED WALLS, STENCILING TO READ AS FOLLOWS "FIRE AND SMOKE BARRIER-PROTECT ALL OPENINGS". INCLUDE UL NUMBERS TYPICAL OF ALL RATED WALLS.

**NORTH LITTLE ROCK
FIRE DEPARTMENT
STATION 8**

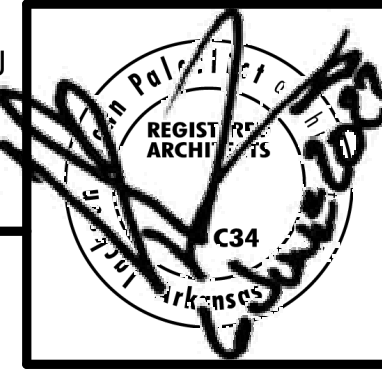

**Jackson
Brown
Palculict
architects**

Date
6/6/22
Revisions


JOB NUMBER 2203

Sheet Title
BUILDING SECTIONS


Sheet Number
A301

12921 Cantrell Road, Suite 201
Little Rock, AR 72223
501.664.8700 tel
501.664.5189 fax
www.jbparcitects.com


CONSULTING

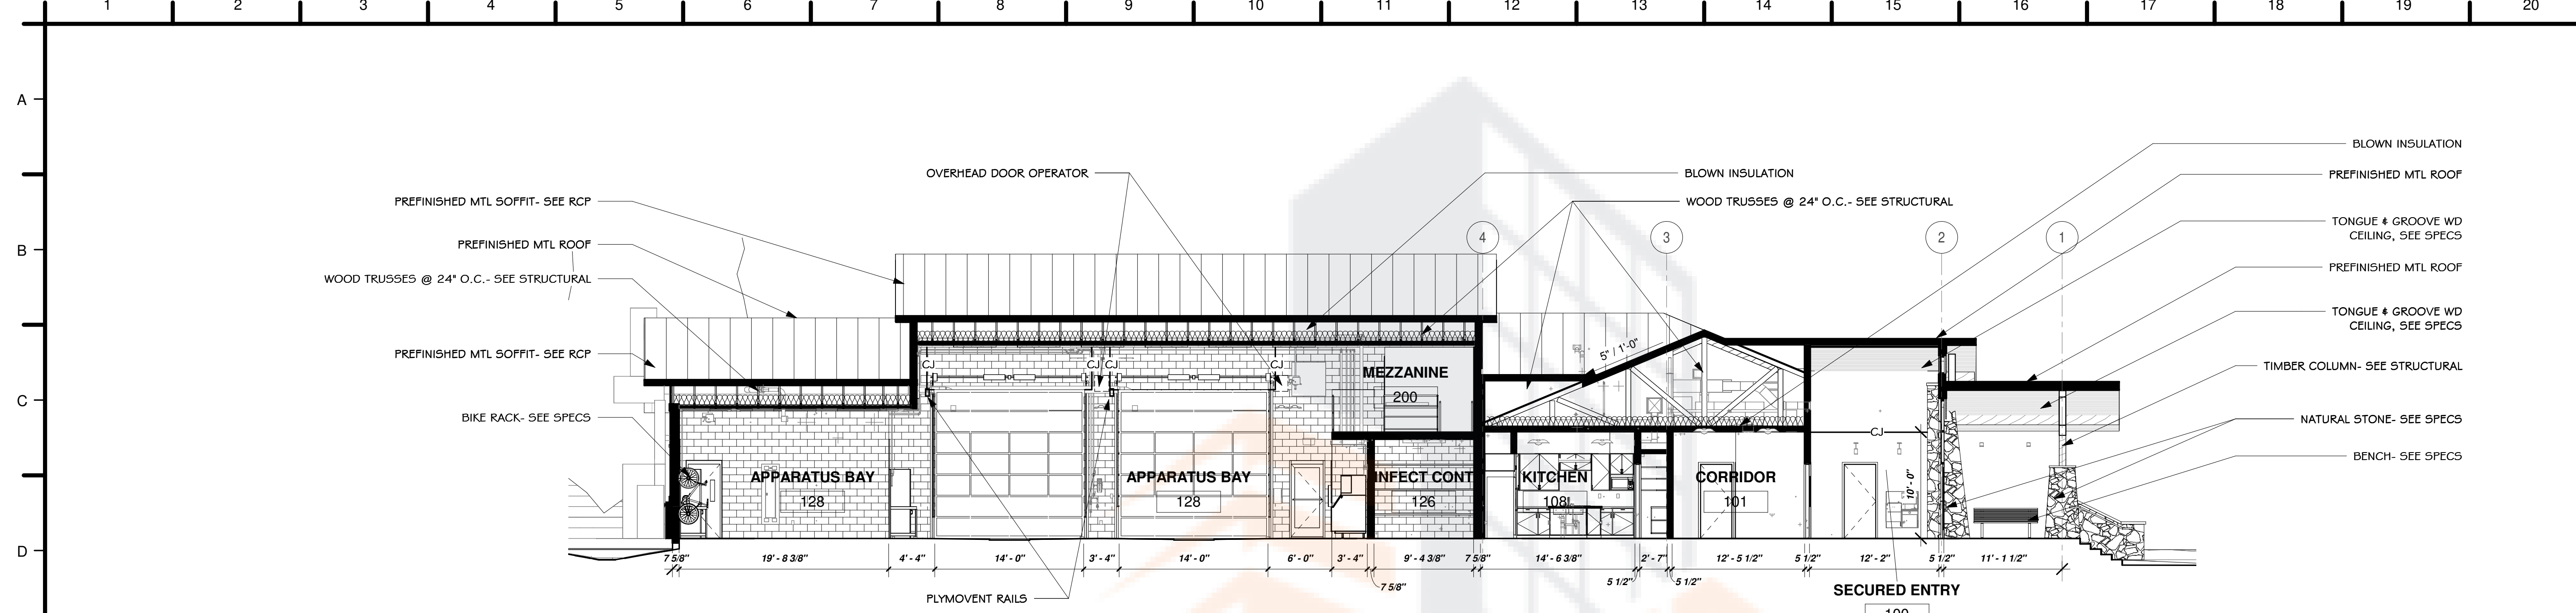


4 BUILDING SECTION 5
1/8" = 1'-0"

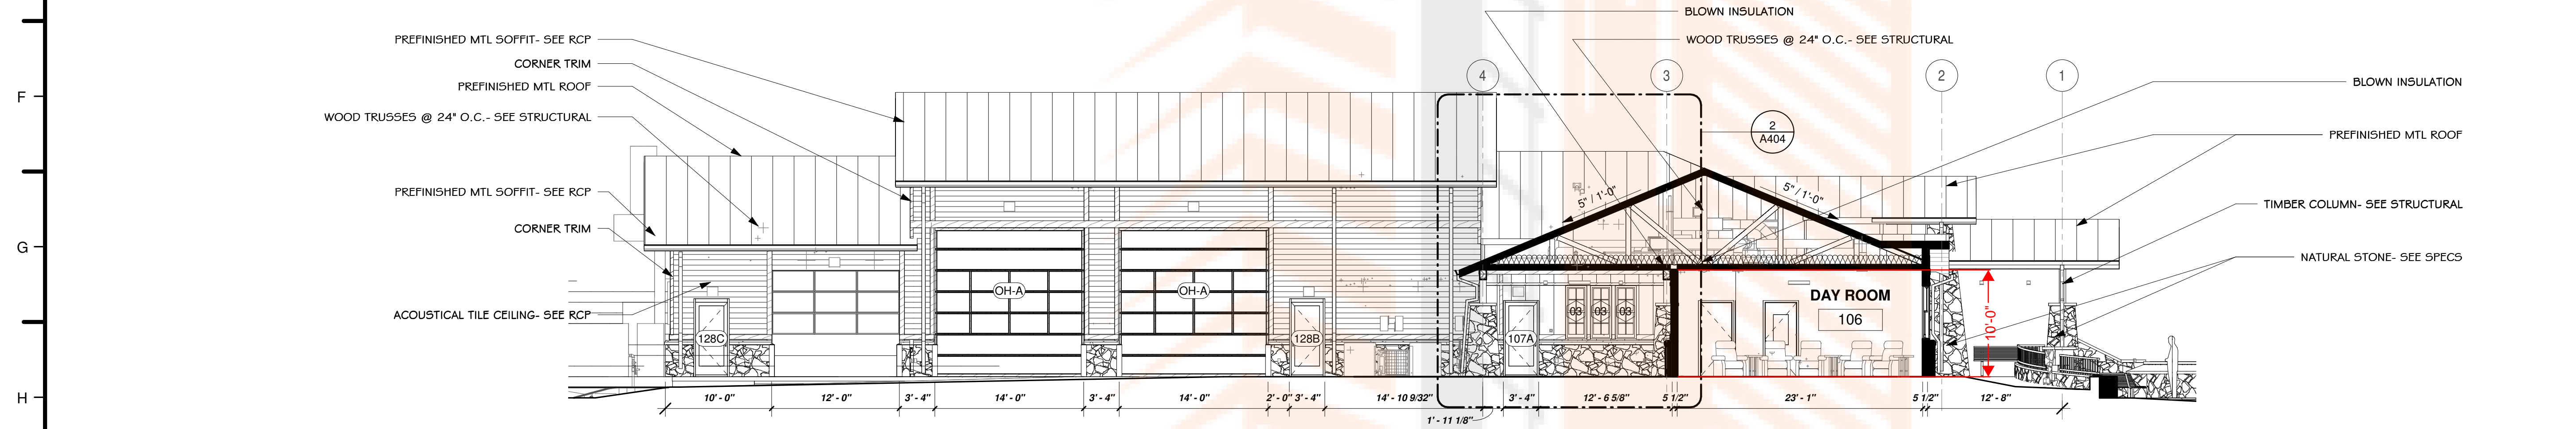

3 BUILDING SECTION 6
1/8" = 1'-0"

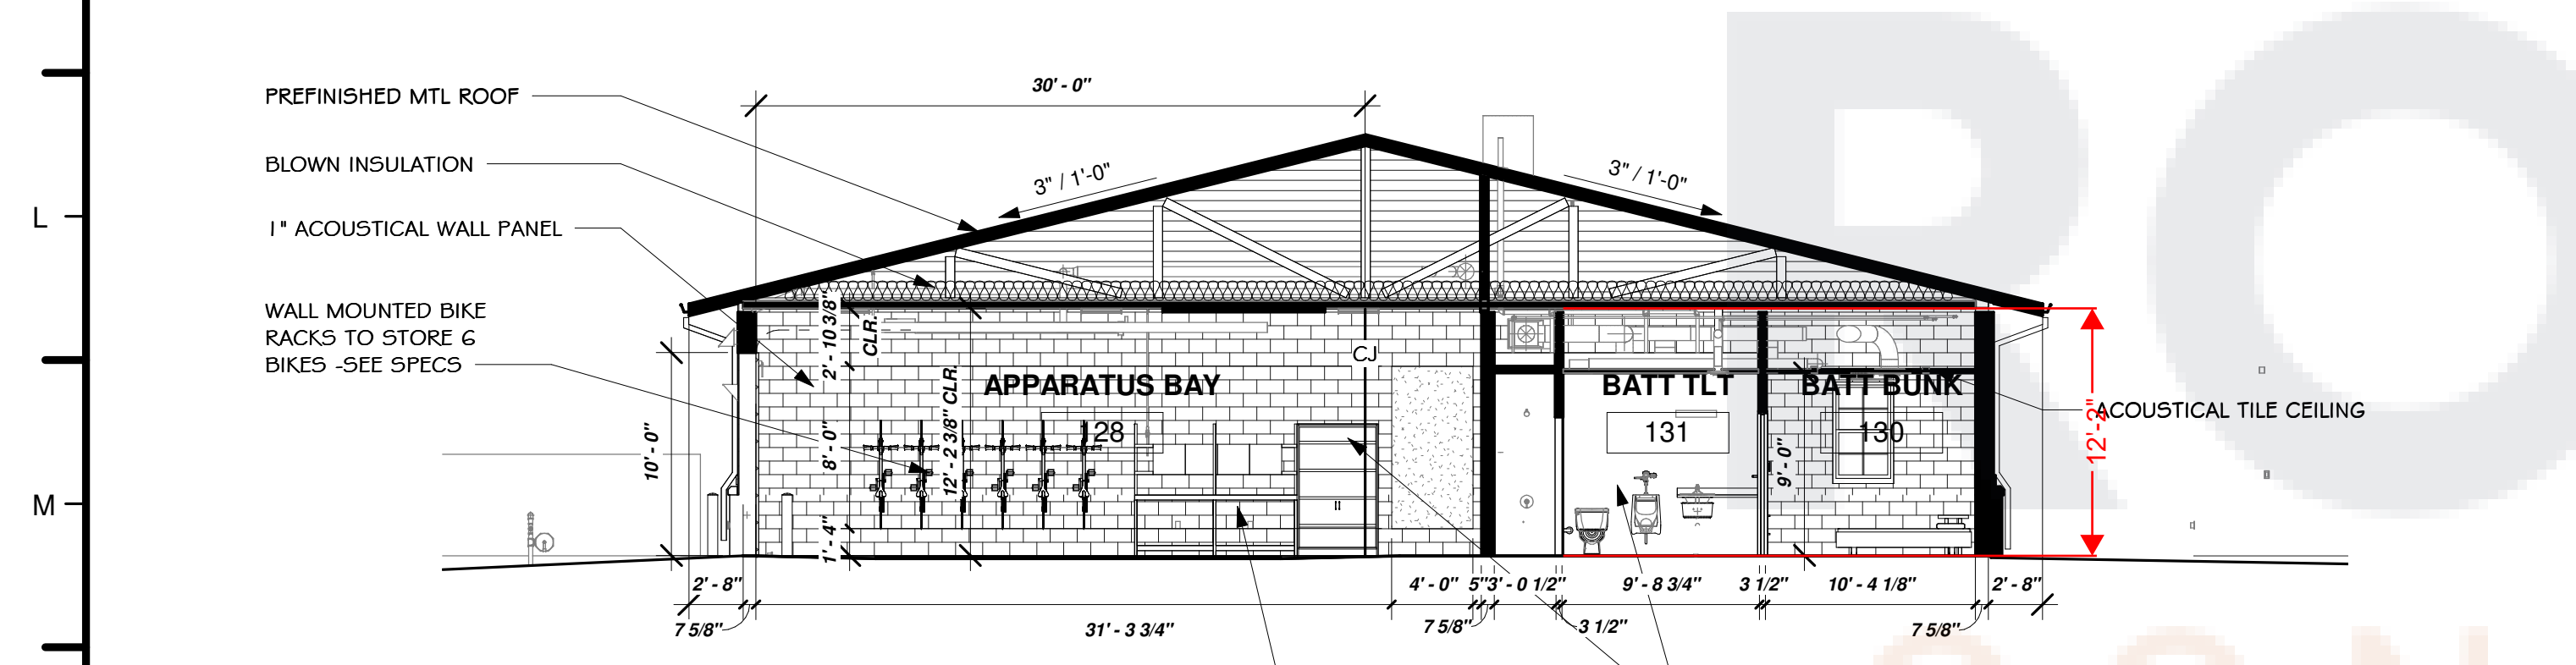


2 BUILDING SECTION 7
1/8" = 1'-0"

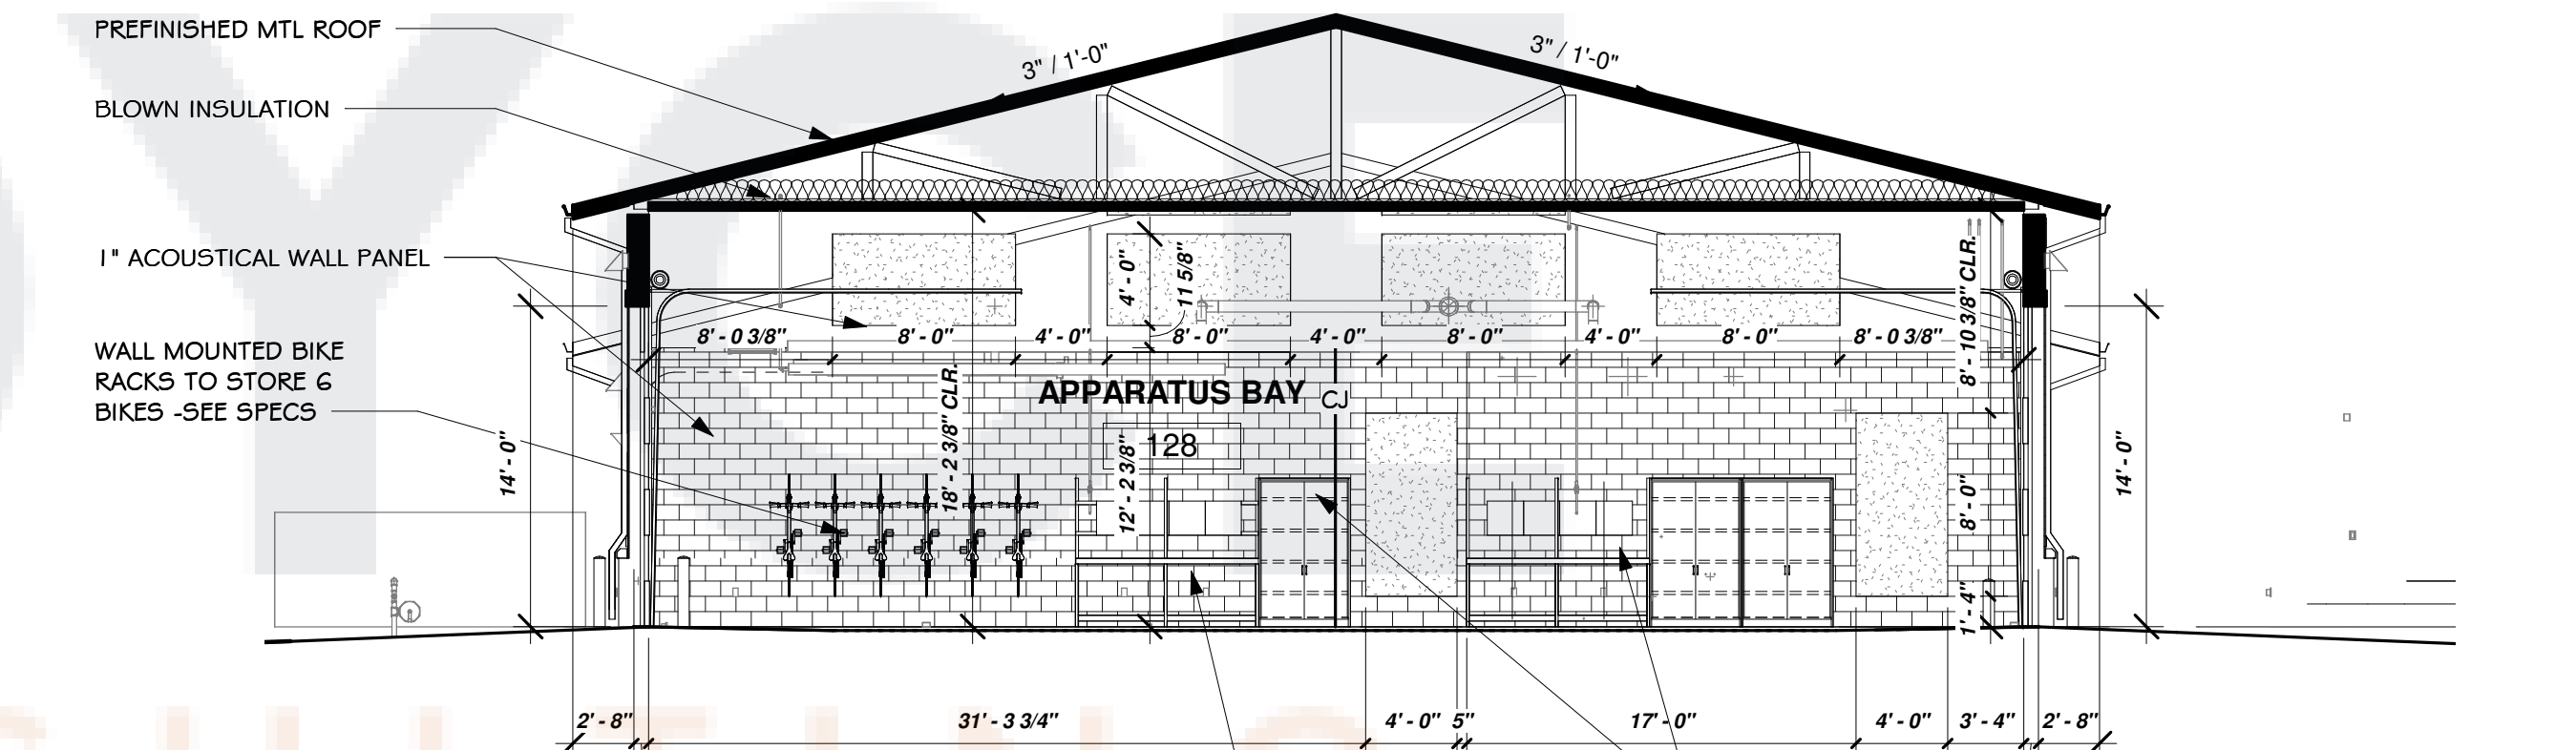

1 BUILDING SECTION 8
1/8" = 1'-0"

- General Notes**
1. PROVIDE FIELD PAINTING OF HANGERS AND EXPOSED-TO-VIEW METAL SURFACES OF ITEMS, AS REQUIRED TO MATCH ADJACENT SURFACES AND EQUIPMENT INSTALLED UNDER MECHANICAL AND ELECTRICAL WORK. THIS INCLUDES BUT IS NOT LIMITED TO, ALL EXPOSED CONDUIT, FIRE SPRINKLER PIPING, HANGERS, DUCTWORK, SUPPORTS, ETC. IF IT CAN BE SEEN, PAINT IT. ARCHITECT TO SELECT COLOR OR COLORS.
 2. ALL DIMENSIONS ARE TO FACE OF STUD, OR CMU U.N.O.
 3. "CJ" INDICATES CONTROL JOINT. SEE SPECIFICATIONS FOR DESCRIPTION OF METHODS AND LOCATIONS PERTAINING TO REQUIREMENTS.
 4. CONTRACTOR TO COORDINATE REQUIRED INSTALLATION OF ALL BLOCKING FOR (NOT LIMITED TO) ALL FIXTURES, EQUIP, OR SIGNAGE.
 5. PROVIDE 3" TALL HELVETICA LETTERS STENCILED AT ALL RATED WALLS, STENCILING TO READ AS FOLLOWS "FIRE AND SMOKE BARRIER-PROTECT ALL OPENINGS". INCLUDE UL NUMBERS TYPICAL OF ALL RATED WALLS.

**NORTH LITTLE ROCK
FIRE DEPARTMENT
STATION 8**

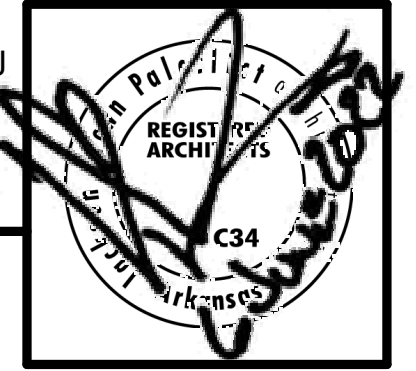

**Jackson
Brown
Palculict
architects**

Date
6/6/22
Revisions


JOB NUMBER 2203

Sheet Title
BUILDING SECTIONS

Sheet Number
A302


12921 Cantrell Road, Suite 201
Little Rock, AR 72223
501.664.8700 tel
501.664.5189 fax
www.jbparchitects.com

DOYER CONSULTING

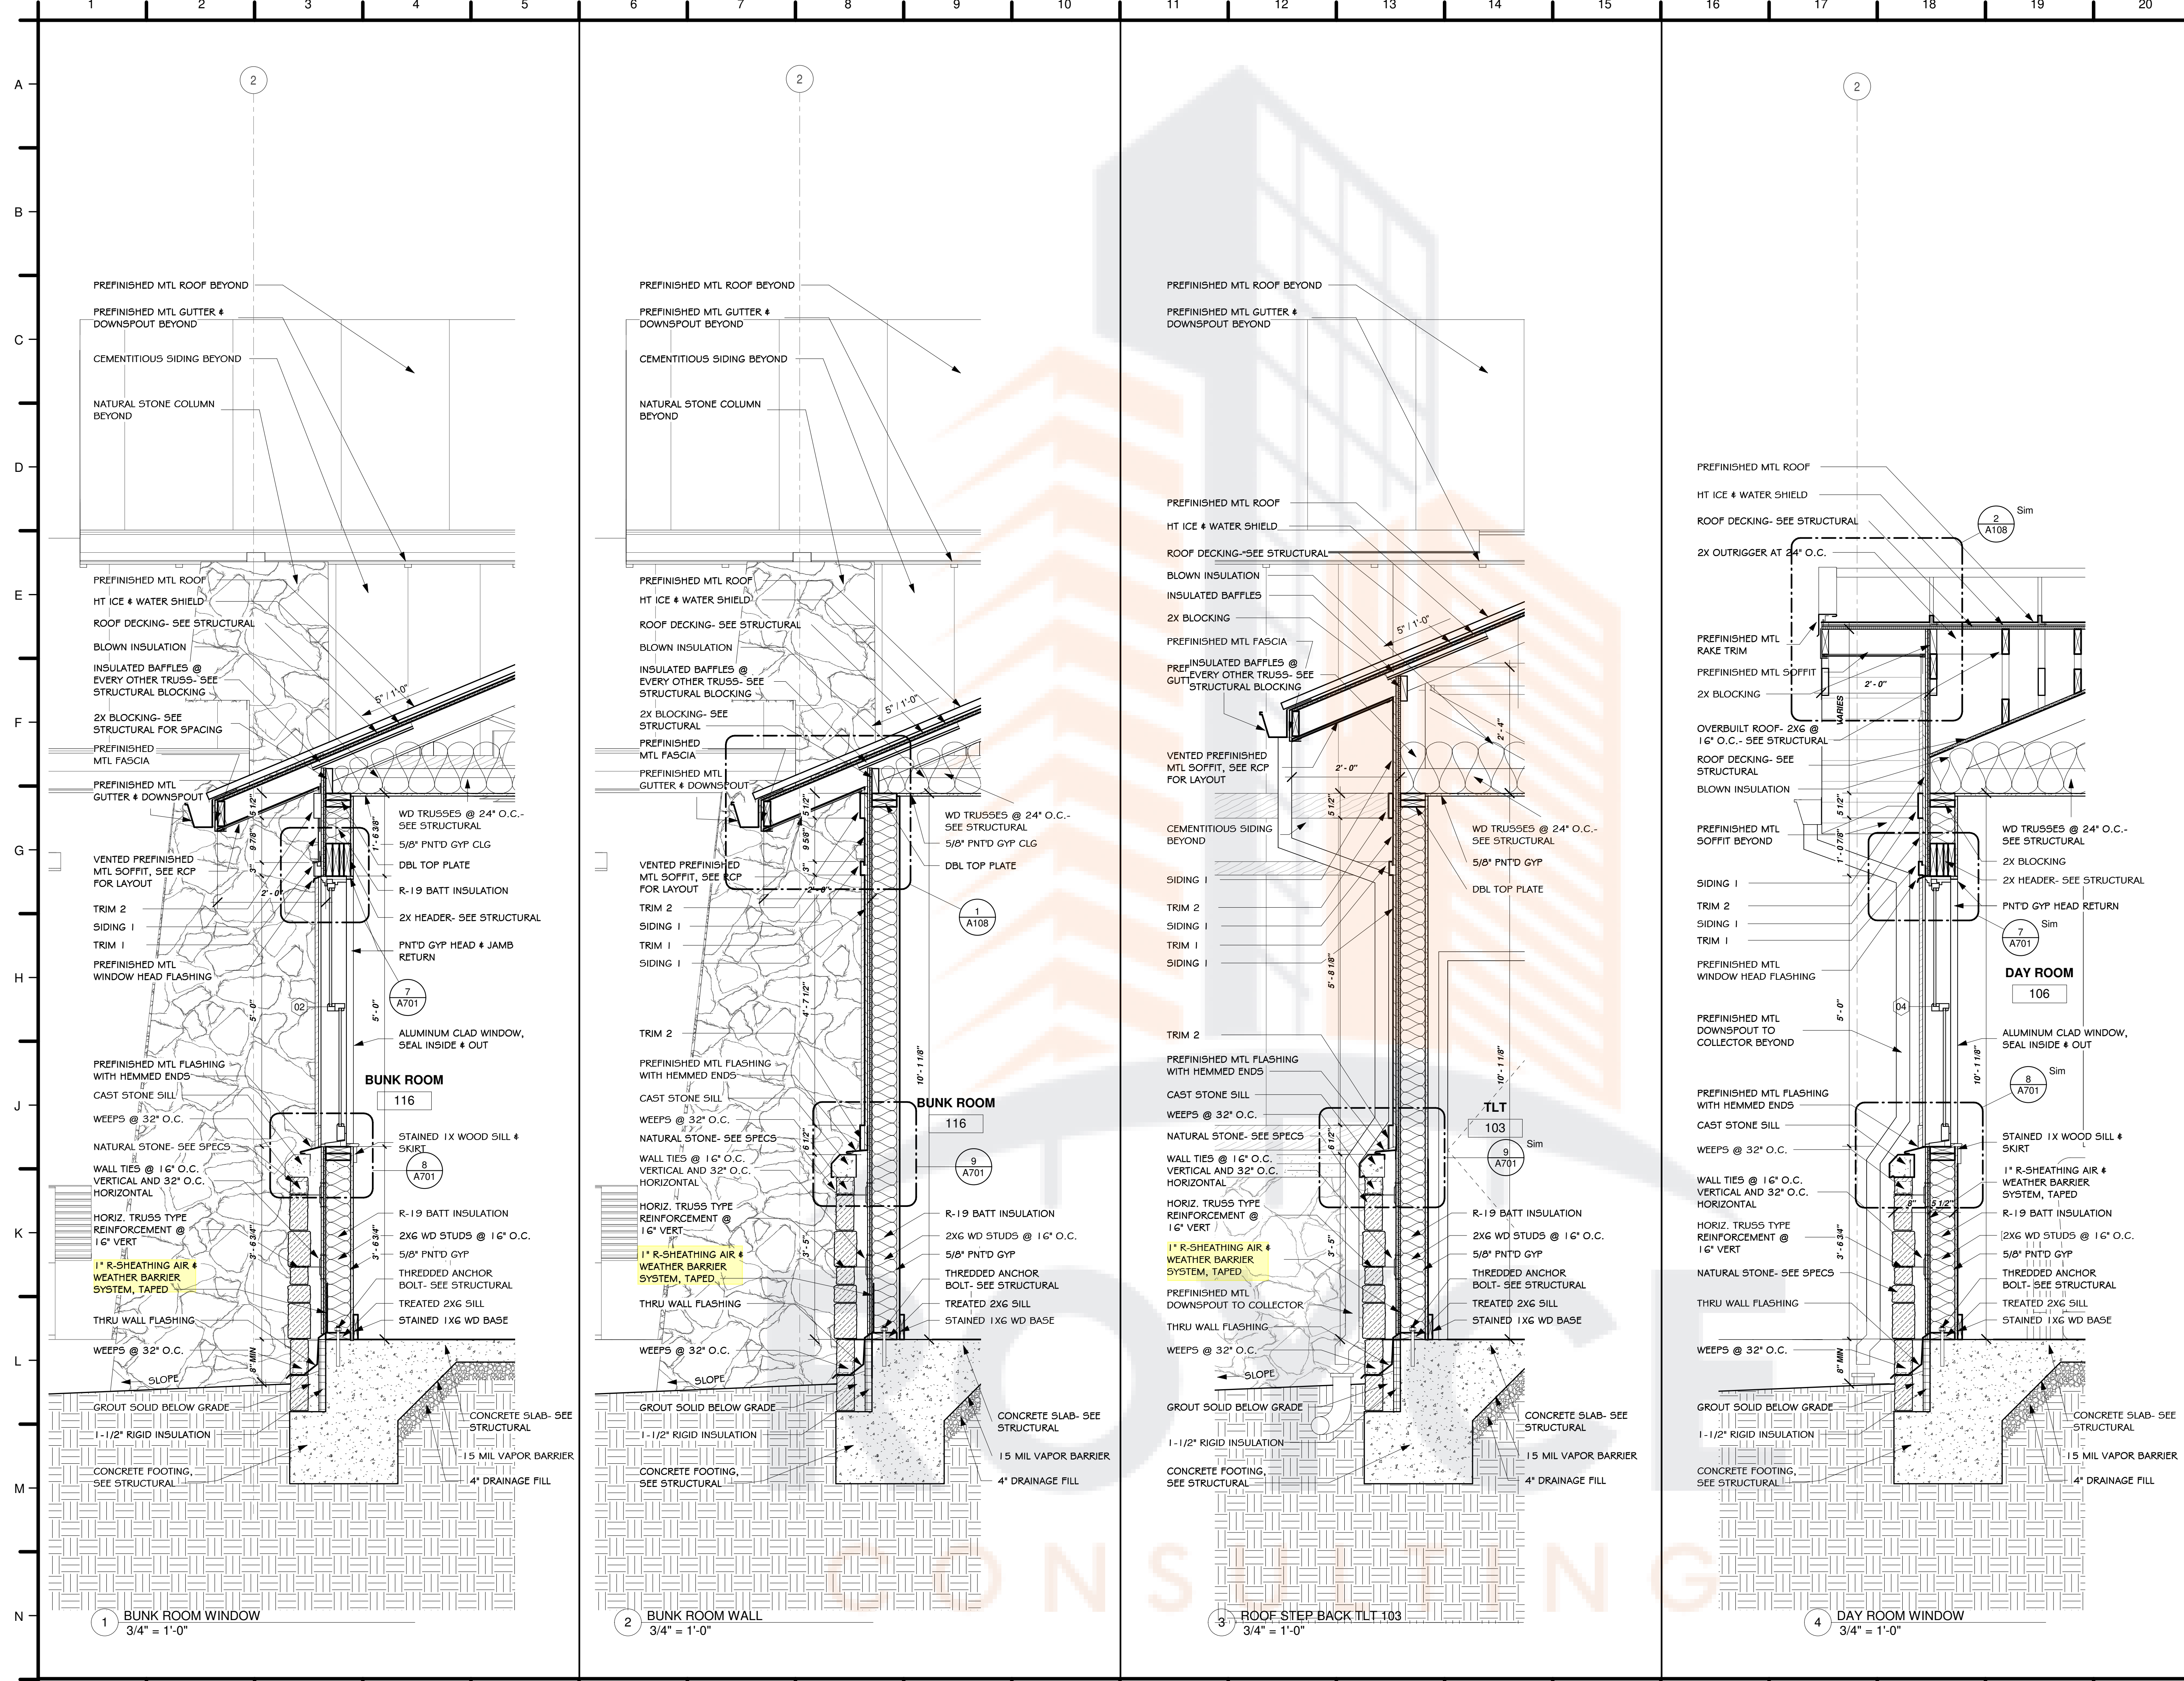

- General Notes**
1. PROVIDE FIELD PAINTING OF HANGERS AND EXPOSED-TO-VIEW METAL SURFACES OF ITEMS, AS REQUIRED TO MATCH ADJACENT SURFACES AND EQUIPMENT INSTALLED UNDER MECHANICAL AND ELECTRICAL WORK. THIS INCLUDES BUT IS NOT LIMITED TO, ALL EXPOSED CONDUIT, FIRE SPRINKLER PIPING, HANGERS, DUCTWORK, SUPPORTS, ETC. IF IT CAN BE SEEN, PAINT IT. ARCHITECT TO SELECT COLOR OR COLORS.
 2. ALL DIMENSIONS ARE TO FACE OF STUD, OR CMU U.N.O. "C" INDICATES CONTROL JOINT. SEE SPECIFICATIONS FOR DESCRIPTION OF METHODS AND LOCATIONS PERTAINING TO REQUIREMENTS.
 3. CONTRACTOR TO COORDINATE REQUIRED INSTALLATION OF ALL BLOCKING FOR (NOT LIMITED TO) ALL FIXTURES, EQUIP, OR SIGNAGE.
 4. PROVIDE 3" TALL HELVETICA LETTERS STENCILED AT ALL RATED WALLS, STENCILING TO READ AS FOLLOWS "FIRE AND SMOKE BARRIER-PROTECT ALL OPENINGS". INCLUDE UL NUMBERS TYPICAL OF ALL RATED WALLS.

**NORTH LITTLE ROCK
FIRE DEPARTMENT
STATION 8**

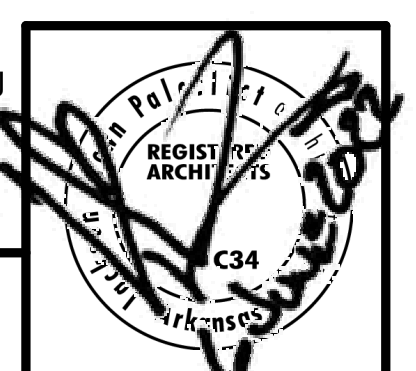


**Jackson
Brown
Palculict
architects**

Date
6/6/22
Revisions

Sheet Title
**WALL
SECTIONS**

Sheet Number
A401

12921 Cantrell Road, Suite 201
Little Rock, AR 72223
501.664.8700 tel
501.664.5189 fax
www.jbparchitects.com

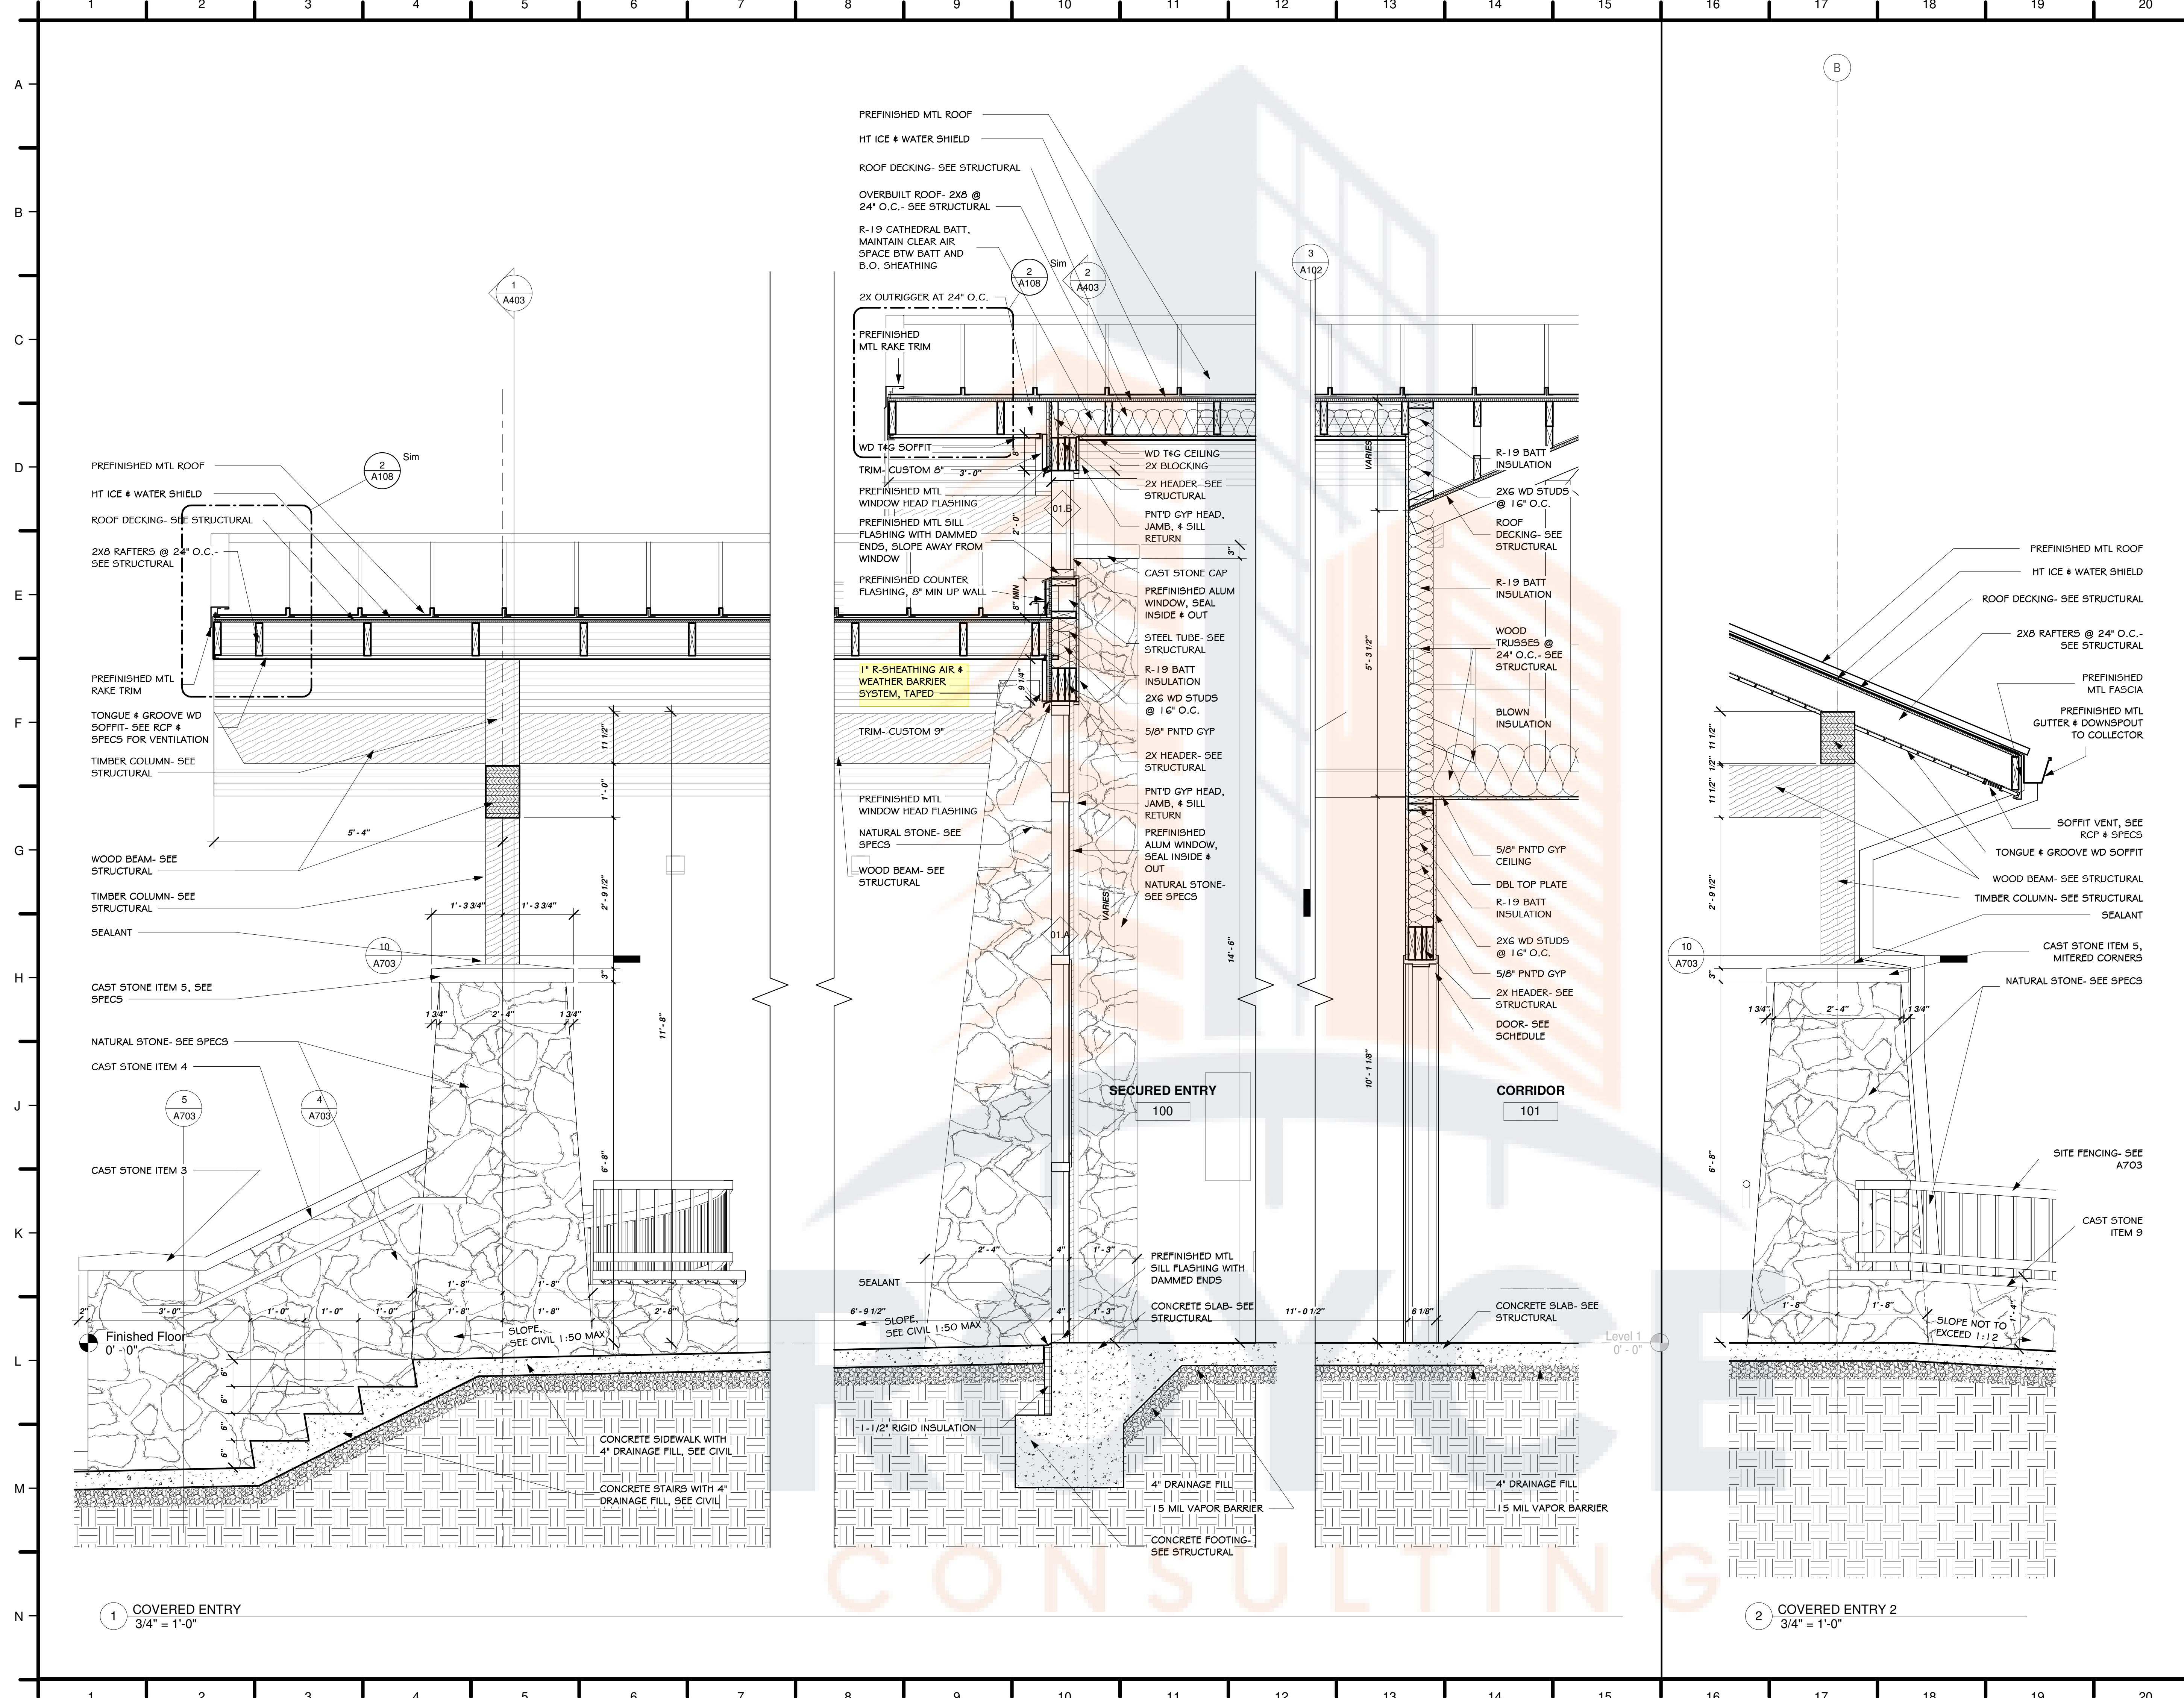

- General Notes**
1. PROVIDE FIELD PAINTING OF HANGERS AND EXPOSED-TO-VIEW METAL SURFACES OF ITEMS, AS REQUIRED TO MATCH ADJACENT SURFACES AND EQUIPMENT INSTALLED UNDER MECHANICAL AND ELECTRICAL WORK. THIS INCLUDES BUT IS NOT LIMITED TO, ALL EXPOSED CONDUIT, FIRE SPRINKLER PIPING, HANGERS, DUCTWORK, SUPPORTS, ETC. IF IT CAN BE SEEN, PAINT IT. ARCHITECT TO SELECT COLOR OR COLORS.
 2. ALL DIMENSIONS ARE TO FACE OF STUD, OR CMU U.N.O.
 3. 'CJ' INDICATES CONTROL JOINT. SEE SPECIFICATIONS FOR DESCRIPTION OF METHODS AND LOCATIONS PERTAINING TO REQUIREMENTS.
 4. CONTRACTOR TO COORDINATE REQUIRED INSTALLATION OF ALL BLOCKING FOR (NOT LIMITED TO) ALL FIXTURES, EQUIP, OR SIGNAGE.
 5. PROVIDE 3" TALL HELVETICA LETTERS STENCILED AT ALL RATED WALLS, STENCILING TO READ AS FOLLOWS "FIRE AND SMOKE BARRIER-PROTECT ALL OPENINGS". INCLUDE UL NUMBERS TYPICAL OF ALL RATED WALLS.

**NORTH LITTLE ROCK
FIRE DEPARTMENT
STATION 8**



Date
6/6/22
Revisions





JOB NUMBER 2203

Sheet Title
WALL SECTIONS

Sheet Number
A402

12921 Cantrell Road, Suite 201
Little Rock, AR 72223
501.664.8700 tel
501.664.5189 fax
www.jbparchitects.com

Copyright 2019 JBP

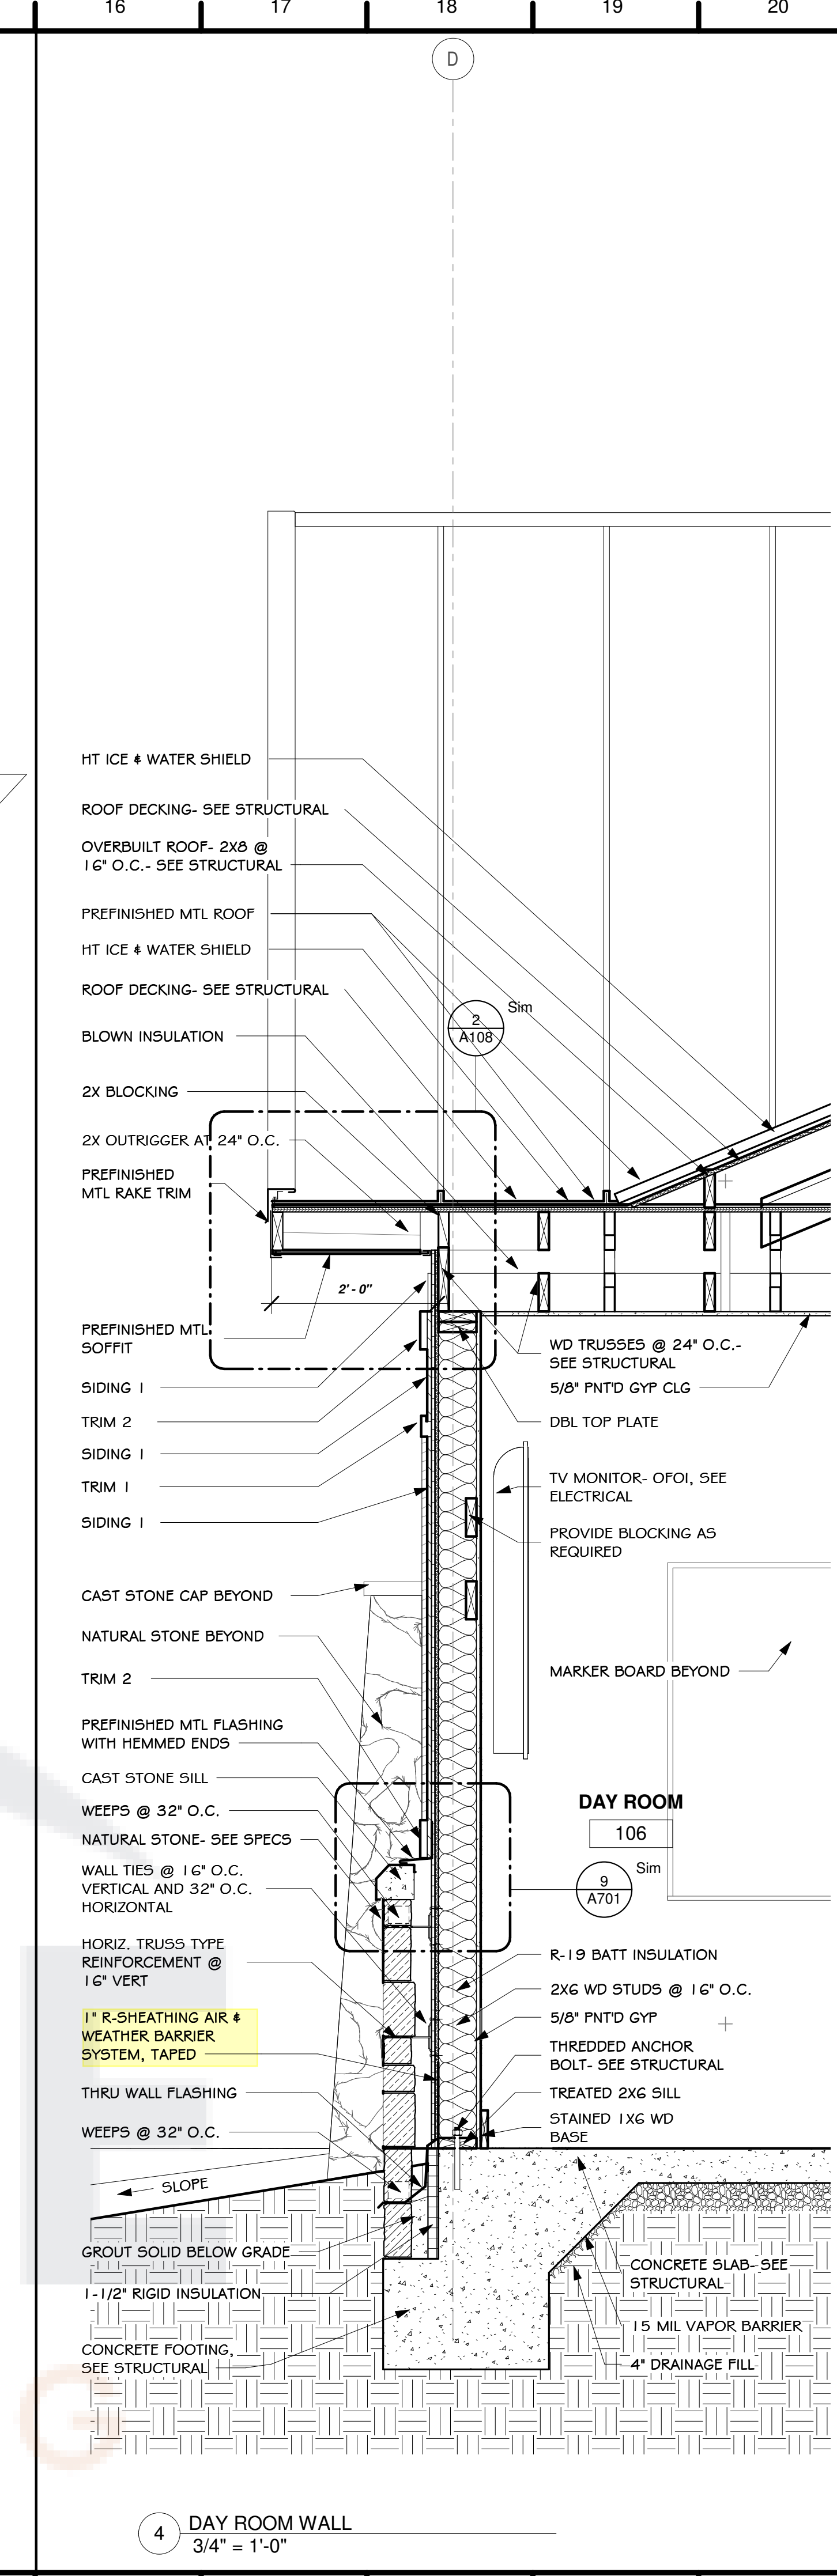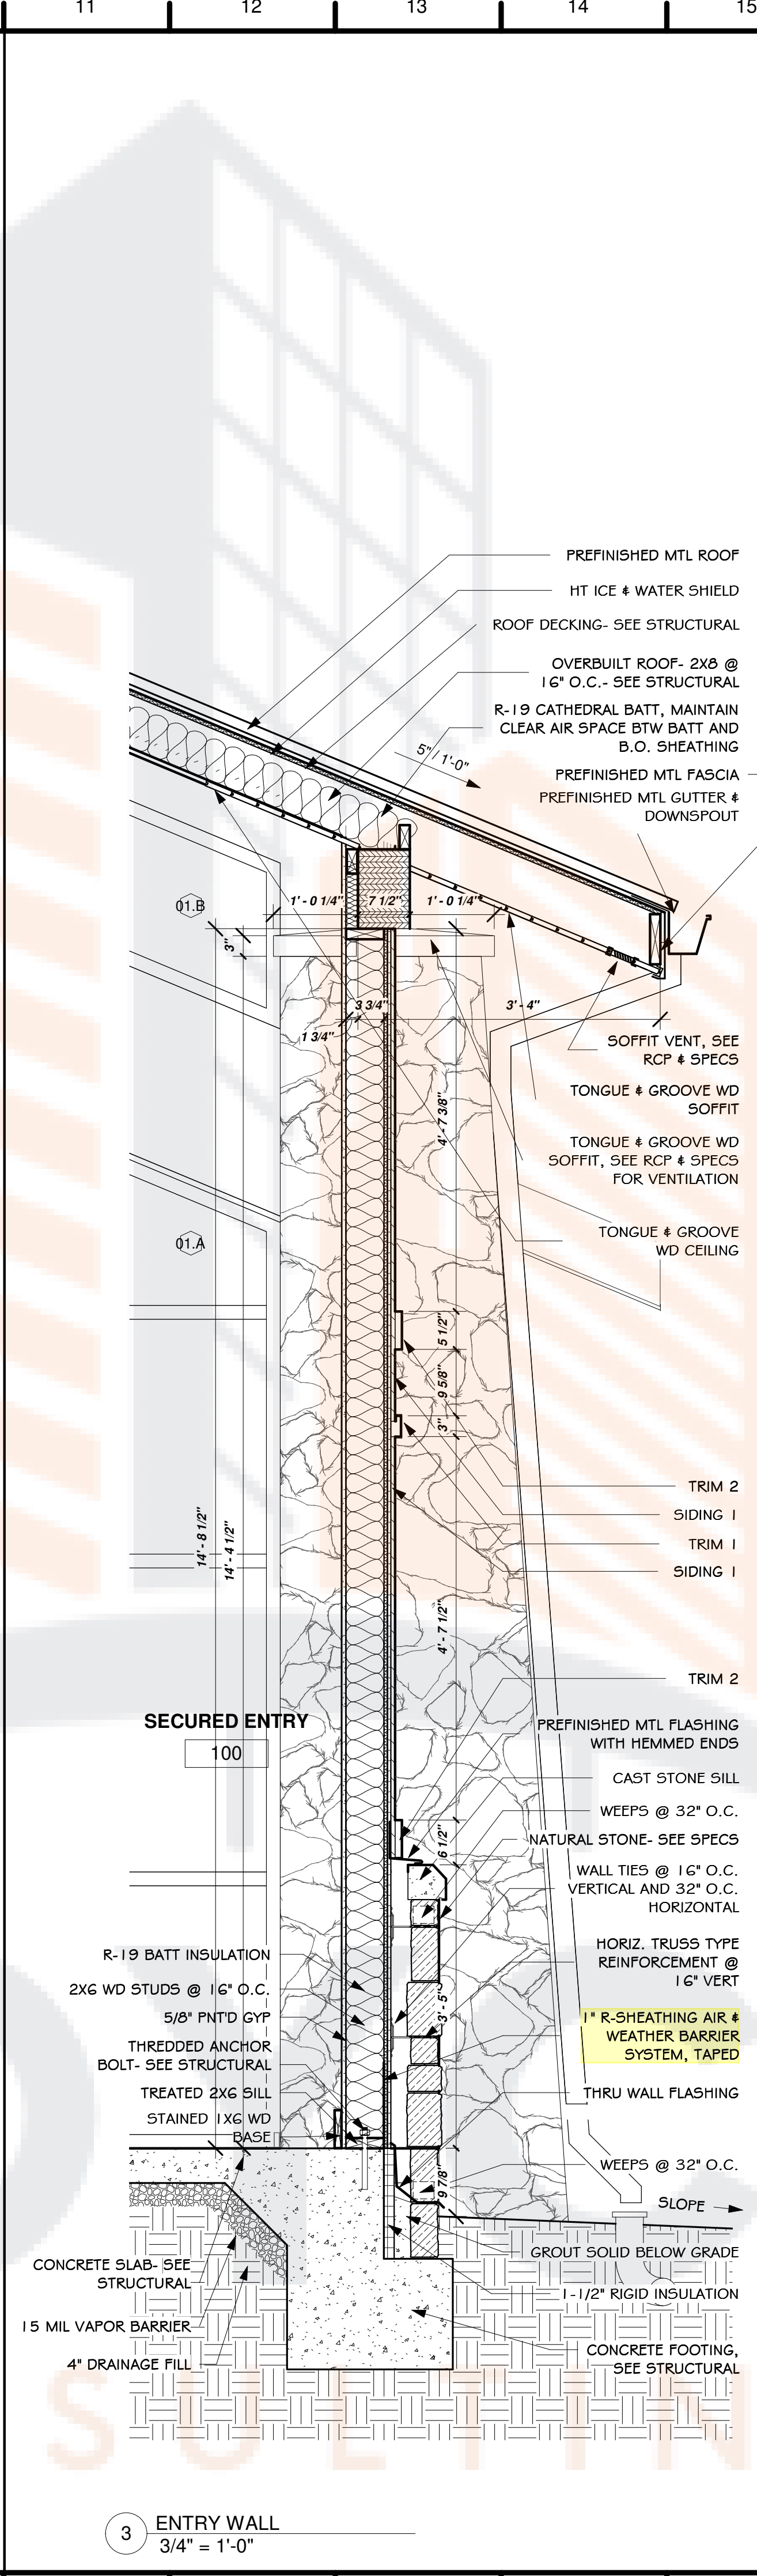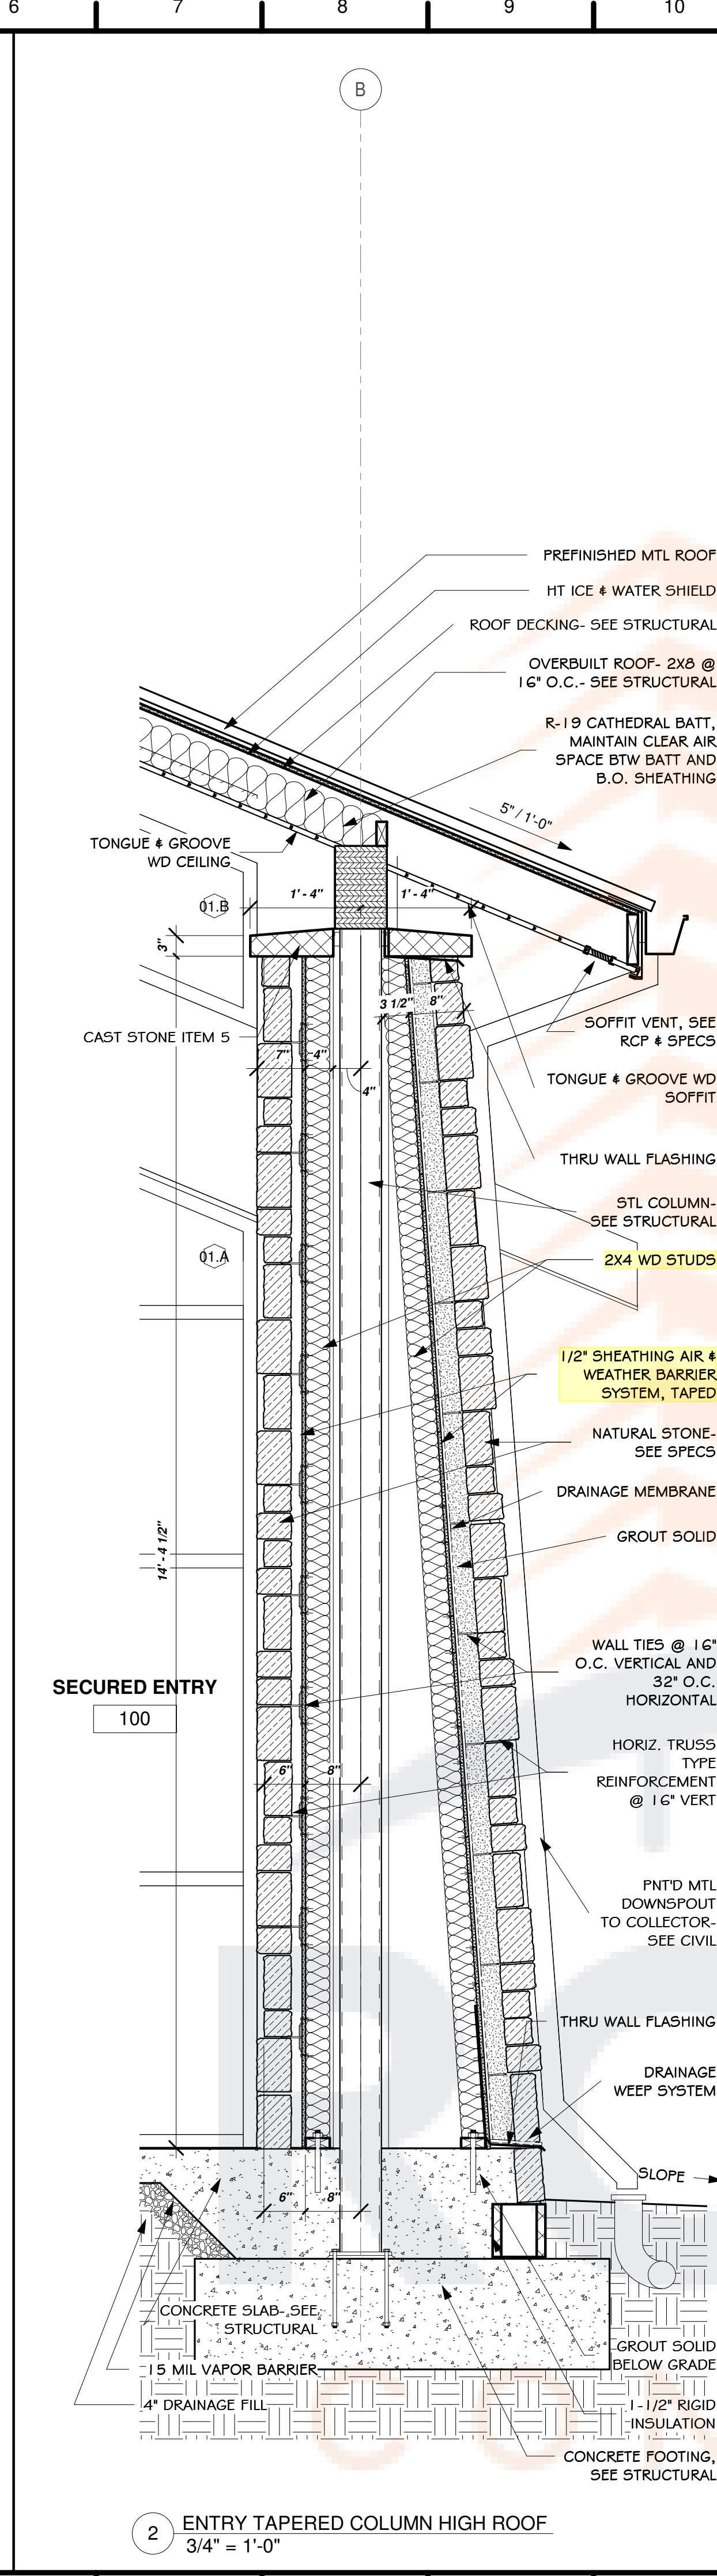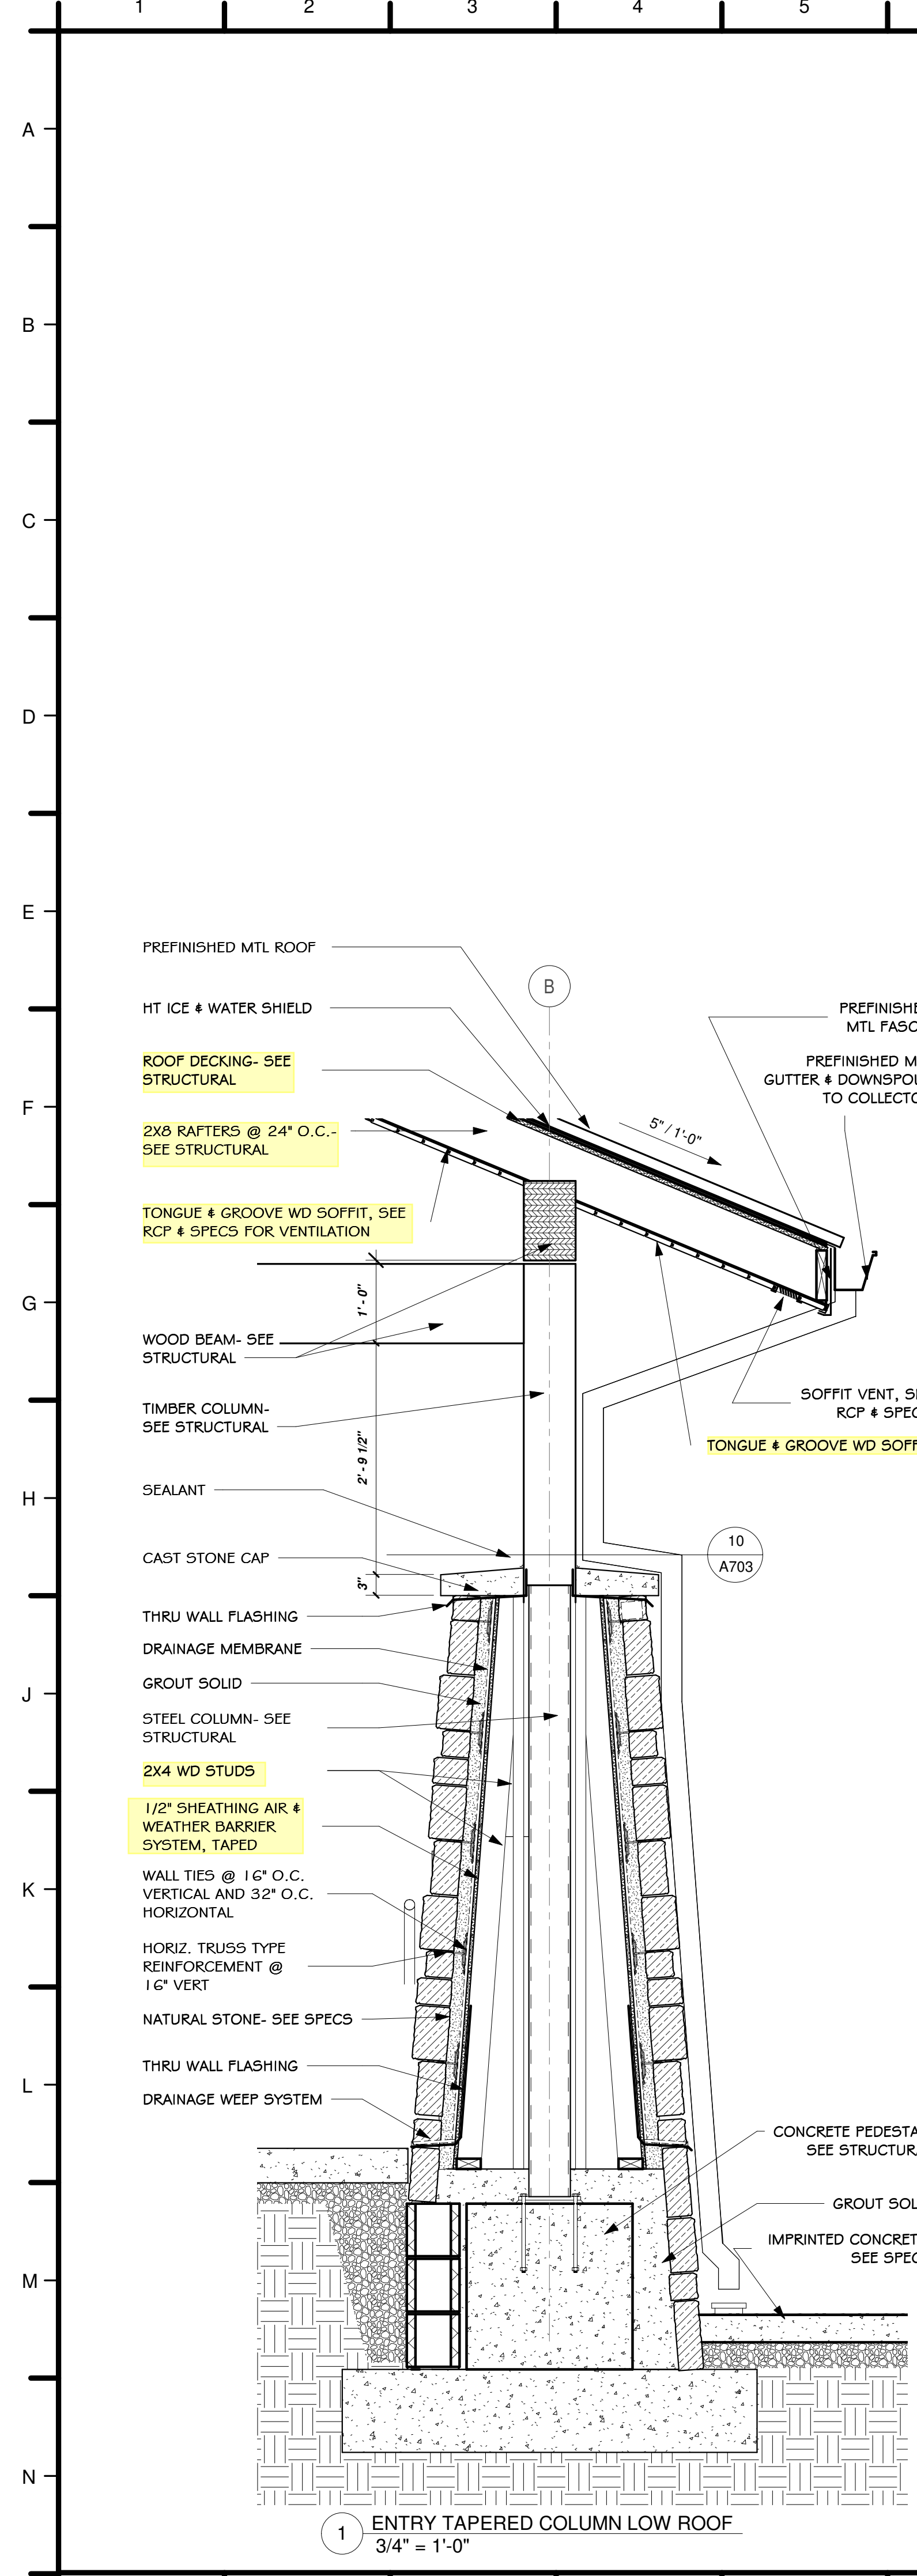

General Notes

- PROVIDE FIELD PAINTING OF HANGERS AND EXPOSED-TO-VIEW METAL SURFACES OF ITEMS, AS REQUIRED TO MATCH ADJACENT SURFACES AND EQUIPMENT INSTALLED UNDER MECHANICAL AND ELECTRICAL WORK. THIS INCLUDES BUT IS NOT LIMITED TO, ALL EXPOSED CONDUIT, FIRE SPRINKLER PIPING, HANGERS, DUCTWORK, SUPPORTS, ETC. IF IT CAN BE SEEN, PAINT IT. ARCHITECT TO SELECT COLOR OR COLORS.
- ALL DIMENSIONS ARE TO FACE OF STUD, OR CMU U.N.O.
- "CJ" INDICATES CONTROL JOINT. SEE SPECIFICATIONS FOR DESCRIPTION OF METHODS AND LOCATIONS PERTAINING TO REQUIREMENTS.
- CONTRACTOR TO COORDINATE REQUIRED INSTALLATION OF ALL BLOCKING FOR (NOT LIMITED TO) ALL FIXTURES, EQUIP, OR SIGNAGE.
- PROVIDE 3" TALL HELVETICA LETTERS STENCILED AT ALL RATED WALLS, STENCILING TO READ AS FOLLOWS "FIRE AND SMOKE BARRIER-PROTECT ALL OPENINGS". INCLUDE UL NUMBERS TYPICAL OF ALL RATED WALLS.

**NORTH LITTLE ROCK
FIRE DEPARTMENT
STATION 8**


**Jackson
Brown
Palculict
architects**

Date
6/6/22
Revisions

Sheet Title
**WALL
SECTIONS**


Sheet Number
A403

12921 Cantrell Road, Suite 201
Little Rock, AR 72223
501.664.8700 tel
501.664.5189 fax
www.jbpaarchitects.com

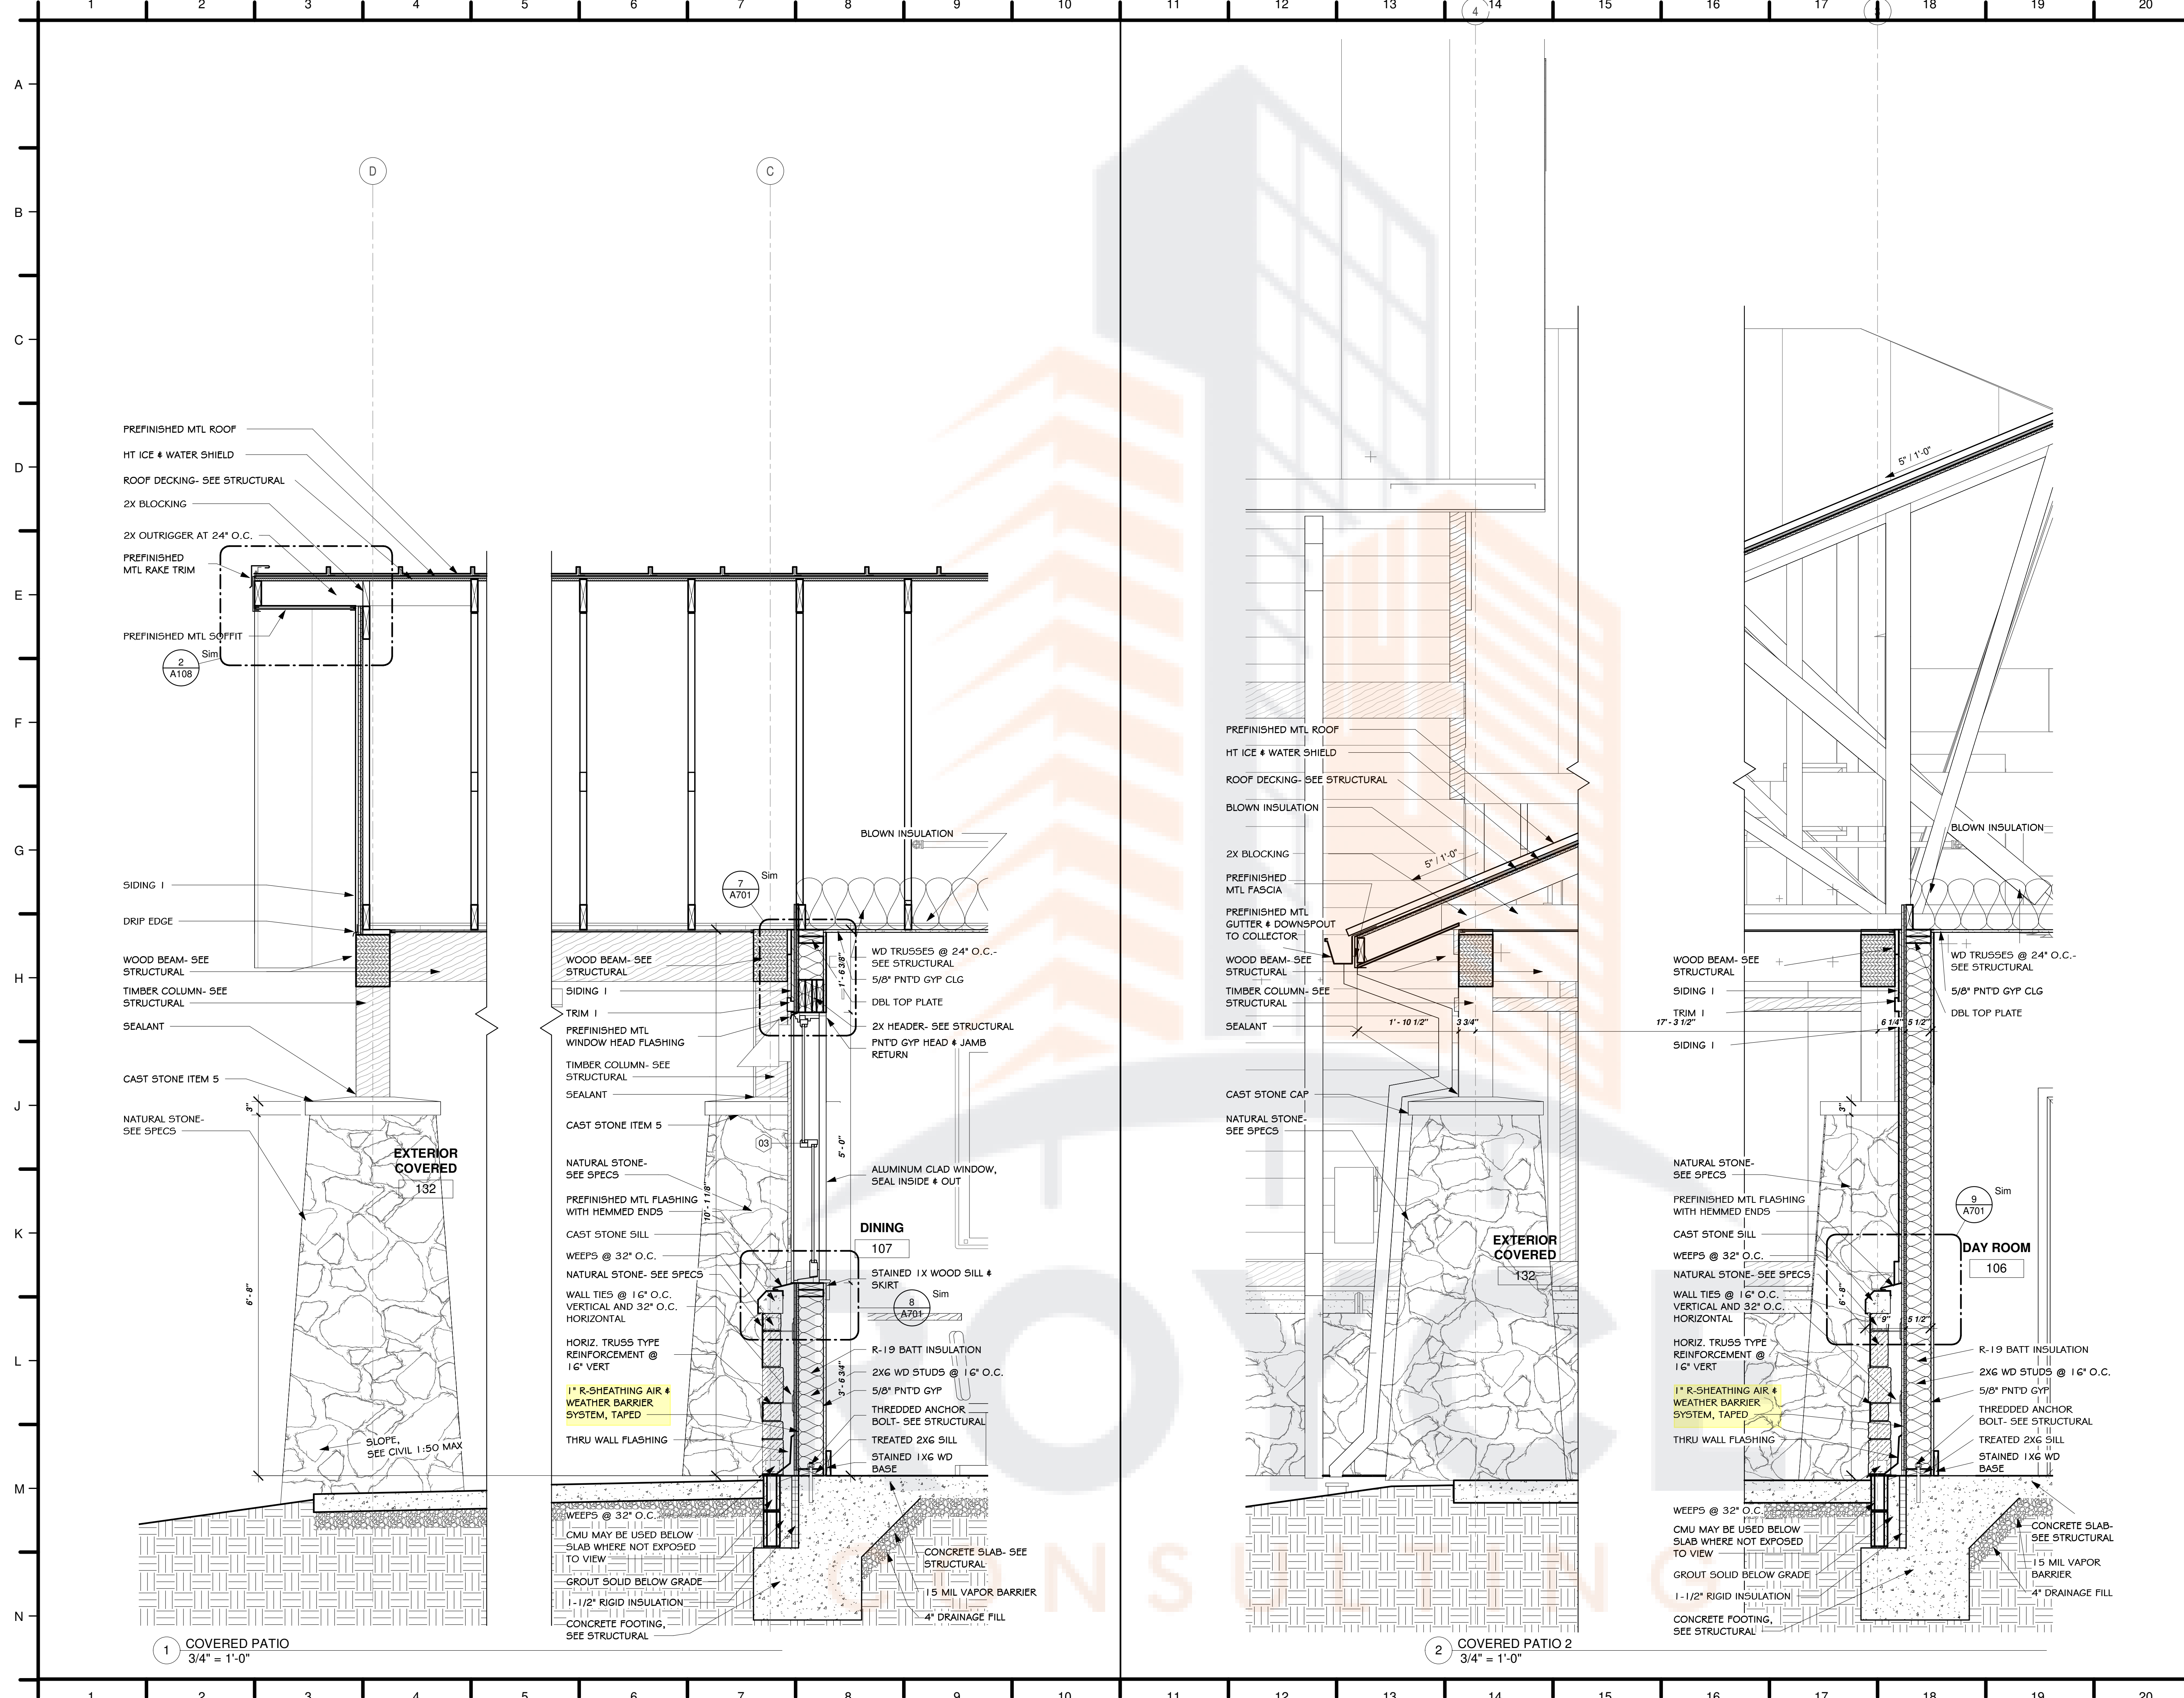

- General Notes**
1. PROVIDE FIELD PAINTING OF HANGERS AND EXPOSED-TO-VIEW METAL SURFACES AND EQUIPMENT AS REQUIRED TO MATCH ADJACENT SURFACES AND EQUIPMENT INSTALLED UNDER MECHANICAL AND ELECTRICAL WORK. THIS INCLUDES BUT IS NOT LIMITED TO, ALL EXPOSED CONDUIT, FIRE SPRINKLER PIPING, HANGERS, DUCTWORK, SUPPORTS, ETC. IF IT CAN BE SEEN, PAINT IT. ARCHITECT TO SELECT COLOR OR COLORS.
 2. ALL DIMENSIONS ARE TO FACE OF STUD, OR CMU U.N.O.
 3. 'CJ' INDICATES CONTROL JOINT. SEE SPECIFICATIONS FOR DESCRIPTION OF METHODS AND LOCATIONS PERTAINING TO REQUIREMENTS.
 4. CONTRACTOR TO COORDINATE REQUIRED INSTALLATION OF ALL BLOCKING FOR (NOT LIMITED TO) ALL FIXTURES, EQUIP, OR SIGNAGE.
 5. PROVIDE 3" TALL HELVETICA LETTERS STENCILED AT ALL RATED WALLS. STENCILING TO READ AS FOLLOWS 'FIRE AND SMOKE BARRIER-PROTECT ALL OPENINGS'. INCLUDE UL NUMBERS TYPICAL OF ALL RATED WALLS.

**NORTH LITTLE ROCK
FIRE DEPARTMENT
STATION 8**

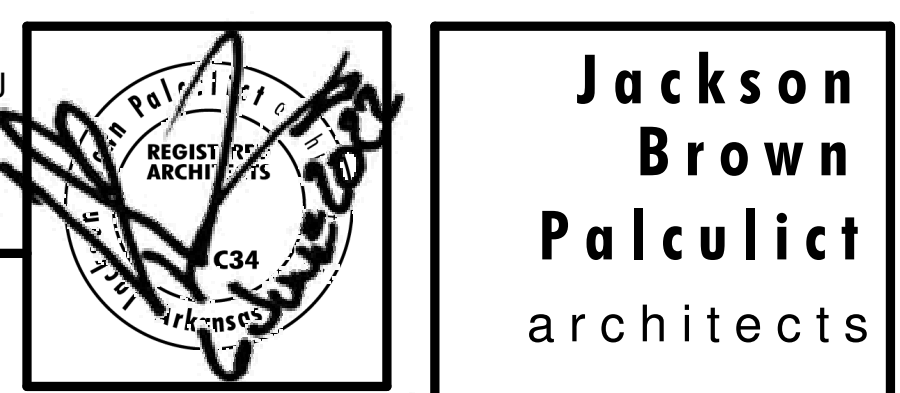


Date
6/6/22
Revisions

JOB NUMBER 2203

Sheet Title
WALL SECTIONS

Sheet Number
A404

12921 Cantrell Road, Suite 201
Little Rock, AR 72223
501.664.8700 tel
501.664.5189 fax
www.jbparcitects.com

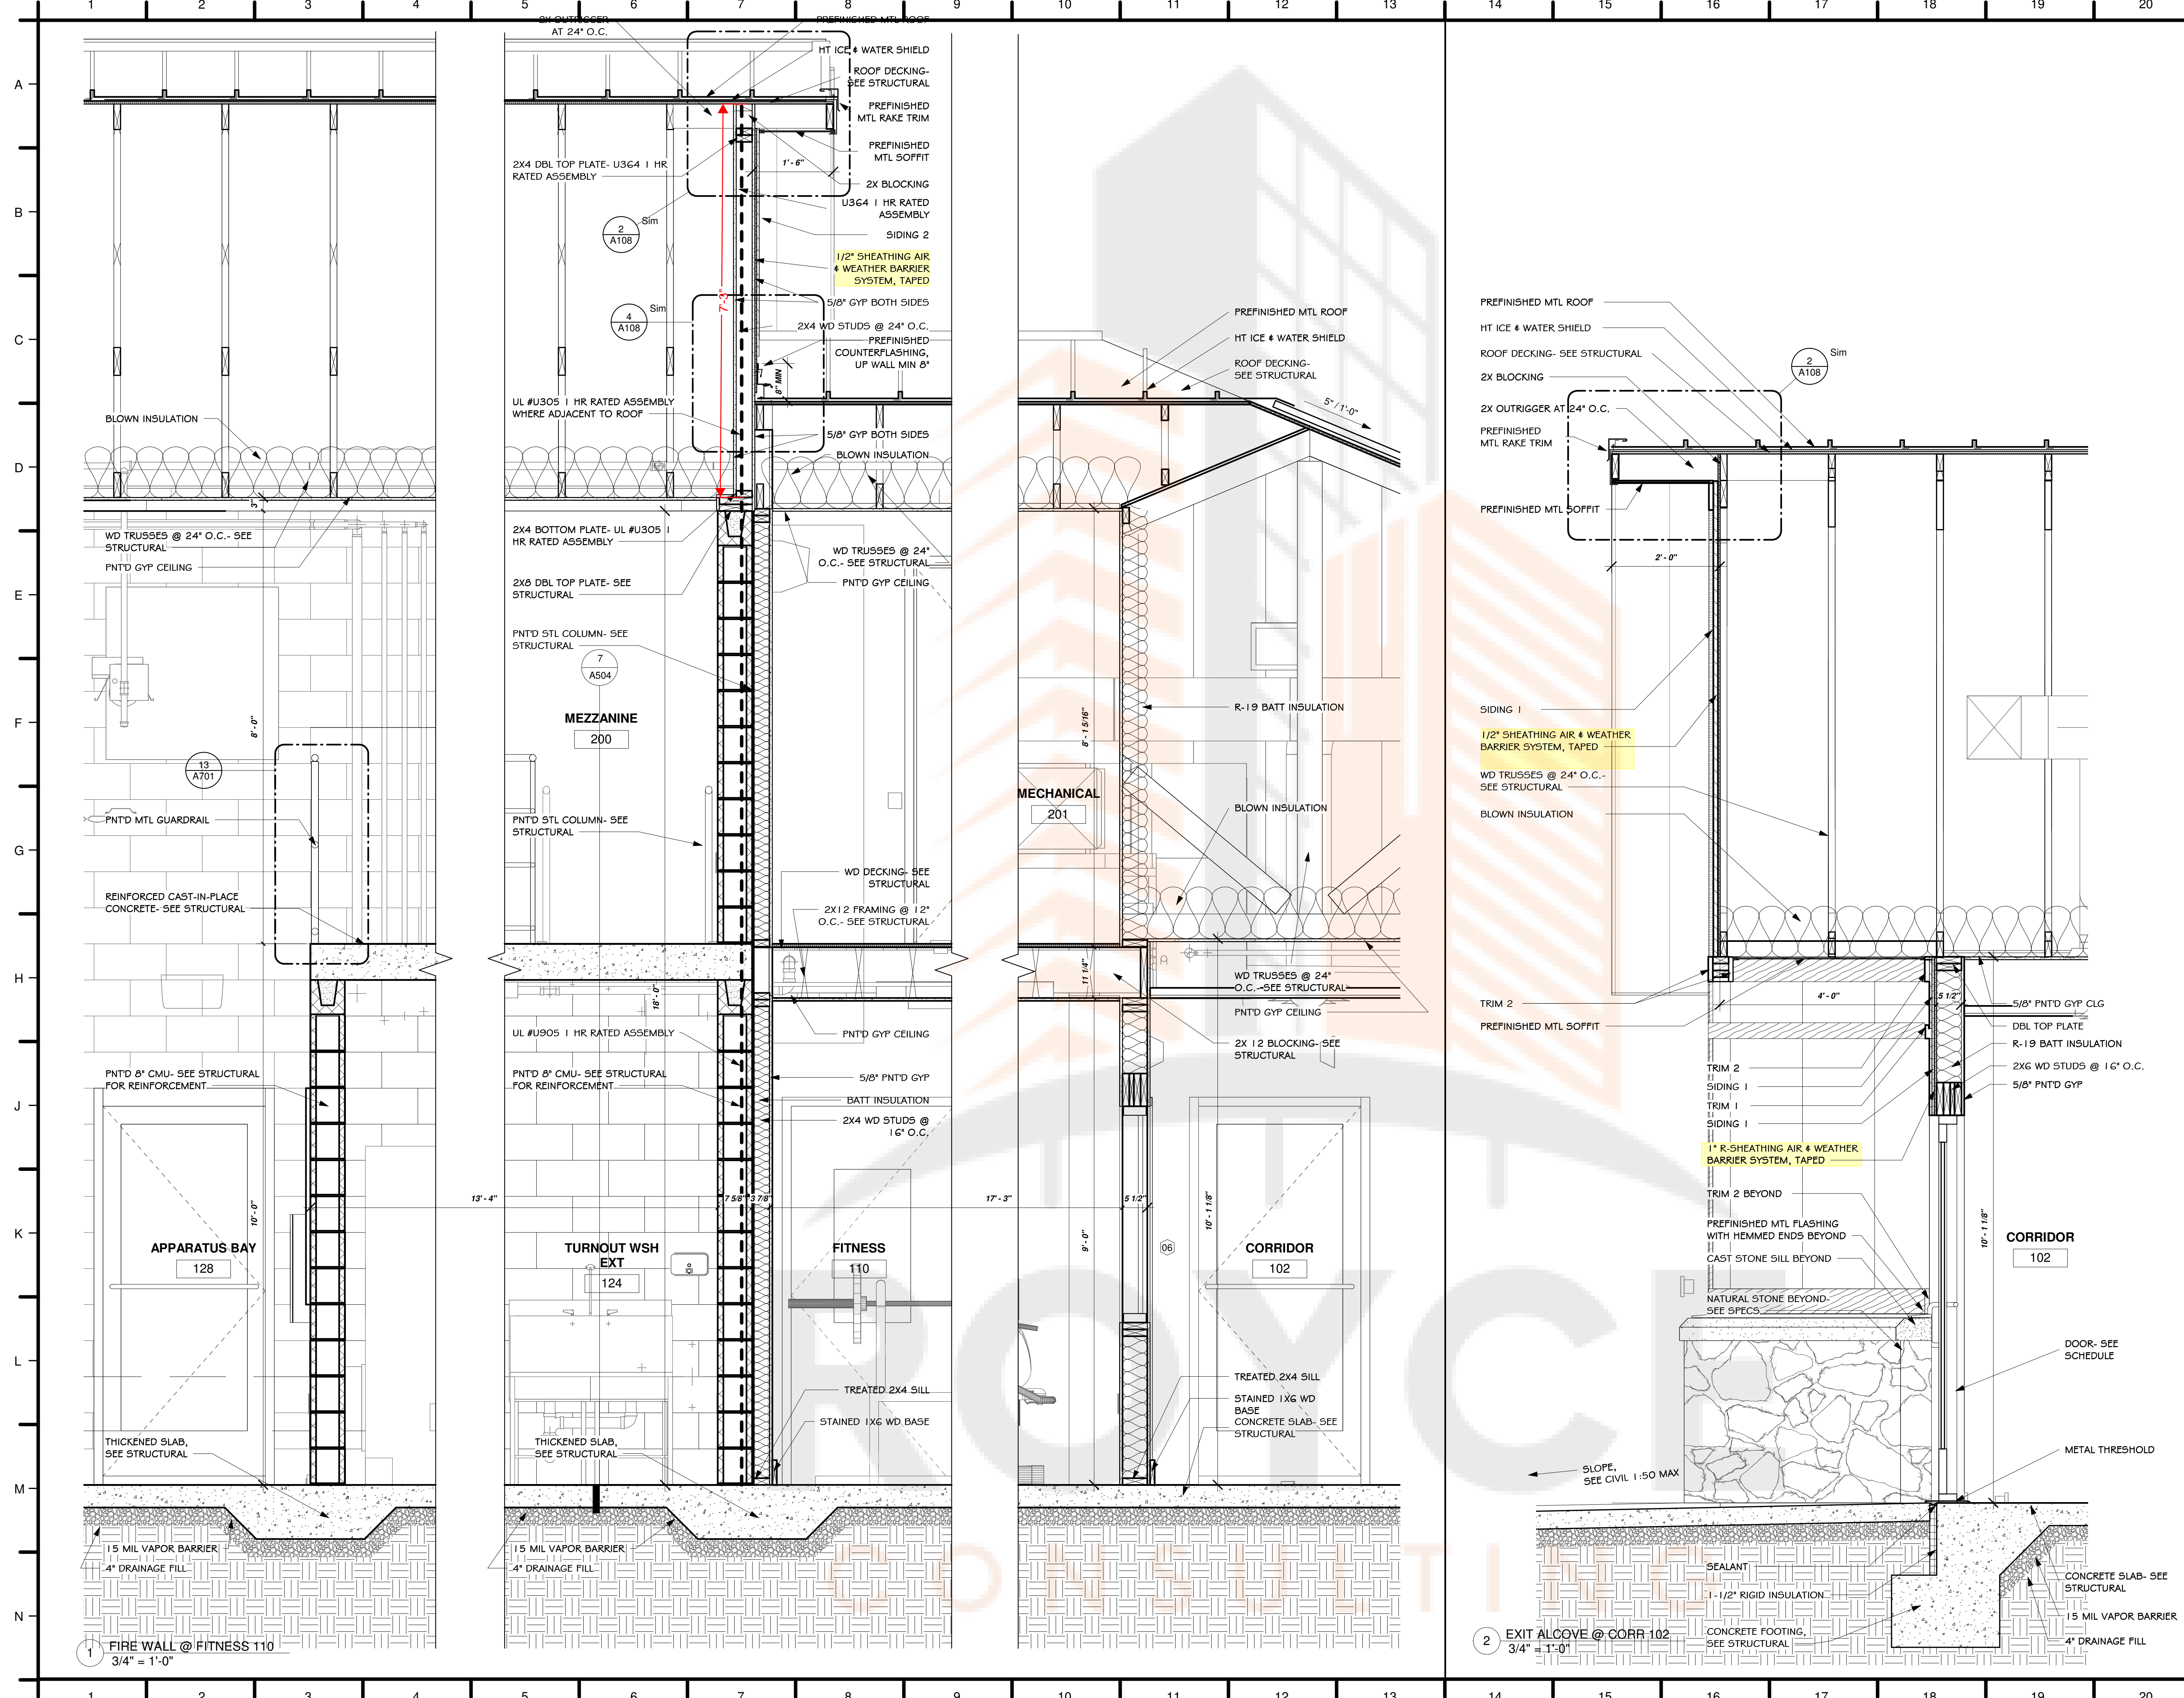

- General Notes**
1. PROVIDE FIELD PAINTING OF HANGERS AND EXPOSED-TO-VIEW METAL SURFACES OF ITEMS, AS REQUIRED TO MATCH ADJACENT SURFACES AND EQUIPMENT INSTALLED UNDER MECHANICAL AND ELECTRICAL WORK. THIS INCLUDES BUT IS NOT LIMITED TO, ALL EXPOSED CONDUIT, FIRE SPRINKLER PIPING, HANGERS, DUCTWORK, SUPPORTS, ETC. IF IT CAN BE SEEN, PAINT IT. ARCHITECT TO SELECT COLOR OR COLORS.
 2. ALL DIMENSIONS ARE TO FACE OF STUD, OR CMU U.N.O.
 3. "CJ" INDICATES CONTROL JOINT. SEE SPECIFICATIONS FOR DESCRIPTION OF METHODS AND LOCATIONS PERTAINING TO REQUIREMENTS.
 4. CONTRACTOR TO COORDINATE REQUIRED INSTALLATION OF ALL BLOCKING FOR (NOT LIMITED TO) ALL FIXTURES, EQUIP, OR SIGNAGE.
 5. PROVIDE 3" TALL HELVETICA LETTERS STENCILED AT ALL RATED WALLS, STENCILING TO READ AS FOLLOWS: "FIRE AND SMOKE BARRIER-PROTECT ALL OPENINGS". INCLUDE UL NUMBERS TYPICAL OF ALL RATED WALLS.

**NORTH LITTLE ROCK
FIRE DEPARTMENT
STATION 8**



Date
6/6/22
Revisions




JOB NUMBER 2203

Sheet Title
WALL SECTIONS

Sheet Number
A405

12921 Cantrell Road, Suite 201
Little Rock, AR 72223
501.664.8700 tel
501.664.5189 fax
www.jbparchitects.com

Copyright 2019 JBP

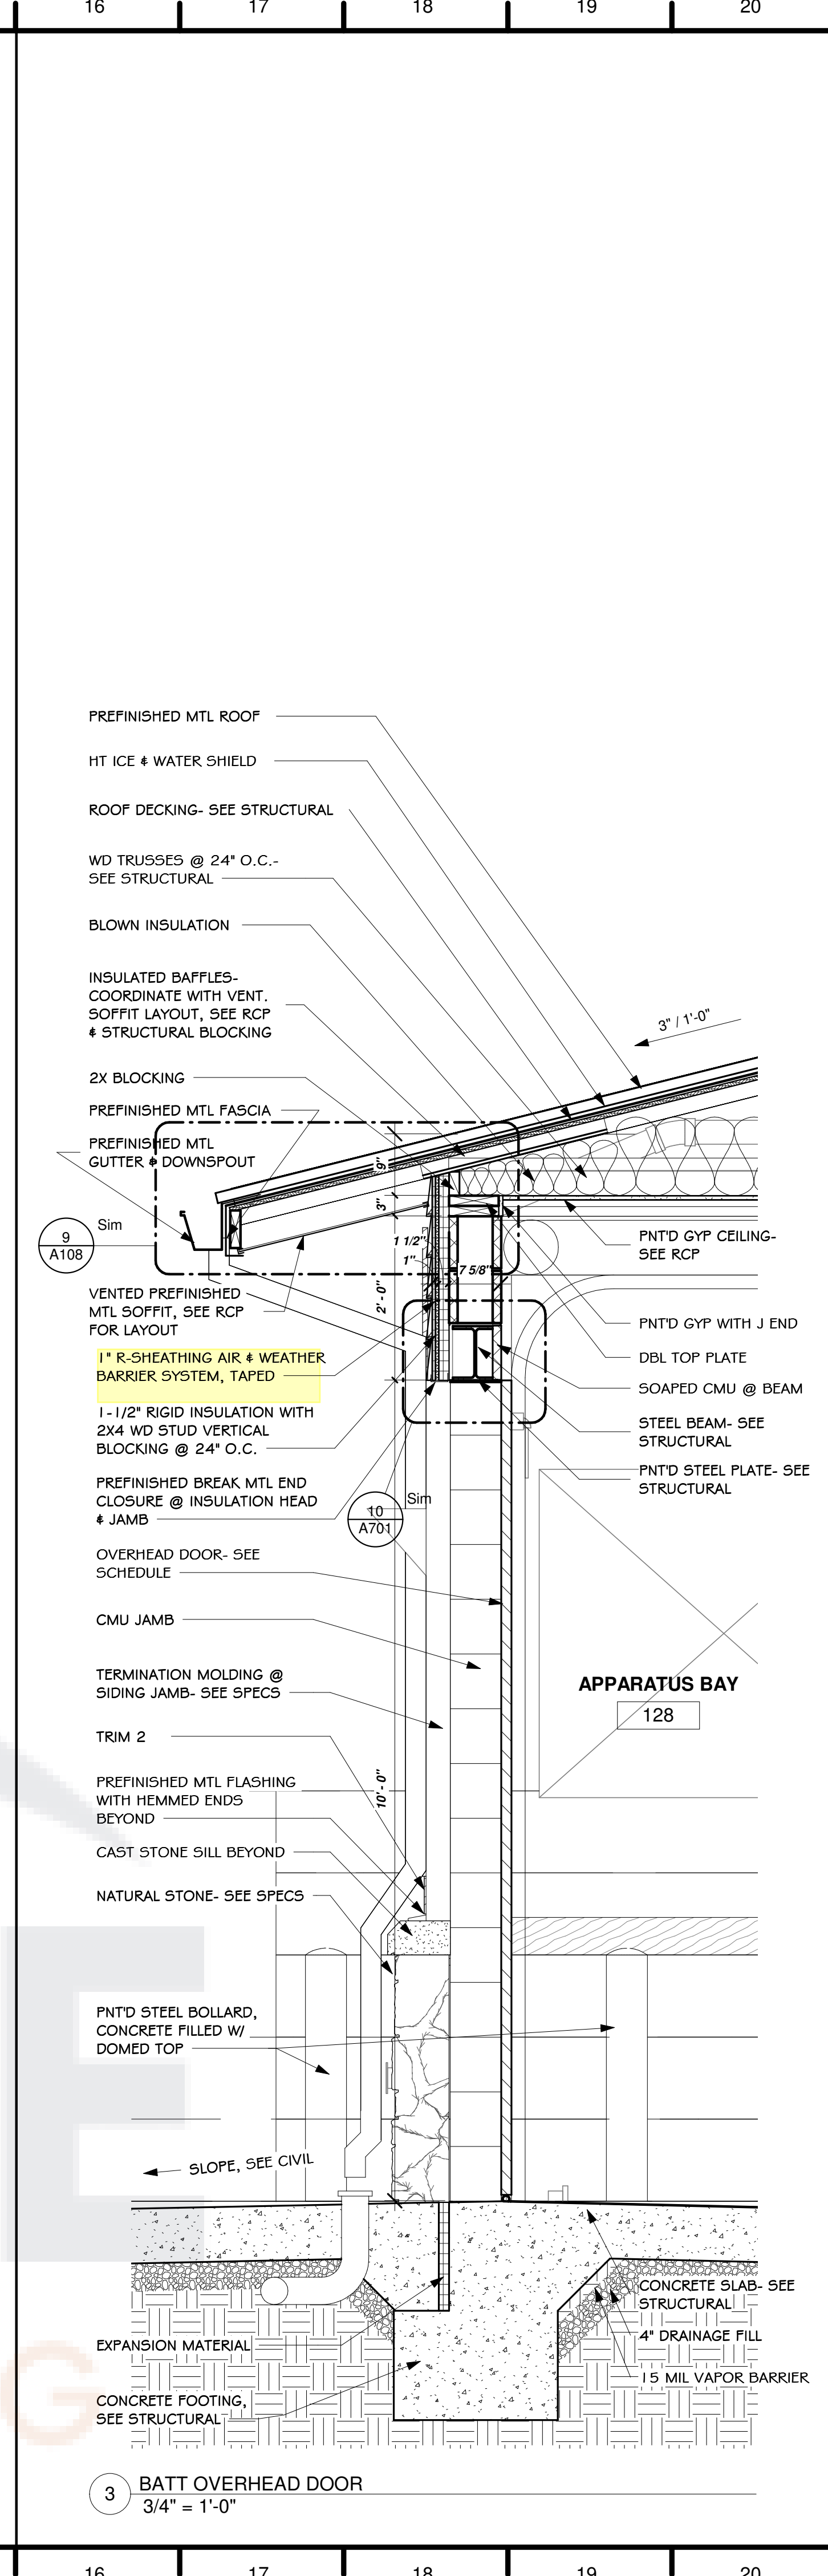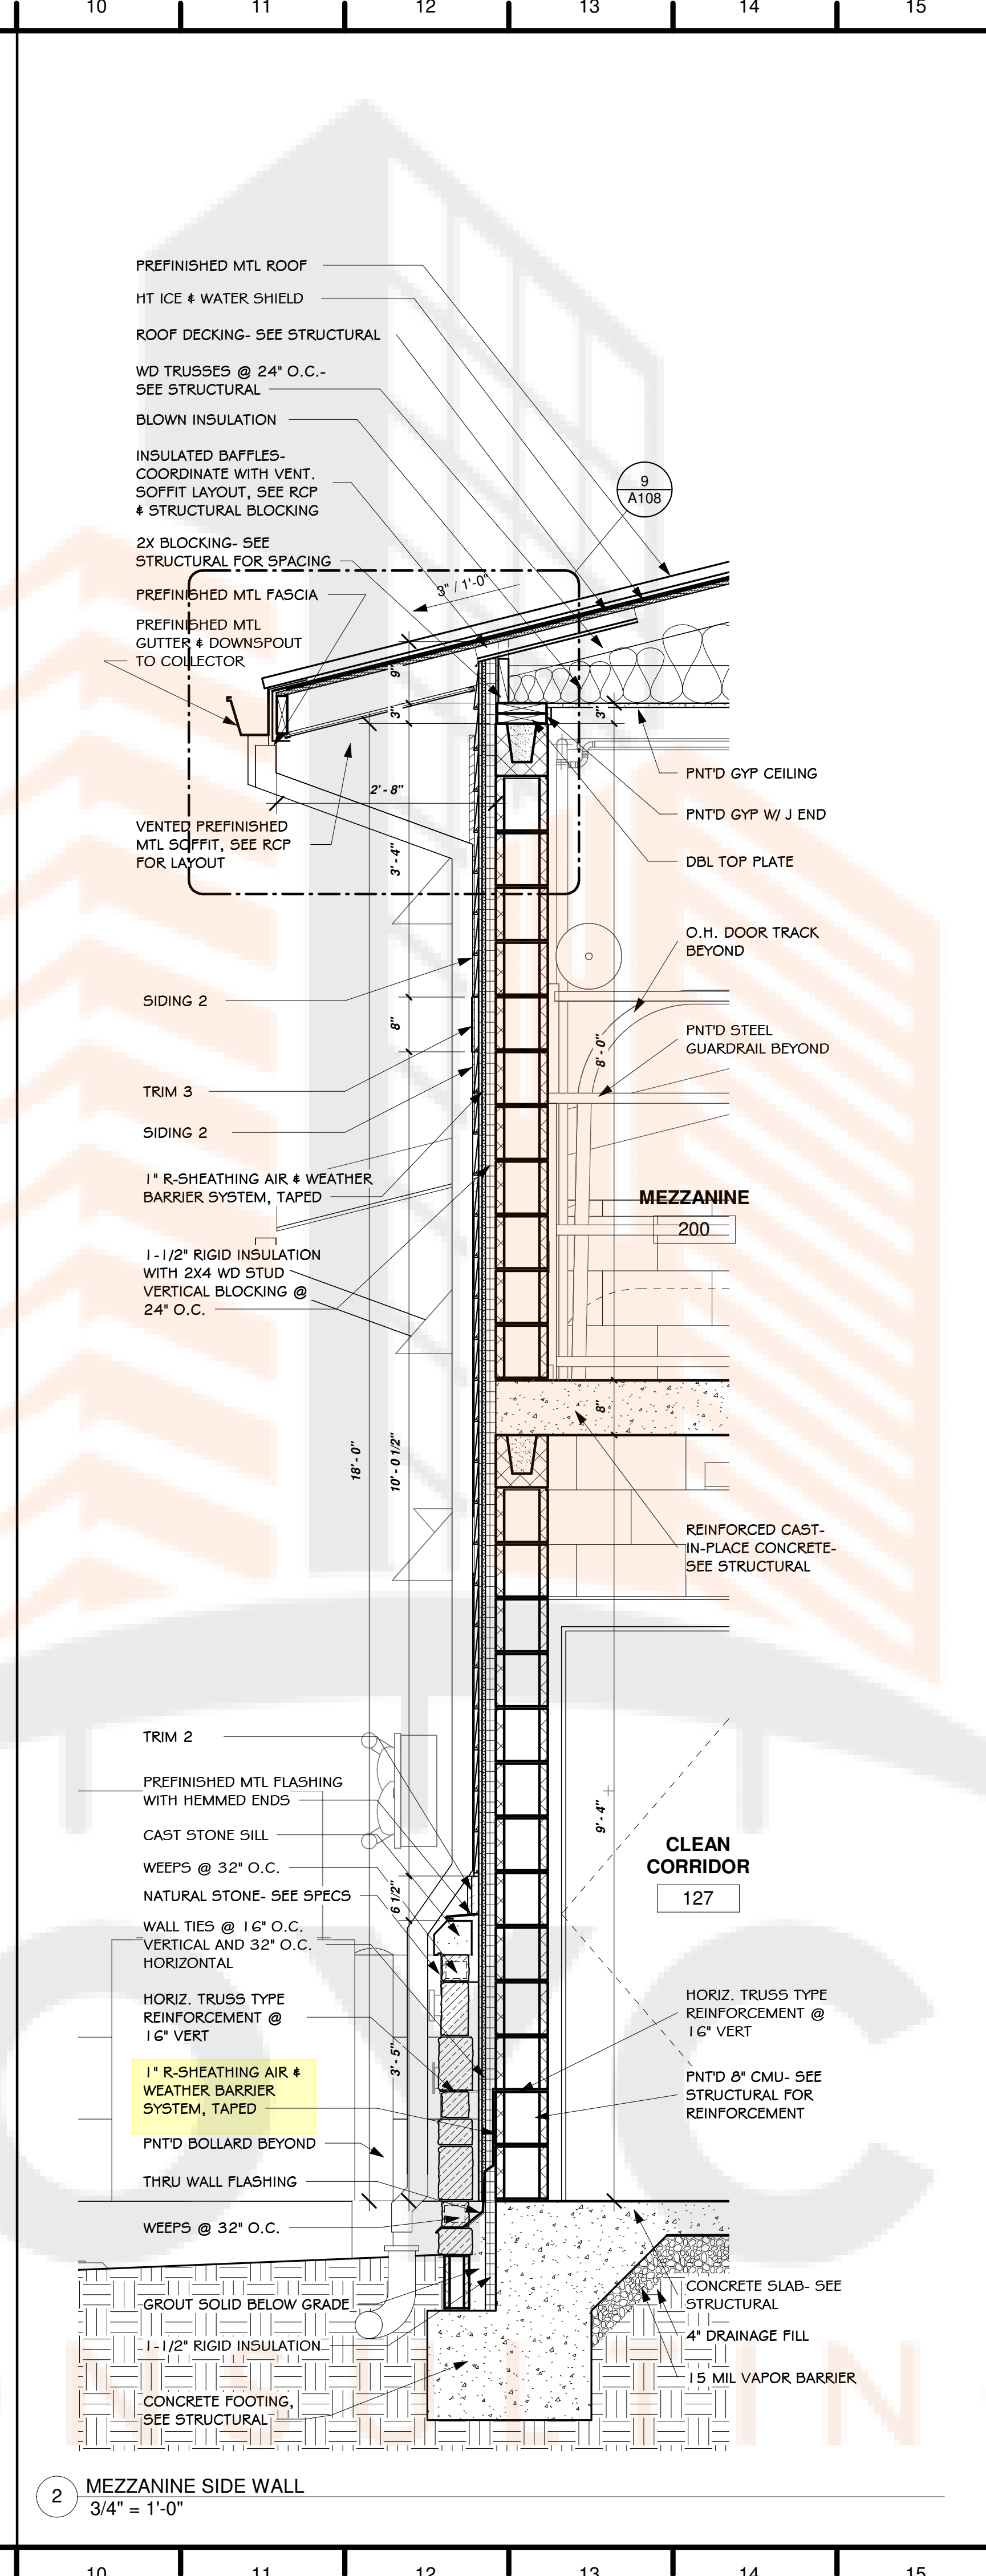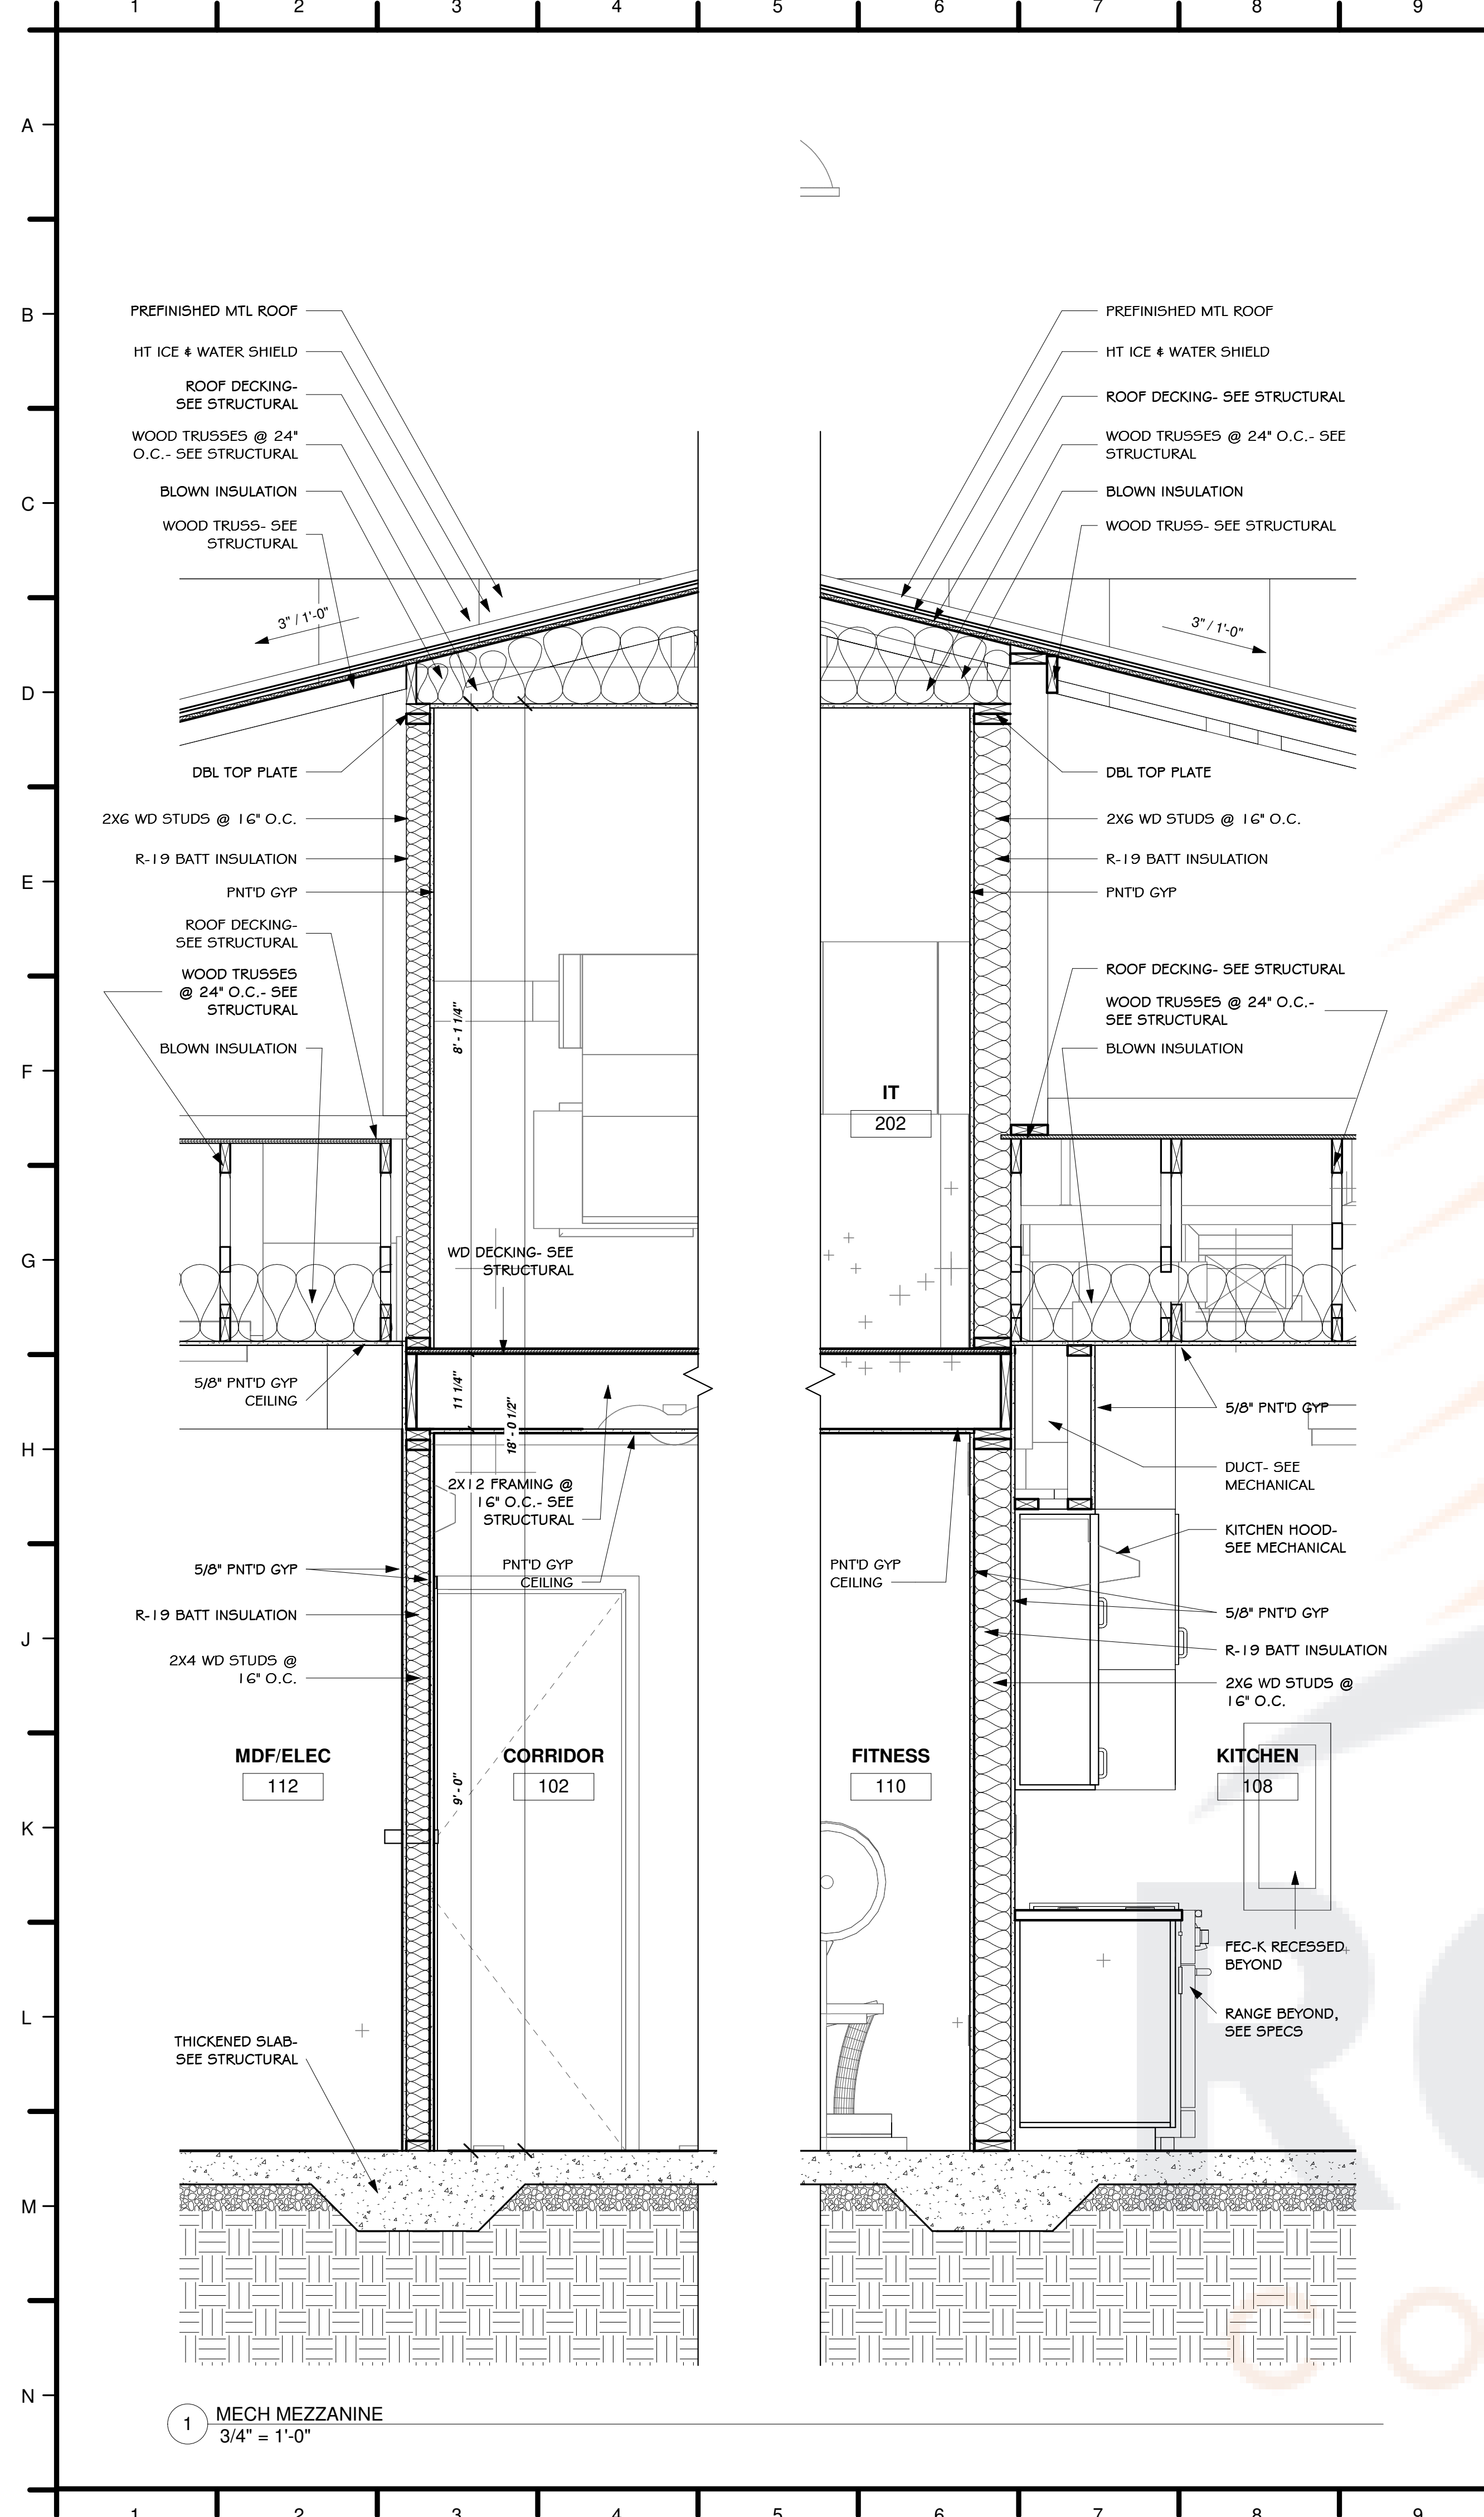

General Notes

- PROVIDE FIELD PAINTING OF HANGERS AND EXPOSED-TO-VIEW METAL SURFACES OF ITEMS, AS REQUIRED TO MATCH ADJACENT SURFACES AND EQUIPMENT INSTALLED UNDER MECHANICAL AND ELECTRICAL WORK. THIS INCLUDES BUT IS NOT LIMITED TO, ALL EXPOSED CONDUIT, FIRE SPRINKLER PIPING, HANGERS, DUCTWORK, SUPPORTS, ETC. IF IT CAN BE SEEN, PAINT IT. ARCHITECT TO SELECT COLOR OR COLORS
- ALL DIMENSIONS ARE TO FACE OF STUD, OR CMU U.N.O.
- "CJ" INDICATES CONTROL JOINT. SEE SPECIFICATIONS FOR DESCRIPTION OF METHODS AND LOCATIONS PERTAINING TO REQUIREMENTS.
- CONTRACTOR TO COORDINATE REQUIRED INSTALLATION OF ALL BLOCKING FOR (NOT LIMITED TO) ALL FIXTURES, EQUIP, OR SIGNAGE
- PROVIDE 3" TALL HELVETICA LETTERS STENCILED AT ALL RATED WALLS, STENCILING TO READ AS FOLLOWS "FIRE AND SMOKE BARRIER-PROTECT ALL OPENINGS". INCLUDE UL NUMBERS TYPICAL OF ALL RATED WALLS.

NORTH LITTLE ROCK FIRE DEPARTMENT STATION 8

**Jackson
Brown
Palculict
architects**

Date
6/6/22
Revisions





JOB NUMBER 2203

Sheet Title
**WALL
SECTIONS**

Sheet Number
A406

12921 Cantrell Road, Suite 201
Little Rock, AR 72223
501.664.8700 tel
501.664.5189 fax
www.jbparchitects.com

Copyright 2019 JBP

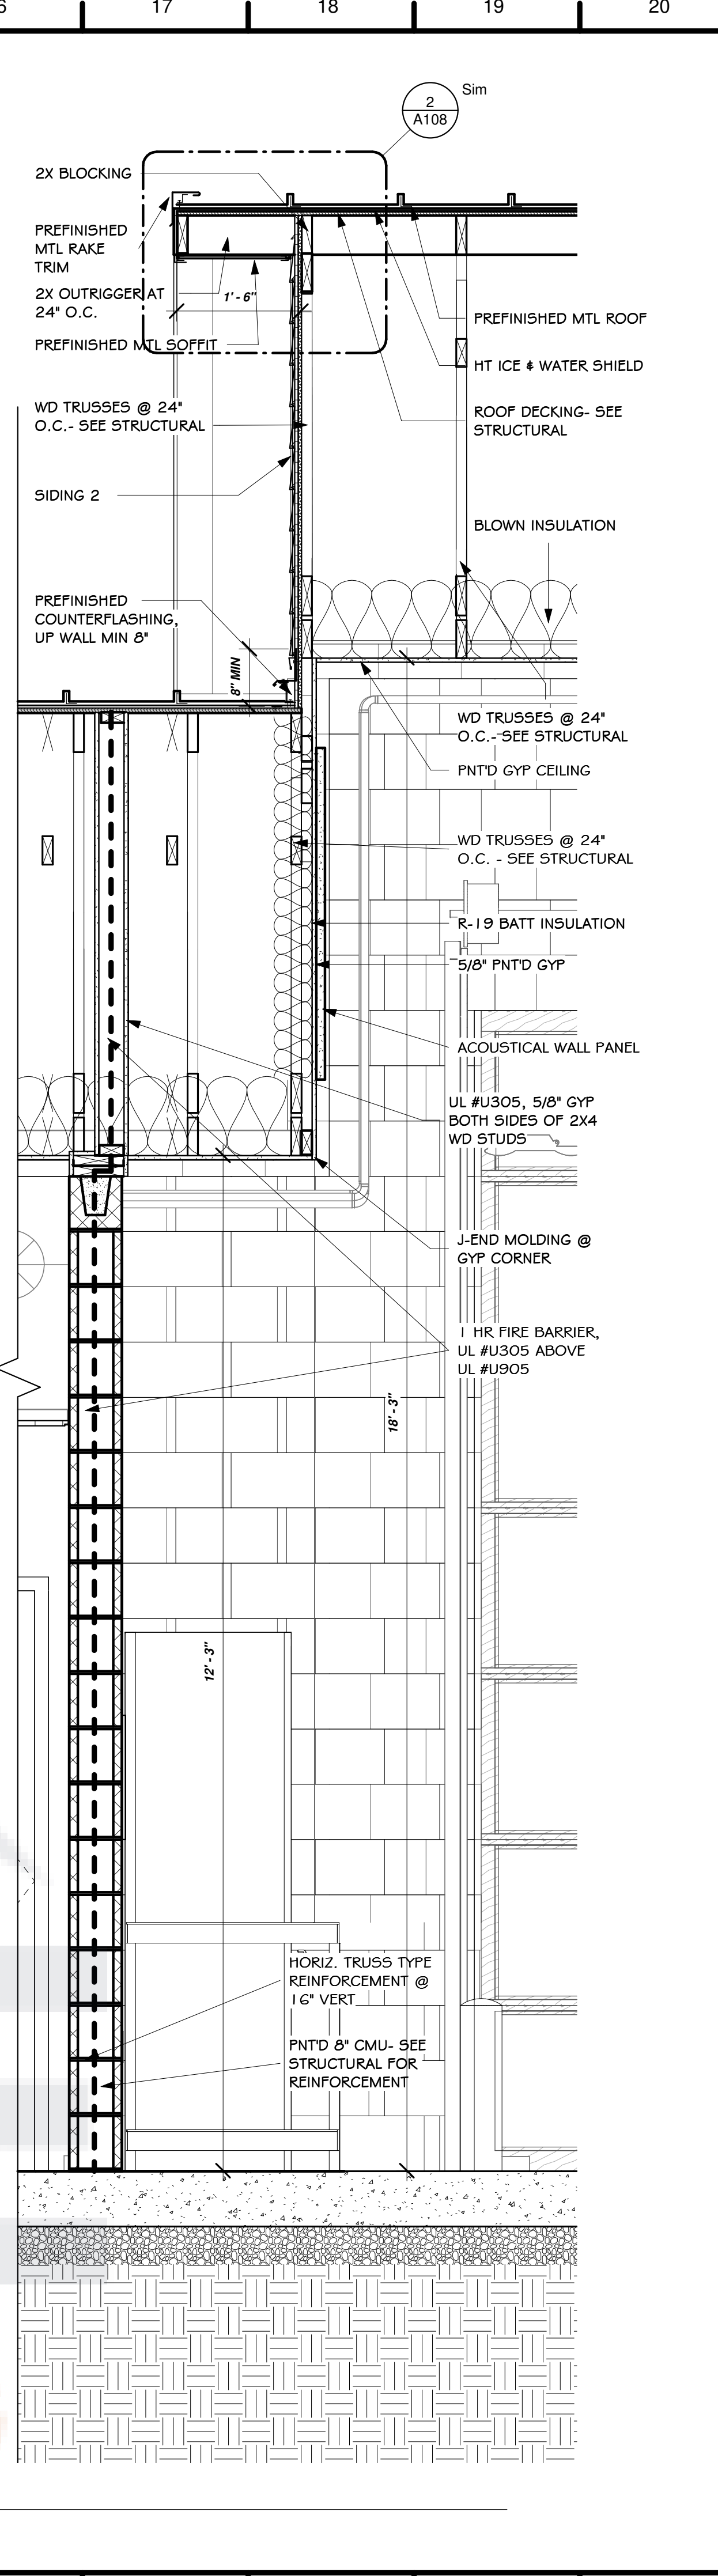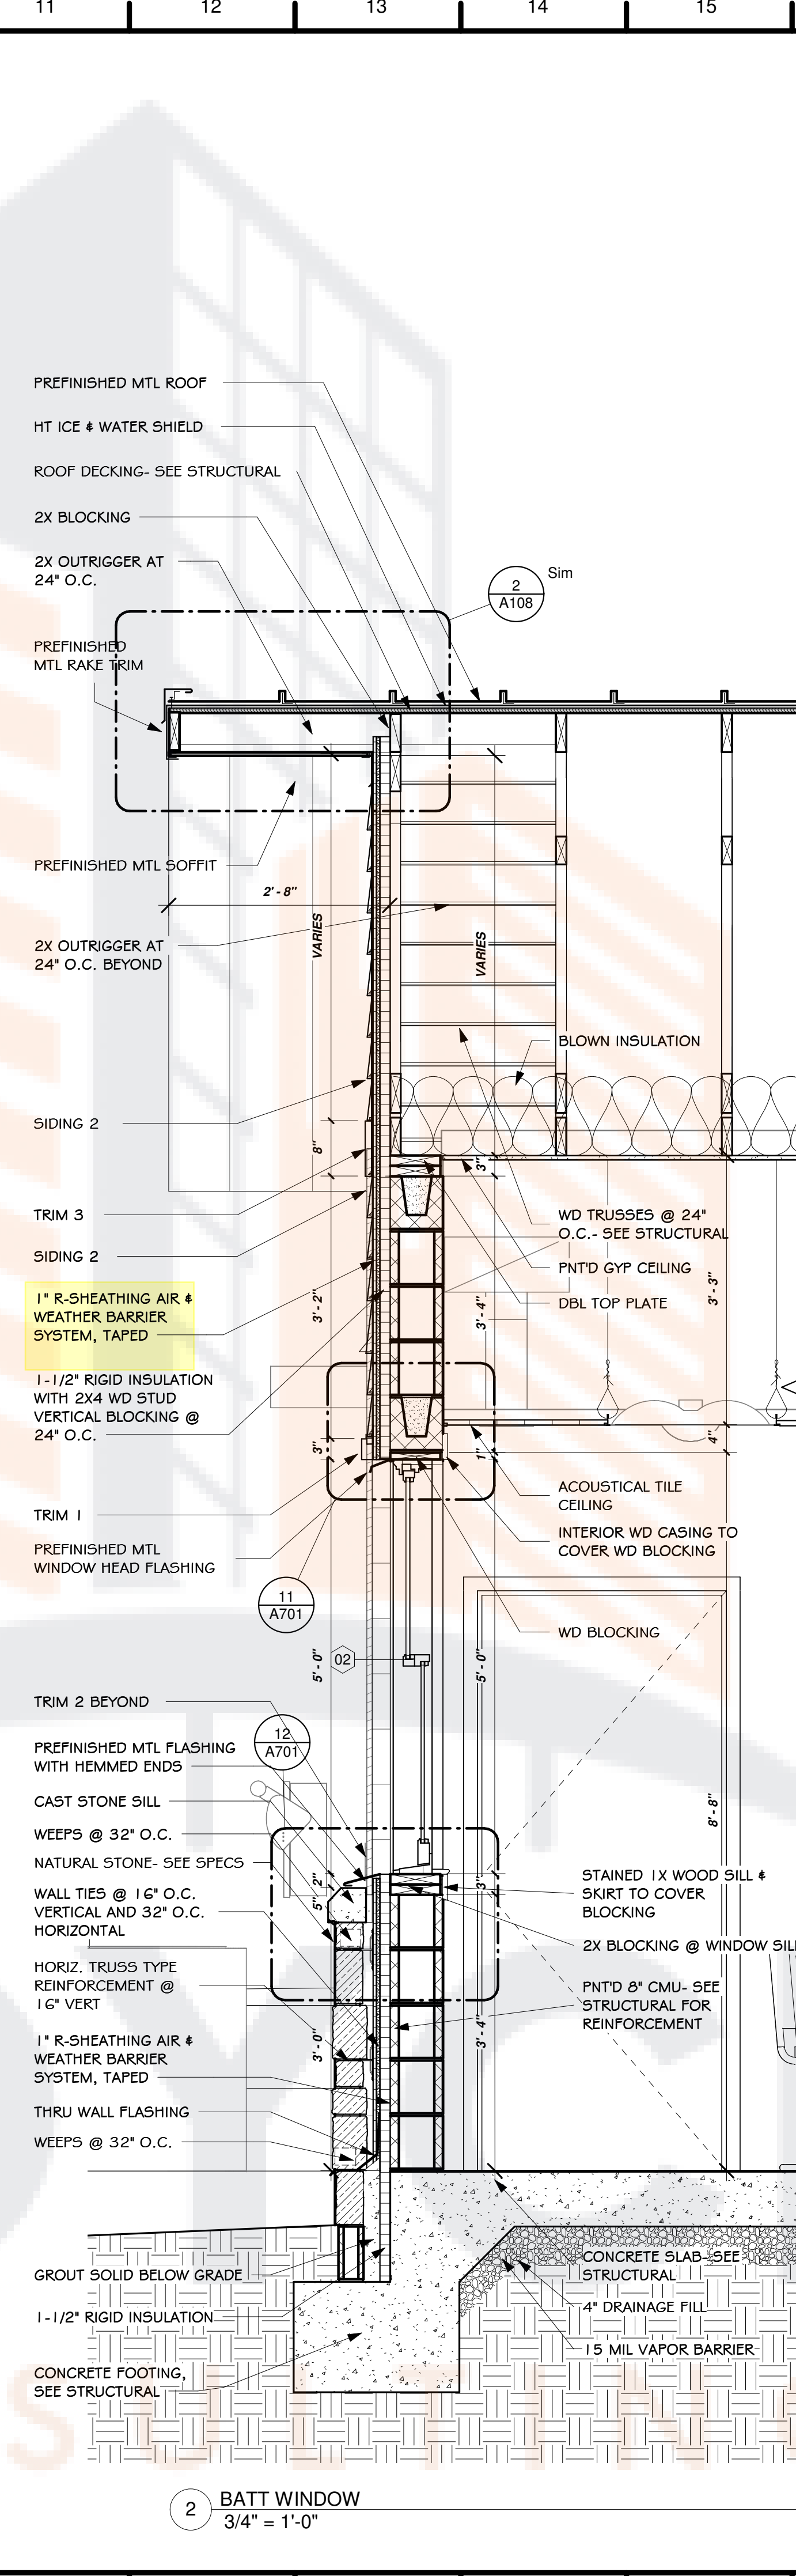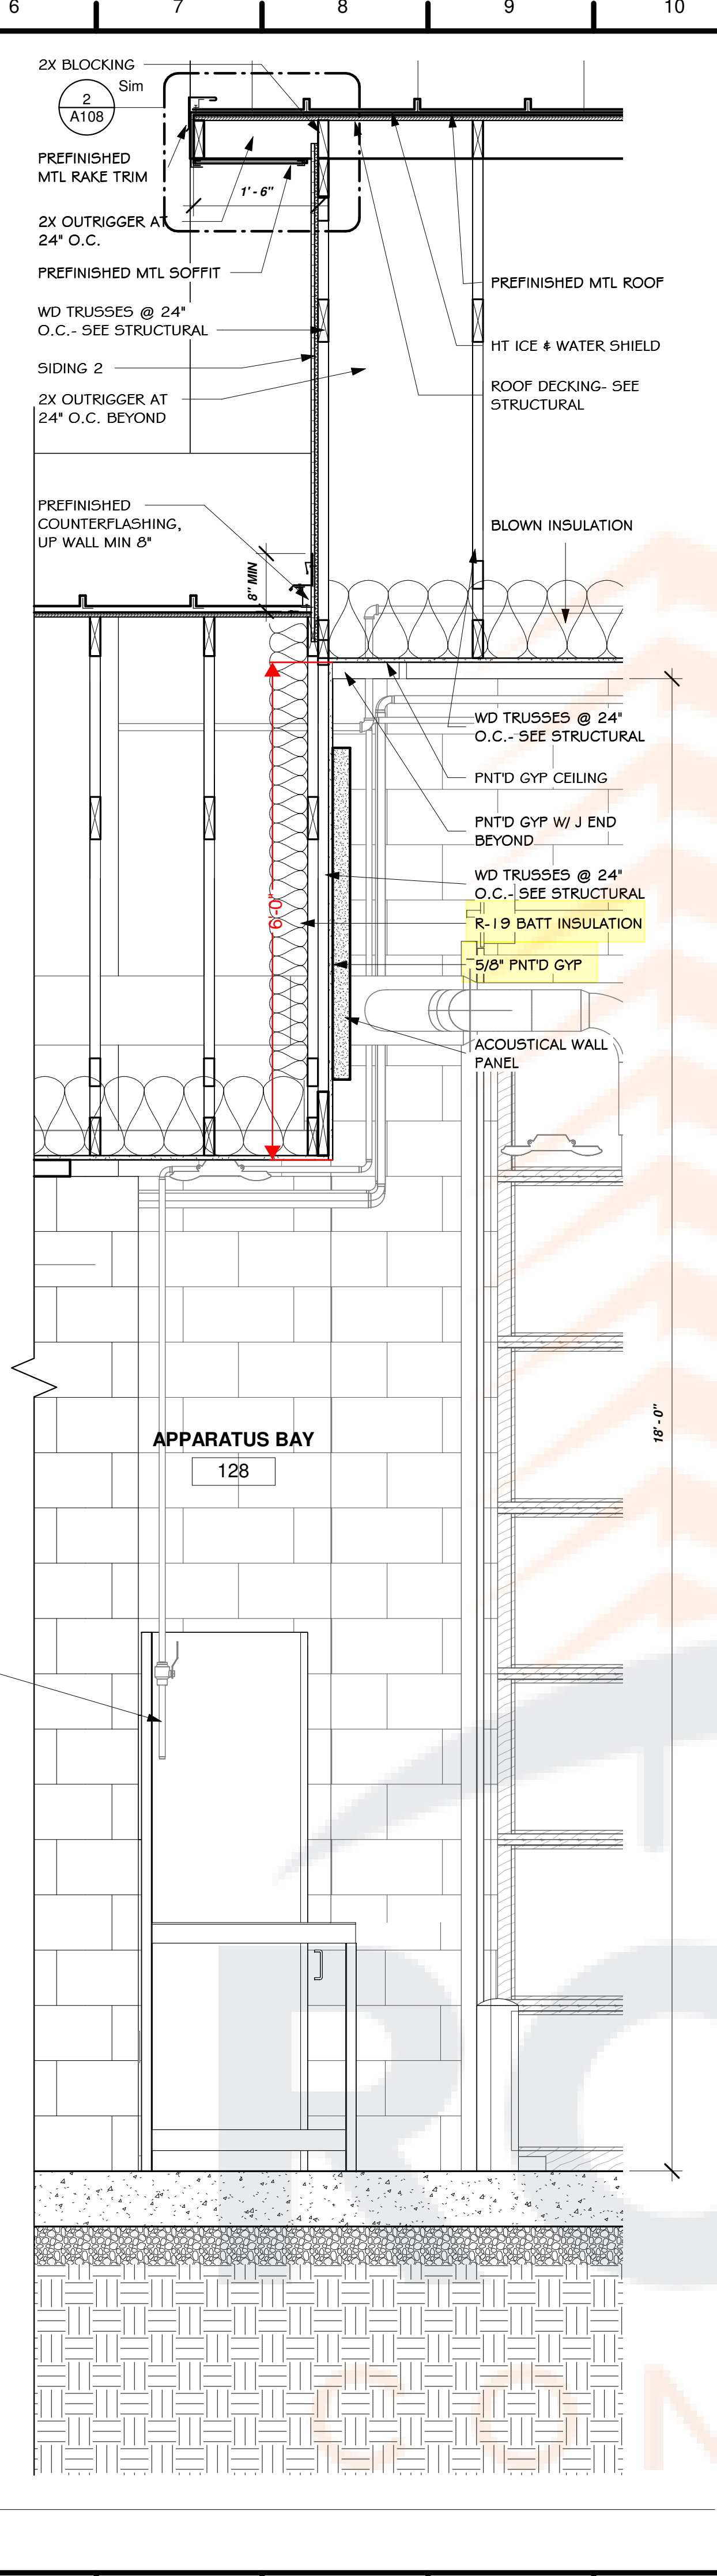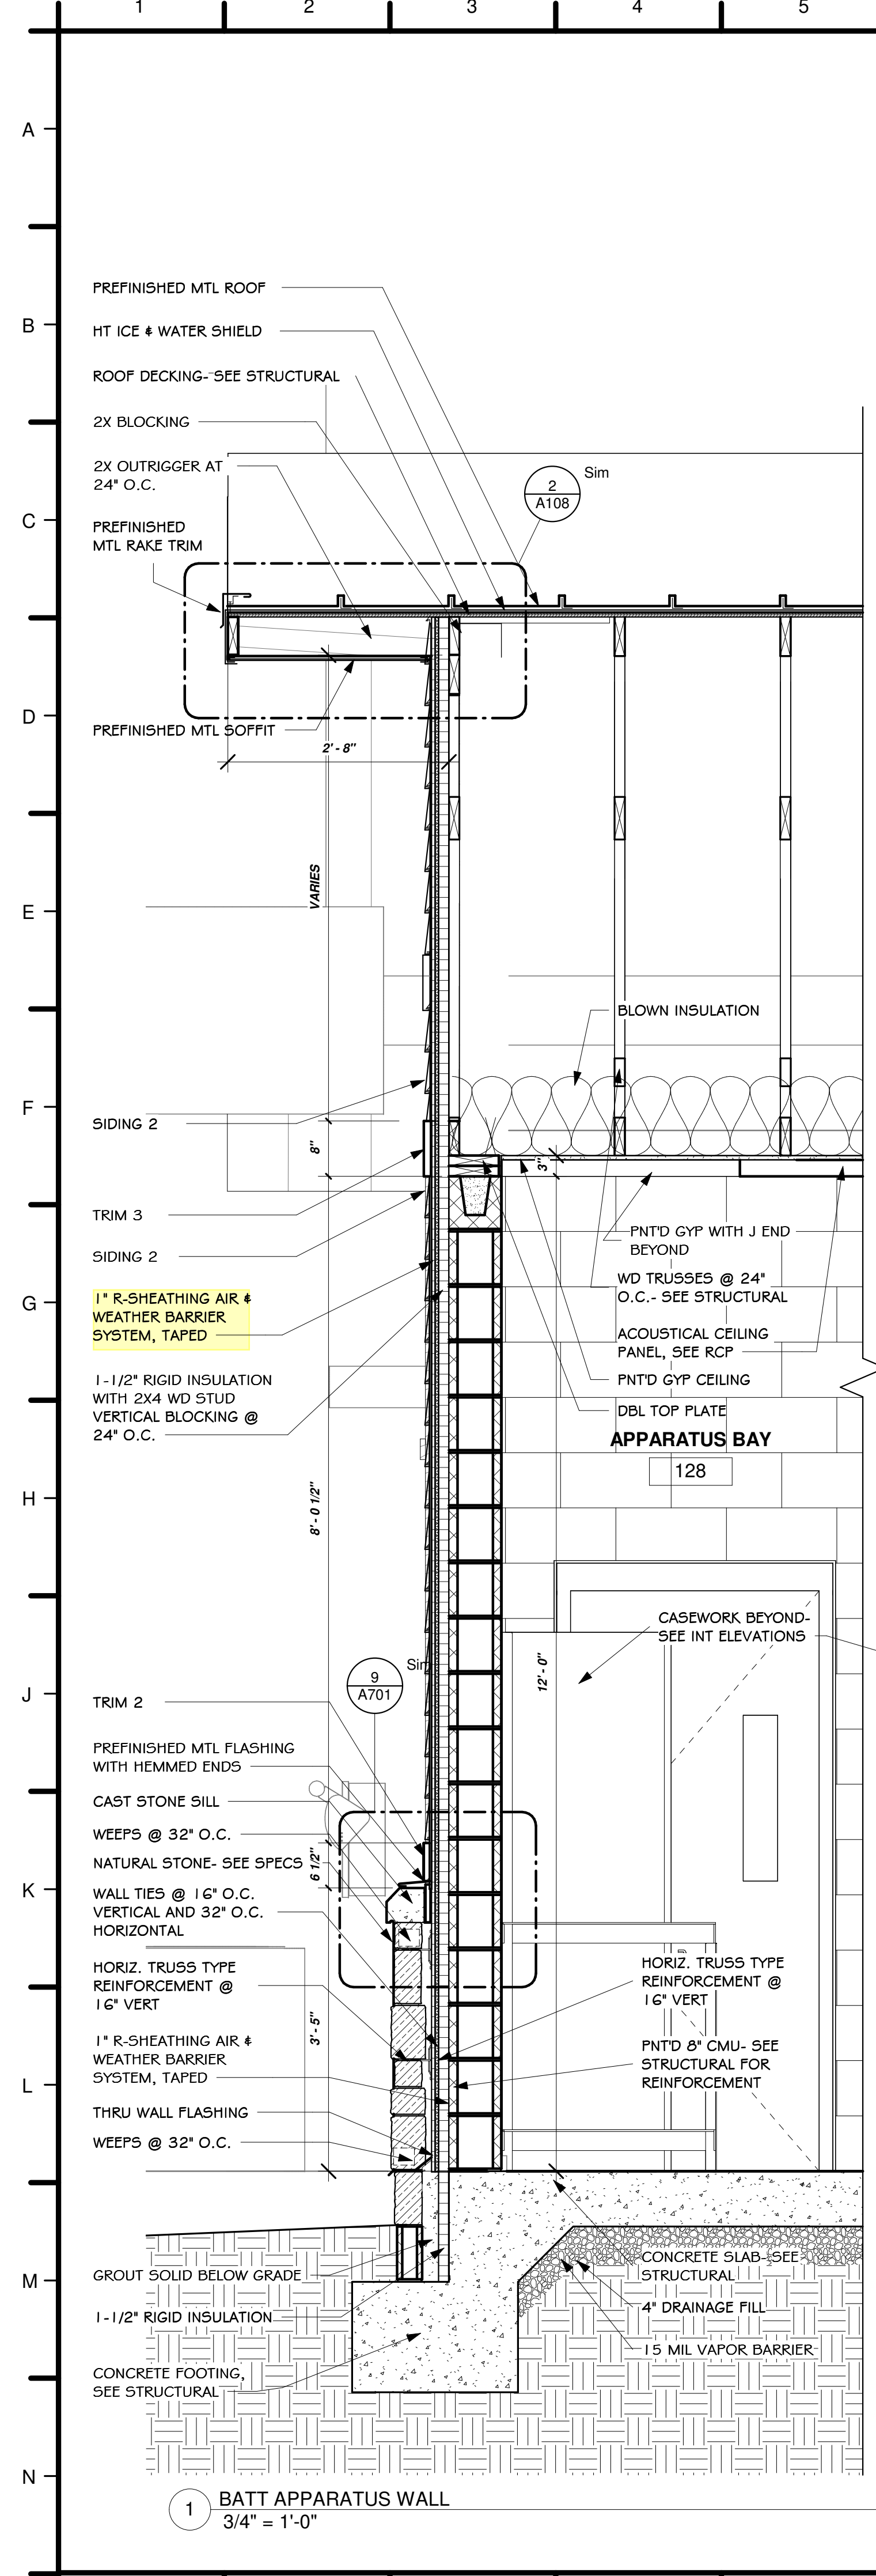

General Notes

- PROVIDE FIELD PAINTING OF HANGERS AND EXPOSED-TO-VIEW METAL SURFACES OF ITEMS, AS REQUIRED TO MATCH ADJACENT SURFACES AND EQUIPMENT INSTALLED UNDER MECHANICAL AND ELECTRICAL WORK. THIS INCLUDES BUT IS NOT LIMITED TO, ALL EXPOSED CONDUIT, FIRE SPRINKLER PIPING HANGERS, DUCTWORK, SUPPORTS, ETC. IF IT CAN BE SEEN, PAINT IT. ARCHITECT TO SELECT COLOR OR COLORS.
- ALL DIMENSIONS ARE TO FACE OF STUD, OR CMU U.N.O. "CJ" INDICATES CONTROL JOINT. SEE SPECIFICATIONS FOR DESCRIPTION OF METHODS AND LOCATIONS PERTAINING TO REQUIREMENTS.
- CONTRACTOR TO COORDINATE REQUIRED INSTALLATION OF ALL BLOCKING FOR (NOT LIMITED TO) ALL FIXTURES, EQUIP, OR SIGNAGE.
- PROVIDE 3" TALL HELVETICA LETTERS STENCILED AT ALL RATED WALLS, STENCILING TO READ AS FOLLOWS: FIRE AND SMOKE BARRIER-PROTECT ALL OPENINGS. INCLUDE UL NUMBERS TYPICAL OF ALL RATED WALLS.

NORTH LITTLE ROCK FIRE DEPARTMENT STATION 8

Jackson Brown Palculict architects


Date: 6/6/22
Revisions: 1

JOB NUMBER: 2203


Sheet Title: **WALL SECTIONS**

Sheet Number: **A407**


12921 Cantrell Road, Suite 201
Little Rock, AR 72223
501.664.8700 tel
501.664.5189 fax
www.jbparchitects.com

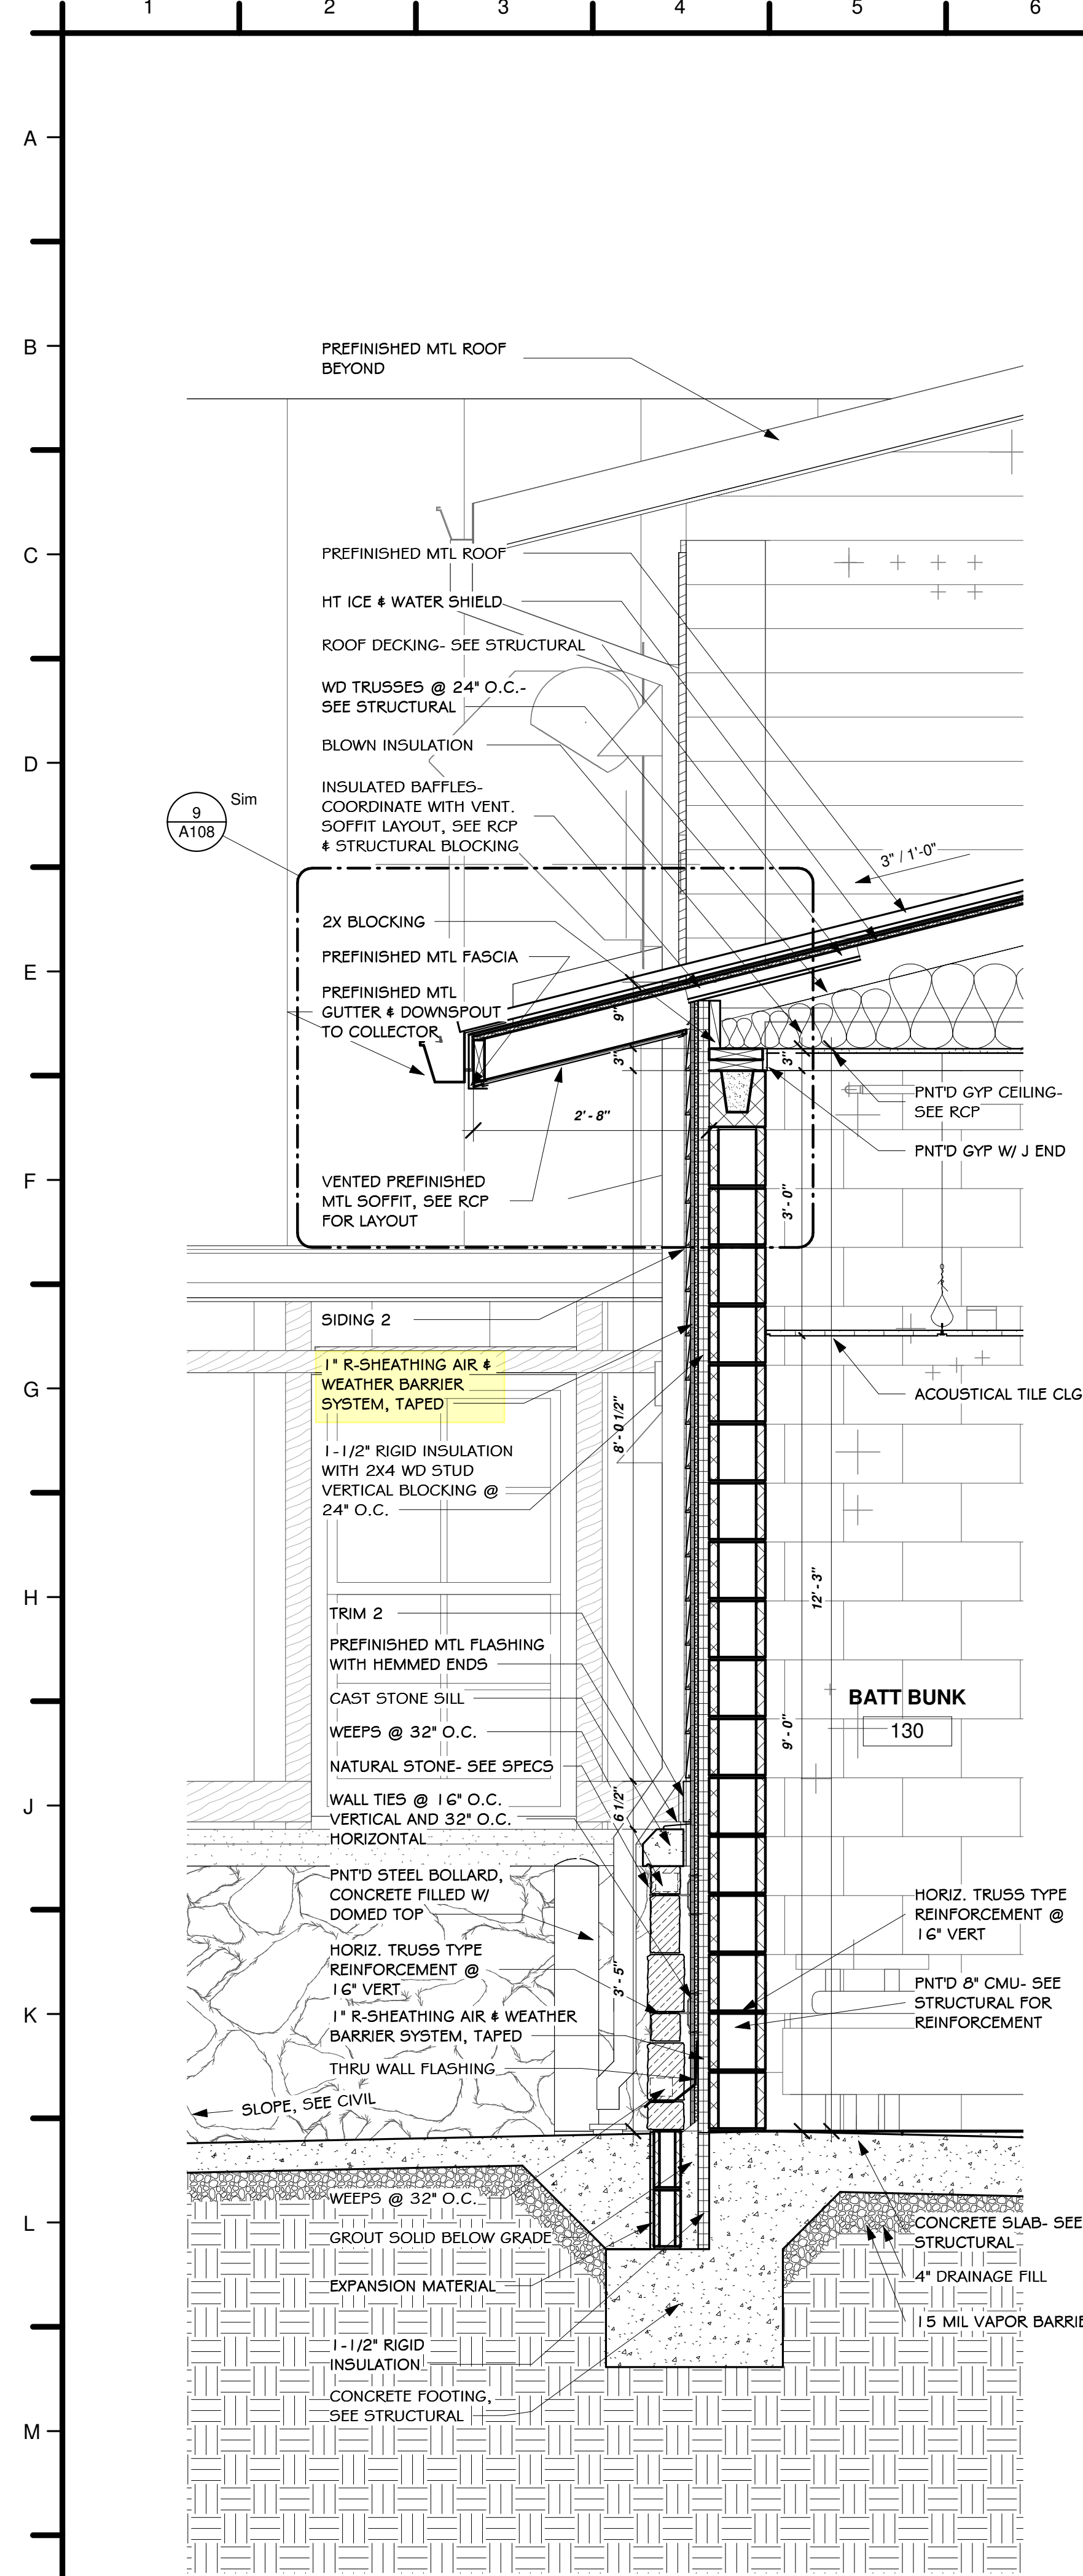

1 BATT SIDE WALL
3/4" = 1'-0"

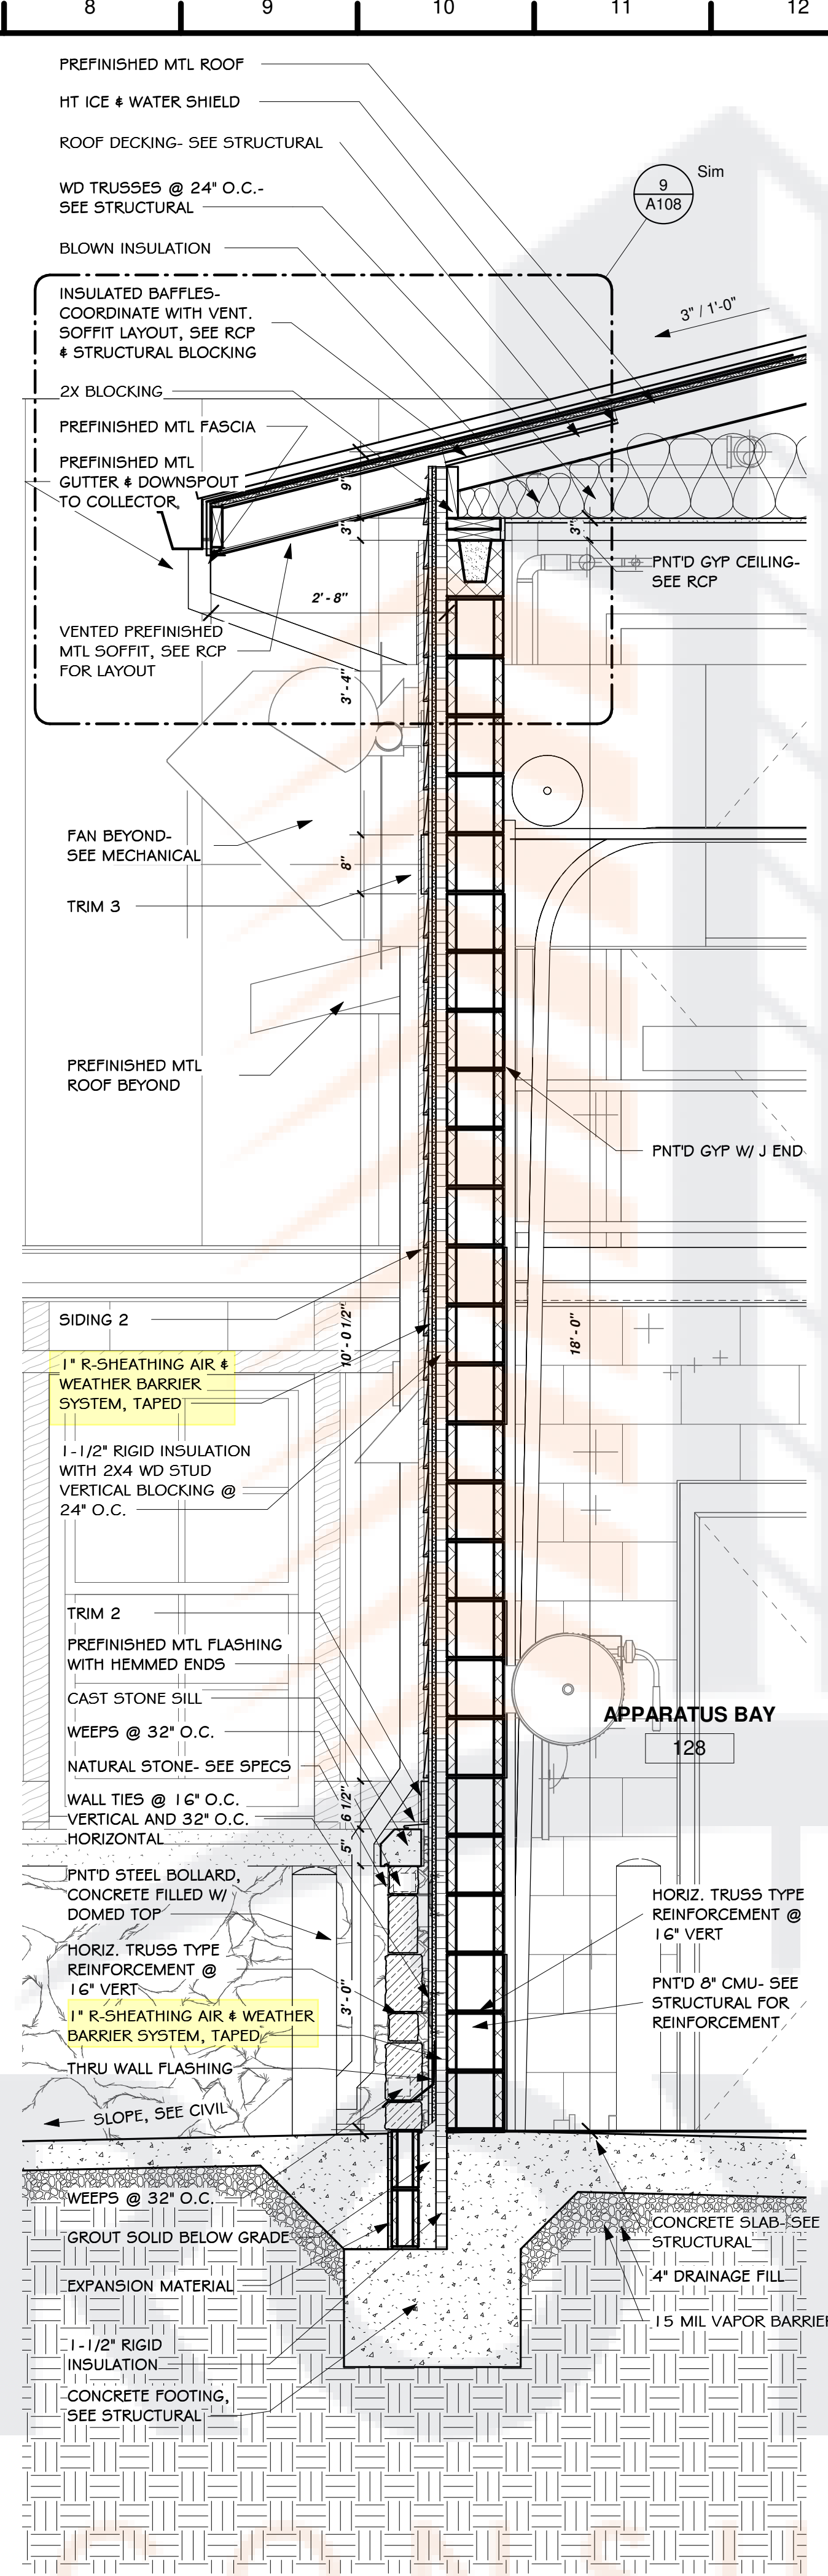

2 APPARATUS WALL
3/4" = 1'-0"

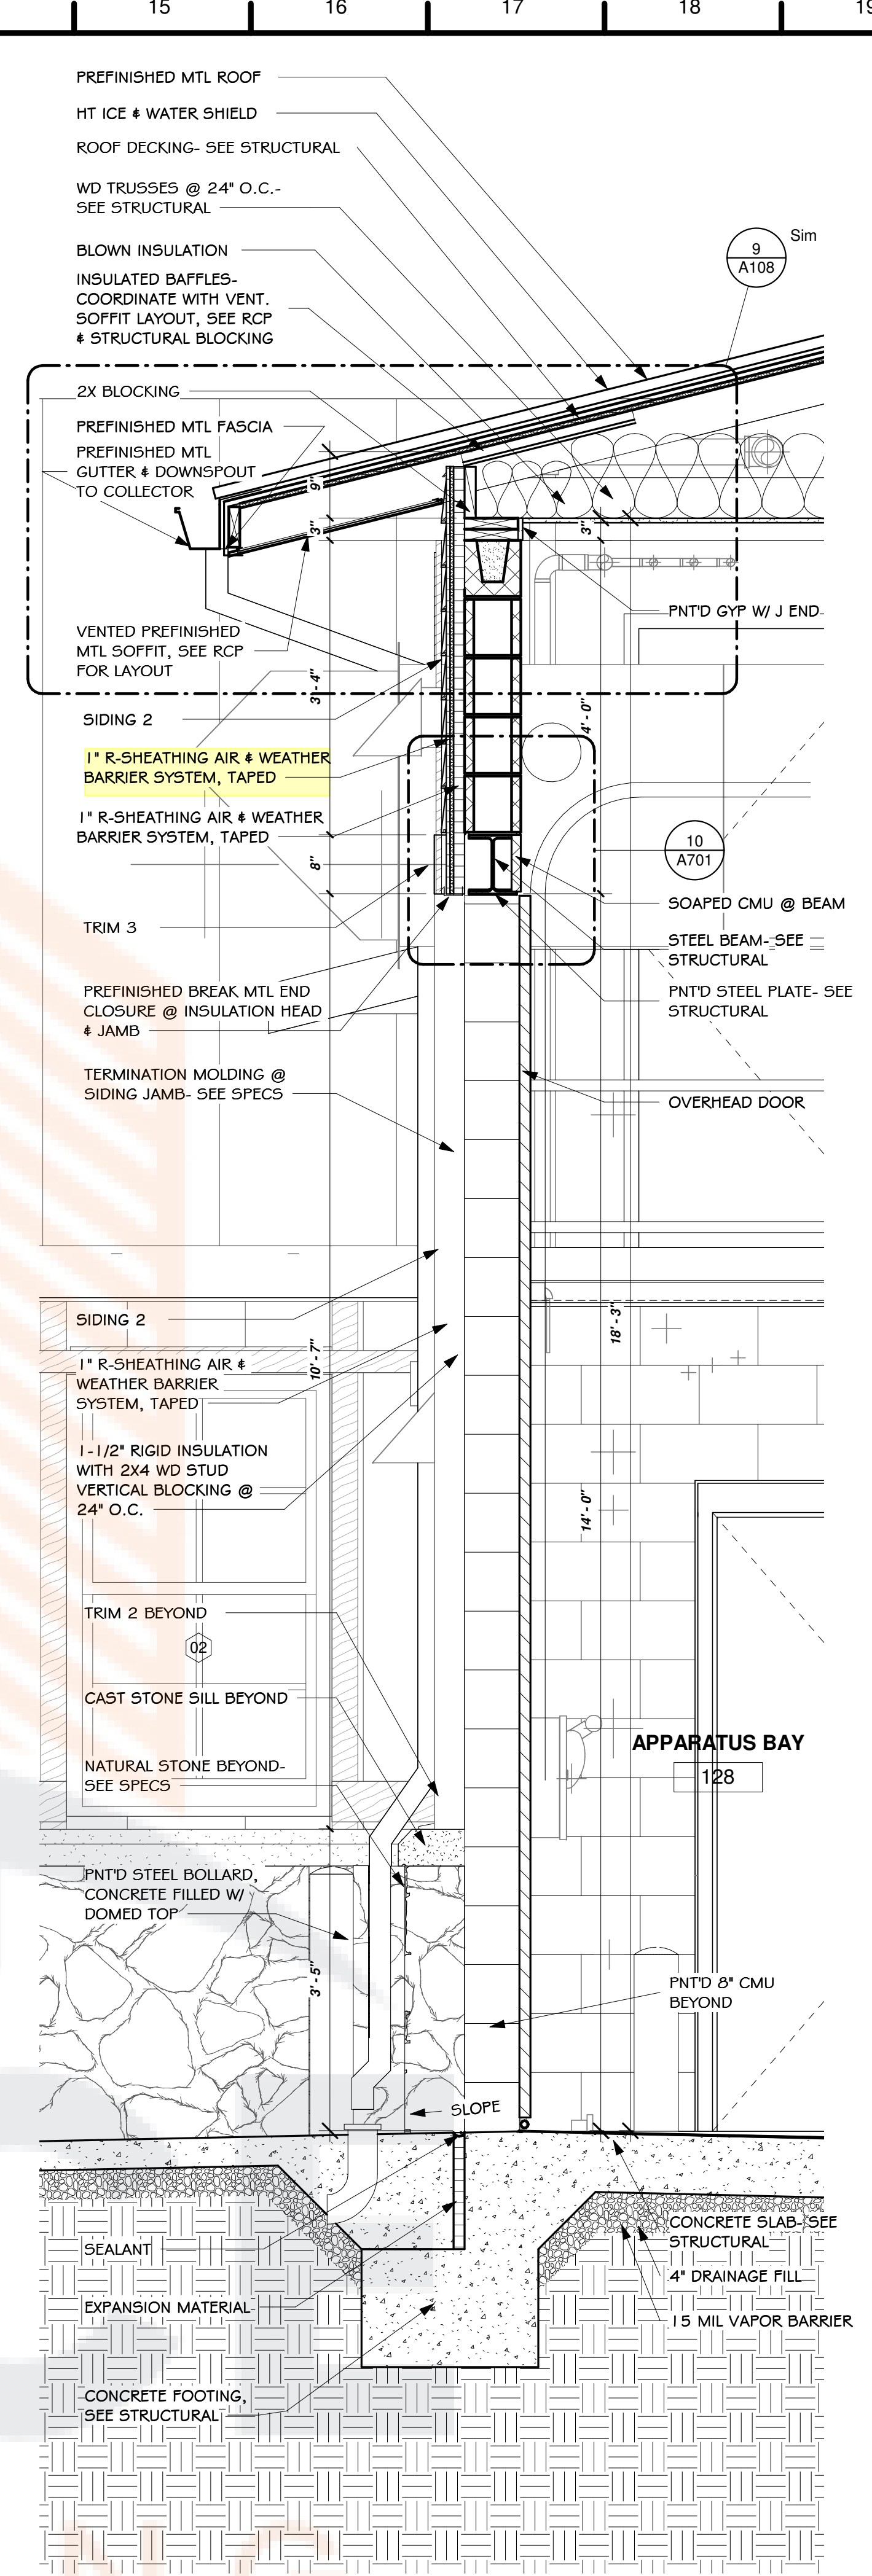


3 APPARATUS OVERHEAD DOOR
3/4" = 1'-0"

General Notes

1. PROVIDE FIELD PAINTING OF HANGERS AND EXPOSED-TO-VIEW METAL SURFACES OF ITEMS, AS REQUIRED TO MATCH ADJACENT SURFACES AND EQUIPMENT INSTALLED UNDER MECHANICAL AND ELECTRICAL WORK. THIS INCLUDES BUT IS NOT LIMITED TO, ALL EXPOSED CONDUIT, FIRE SPRINKLER PIPING, HANGERS, DUCTWORK, SUPPORTS, ETC. IF IT CAN BE SEEN, PAINT IT. ARCHITECT TO SELECT COLOR OR COLORS.
2. ALL DIMENSIONS ARE TO FACE OF STUD, OR CMU U.N.O. 'C' INDICATES CONTROL JOINT. SEE SPECIFICATIONS FOR DESCRIPTION OF METHODS AND LOCATIONS PERTAINING TO REQUIREMENTS.
3. CONTRACTOR TO COORDINATE REQUIRED INSTALLATION OF ALL BLOCKING FOR (NOT LIMITED TO) ALL FIXTURES, EQUIP, OR SIGNAGE.
4. PROVIDE 3" TALL HELVETICA LETTERS STENCILED AT ALL RATED WALLS, STENCILING TO READ AS FOLLOWS "FIRE AND SMOKE BARRIER-PROTECT ALL OPENINGS". INCLUDE UL NUMBERS TYPICAL OF ALL RATED WALLS.

**NORTH LITTLE ROCK
FIRE DEPARTMENT
STATION 8**

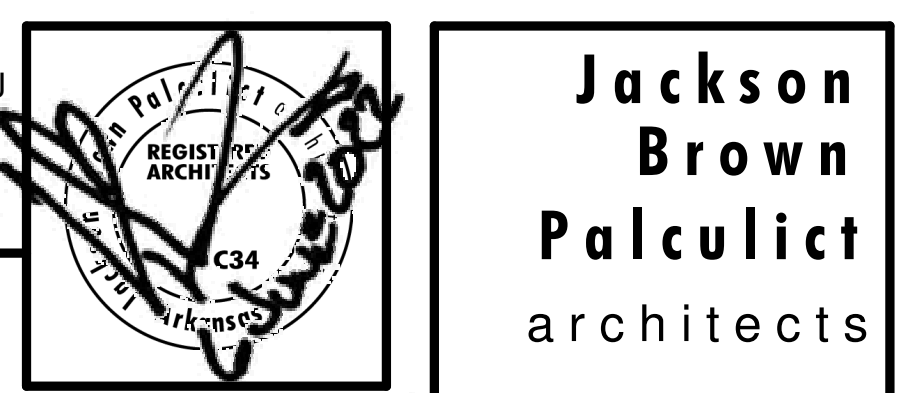


Date
6/6/22
Revisions

JOB NUMBER 2203

Sheet Title
WALL SECTIONS


Sheet Number
A408

12921 Cantrell Road, Suite 201
Little Rock, AR 72223
501.664.8700 tel
501.664.5189 fax
www.jbparchitects.com

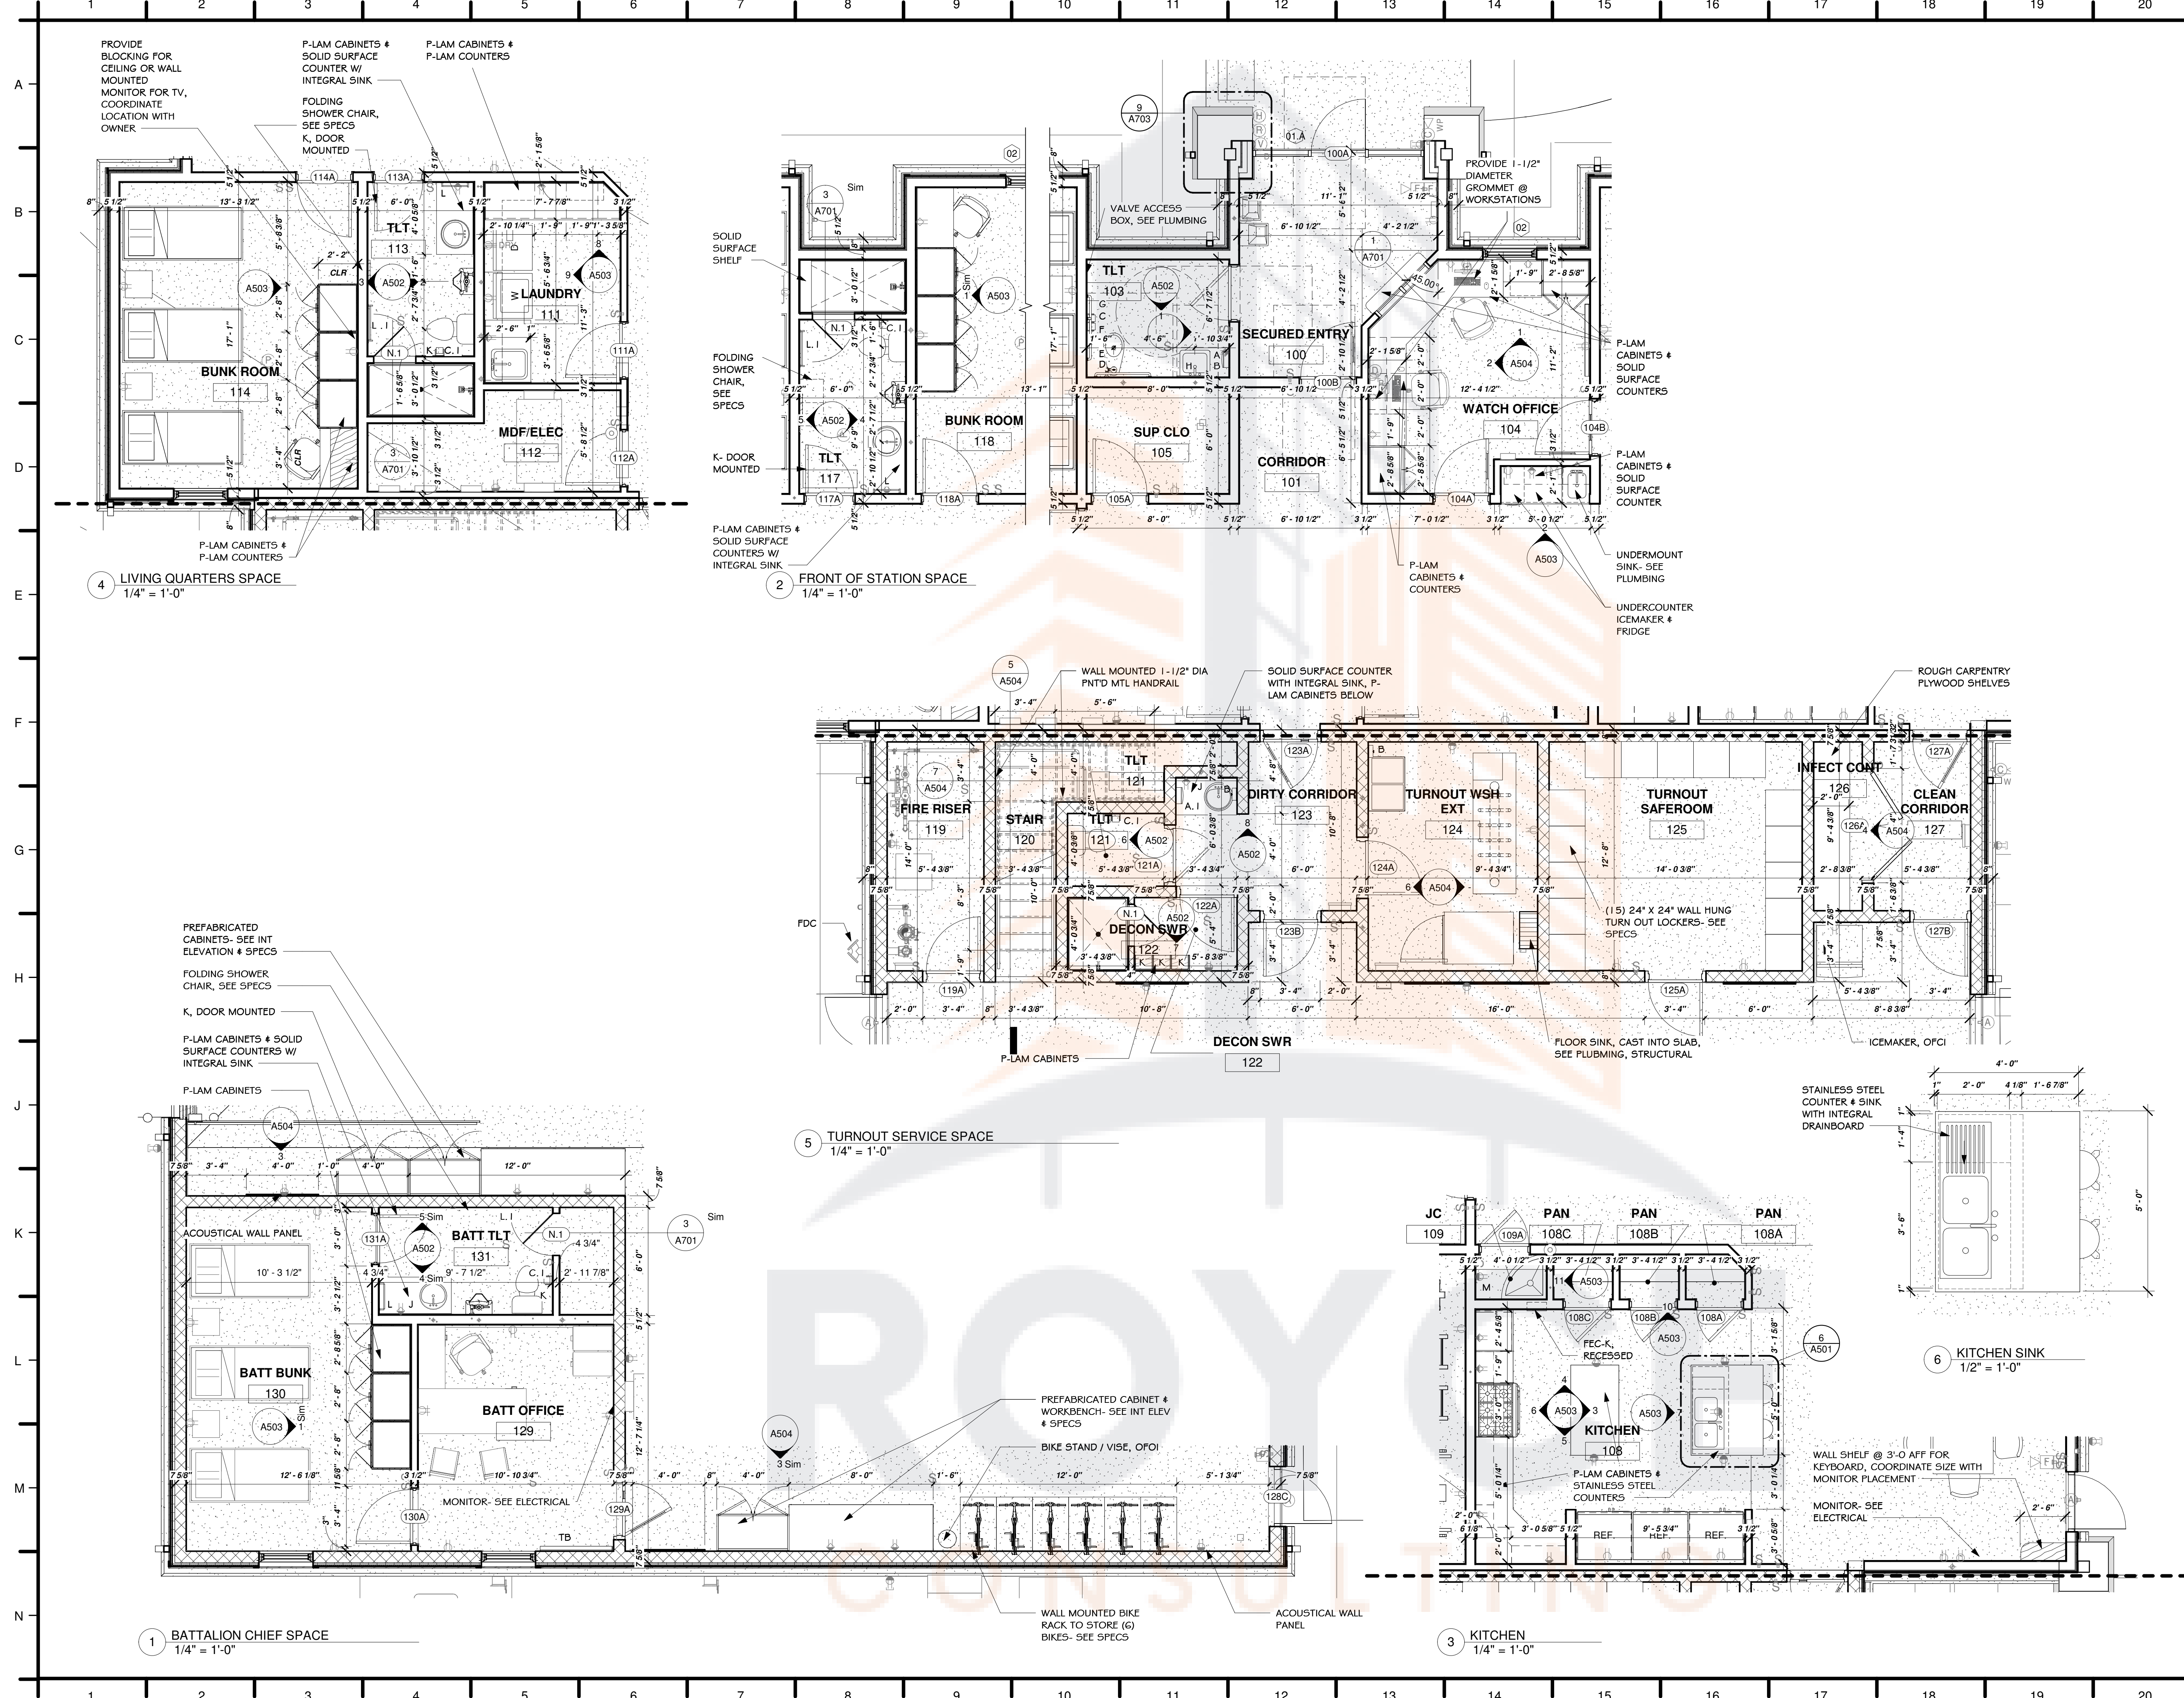

- General Notes**
1. PROVIDE FIELD PAINTING OF HANGERS, EXPOSED STEEL, AND IRON WORK, OF PRIMED METAL SURFACES AND EXPOSED-TO-VIEW METAL SURFACES OF ITEMS, AS REQUIRED TO MATCH ADJACENT SURFACES AND EQUIPMENT INSTALLED UNDER MECHANICAL AND ELECTRICAL WORK. THIS INCLUDES BUT IS NOT LIMITED TO, ALL EXPOSED CONDUIT, FIRE SPRINKLER PIPING, HANGERS, DUCTWORK, SUPPORTS, ETC. IF IT CAN BE SEEN, PAINT IT. ARCHITECT TO SELECT COLOR OR COLORS.
 2. ALL DIMENSIONS ARE TO FACE OF STUD OR BLOCK, U.N.O.
 3. 'C.I.' INDICATES CONTROL JOINT. SEE SPECIFICATIONS FOR DESCRIPTION OF METHODS AND LOCATIONS PERTAINING TO REQUIREMENTS.
 4. CONTRACTOR TO COORDINATE REQUIRED INSTALLATION OF ALL BLOCKING FOR (NOT LIMITED TO) ALL FIXTURES, EQUIP, OR SIGNAGE.
 5. PROVIDE 3" TALL HELVETICA LETTERS STENCILED AT ALL RATED WALLS, STENCILING TO READ AS FOLLOWS "FIRE AND SMOKE BARRIER-PROTECT ALL OPENINGS". INCLUDE UL NUMBERS TYPICAL OF ALL RATED WALLS.
 6. FIRE EXTINGUISHER CABINETS (FEC) ARE TO BE MOUNTED 48" A.F.F. TO THE TOP OF THE CABINET.
 7. FURNITURE N.I.C. SHOWN FOR REFERENCE ONLY.
 8. ALL SWITCHES TO BE MOUNTED NO HIGHER THAN 48" A.F.F.
 9. ALL DOOR HDWR TO MEET ADA REQUIREMENTS.
 10. PROVIDE BLOCKING IN BUNK ROOMS FOR WALL OR CEILING MOUNTED MONITOR. COORDINATE LOCATION WITH OWNER.
- ACCESSORIES**
- | | |
|-----|--|
| A | PAPER TOWEL DISPENSER |
| A.1 | PAPER TOWEL DISPENSER AND RECEPTACLE |
| B | SOAP DISPENSER (WALL MOUNTED) |
| B.1 | SOAP DISPENSER (COUNTER-MOUNTED) |
| C | DOUBLE TOILET PAPER DISPENSER |
| C.1 | SINGLE TOILET PAPER DISPENSER |
| D | 36" GRAB BAR (MNT 10-12" FROM REAR WALL) |
| E | 42" GRAB BAR (MNT 6" FROM SIDE WALL) |
| F | 18" VERTICAL GRAB BAR |
| G | SANITARY NAPKIN RECEPTACLE |
| H | FRAMED MIRROR (24"x42") |
| J | MIRROR |
| K | ROBE HOOK |
| L | 24" TOWEL BAR |
| L.1 | 18" TOWEL BAR |
| M | MOP AND BROOM HOLDER |
| N | NOT USED |
| N.1 | SHOWER DOOR |

**NORTH LITTLE ROCK
FIRE DEPARTMENT
STATION 8**

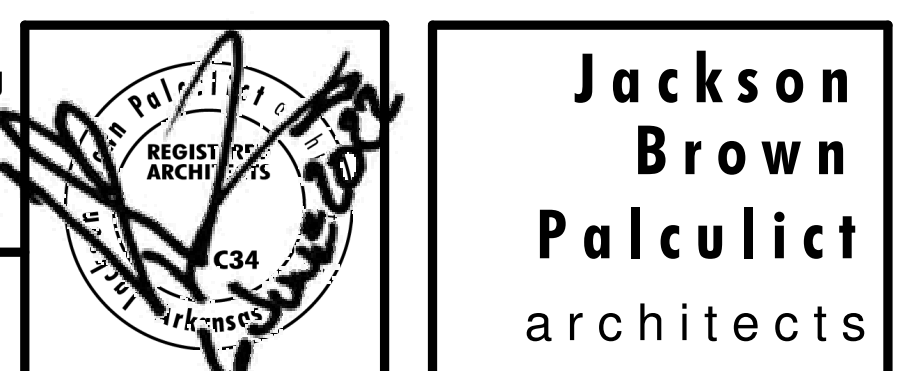

Date
6/6/22

Revisions


JOB NUMBER 2203

Sheet Title
ENLARGED PLANS

Sheet Number
A501

12921 Cantrell Road, Suite 201
Little Rock, AR 72223
501.664.8700 tel
501.664.5189 fax
www.jbparchitects.com

Copyright 2019 JBP

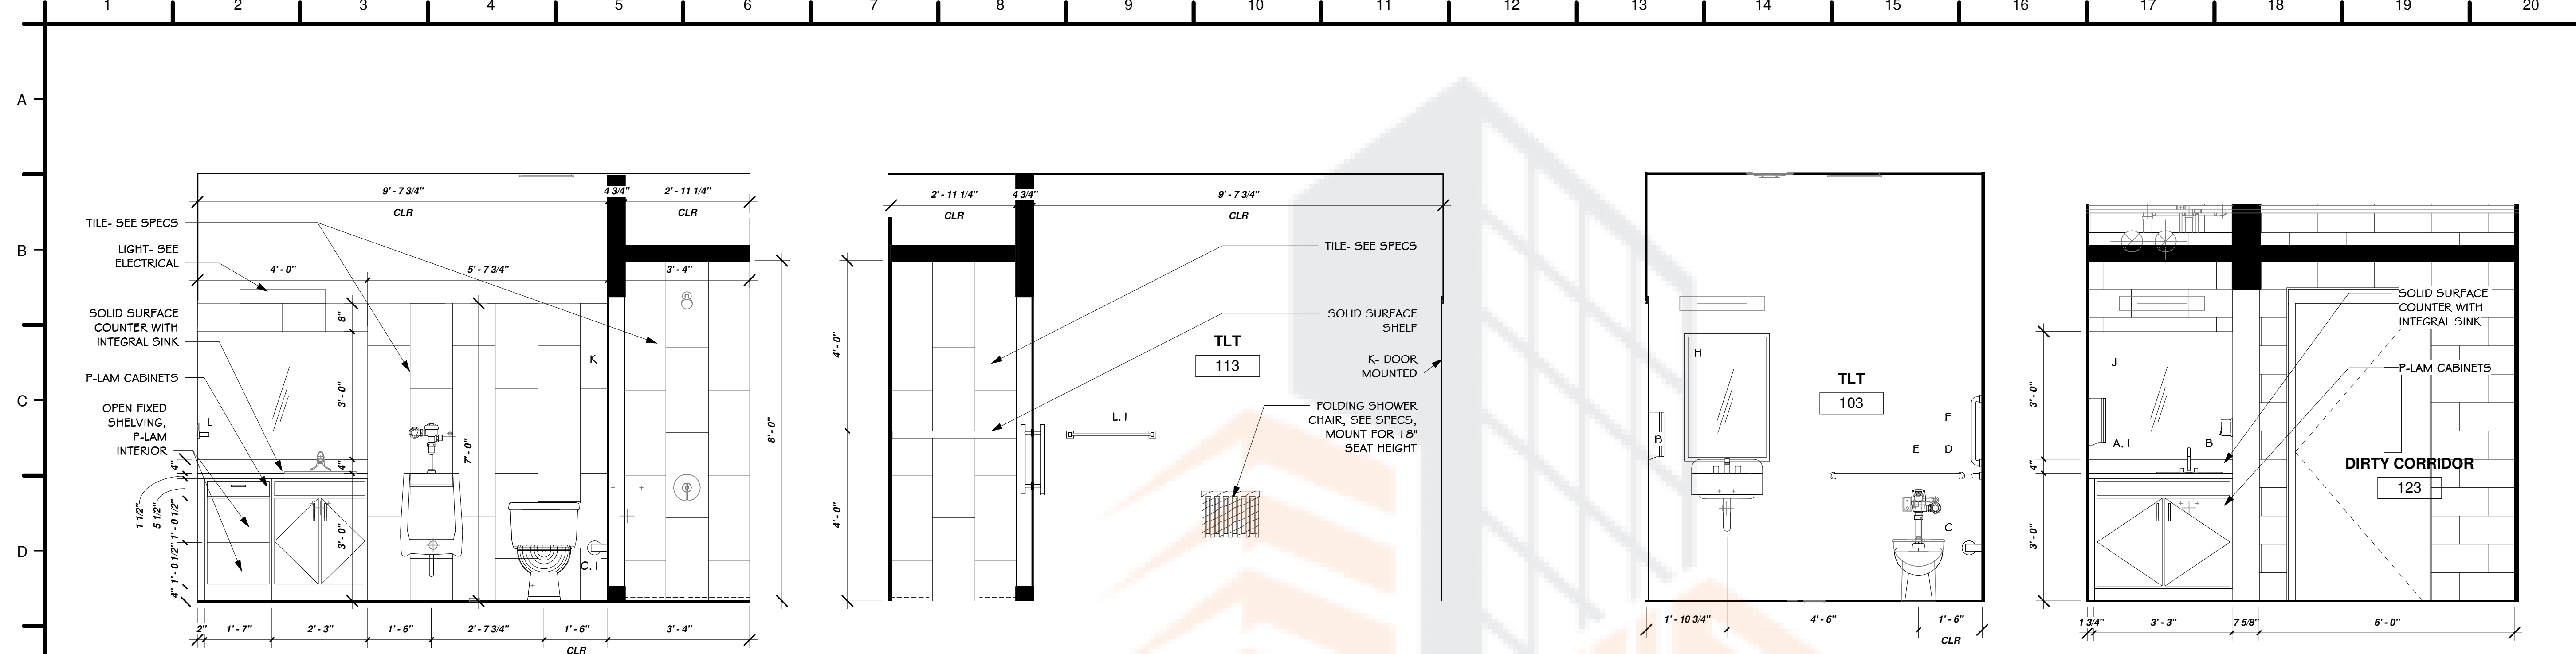


2 TL113 EAST
1/2" = 1'-0"


3 TL113 WEST
1/2" = 1'-0"

1 TL103 SOUTH
1/2" = 1'-0"


8 CORRIDOR 123 NORTH
1/2" = 1'-0"

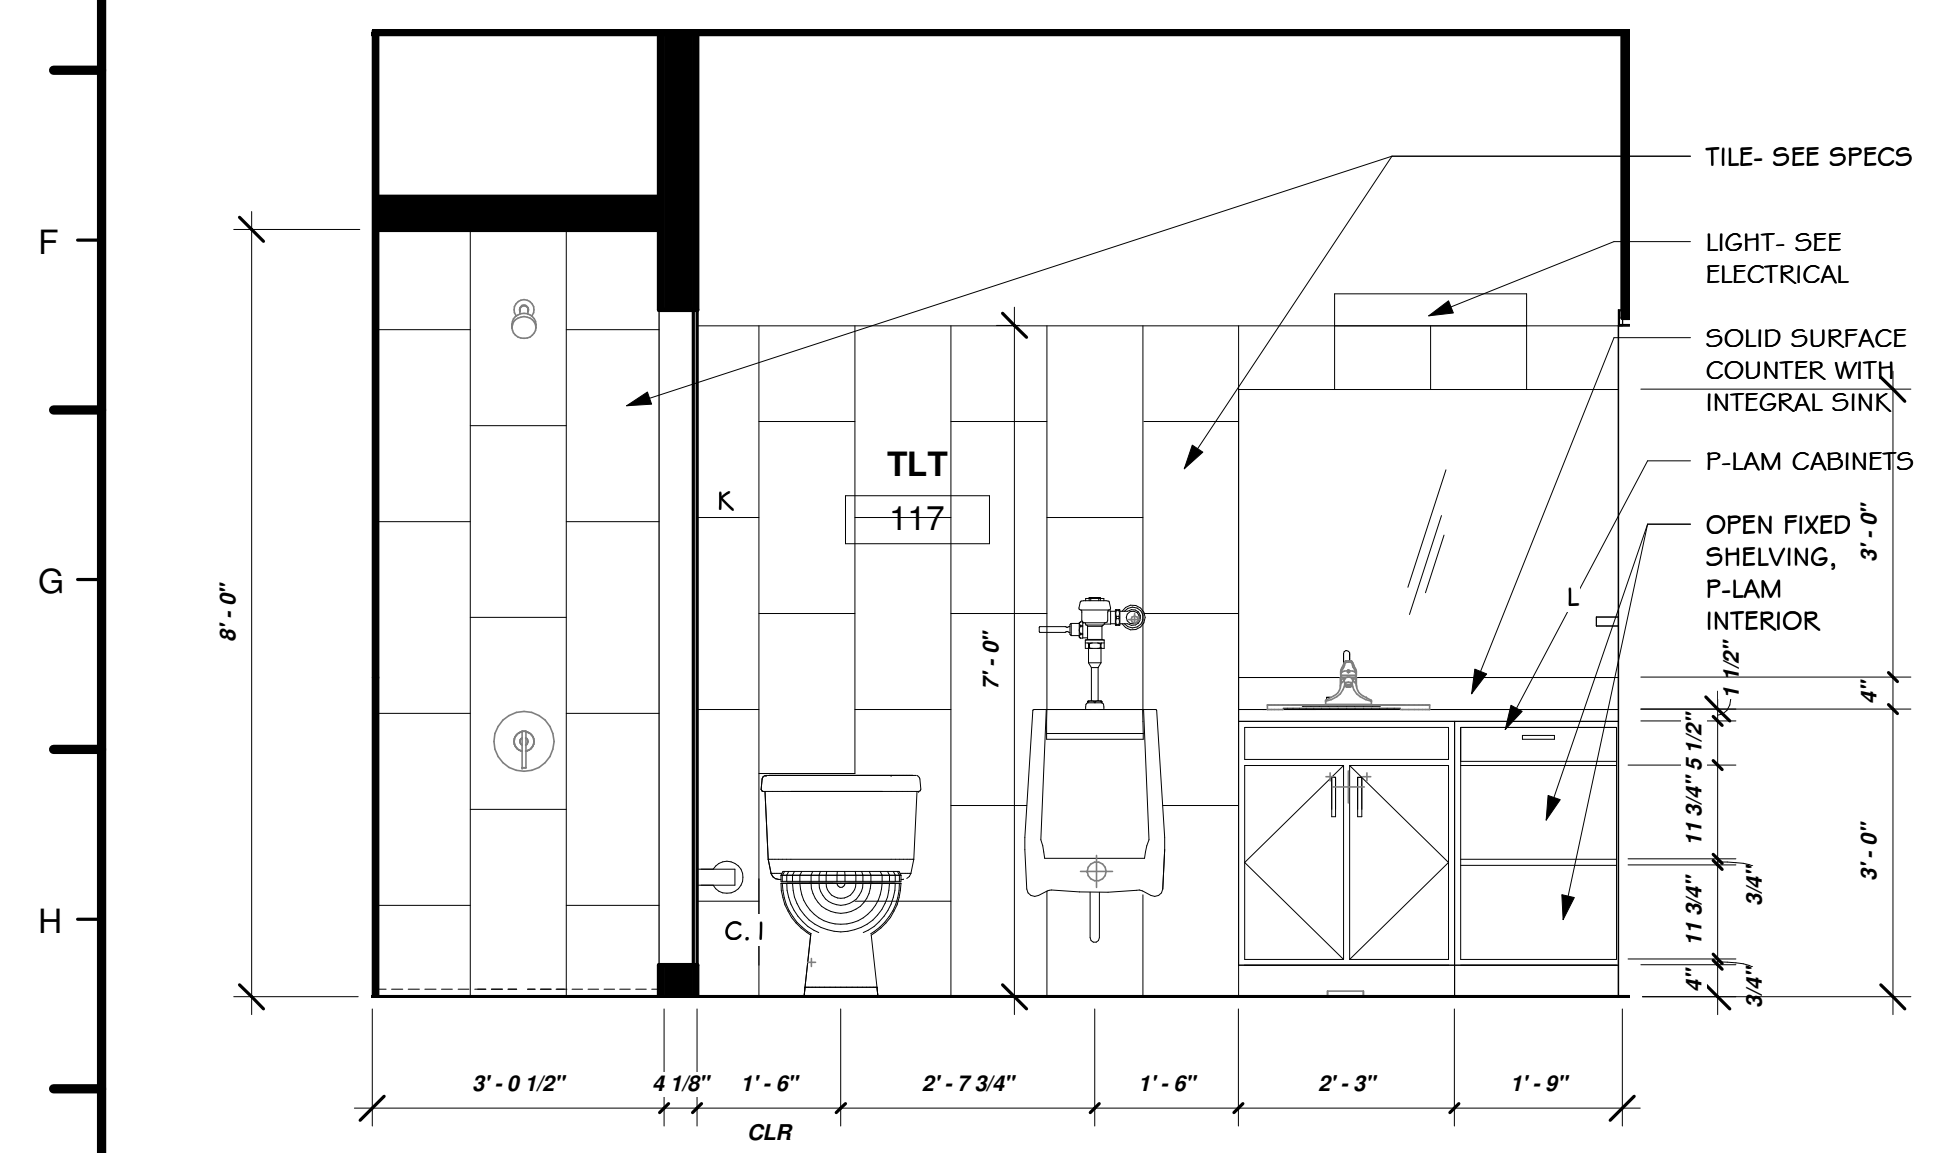


4 TL117 EAST
1/2" = 1'-0"

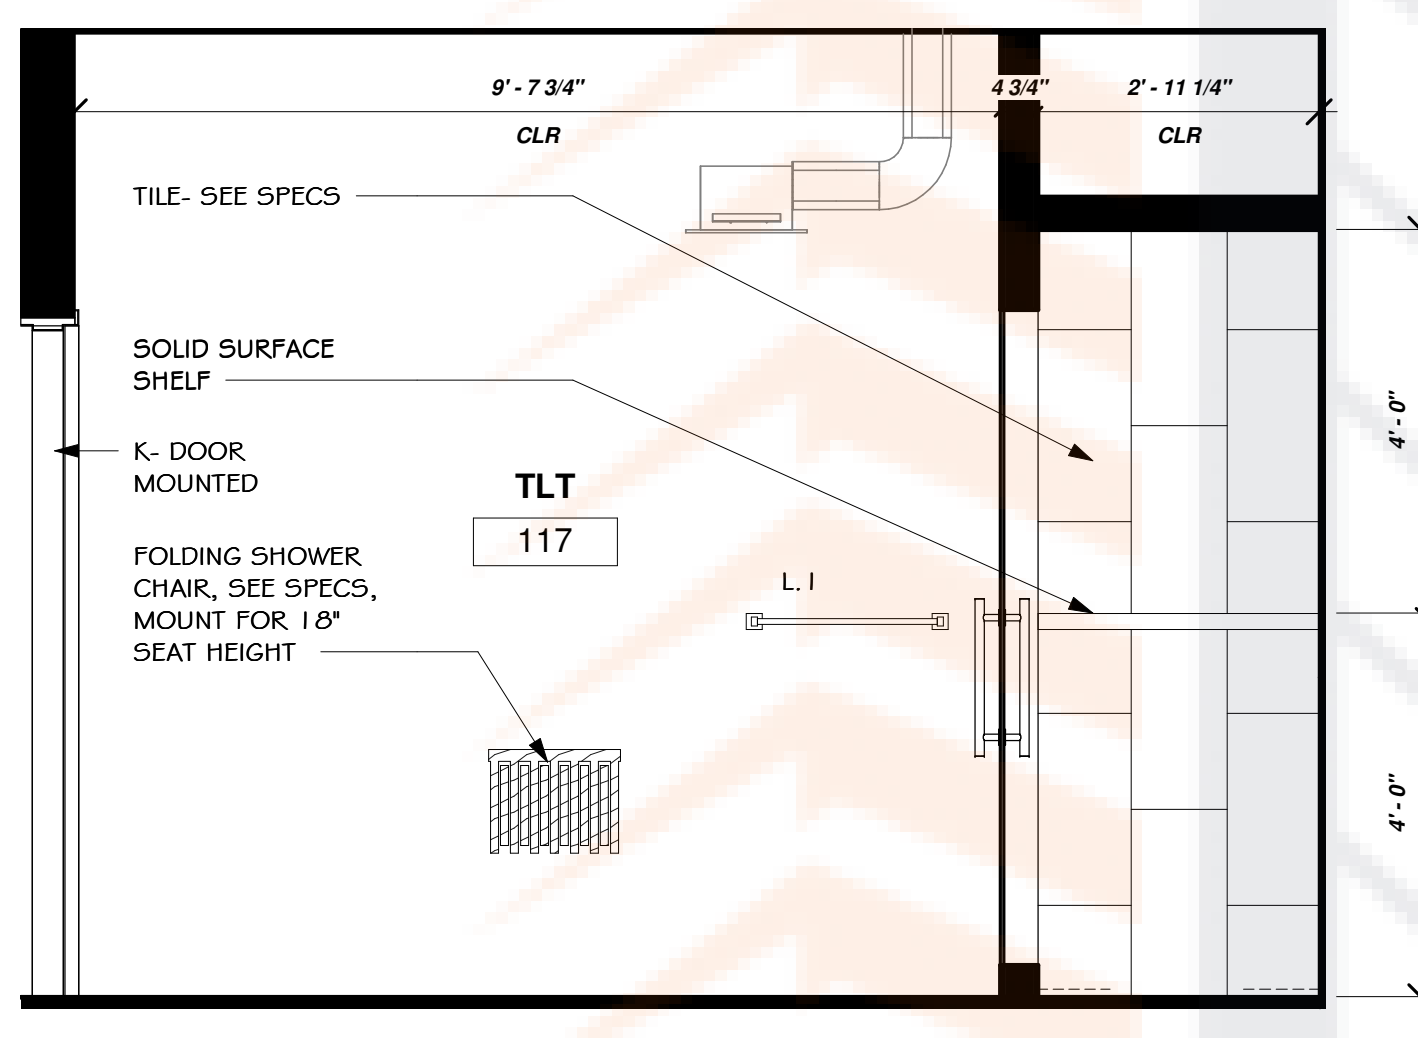


5 TL117 WEST
1/2" = 1'-0"

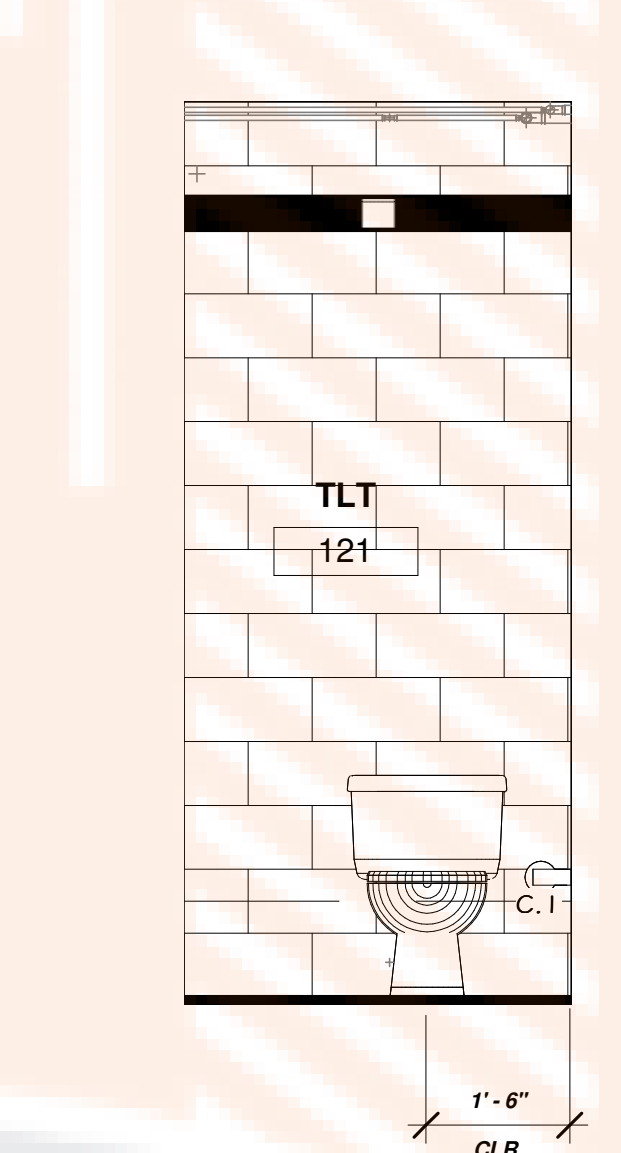

6 TL121 WEST
1/2" = 1'-0"

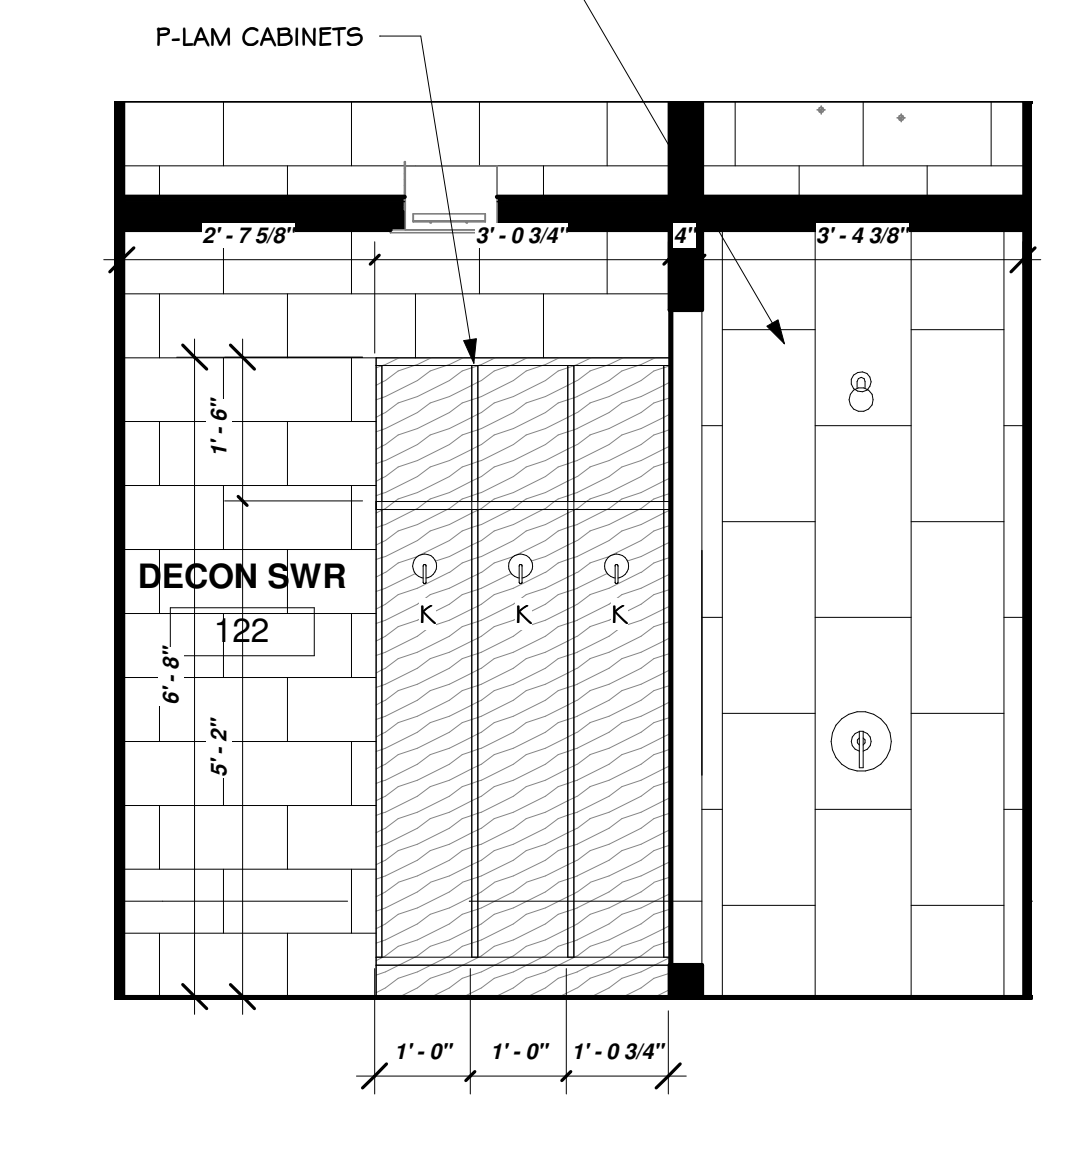

7 DECON 122 SOUTH
1/2" = 1'-0"

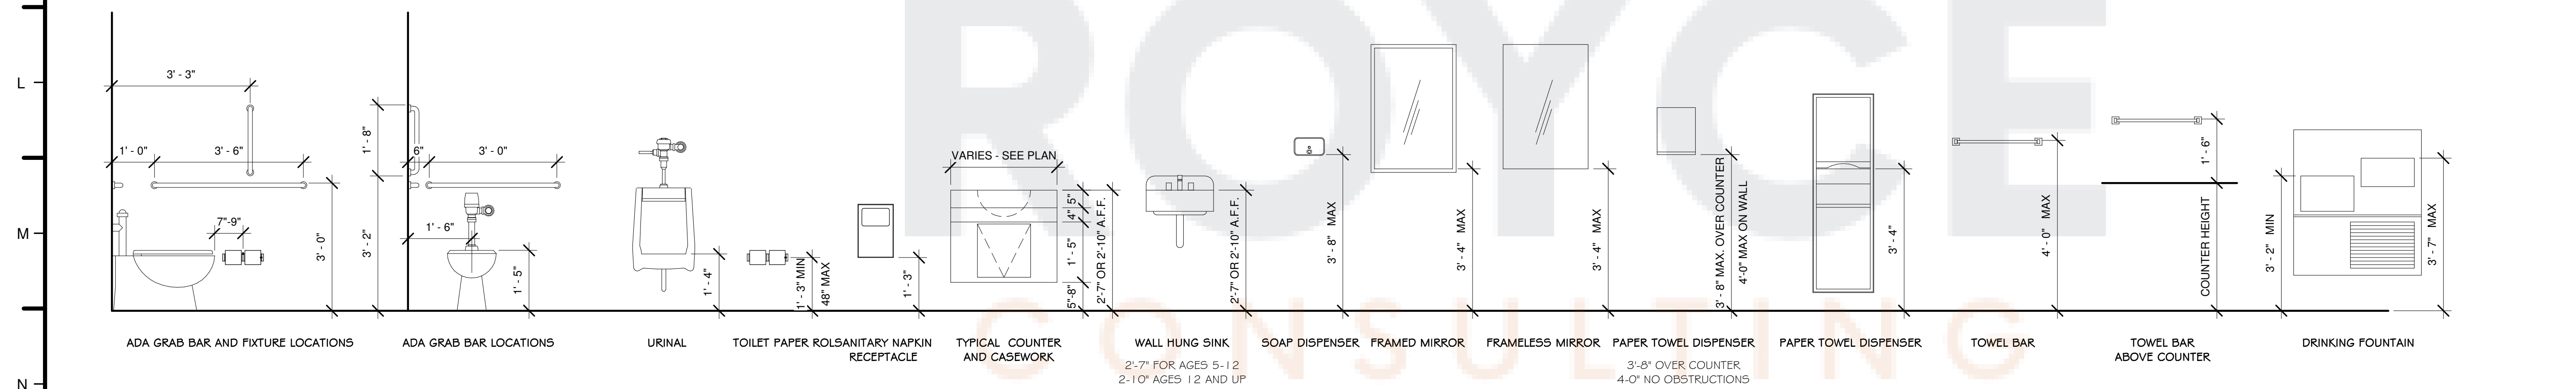


TYPICAL TOILET FIXTURE HEIGHTS
1/2" = 1'-0"

General Notes

- PROVIDE FIELD PAINTING OF HANGERS, EXPOSED STEEL, AND IRON WORK, OF PRIMED METAL SURFACES AND EXPOSED-TO-VIEW METAL SURFACES OF ITEMS, AS REQUIRED TO MATCH ADJACENT SURFACES AND EQUIPMENT INSTALLED UNDER MECHANICAL AND ELECTRICAL WORK. THIS INCLUDES BUT IS NOT LIMITED TO, ALL EXPOSED CONDUIT, FIRE SPRINKLER PIPING, HANGERS, DUCTWORK, SUPPORTS, ETC. IF IT CAN BE SEEN, PAINT IT. ARCHITECT TO SELECT COLOR OR COLORS.
- ALL DIMENSIONS ARE TO FACE OF STUD OR BLOCK, U.N.O.
- 'C.I.' INDICATES CONTROL JOINT. SEE SPECIFICATIONS FOR DESCRIPTION OF METHODS AND LOCATIONS PERTAINING TO REQUIREMENTS.
- CONTRACTOR TO COORDINATE REQUIRED INSTALLATION OF ALL BLOCKING FOR (NOT LIMITED TO) ALL FIXTURES, EQUIP, OR SIGNAGE.
- PROVIDE 3" TALL HELVETICA LETTERS STENCILED AT ALL RATED WALLS, STENCILING TO READ AS FOLLOWS "FIRE AND SMOKE BARRIER-PROTECT ALL OPENINGS". INCLUDE UL NUMBERS TYPICAL OF ALL RATED WALLS.
- FIRE EXTINGUISHER CABINETS (FEC) ARE TO BE MOUNTED 48" A.F.F. TO THE TOP OF THE CABINET.
- FURNITURE N.I.C. SHOWN FOR REFERENCE ONLY.
- ALL SWITCHES TO BE MOUNTED NO HIGHER THAN 48" A.F.F.
- ALL DOOR HSWR TO MEET ADA REQUIREMENTS
- PROVIDE BLOCKING IN BUNK ROOMS FOR WALL OR CEILING MOUNTED MONITOR. COORDINATE LOCATION WITH OWNER.

ACCESSORIES	
A	PAPER TOWEL DISPENSER
A.I	PAPER TOWEL DISPENSER AND RECEPTACLE
B	SOAP DISPENSER (WALL MOUNTED)
B.I	SOAP DISPENSER (COUNTER-MOUNTED)
C	DOUBLE TOILET PAPER DISPENSER
C.I	SINGLE TOILET PAPER DISPENSER
D	36" GRAB BAR (MNT 10-12" FROM REAR WALL)
E	42" GRAB BAR (MNT 6" FROM SIDE WALL)
F	18" VERTICAL GRAB BAR
G	SANITARY NAPKIN RECEPTACLE
H	FRAMED MIRROR (24"X42")
J	MIRROR
K	ROBE HOOK
L	24" TOWEL BAR
L.I	18" TOWEL BAR
M	MOP AND BROOM HOLDER
N	NOT USED
N.I	SHOWER DOOR

**NORTH LITTLE ROCK
FIRE DEPARTMENT
STATION 8**

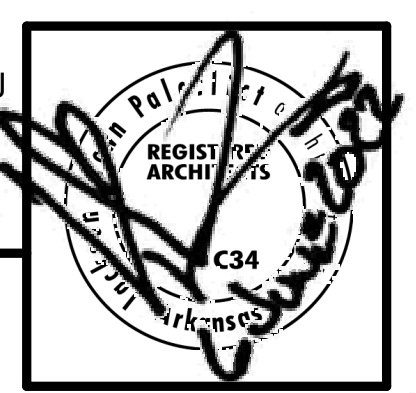

**Jackson
Brown
Palculict
architects**


Date
6/6/22
Revisions

JOB NUMBER 2203


Sheet Title
**INTERIOR
ELEVATIONS**

Sheet Number
A502


12921 Cantrell Road, Suite 201
Little Rock, AR 72223
501.664.8700 tel
501.664.5189 fax
www.jbparcitects.com

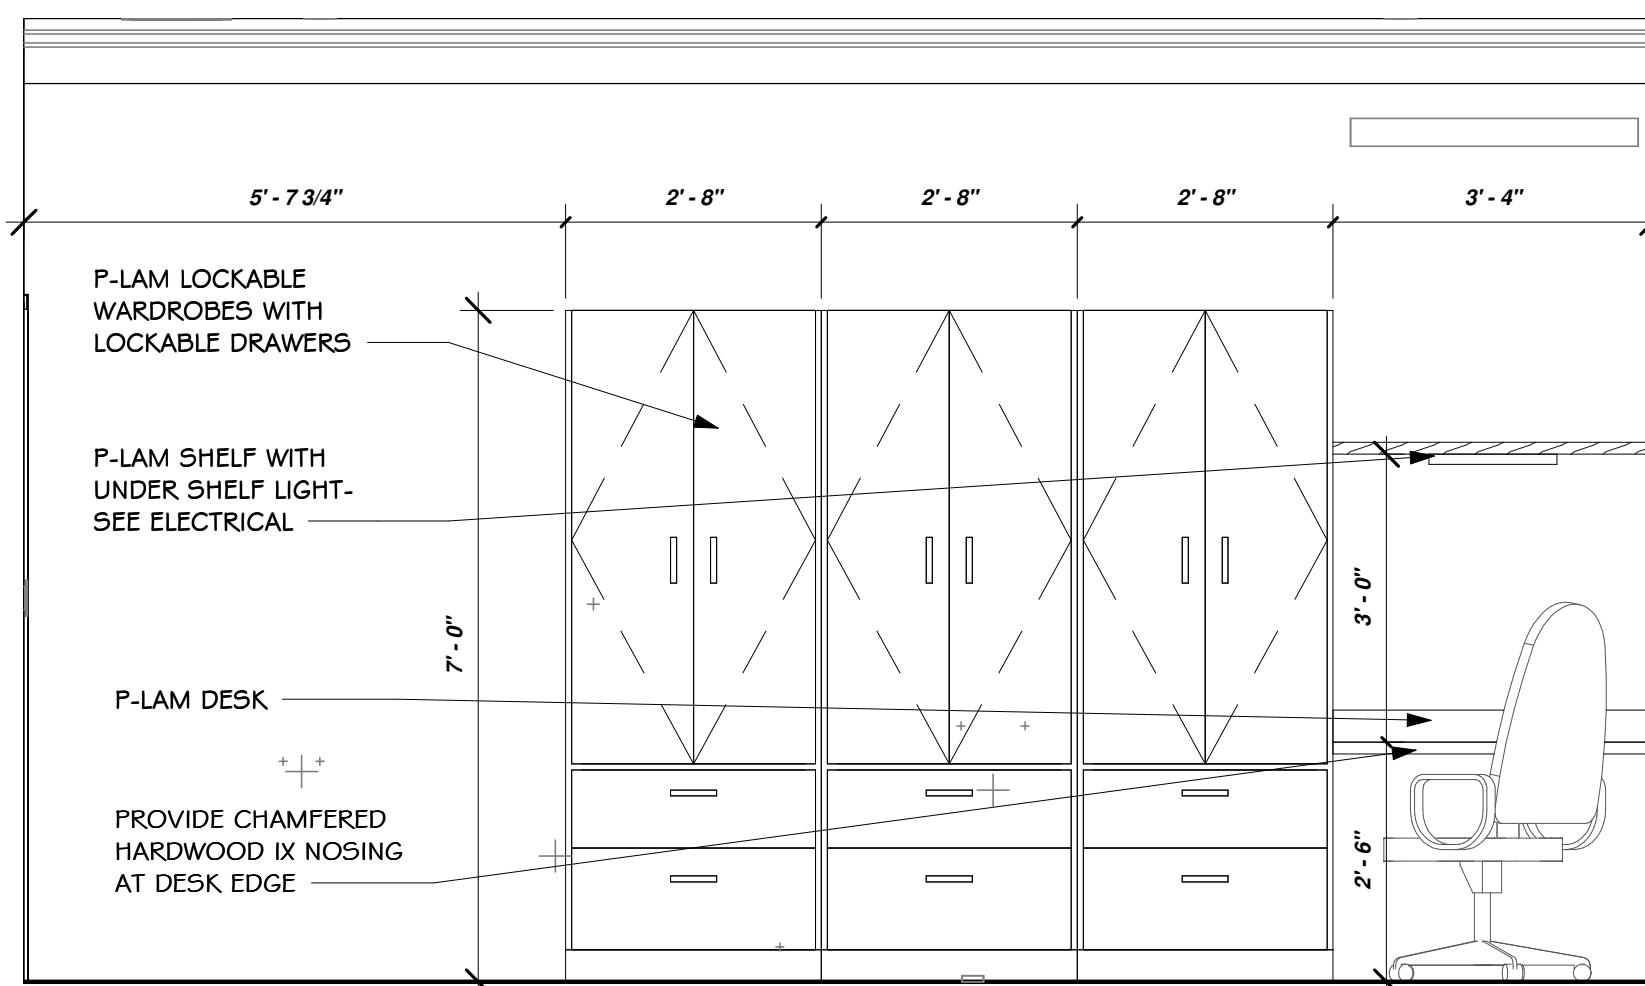

1 BUNK ROOM MILLWORK TYP.
1/2" = 1'-0"

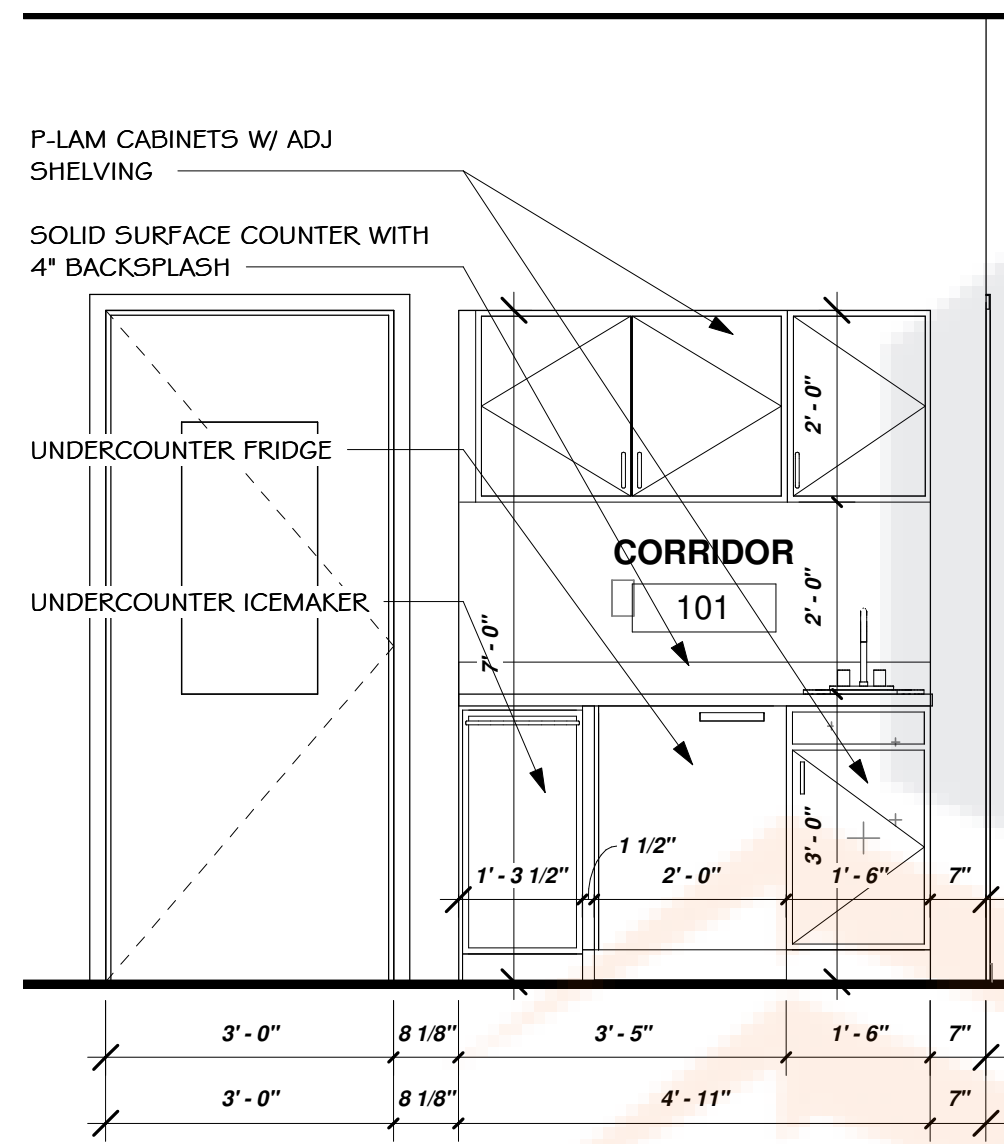


2 COFFEE BAR ELEVATION
1/2" = 1'-0"

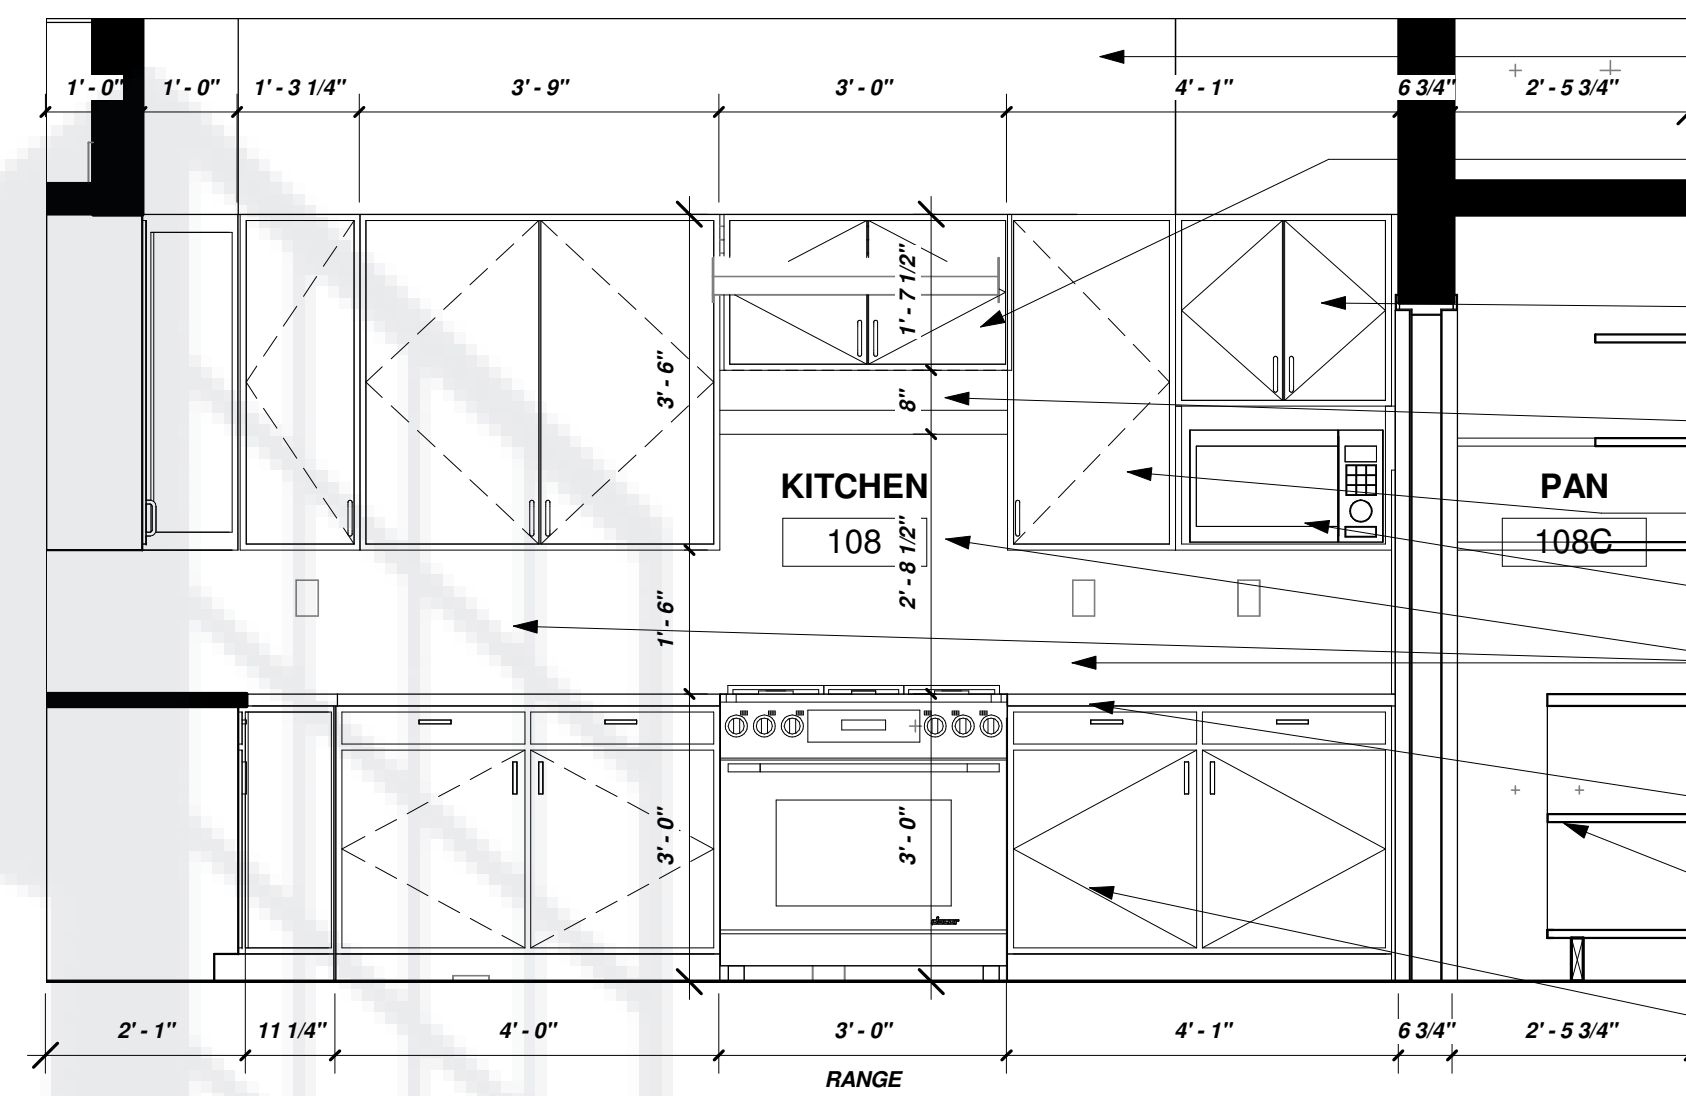


6 KITCHEN 108 WEST
1/2" = 1'-0"


PNTD GYP FURR DOWN TO T.O. CABINET
P-LAM CABINET HEIGHT ABOVE HOOD TO 8' AFF, COORDINATE WITH HOOD SPECS
2" DEEP P-LAM CABINETS W/ ADJ. SHELVING @ MICROWAVE
KITCHEN HOOD W/ FIRE SUPPRESSION- SEE MECH
P-LAM CABINETS W/ ADJ. SHELVING
MICROWAVE
STAINLESS STEEL BACKSPLASH TO COVER BACK WALL TO CABINET & HOOD HEIGHT
STAINLESS STEEL COUNTER @ KITCHEN, TYP.
P-LAM PANTRY SHELVES
P-LAM CABINETS W/ ADJ. SHELVING

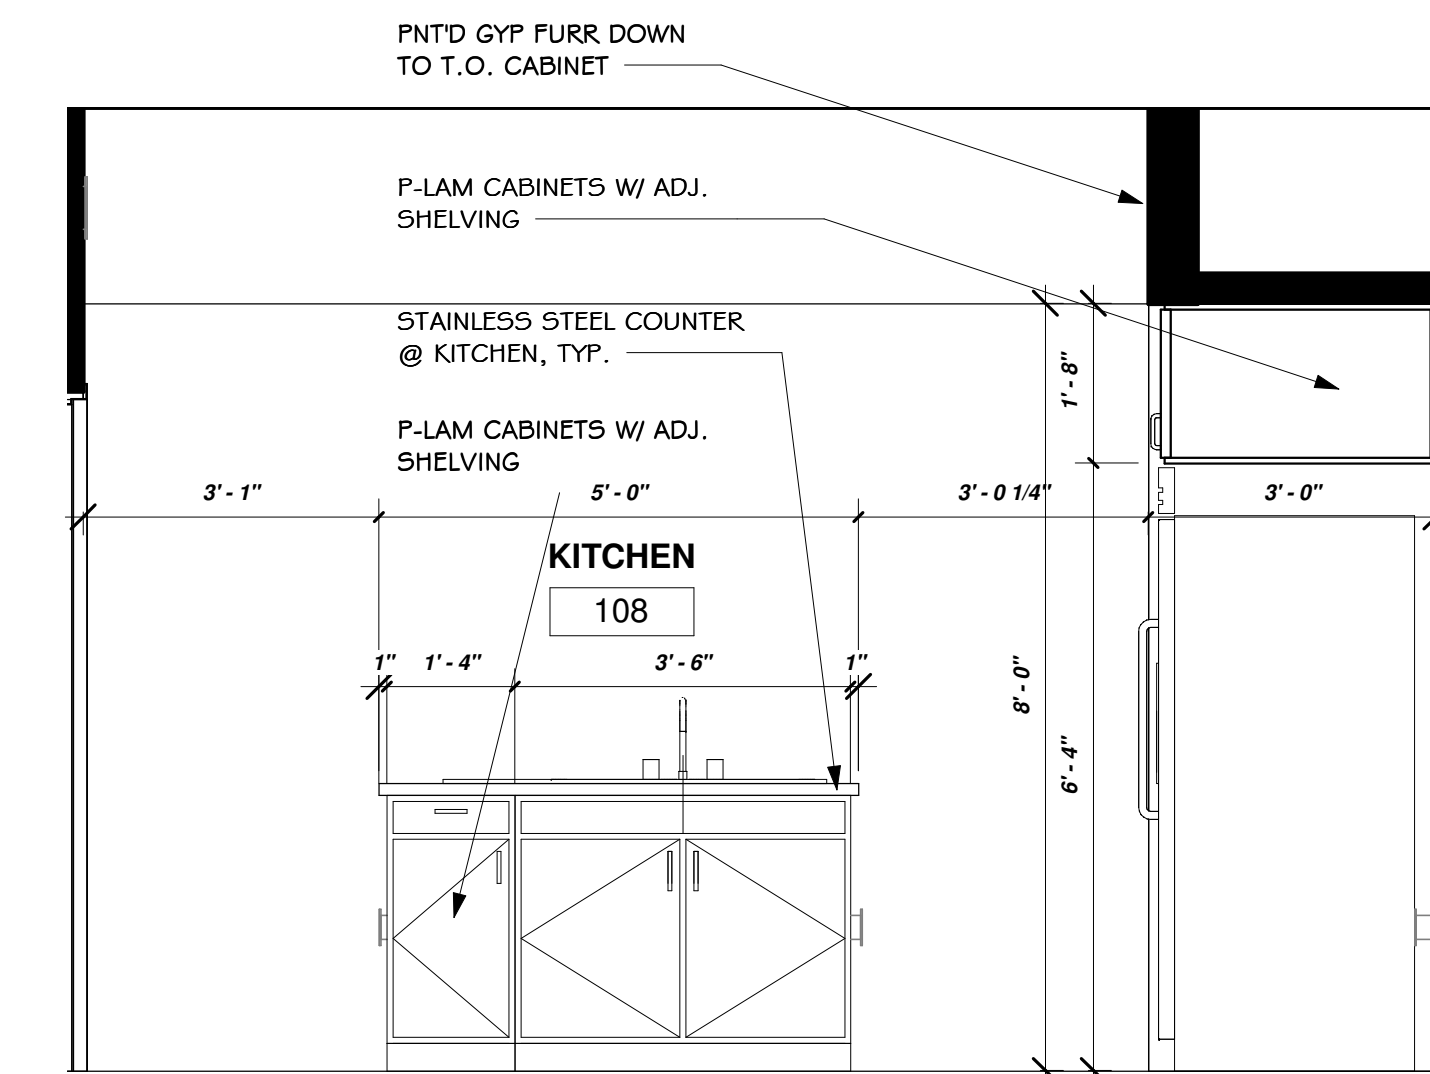


7 KITCHEN ISLAND EAST
1/2" = 1'-0"

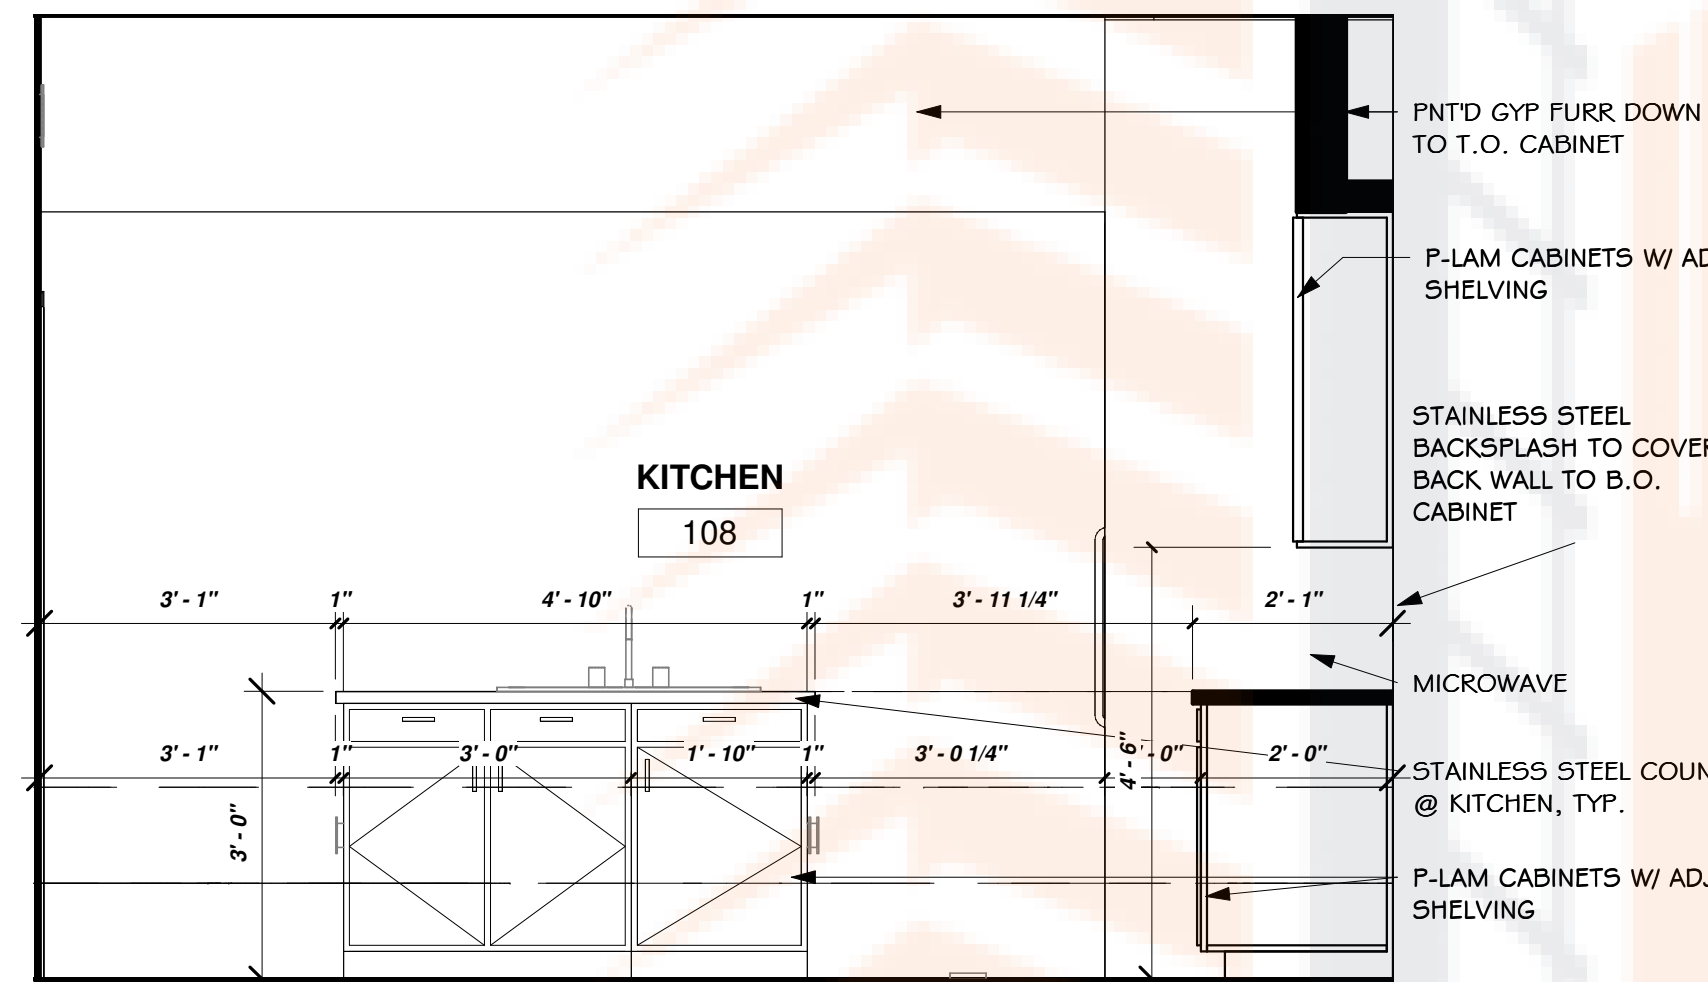


3 KITCHEN 108 EAST
1/2" = 1'-0"

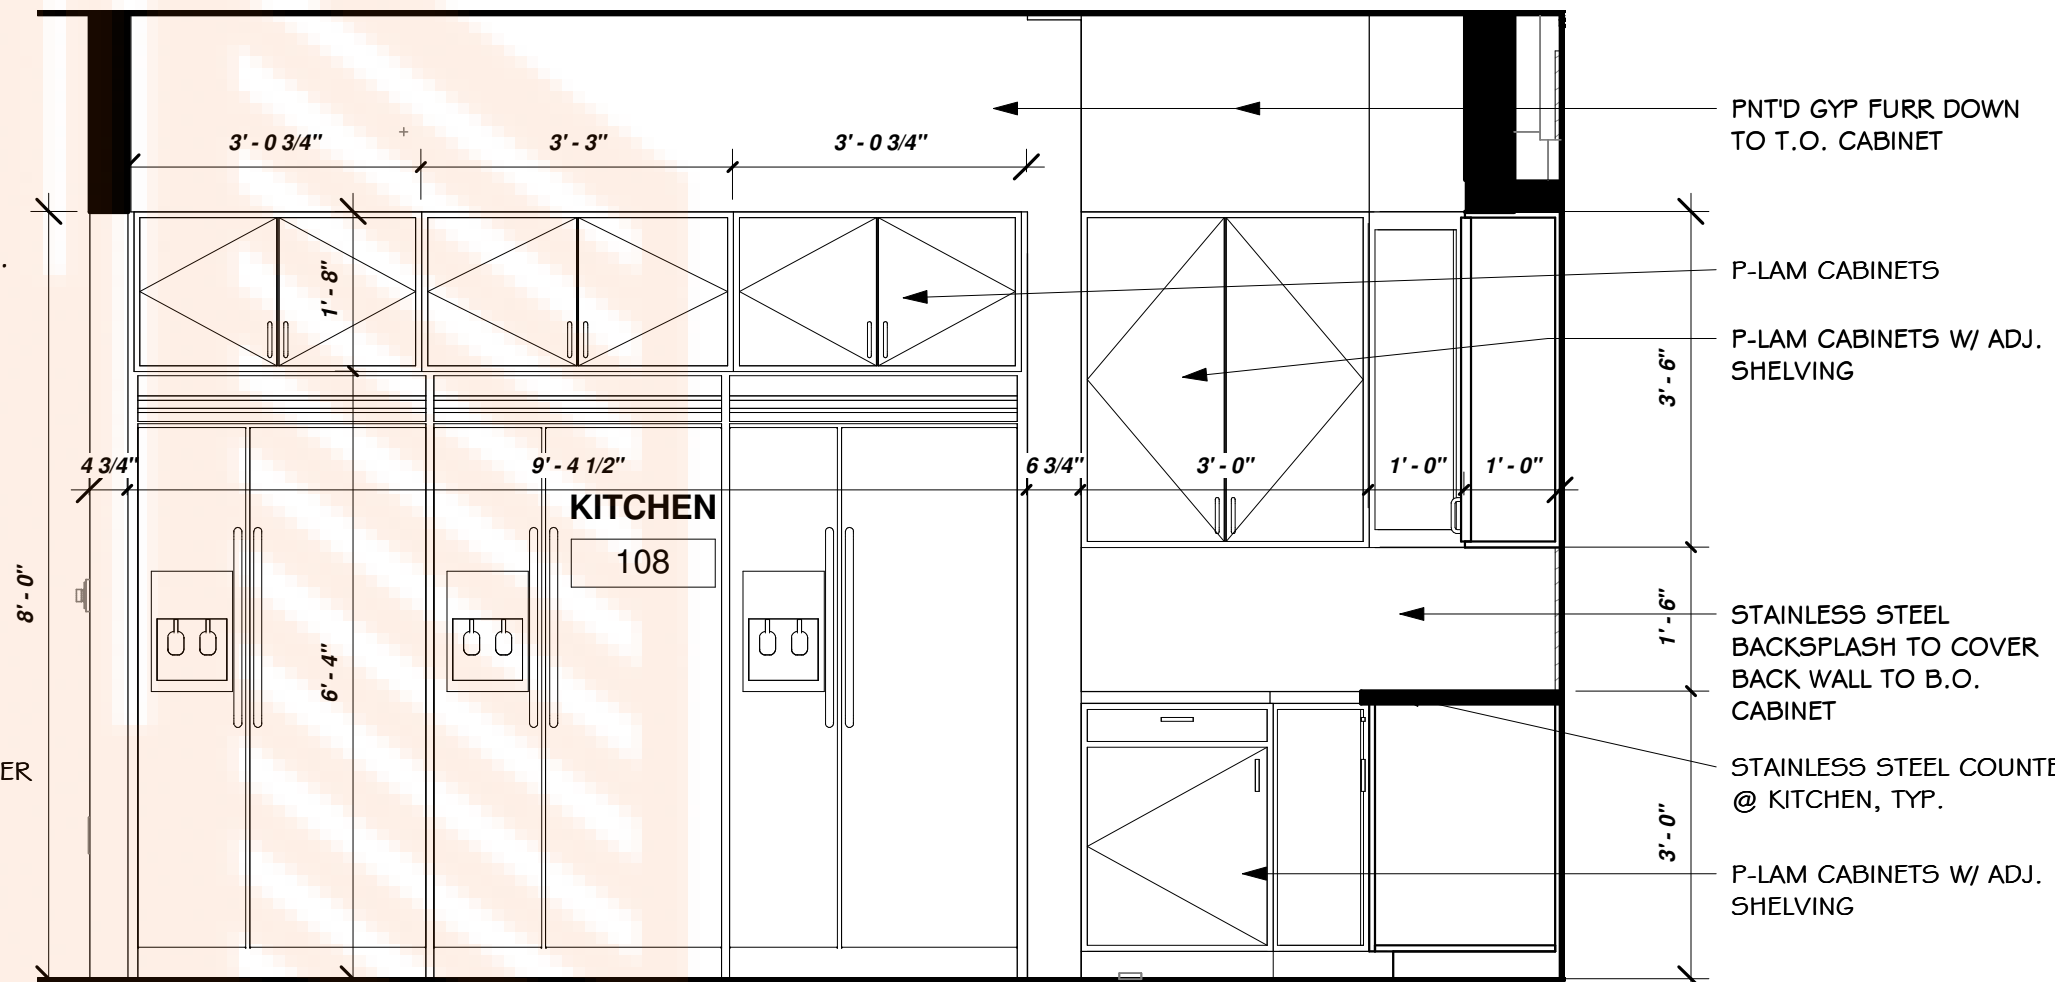


5 KITCHEN 108 SOUTH
1/2" = 1'-0"

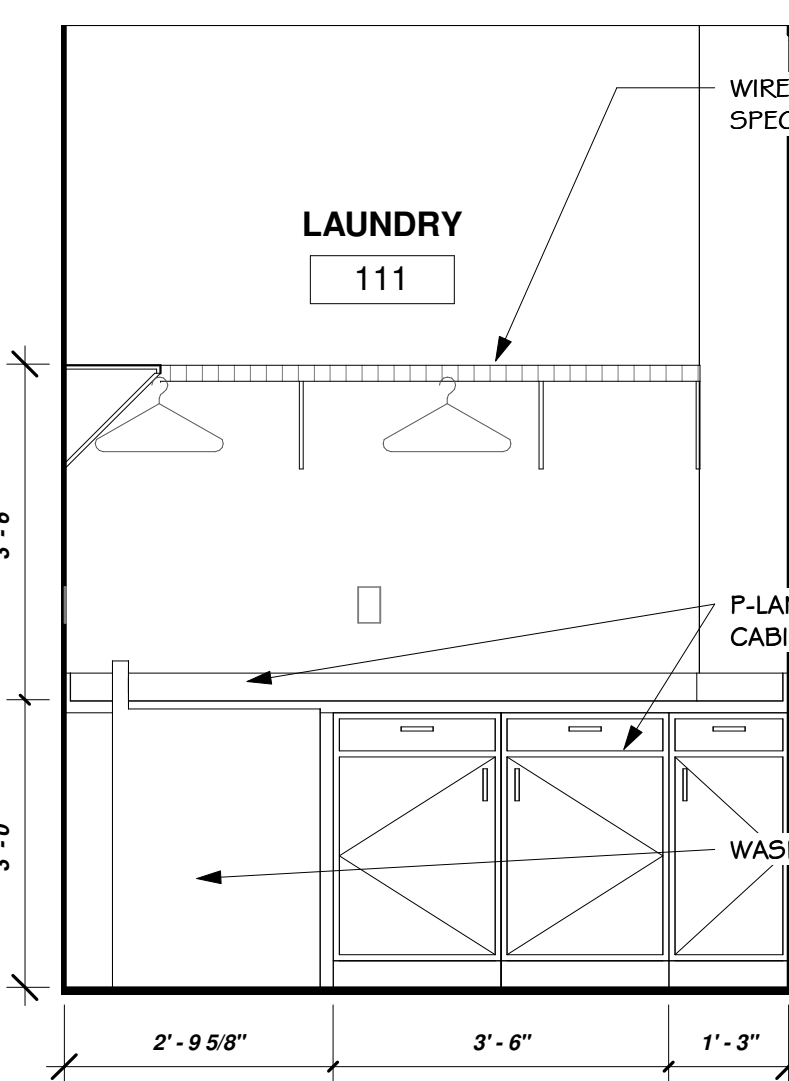

8 LAUNDRY 111 NORTH
1/2" = 1'-0"

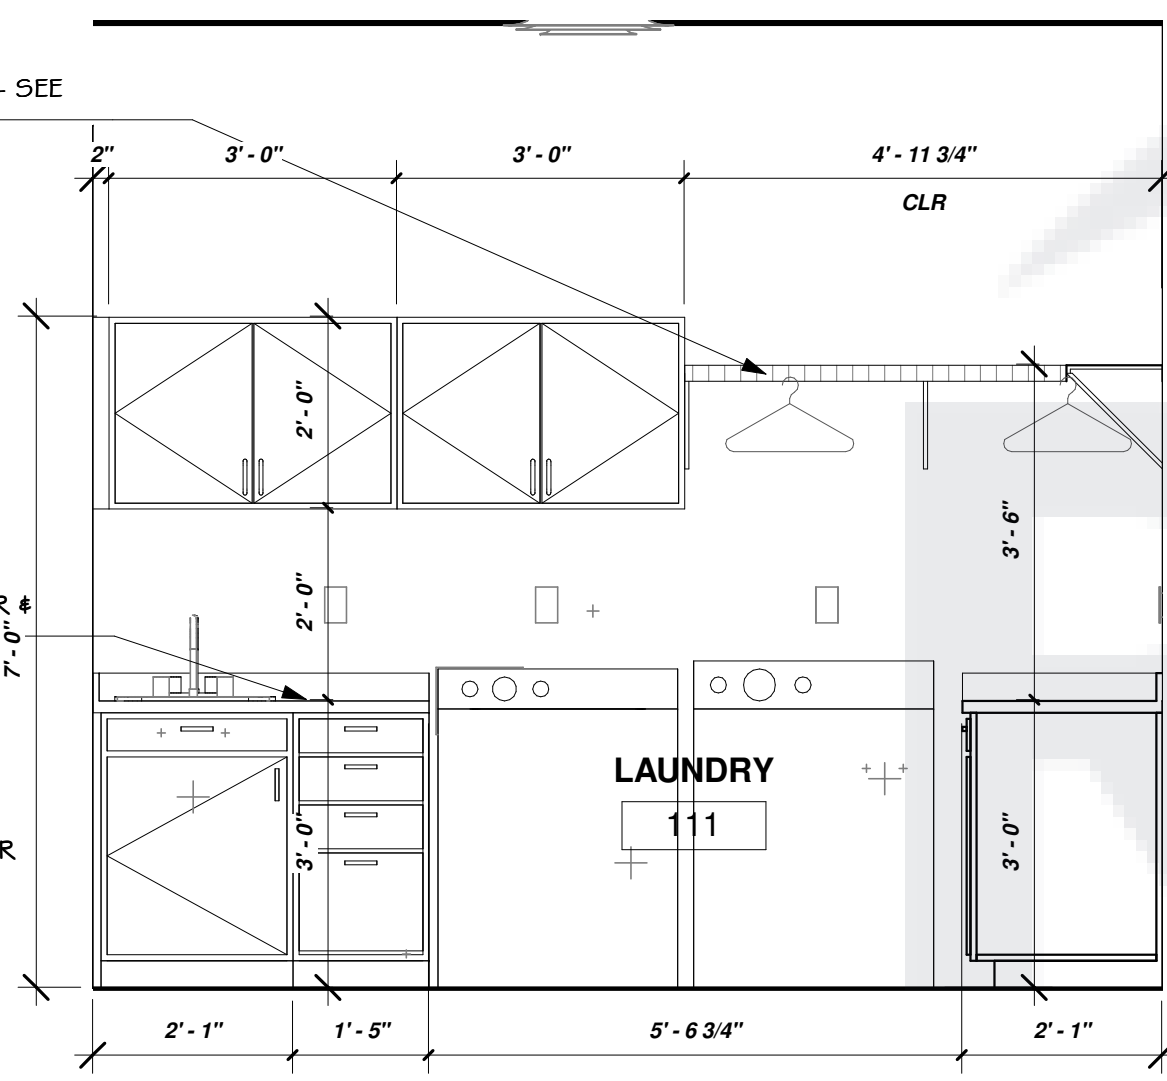

9 LAUNDRY 111 WEST
1/2" = 1'-0"

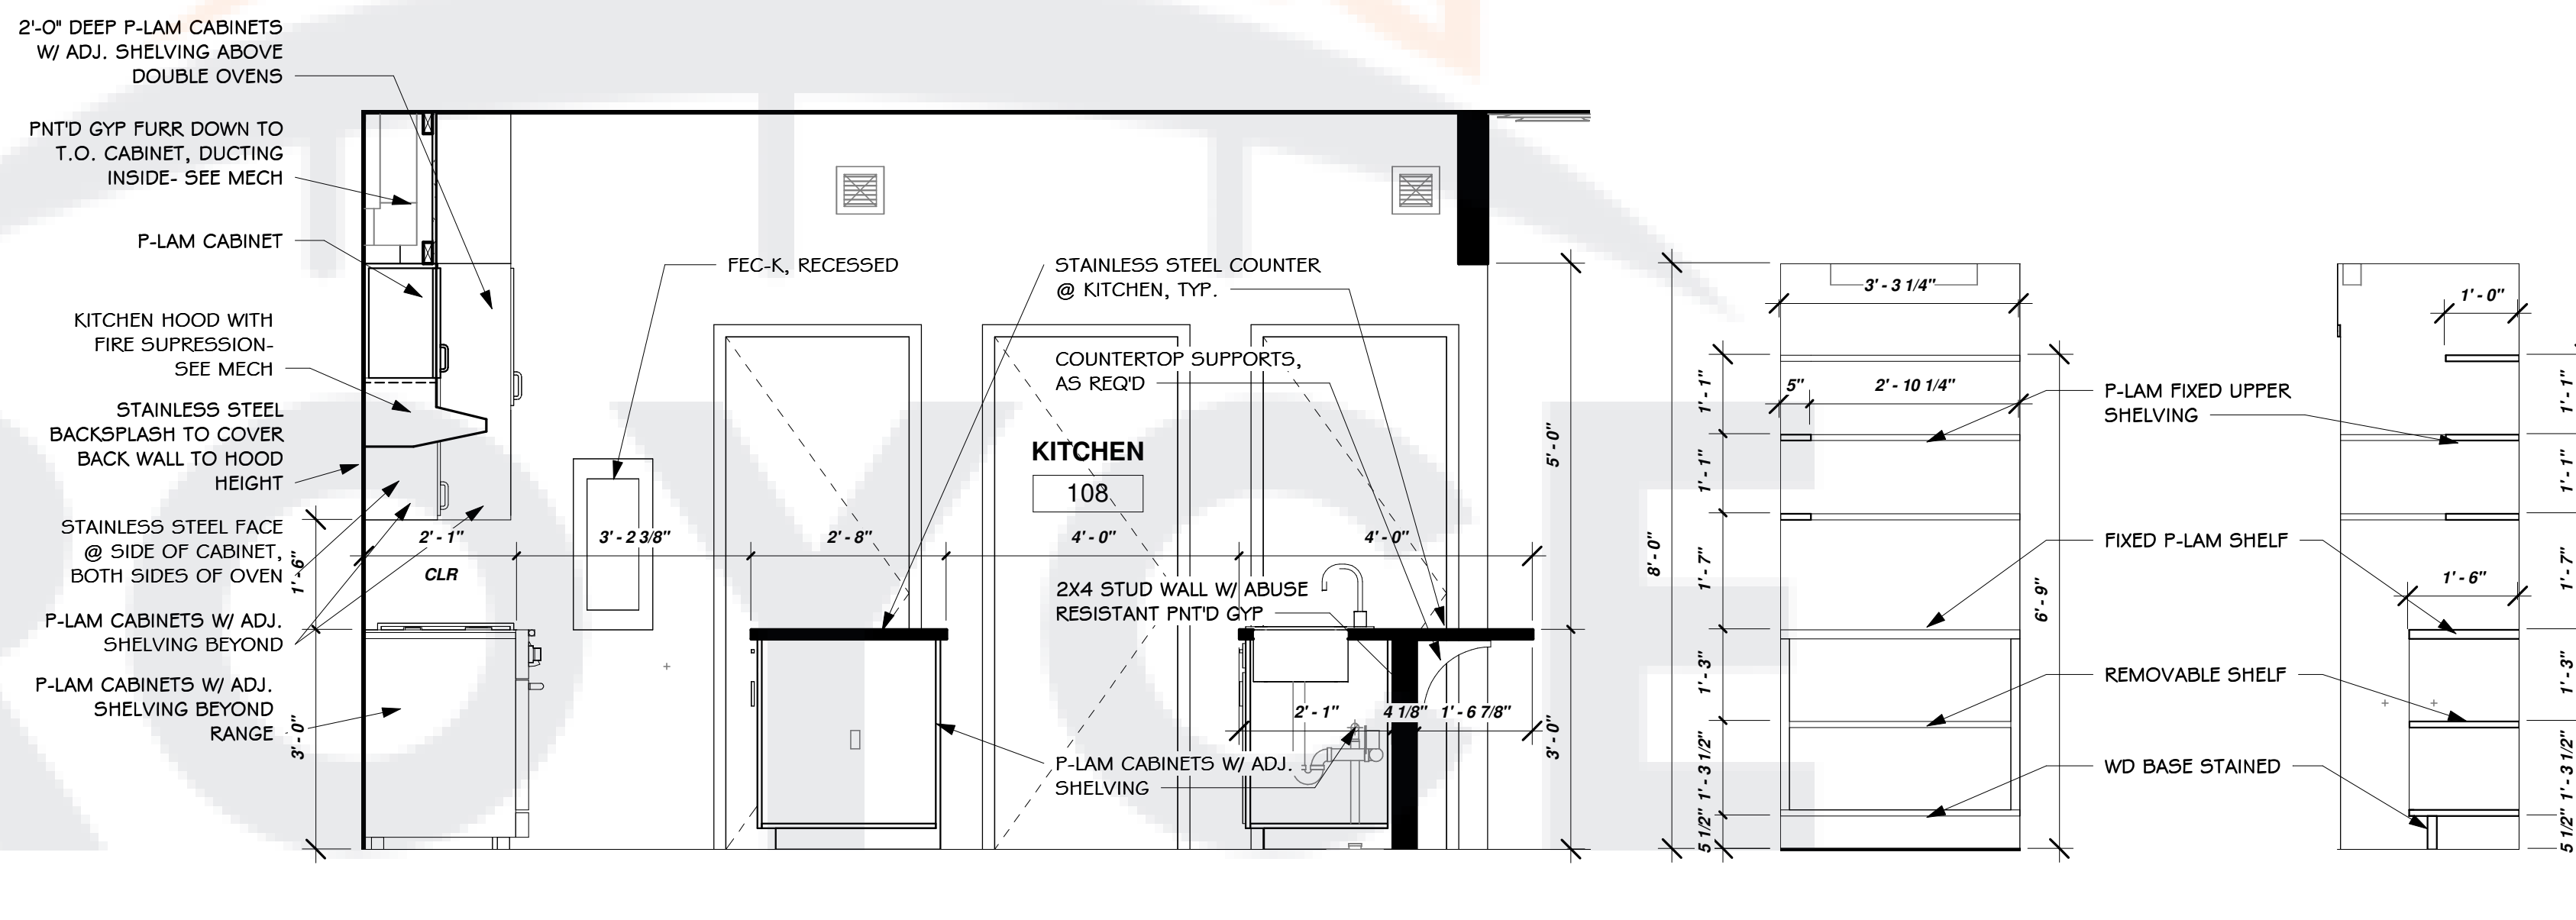

4 KITCHEN 108 NORTH
1/2" = 1'-0"


10 PANTRY 1
1/2" = 1'-0"

11 PANTRY 2
1/2" = 1'-0"

General Notes

- PROVIDE FIELD PAINTING OF HANGERS, EXPOSED STEEL, AND IRON WORK, OF PRIME METAL SURFACES AND EXPOSED-TO-VIEW METAL SURFACES OF ITEMS, AS REQUIRED TO MATCH ADJACENT SURFACES AND EQUIPMENT INSTALLED UNDER MECHANICAL AND ELECTRICAL WORK. THIS INCLUDES BUT IS NOT LIMITED TO, ALL EXPOSED CONDUIT, FIRE SPRINKLER PIPING, HANGERS, DUCTWORK, SUPPORTS, ETC. IF IT CAN BE SEEN, PAINT IT. ARCHITECT TO SELECT COLOR OR COLORS
- ALL DIMENSIONS ARE TO FACE OF STUD OR BLOCK, U.N.O.
- "CJ" INDICATES CONTROL JOINT. SEE SPECIFICATIONS FOR DESCRIPTION OF METHODS AND LOCATIONS PERTAINING TO REQUIREMENTS.
- CONTRACTOR TO COORDINATE REQUIRED INSTALLATION OF ALL BLOCKING FOR (NOT LIMITED TO) ALL FIXTURES, EQUIP, OR SIGNAGE
- PROVIDE 3" TALL HELVETICA LETTERS STENCILED AT ALL RATED WALLS, STENCILING TO READ AS FOLLOWS "FIRE AND SMOKE BARRIER-PROTECT ALL OPENINGS". INCLUDE UL NUMBERS TYPICAL OF ALL RATED WALLS.
- FIRE EXTINGUISHER CABINETS (FEC) ARE TO BE MOUNTED 48" A.F.F. TO THE TOP OF THE CABINET.
- FURNITURE I.L.C. SHOWN FOR REFERENCE ONLY.
- ALL SWITCHES TO BE MOUNTED NO HIGHER THAN 48" A.F.F.
- ALL DOOR HDWR TO MEET ADA REQUIREMENTS
- PROVIDE BLOCKING IN BUNK ROOMS FOR WALL OR CEILING MOUNTED MONITOR. COORDINATE LOCATION WITH OWNER.

**NORTH LITTLE ROCK
FIRE DEPARTMENT
STATION 8**

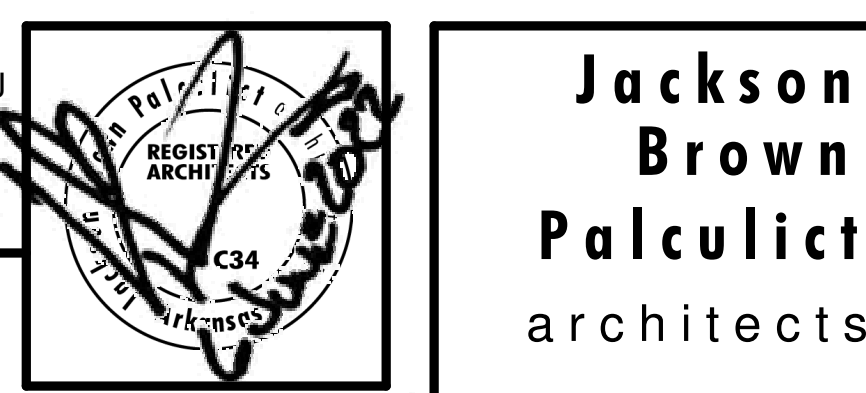

Date
6/6/22
Revisions


JOB NUMBER 2203

Sheet Title
**INTERIOR
ELEVATIONS**


Sheet Number
A503

12921 Cantrell Road, Suite 201
Little Rock, AR 72223
501.664.8700 tel
501.664.5189 fax
www.jbparchitects.com


CONSULTING

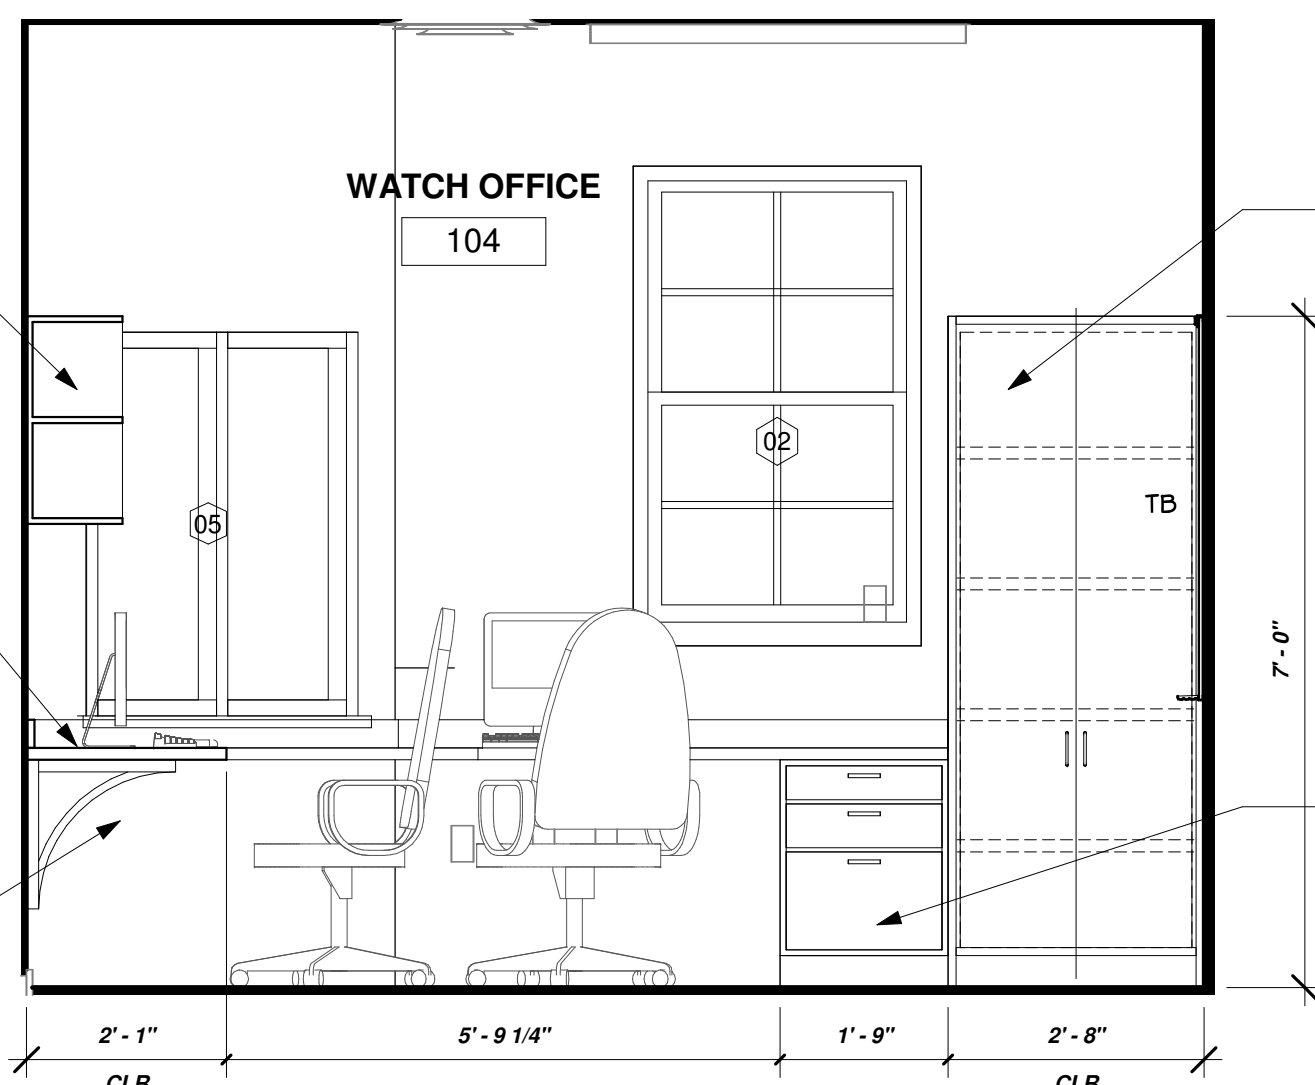


1 OFFICE 104 NORTH
1/2" = 1'-0"

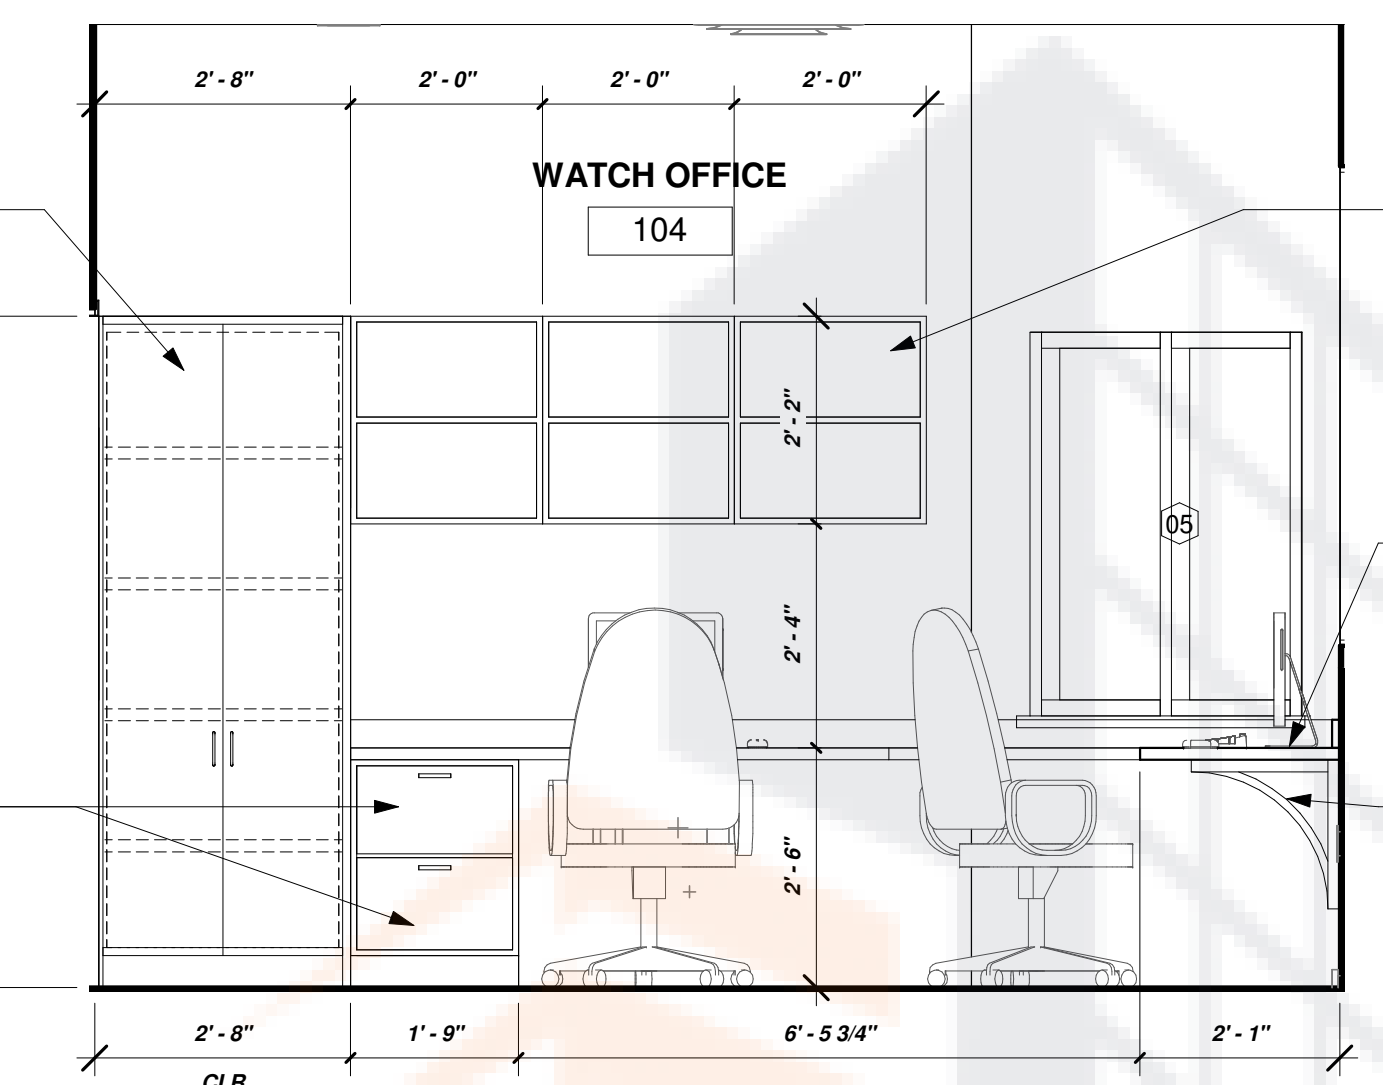


2 OFFICE 104 WEST
1/2" = 1'-0"

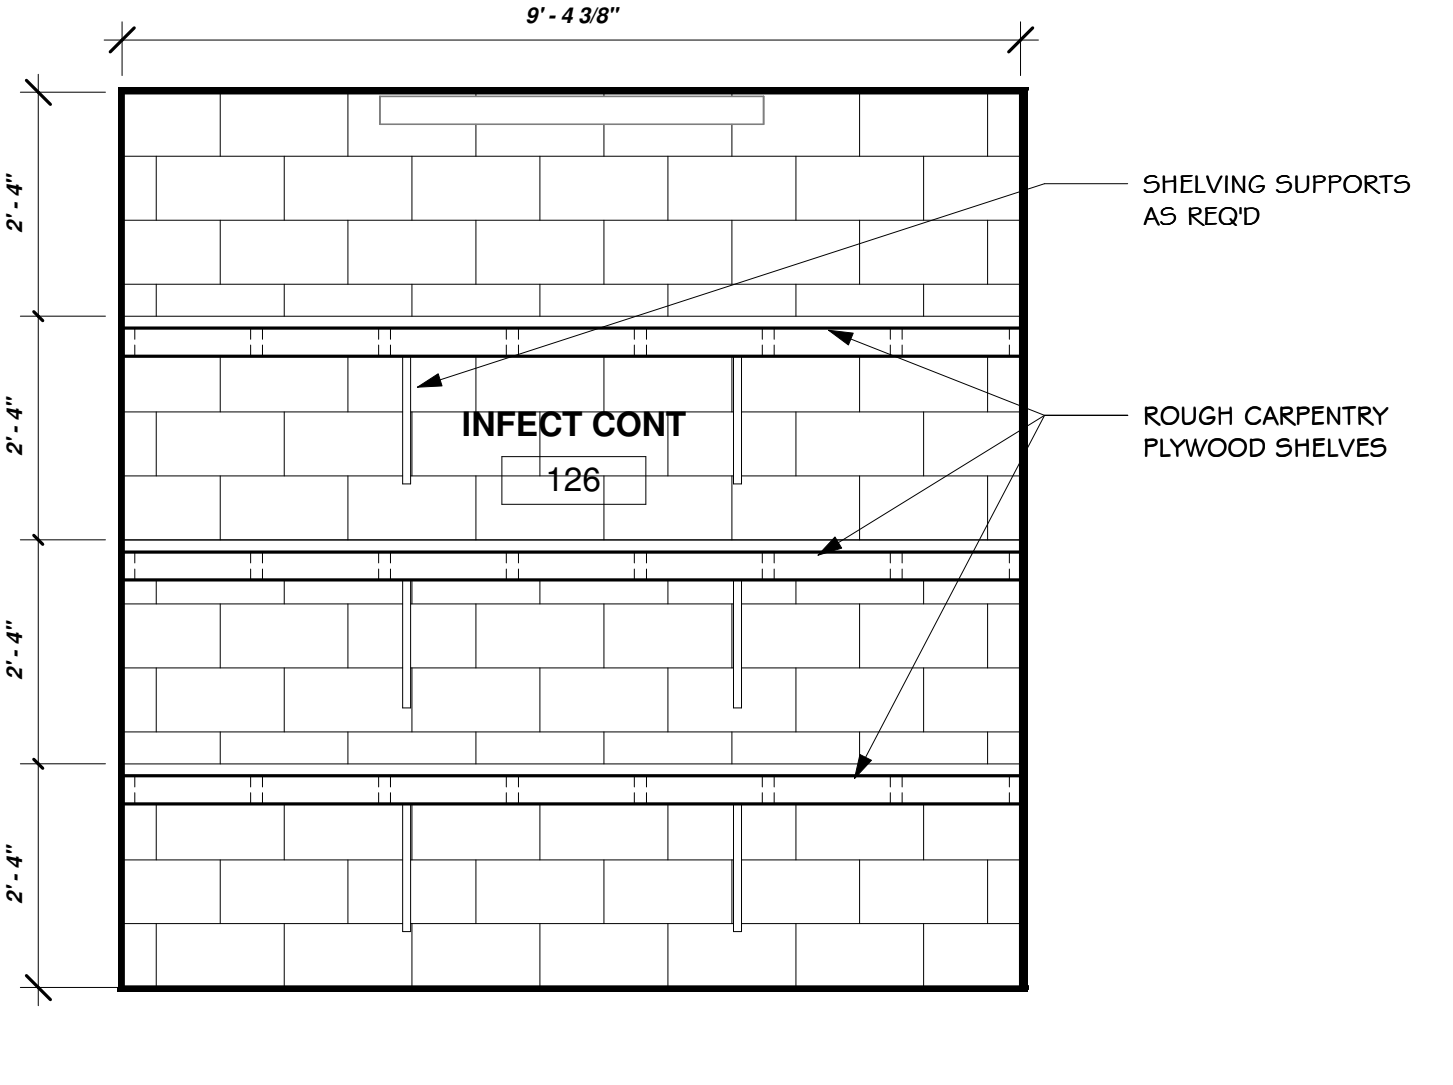


4 INFECT 126 WEST
1/2" = 1'-0"

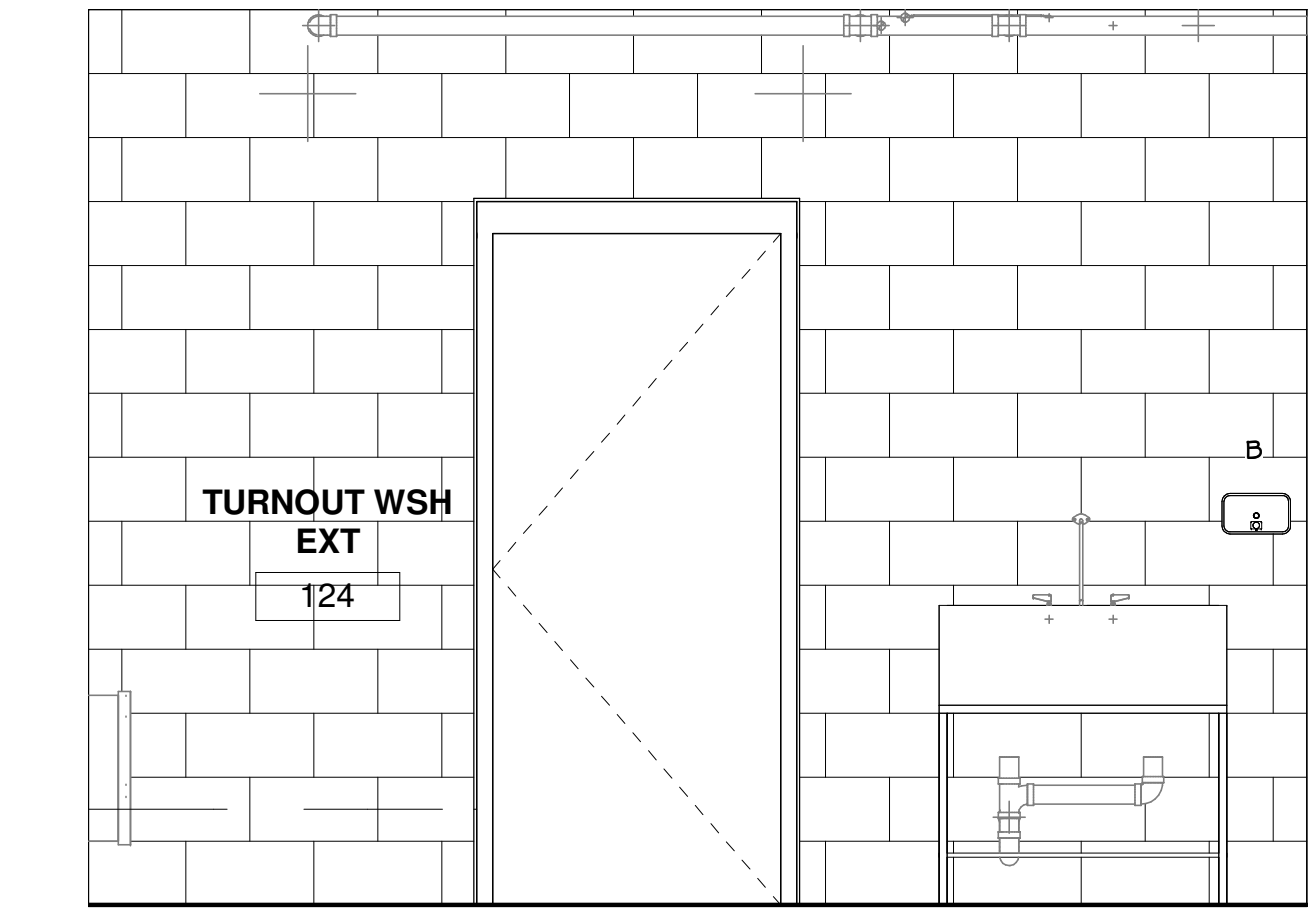

6 TURNOUT 124 WEST
1/2" = 1'-0"

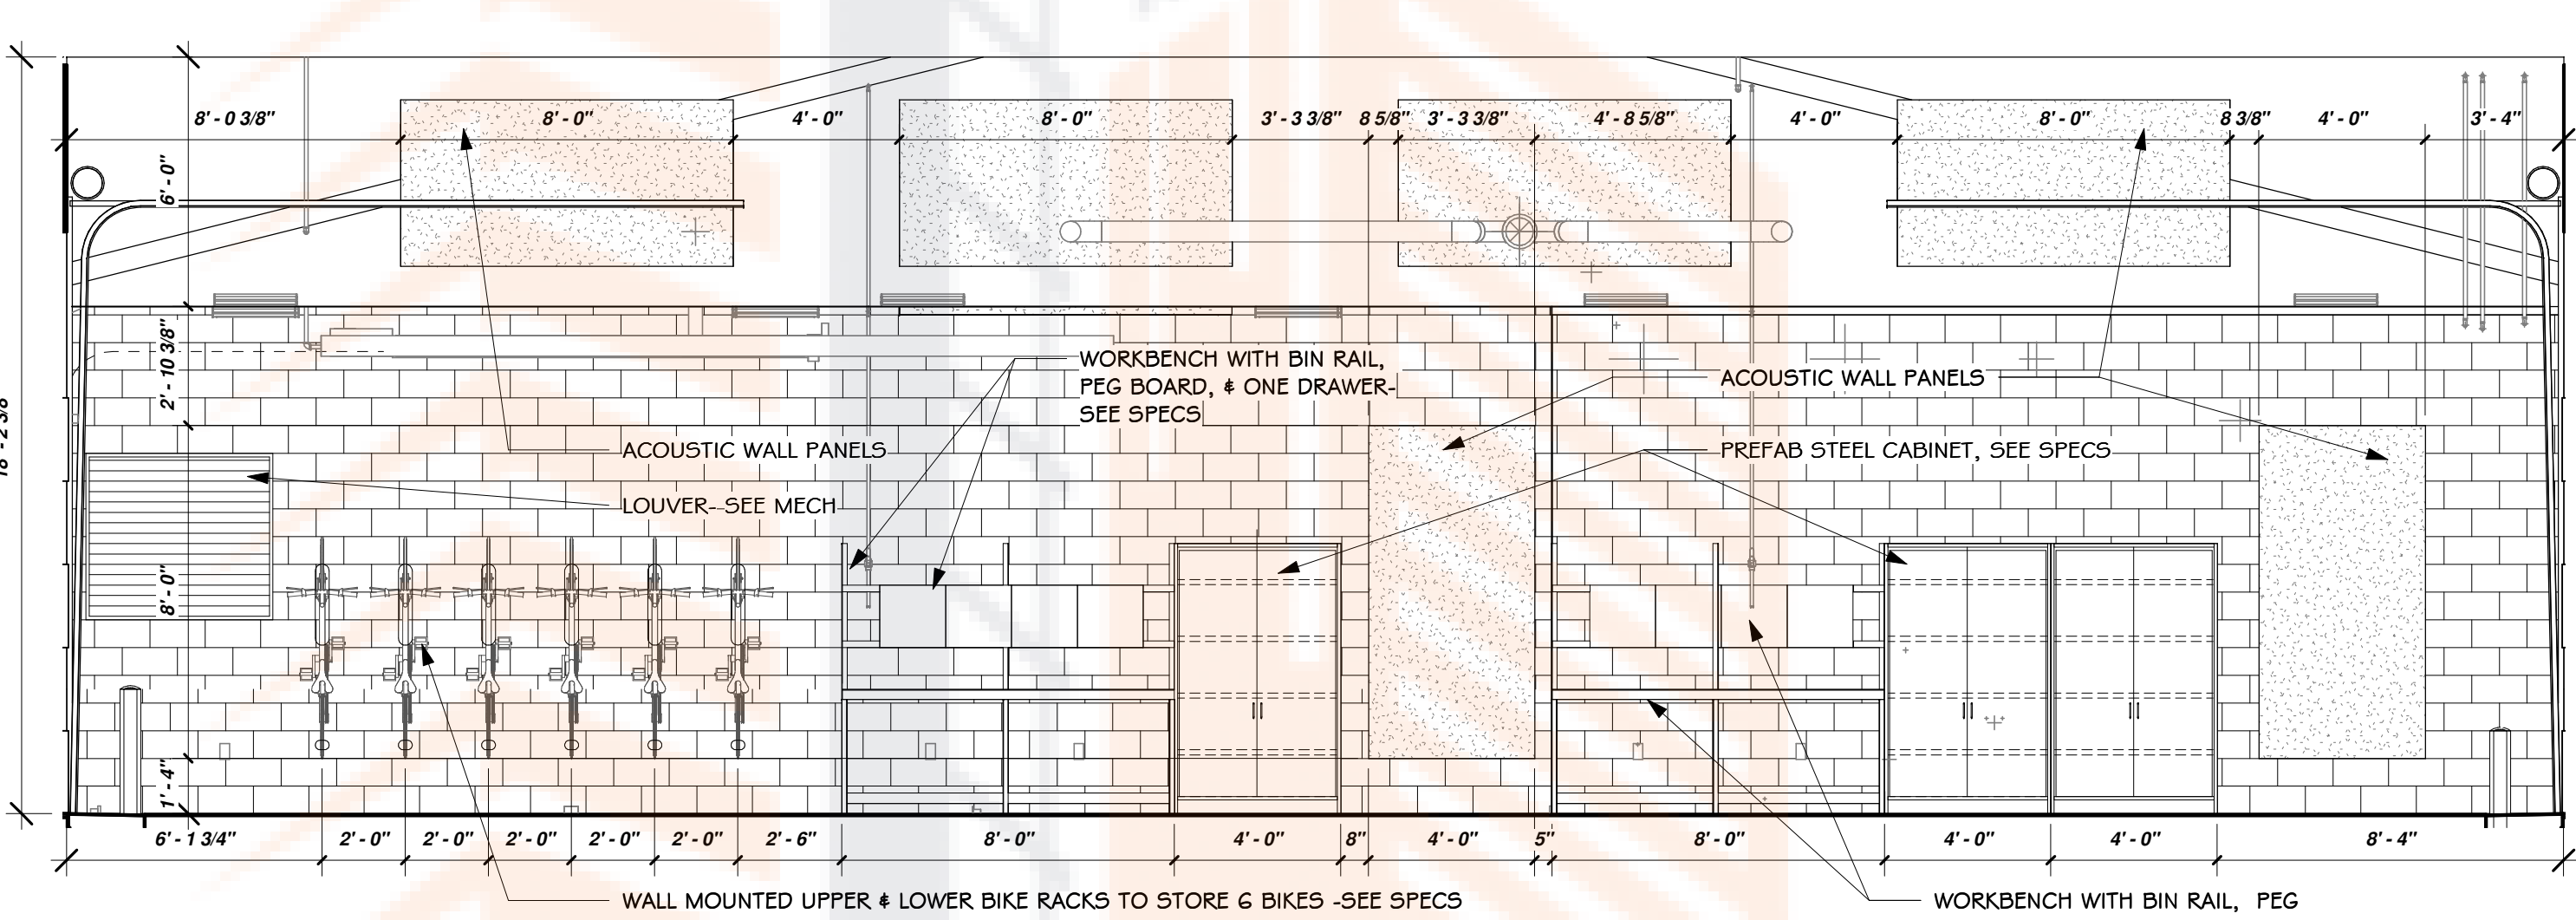

3 APPARATUS 128 SOUTH
1/4" = 1'-0"

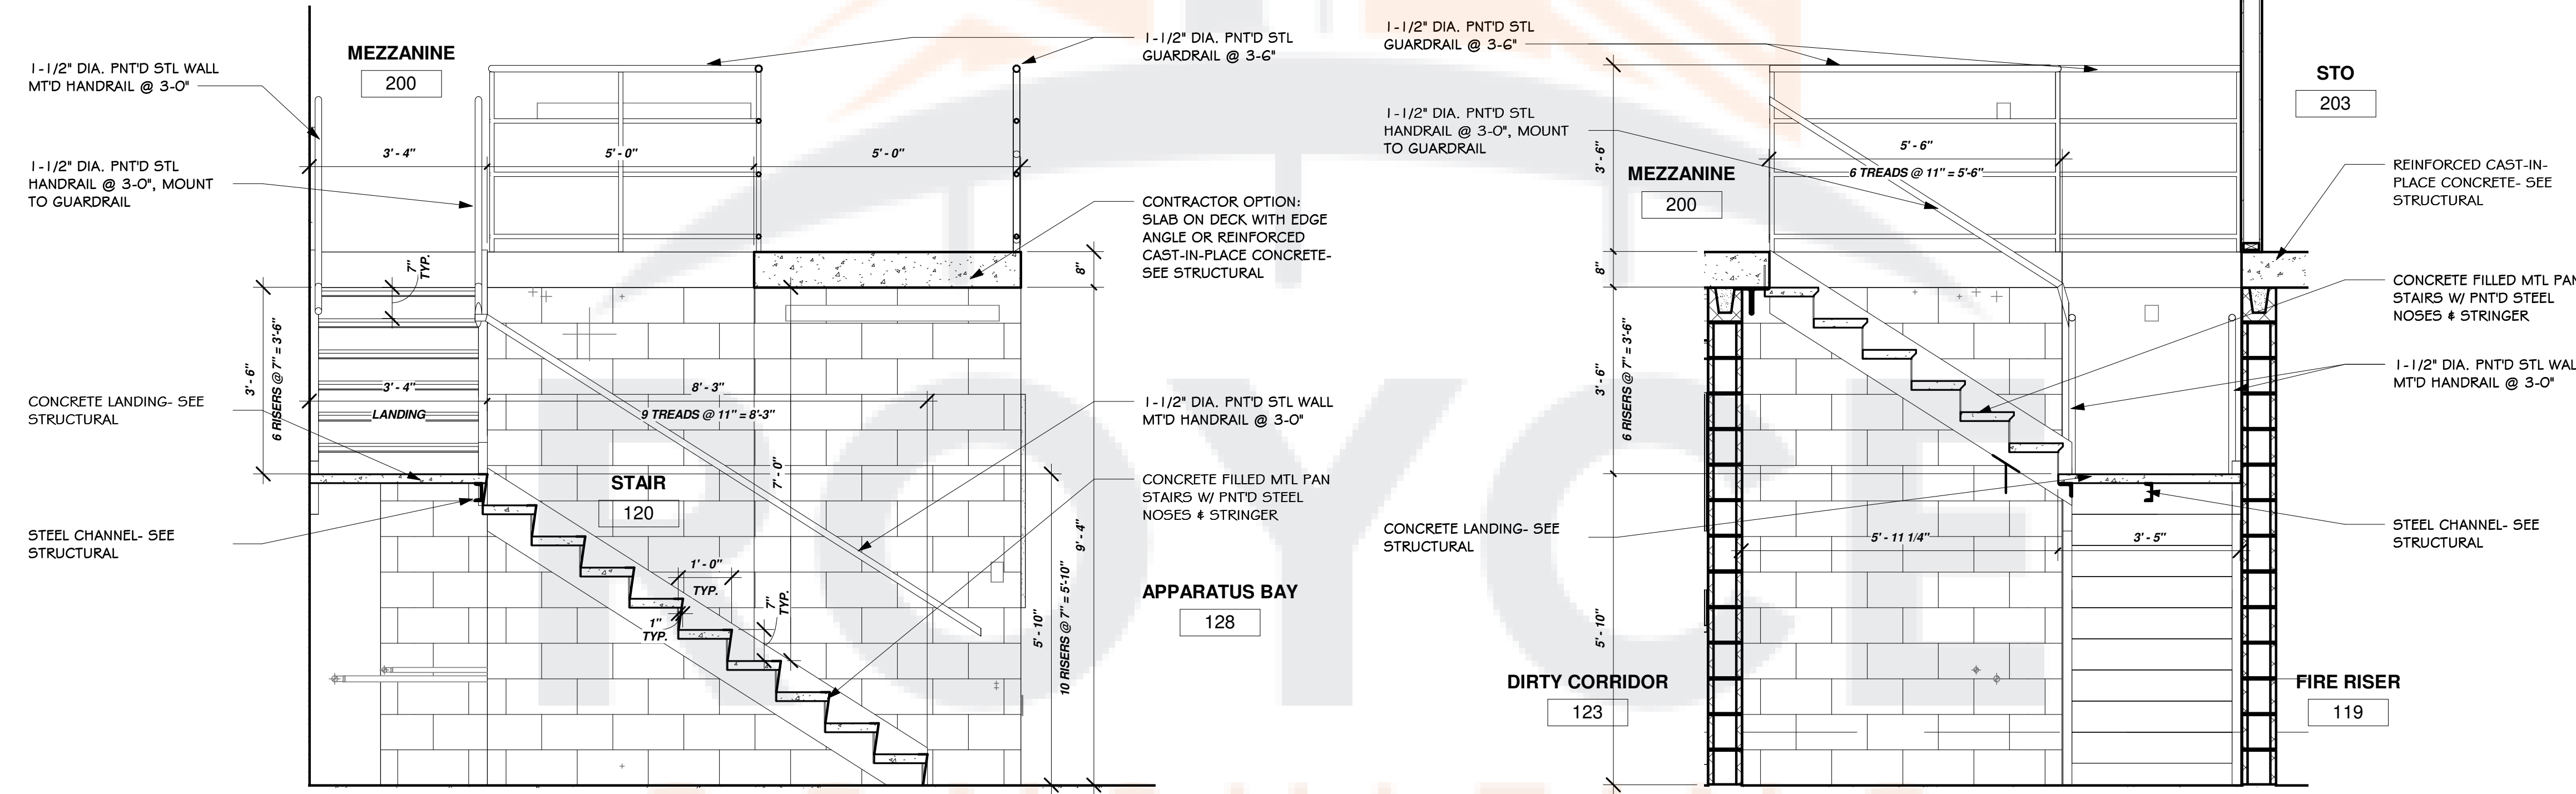

5 STAIR SECTION 1
1/2" = 1'-0"

7 STAIR SECTION 2
1/2" = 1'-0"


General Notes

- PROVIDE FIELD PAINTING OF HANGERS, EXPOSED STEEL, AND IRON WORK, OF PRIMED METAL SURFACES AND EXPOSED-TO-VIEW METAL SURFACES OF ITEMS, AS REQUIRED TO MATCH ADJACENT SURFACES AND EQUIPMENT INSTALLED UNDER MECHANICAL AND ELECTRICAL WORK. THIS INCLUDES BUT IS NOT LIMITED TO, ALL EXPOSED CONDUIT, FIRE SPRINKLER PIPING, HANGERS, DUCTWORK, SUPPORTS, ETC. IF IT CAN BE SEEN, PAINT IT. ARCHITECT TO SELECT COLOR OR COLORS.
- ALL DIMENSIONS ARE TO FACE OF STUD OR BLOCK, U.N.O.
- "C.J." INDICATES CONTROL JOINT. SEE SPECIFICATIONS FOR DESCRIPTION OF METHODS AND LOCATIONS PERTAINING TO REQUIREMENTS.
- CONTRACTOR TO COORDINATE REQUIRED INSTALLATION OF ALL BLOCKING FOR (NOT LIMITED TO) ALL FIXTURES, EQUIP, OR SIGNAGE.
- PROVIDE 3" TALL HELVETICA LETTERS STENCILED AT ALL RATED WALLS, STENCILING TO READ AS FOLLOWS: "FIRE AND SMOKE BARRIER-PROTECT ALL OPENINGS". INCLUDE UL NUMBERS TYPICAL OF ALL RATED WALLS.
- FIRE EXTINGUISHER CABINETS (FEC) ARE TO BE MOUNTED 48" A.F.F. TO THE TOP OF THE CABINET.
- FURNITURE N.I.C. SHOWN FOR REFERENCE ONLY.
- ALL SWITCHES TO BE MOUNTED NO HIGHER THAN 48" A.F.F.
- ALL DOOR HDWR TO MEET ADA REQUIREMENTS
- PROVIDE BLOCKING IN BUNK ROOMS FOR WALL OR CEILING MOUNTED MONITOR. COORDINATE LOCATION WITH OWNER.

ACCESSORIES

A	PAPER TOWEL DISPENSER
A.I	PAPER TOWEL DISPENSER AND RECEPTACLE
B	SOAP DISPENSER (WALL MOUNTED)
B.I	SOAP DISPENSER (COUNTER-MOUNTED)
C	DOUBLE TOILET PAPER DISPENSER
C.I	SINGLE TOILET PAPER DISPENSER
D	36" GRAB BAR (MNT 10-12" FROM REAR WALL)
E	42" GRAB BAR (MNT 6" FROM SIDE WALL)
F	18" VERTICAL GRAB BAR
G	SANITARY NAPKIN EXCHANGE
H	FRAMED MIRROR (24"X42")
J	MIRROR
K	ROBE HOOK
L	24" TOWEL BAR
L.I	18" TOWEL BAR
M	MOP AND BROOM HOLDER
N	NOT USED
N.I	SHOWER DOOR

**NORTH LITTLE ROCK
FIRE DEPARTMENT
STATION 8**

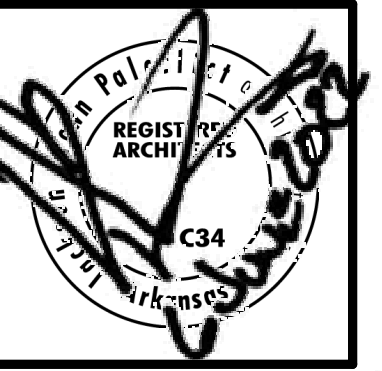

**Jackson
Brown
Palculict
architects**

Date
6/6/22
Revisions

JOB NUMBER 2203

Sheet Title
**INTERIOR
ELEVATIONS
& STAIR
SECTIONS**

Sheet Number
A504

12921 Cantrell Road, Suite 201
Little Rock, AR 72223
501.664.8700 tel
501.664.5189 fax
www.jbparchitects.com

CONSULTING

INTERIOR WALL TYPES

40 WD STUDS @ 16" O.C. PNT'D GYP BOTH SIDES. TAPED FLOATED TO B.O. TRUSS, SAB INSULATION.	41 NOT USED	42 WD STUDS @ 16" O.C. PNT'D GYP BOTH SIDES. TAPED FLOATED TO B.O. TRUSS, NO INSULATION.	43 NOT USED	44 WD STUDS @ 16" O.C. PNT'D GYP ONE SIDE. TAPED FLOATED TO B.O. TRUSS, SAB INSULATION.

INTERIOR WALL TYPES, CMU


20 PNT'D CMU TO 18'-0" REFER TO STRUCTURAL FOR REINFORCEMENT. 1 HR RATED ASSEMBLY	21 PNT'D CMU TO MEZZANINE SLAB. REFER TO STRUCTURAL FOR REINFORCEMENT.	22 PNT'D UL #U905 TO B.O. TRUSS. UL # U305 TO WD DECKING. REFER TO STRUCTURAL FOR REINFORCEMENT. 1 HR RATED ASSEMBLY.	23 PNT'D CMU TO B.O. TRUSS. 2X4 WD STUDS WITH PNT'D GYP ONE SIDE, SAB INSULATION. REFER TO STRUCTURAL FOR REINFORCEMENT. 1 HR RATED ASSEMBLY.

BULLNOSE CMU DETAILS

<p>TYP. OUTSIDE CORNER OF CMU WALL</p>	<p>TYP. DOOR JAMB DETAIL @ CMU WALL SEE DOOR SCHEDULE FOR DOOR PANEL TYPE</p>
--	---

General Notes

NORTH LITTLE ROCK FIRE DEPARTMENT STATION 8

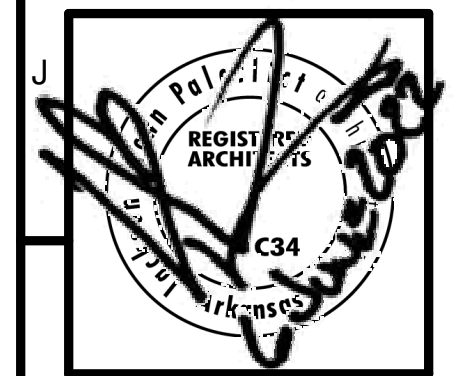

Jackson
Brown
Palculict
architects

Date
6/6/22
Revisions

JOB NUMBER 2203

Sheet Title
**INTERIOR
PARTITIONS**

Sheet Number
A505




Copyright 2019 JBP

12921 Cantrell Road, Suite 201
Little Rock, AR 72223
501.664.8700 tel
501.664.5189 fax
www.jbparchitects.com

Room Schedule						
Number	Name	Floor Finish	Base Finish	Wall Finish	Ceiling Finish	Comments
100	SECURED ENTRY	EC	WD	PGB	STAINED T&G	
101	CORRIDOR	PC	WD	PGB	PGB	
102	CORRIDOR	PC	WD	PGB	PGB	
103	TLT	TILE	TILE	EPGB	PGB	
104	WATCH OFFICE	RTF	WD	PGB	PGB	
105	SUP CLO	SC	WD	PGB	PGB	
106	DAY ROOM	PC	WD	PGB	PGB	
107	DINING	PC	WD	PGB	PGB	
108	KITCHEN	PC	WD	PGB	PGB	
108A	PAN	PC	WD	PGB	PGB	
108B	PAN	PC	WD	PGB	PGB	
108C	PAN	PC	WD	PGB	PGB	
109	JC	SC	WD	PGB	PGB	
110	FITNESS	RUBBER	WD	PGB	PGB	ABUSE RESISTANT GYP TO 4'-0" @ ALL WALLS
111	LAUNDRY	PC	WD	PGB	PGB	
112	MDF/ELEC	SC	WD	PGB	PGB	
113	TLT	TILE	TILE	EPGB, TILE	PGB, EPGB @ SHOWER	
114	BUNK ROOM	RTF	WD	PGB	PGB	
115	BUNK ROOM	RTF	WD	PGB	PGB	
116	BUNK ROOM	RTF	WD	PGB	PGB	
117	TLT	TILE	TILE	EPGB, TILE	PGB, EPGB @ SHOWER	
118	BUNK ROOM	RTF	WD	PGB	PGB	
119	FIRE RISER	SC	N/A	PCMU	PNT'D STRUCTURE	
120	STAIR	SC	N/A	PCMU	PNT'D STRUCTURE	
121	TLT	SC	N/A	EPCMU	PNT'D STRUCTURE	
122	DECON SWR	SC	N/A	EPCMU	E PNT'D STRUCTURE	
123	DIRTY CORRIDOR	SC	N/A	EPCMU	E PNT'D STRUCTURE	
124	TURNOUT WSH EXT	SC	N/A	EPCMU	E PNT'D STRUCTURE	
125	TURNOUT SAFEROOM	SC	N/A	PCMU	PNT'D STRUCTURE	
126	INFECT CONT	SC	N/A	PCMU	PNT'D STRUCTURE	
127	CLEAN CORRIDOR	SC	N/A	PCMU	PNT'D STRUCTURE	
128	APPARATUS BAY	SC	N/A	PCMU, PGB	PGB	
129	BATT OFFICE	RTF	WD	PGB	ACT	
130	BATT BUNK	RTF	WD	PGB	ACT	
131	BATT TLT	TILE	TILE	EPGB, TILE	ACT, EPGB @ SHOWER	
200	MEZZANINE	SC	NONE @ CMU, WD @ GYP	PCMU	PGB	
201	MECHANICAL	SC	N/A	PGB	PGB	
202	IT	SC	N/A	PGB	PGB	
203	STO	SC	WD	PGB	PGB	

Door Schedule										
Mark	Width	Head Height	*Material	Door Type	Frame Type	Fire Rating	Hardware	Access Controls	Comments	
100A	3'-0"	7'-0"	PFA	1	01.A		1	X		
100B	3'-0"	7'-0"	SCW	2	B		2	X		REMOTE BUTTON IN WATCH OFFICE
102A	3'-0"	7'-0"	SCW	2	B		8			
102B	3'-0"	7'-0"	PFA	1	A		1	X		OPAQUE GLASS
103A	3'-0"	7'-0"	SCW	2	B		5			
104A	3'-0"	7'-0"	SCW	5	B		4			
104B	3'-0"	7'-0"	SCW	5	B		4			
105A	3'-0"	7'-0"	SCW	2	B		7			
107A	3'-0"	7'-0"	PFA	1	A		1	X		
108A	2'-6"	7'-0"	LFD	3	C		11			DRY ERASE LAMINATE
108B	2'-6"	7'-0"	LFD	3	C		11			DRY ERASE LAMINATE
108C	2'-6"	7'-0"	LFD	3	C		11			DRY ERASE LAMINATE
109A	2'-8"	7'-0"	SCW	4	D		11			
110A	3'-0"	7'-0"	SCW	5	B		8			WITH HALF LITE
111A	3'-0"	7'-0"	SCW	2	B		11			
112A	3'-0"	7'-0"	SCW	2	B		7			
113A	2'-8"	7'-0"	SCW	4	D		5			
114A	3'-0"	7'-0"	SCW	2	B		6			
115A	3'-0"	7'-0"	SCW	2	B		6			
116A	3'-0"	7'-0"	SCW	2	B		6			
117A	2'-8"	7'-0"	SCW	4	D		5			
118A	3'-0"	7'-0"	SCW	2	B		6			
119A	3'-0"	7'-0"	PHM	7	E		7			LOUVER IN DOOR
121A	3'-0"	7'-0"	SCW	2	E		5			
122A	3'-0"	7'-0"	SCW	2	E		5			
123A	3'-0"	7'-0"	SCW	6	E	45 MIN C	3			VISION PANEL
123B	3'-0"	7'-0"	PHM	8	E		3			
124A	3'-0"	7'-0"	SCW	2	E		8			
125A	3'-0"	7'-0"	FEMA	9	F		10			
126A	6'-0"	7'-0"	SCW	10	G		12			
127A	3'-0"	7'-0"	SCW	6	E	45 MIN C	3			
127B	3'-0"	7'-0"	PHM	8	E		3			
128A	3'-0"	7'-0"	PFA	1	A		1	X		
128B	3'-0"	7'-0"	PFA	1	A		1	X		
128C	3'-0"	7'-0"	PFA	1	A		1	X		
129A	3'-0"	7'-0"	PHM	8	E	45 MIN C	3			
130A	3'-0"	7'-0"	SCW	2	B		6			
131A	2'-8"	7'-0"	SCW	4	B		5			
201A	3'-0"	7'-0"	PHM	7	D	45 MIN C	13			
202A	3'-0"	7'-0"	SCW	7	B		7			
203A	3'-0"	7'-0"	PHM	2	B		7			

*DOOR MATERIAL KEY:
PFA PREFINISHED ALUMINUM
SCW SOLID CORE WOOD
LFD HIGH PRESSURE LAMINATE DECORATIVE FACED DOOR

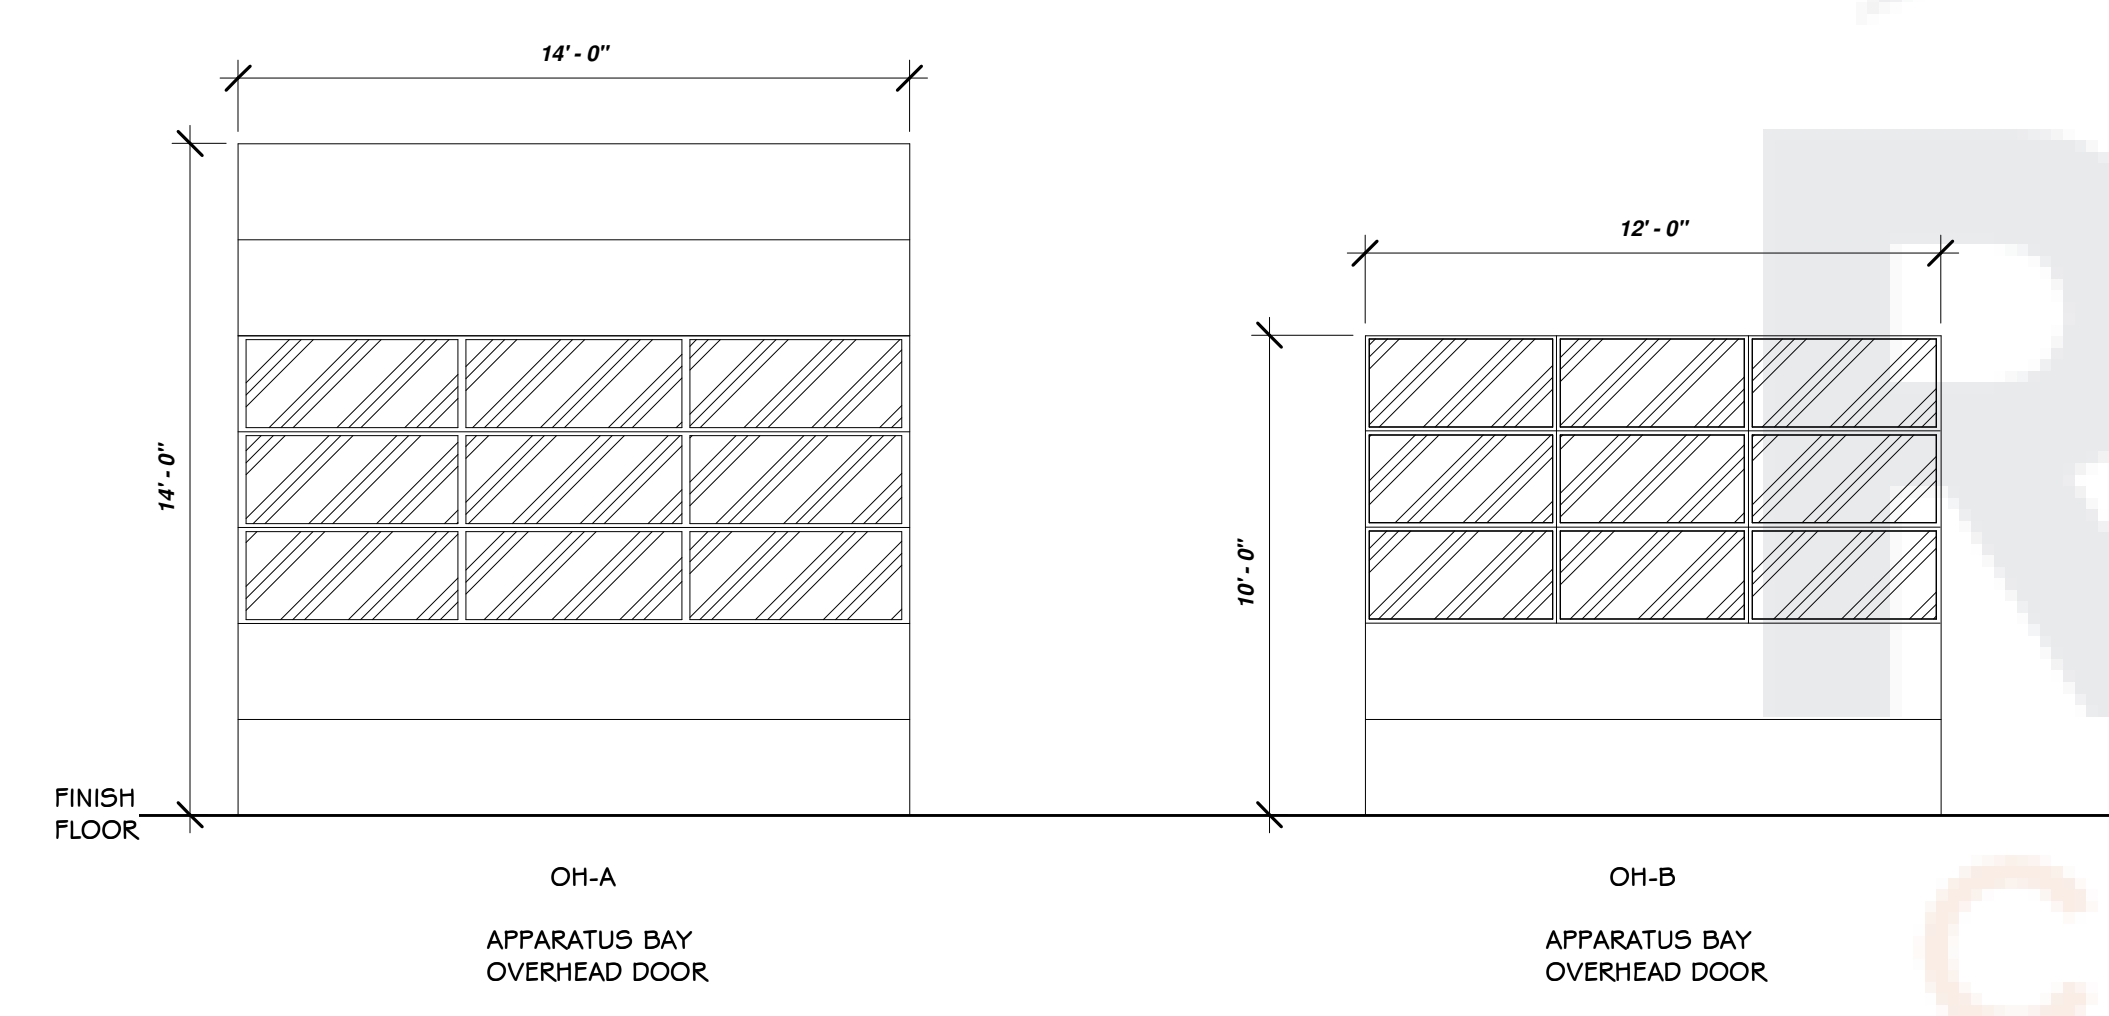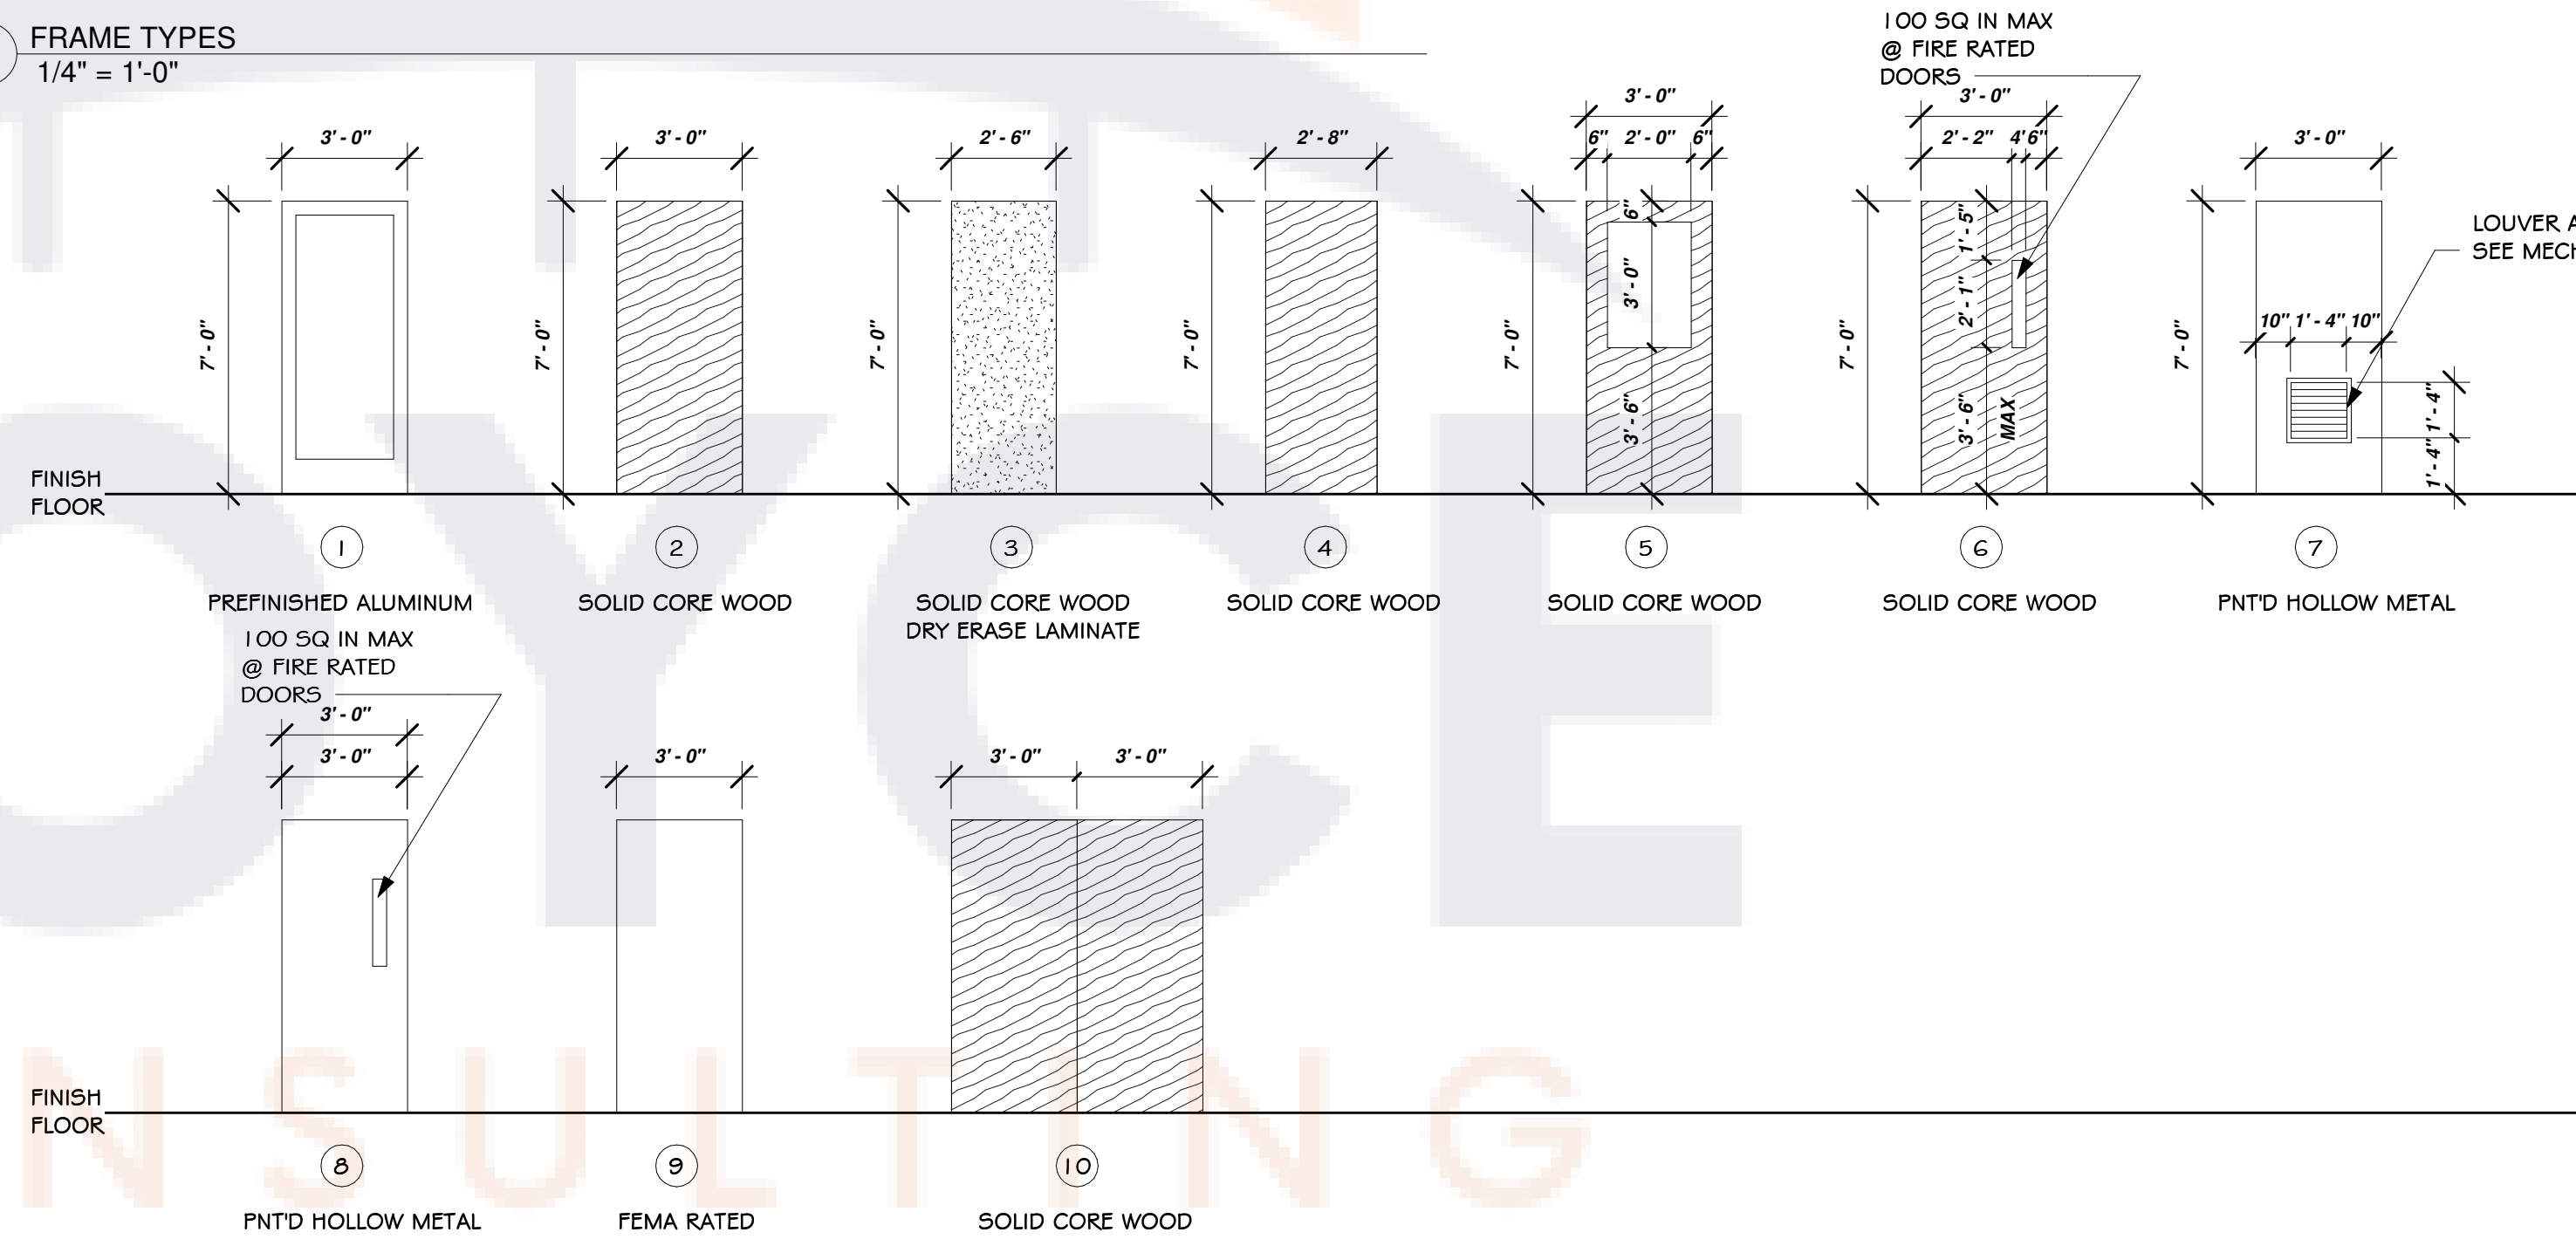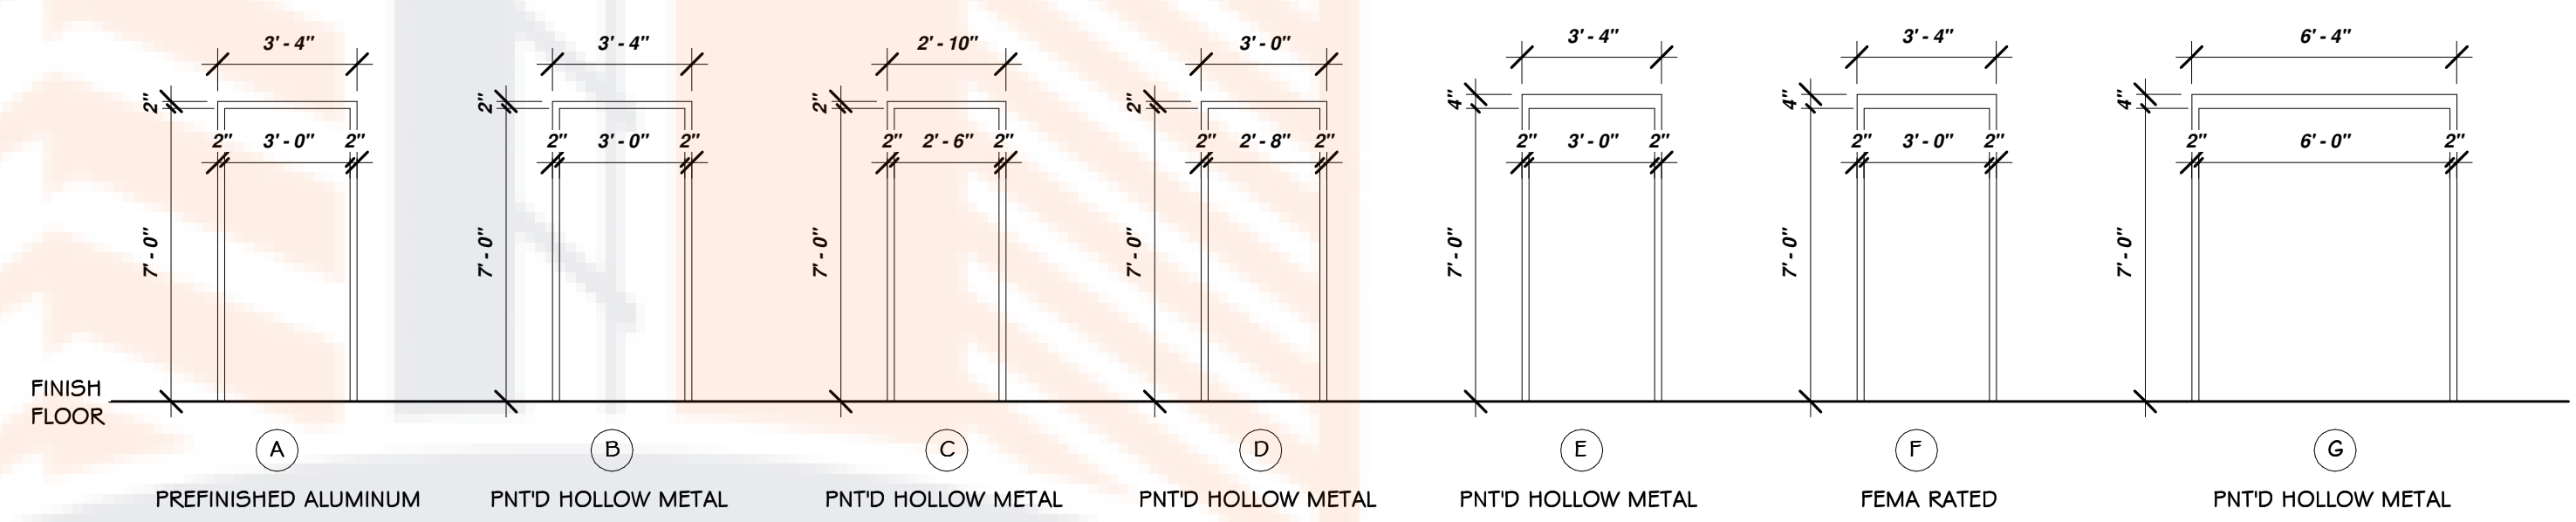


OH DOORS
1/4" = 1'-0"

DOOR TYPES
1/4" = 1'-0"

General Notes

**NORTH LITTLE ROCK
FIRE DEPARTMENT
STATION 8**

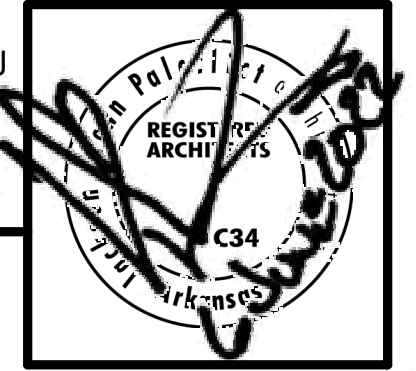


Jackson
Brown
Palculict
architects

Date
6/6/22
Revisions

Sheet Title
**DOOR &
FINISH
SCHEDULE**


Sheet Number
A601

12921 Cantrell Road, Suite 201
Little Rock, AR 72223
501.664.8700 tel
501.664.5189 fax
www.jbpaarchitects.com

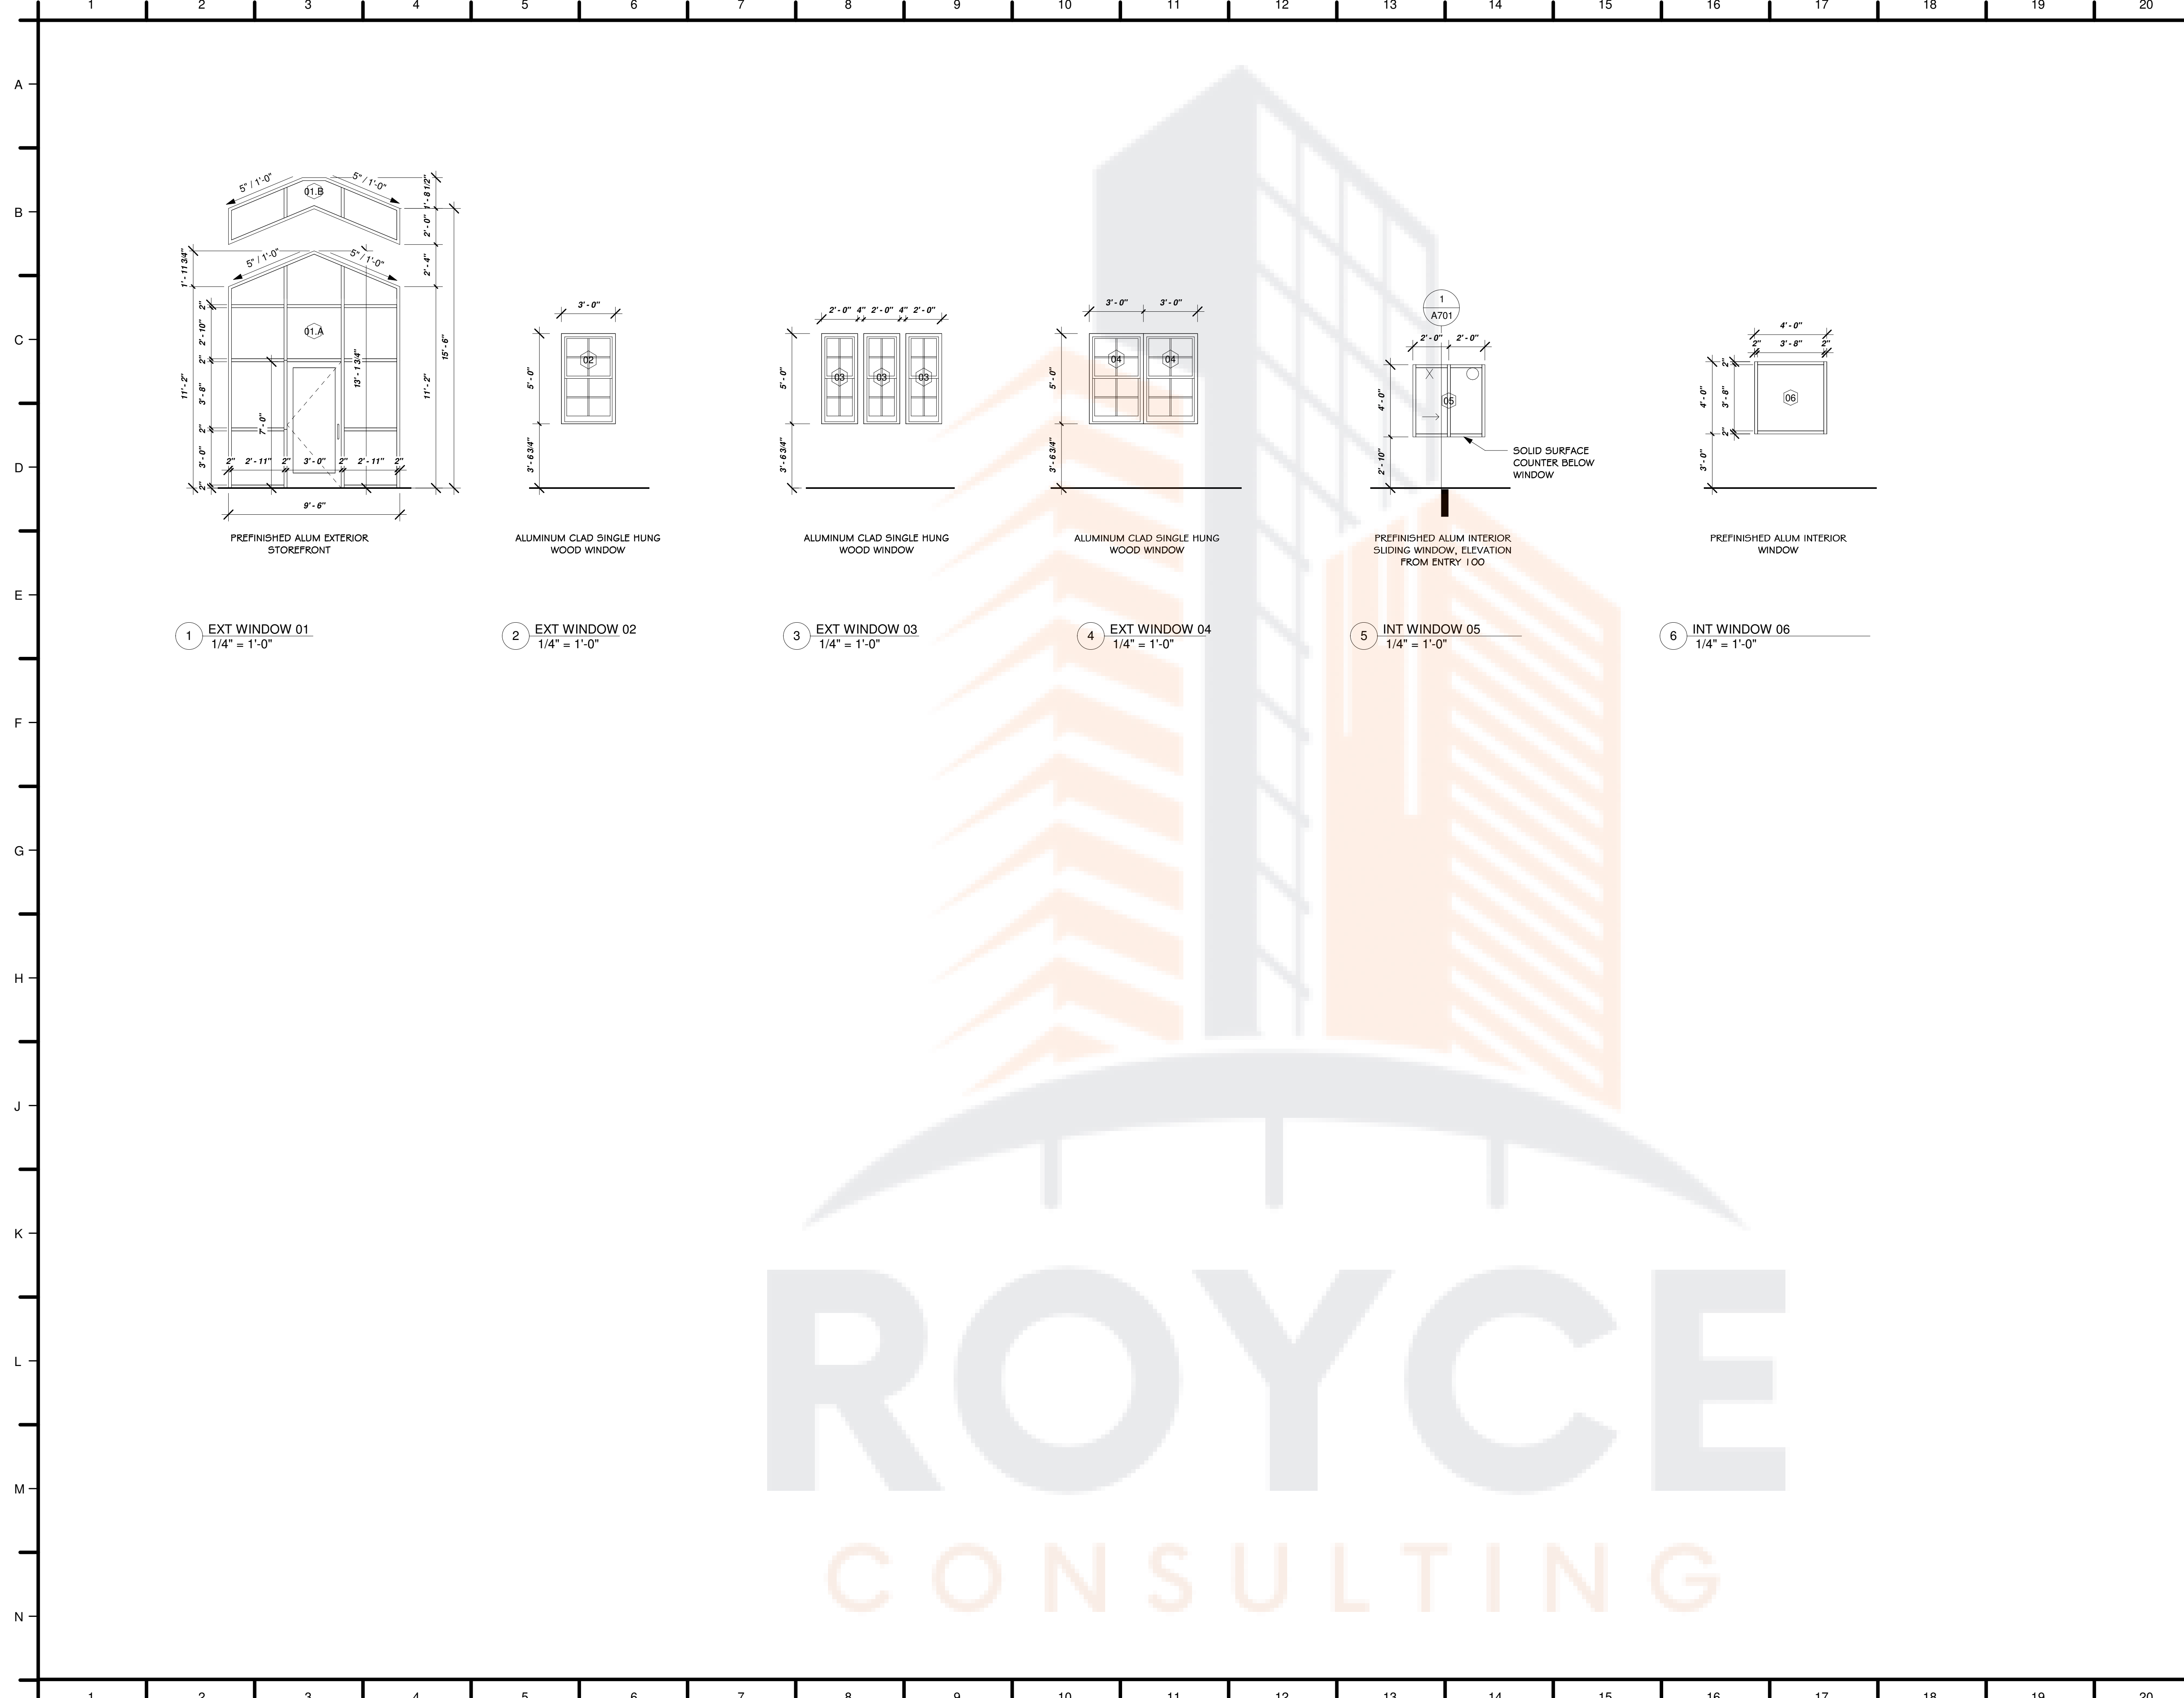

- General Notes
1. ALL DOOR HDWR TO MEET THE ADA REQUIREMENTS
 2. PROVIDE FIELD PAINTING OF HANGERS, EXPOSED STEEL, AND IRON WORK, OF PRIMED METAL SURFACES AND EXPOSED-TO-VIEW METAL SURFACES OF ITEMS, AS REQUIRED TO MATCH ADJACENT SURFACES AND EQUIPMENT INSTALLED UNDER MECHANICAL AND ELECTRICAL WORK. THIS INCLUDES BUT IS NOT LIMITED TO, ALL EXPOSED CONDUIT, FIRE SPRINKLER PIPING, HANGERS, DUCTWORK, SUPPORTS, ETC. IF IT CAN BE SEEN, PAINT IT. ARCHITECT TO SELECT COLOR OR COLORS
 3. CONTRACTOR TO COORDINATE REQUIRED INSTALLATION OF ALL BLOCKING AND SHIMMING FOR (NOT LIMITED TO) ALL DOORS, FIXTURES, EQUIP, OR MILLWORK.
 4. ALL GLAZING LOCATED 1'8" FROM FLOOR AND 2'4" FROM ALL DOORS NEEDS TO BE SAFETY RATED PER CODE.

**NORTH LITTLE ROCK
FIRE DEPARTMENT
STATION 8**

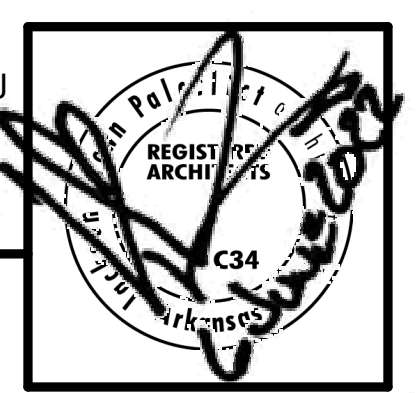

**Jackson
Brown
Palculict
architects**

Date
6/6/22
Revisions


JOB NUMBER 2203

Sheet Title
**WINDOW
ELEVATIONS**


Sheet Number
A602

12921 Cantrell Road, Suite 201
Little Rock, AR 72223
501.664.8700 tel
501.664.5189 fax
www.jbpaarchitects.com


**ROYCE
CONSULTING**

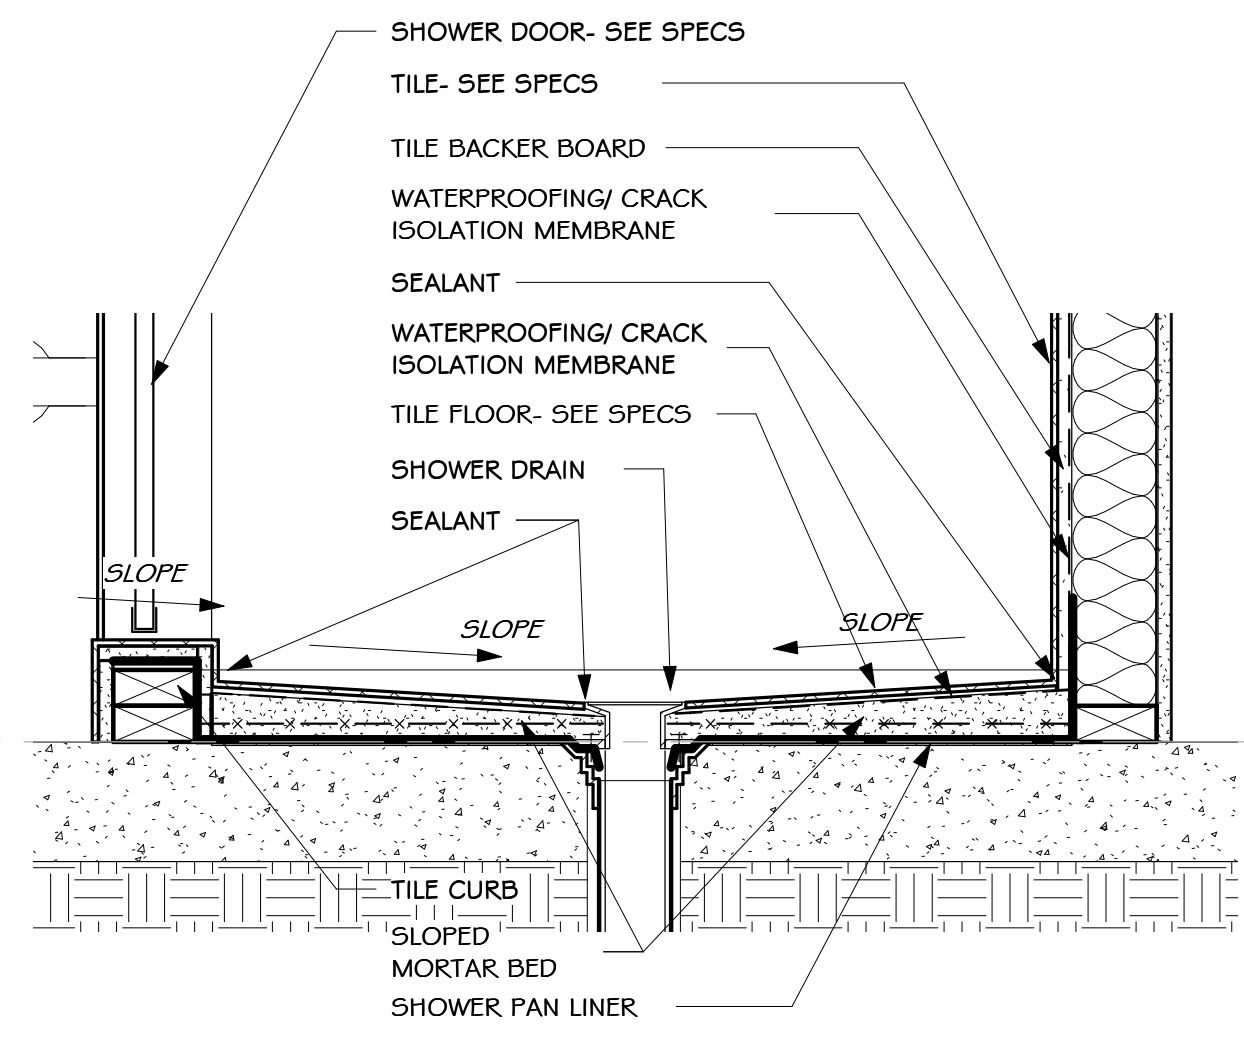


3 SHOWER DETAIL
1 1/2" = 1'-0"

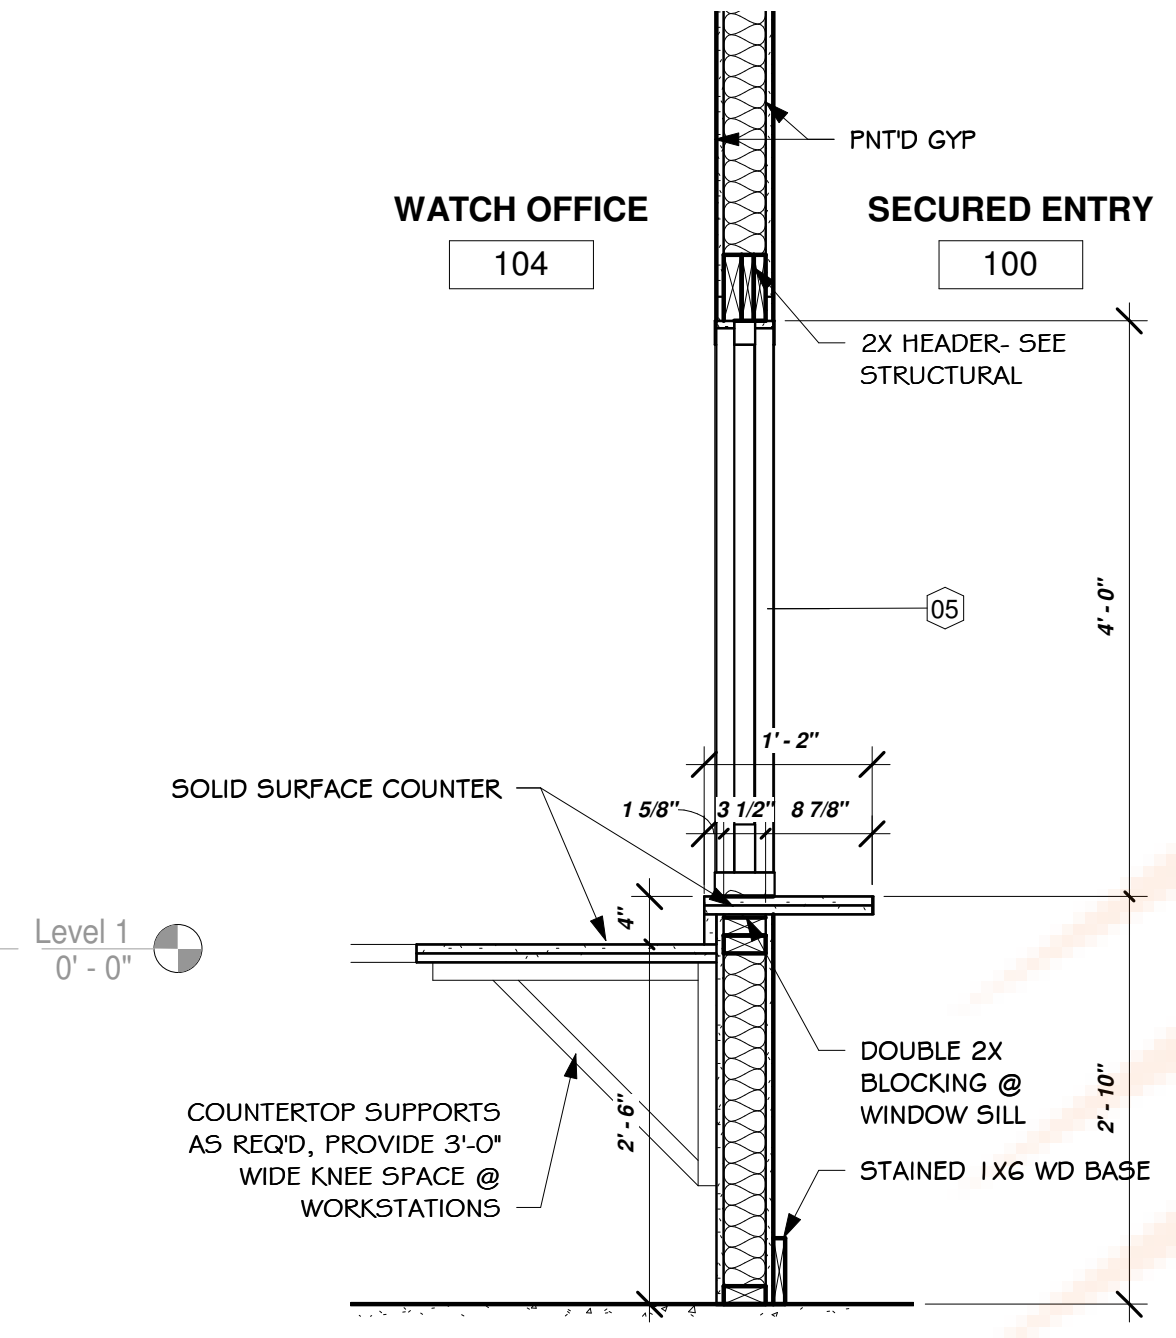


1 WATCH ROOM WINDOW
3/4" = 1'-0"

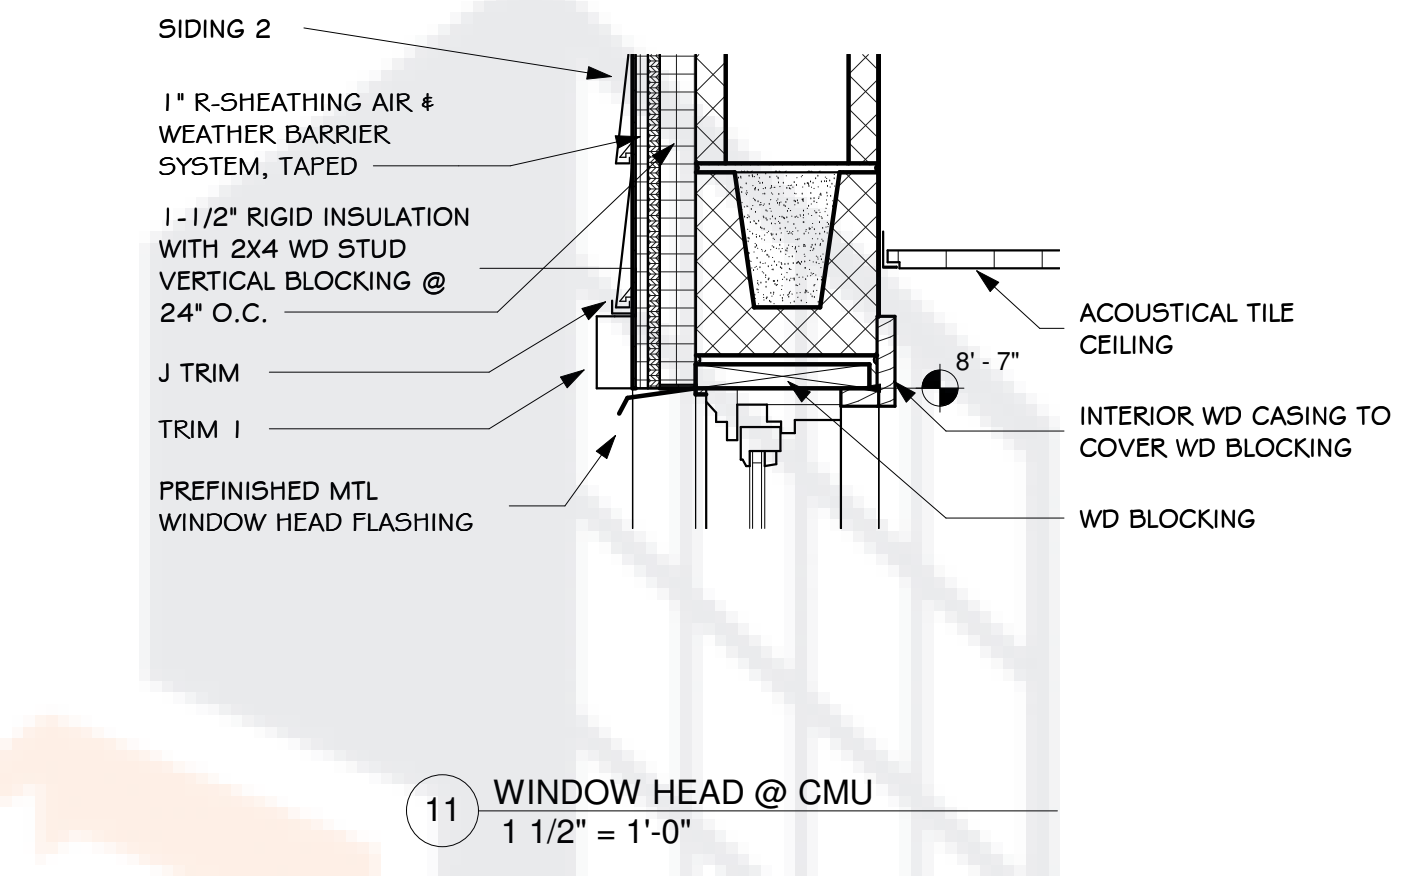


11 WINDOW HEAD @ CMU
1 1/2" = 1'-0"

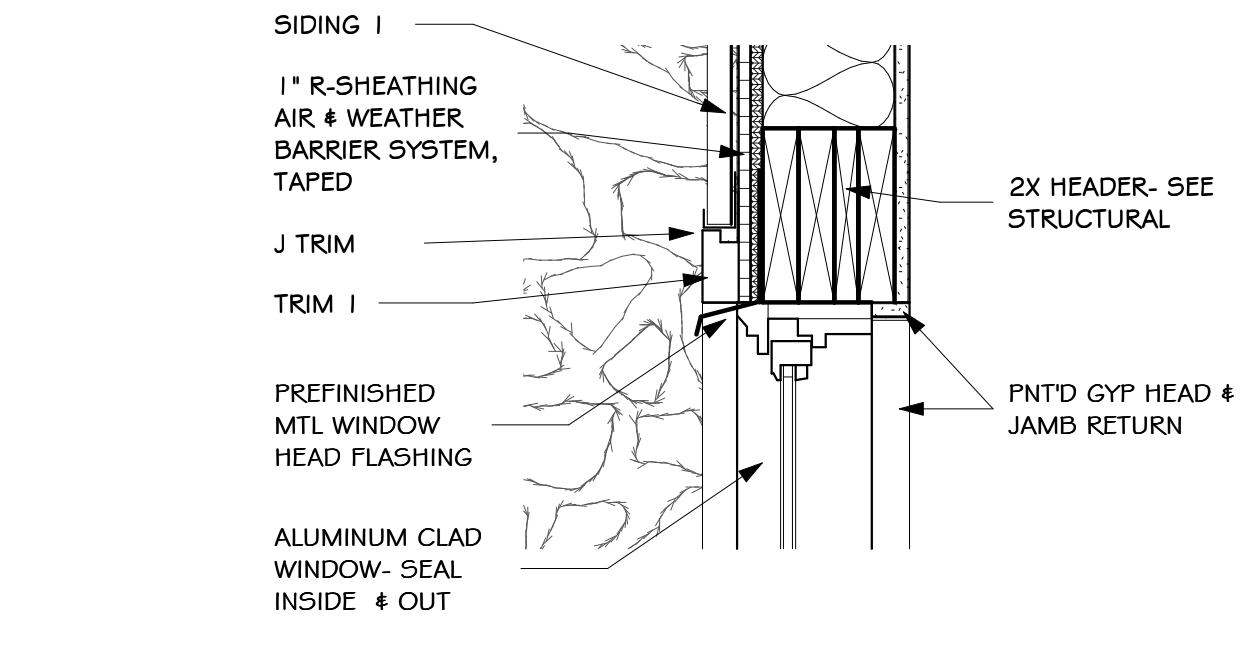


7 WINDOW HEAD
1 1/2" = 1'-0"

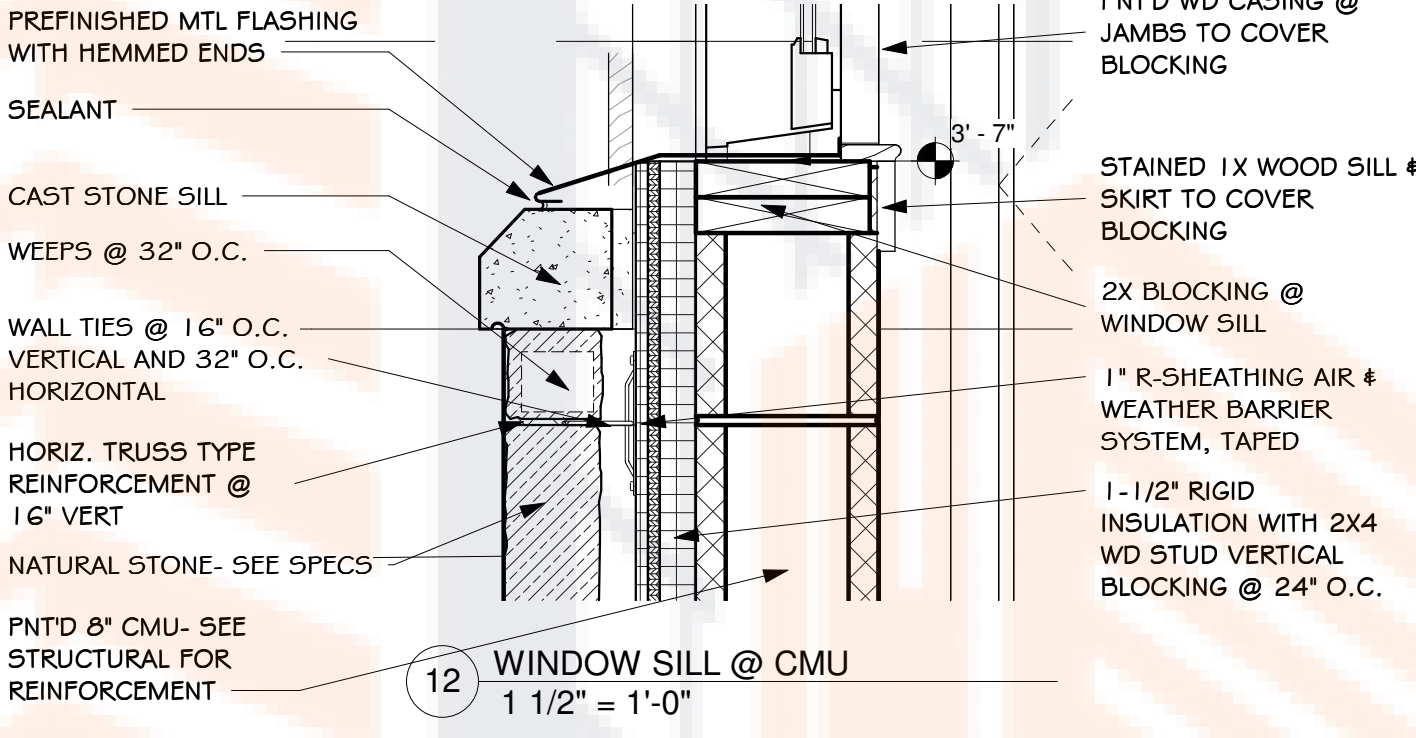


12 WINDOW SILL @ CMU
1 1/2" = 1'-0"

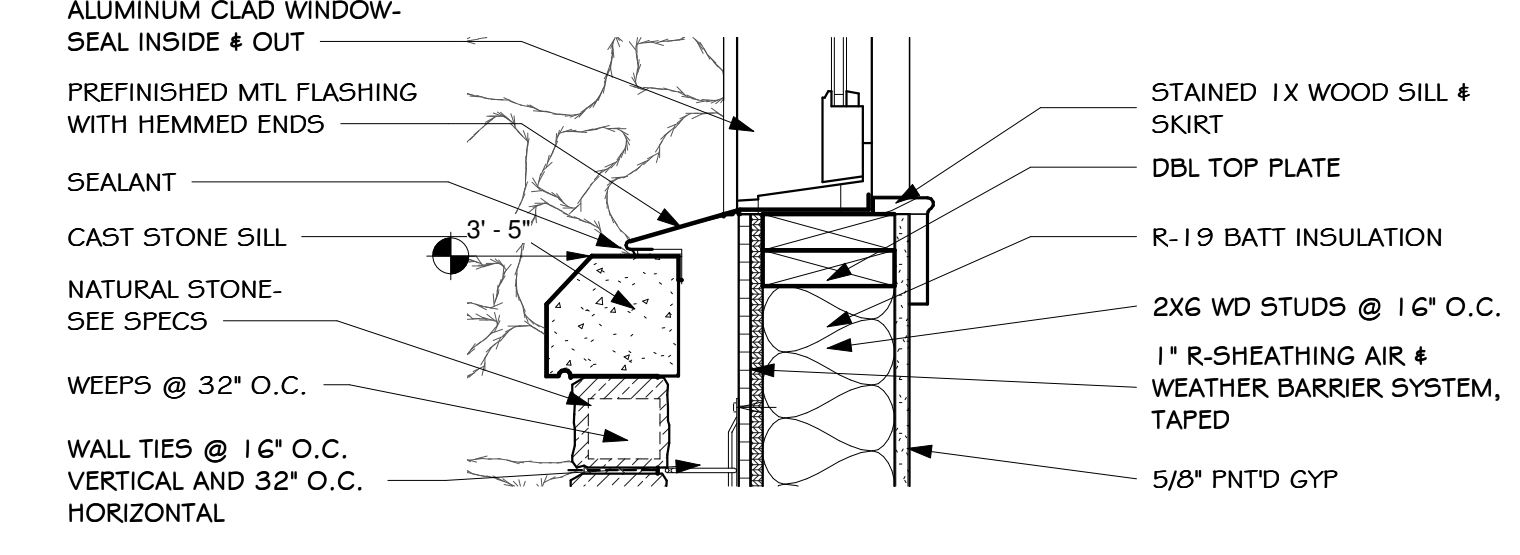


8 WINDOW SILL
1 1/2" = 1'-0"

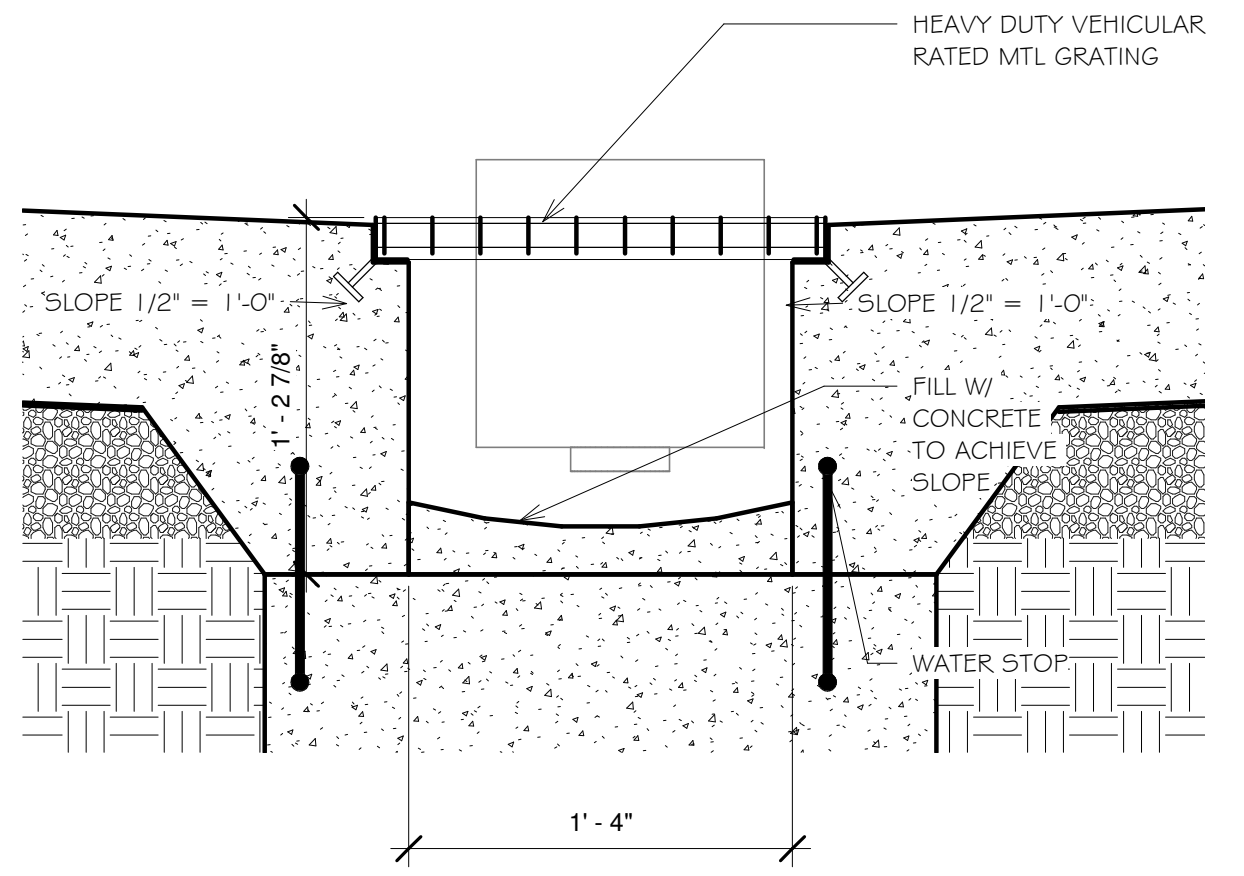


2 APPARATUS TRENCH DRAIN
1 1/2" = 1'-0"

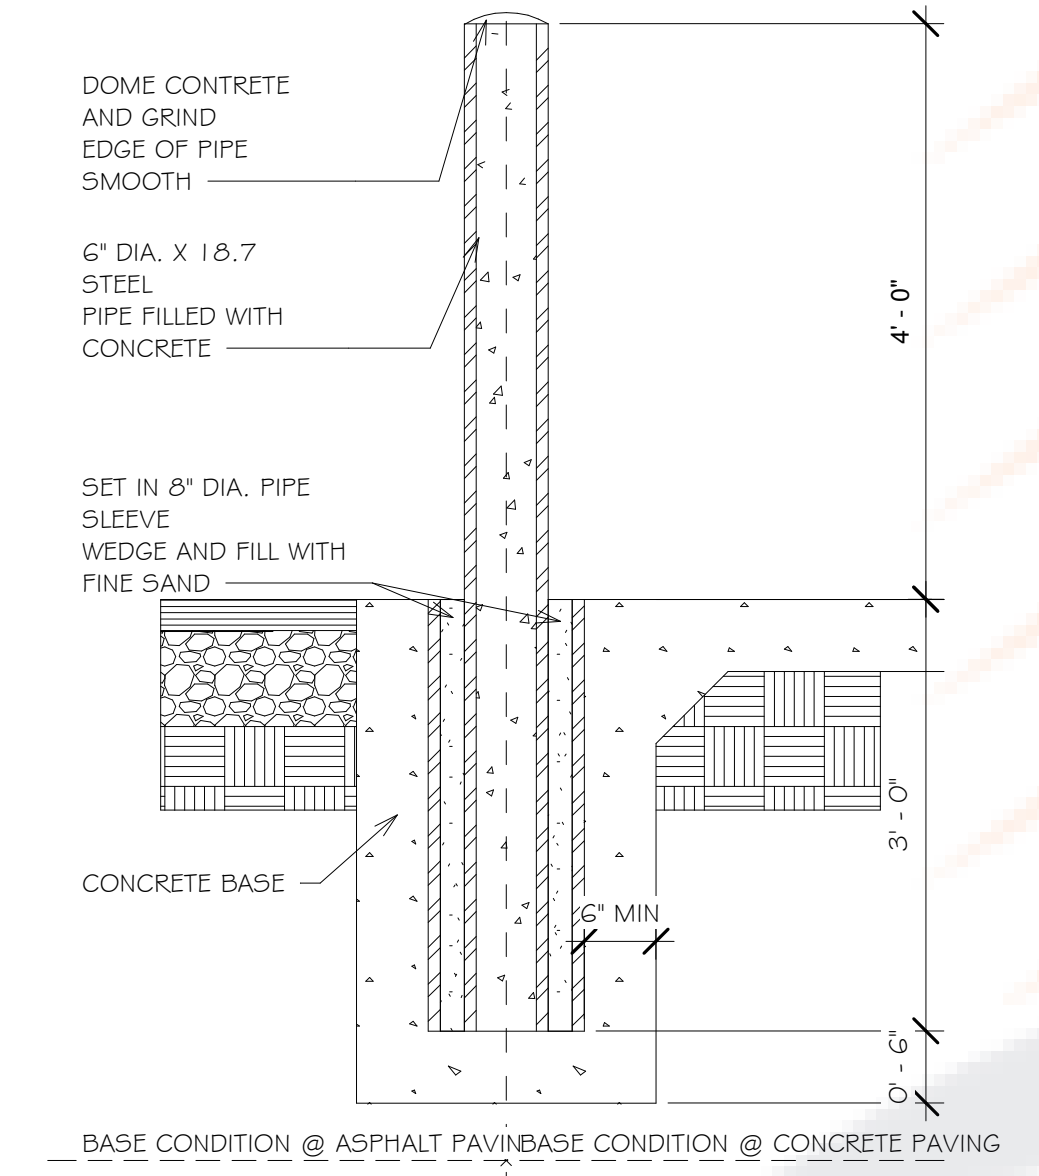


4 TYP BOLLARD DETAIL
3/4" = 1'-0"

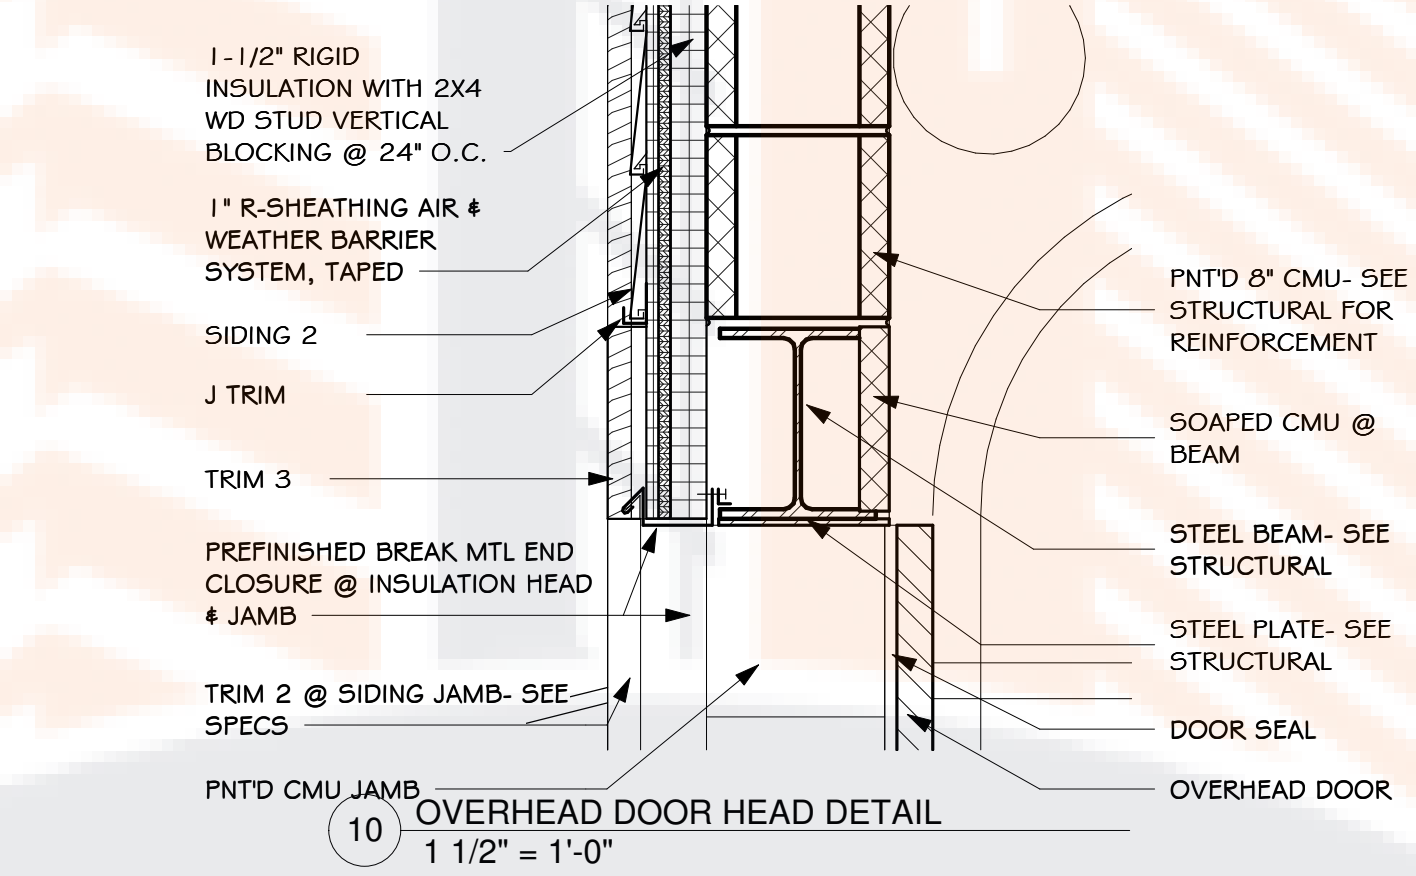


10 OVERHEAD DOOR HEAD DETAIL
1 1/2" = 1'-0"

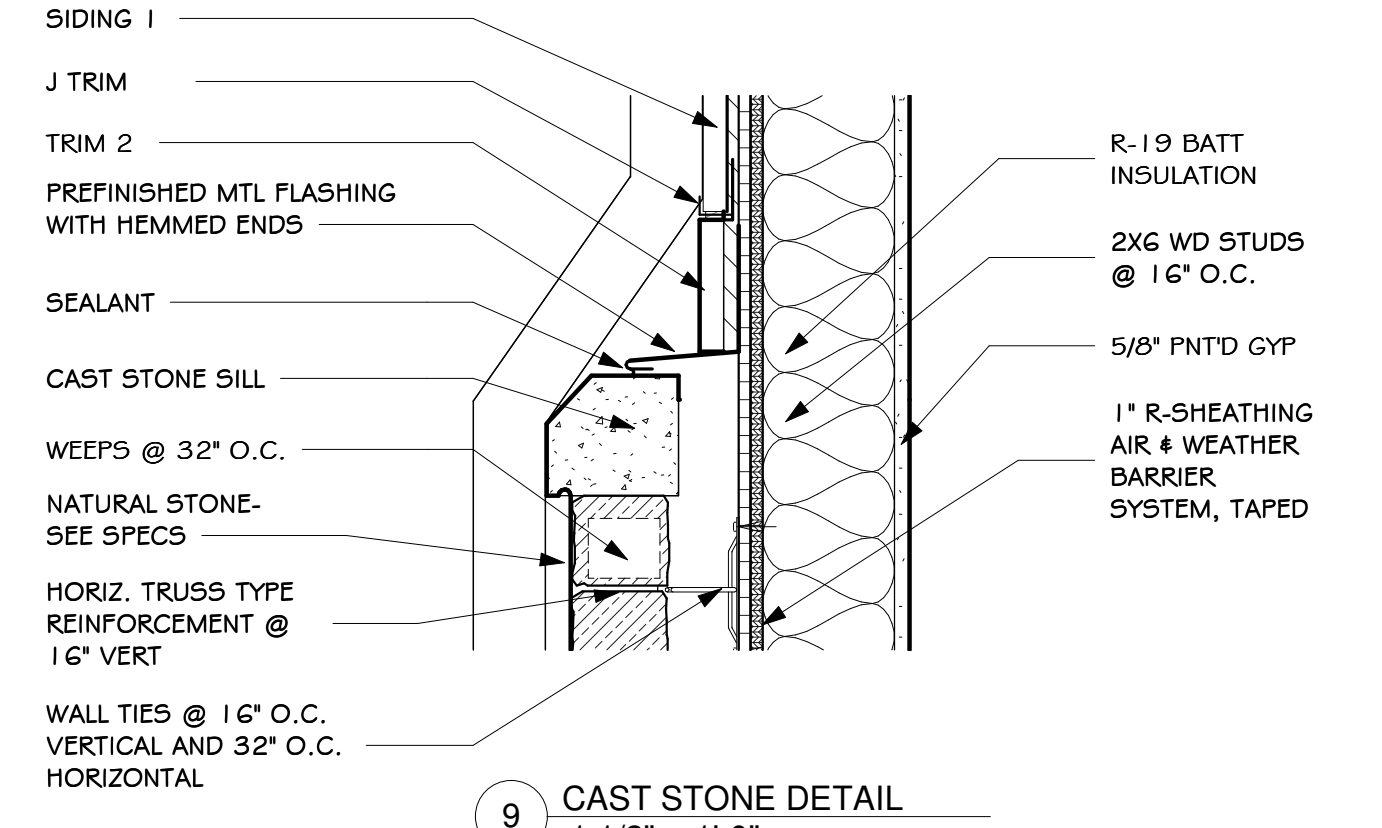


9 CAST STONE DETAIL
1 1/2" = 1'-0"

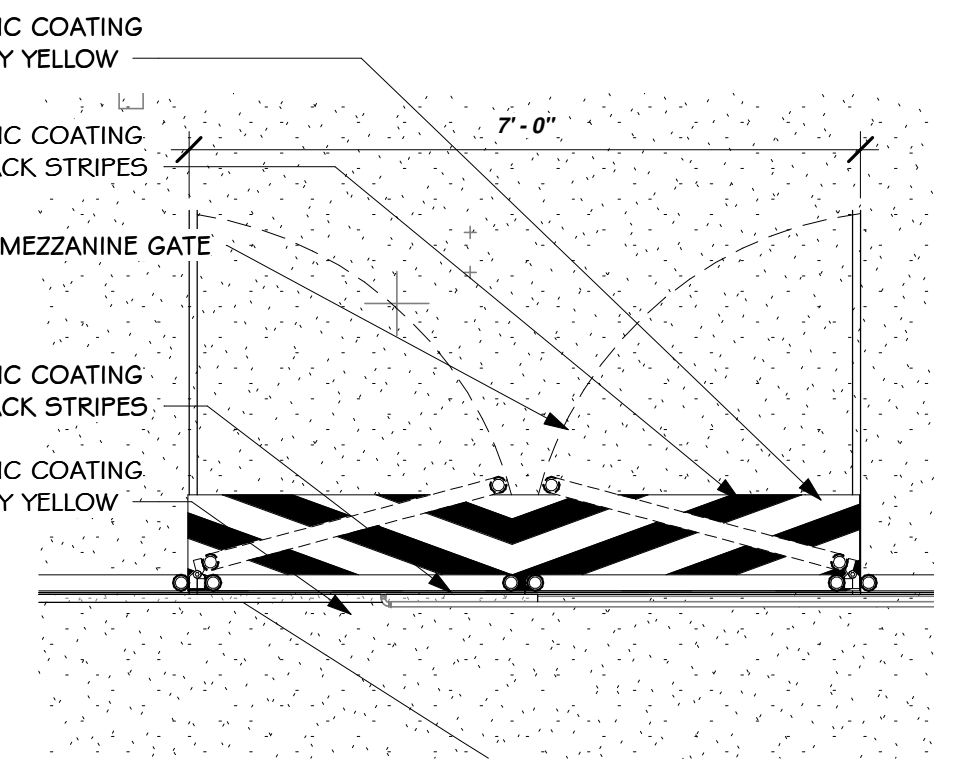


6 HAZARD MARKING DETAIL
1/2" = 1'-0"

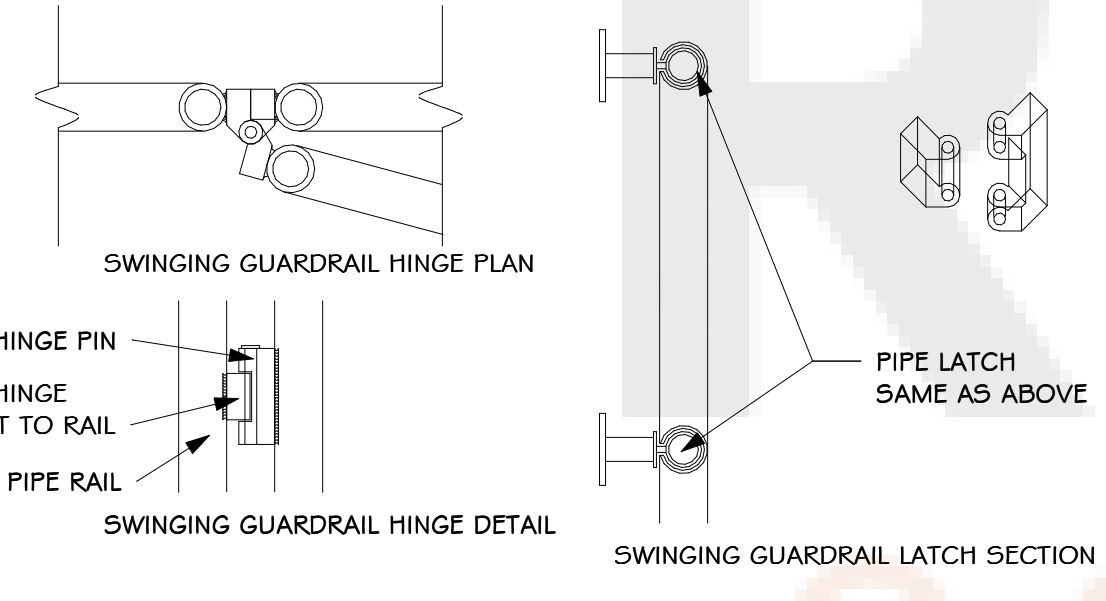

5 MEZZ GATE DETAILS
1 1/2" = 1'-0"

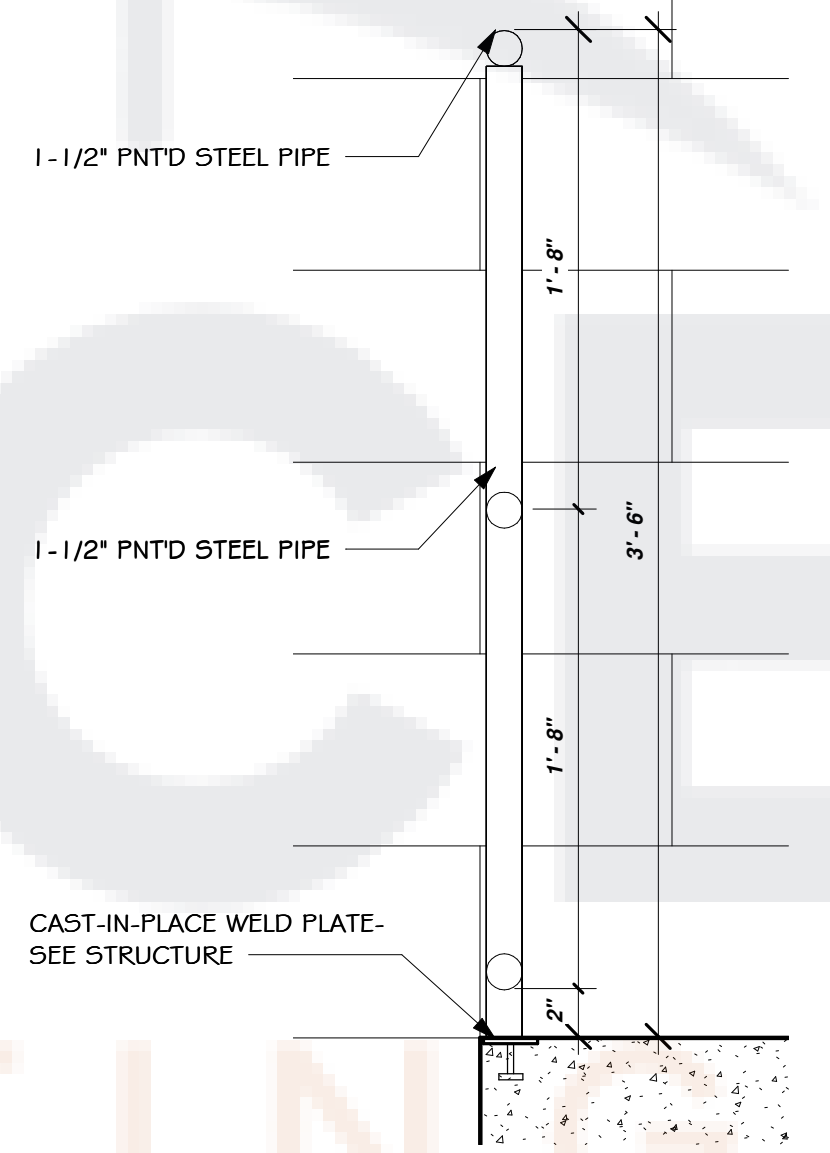


13 GUARDRAIL DETAIL
1 1/2" = 1'-0"

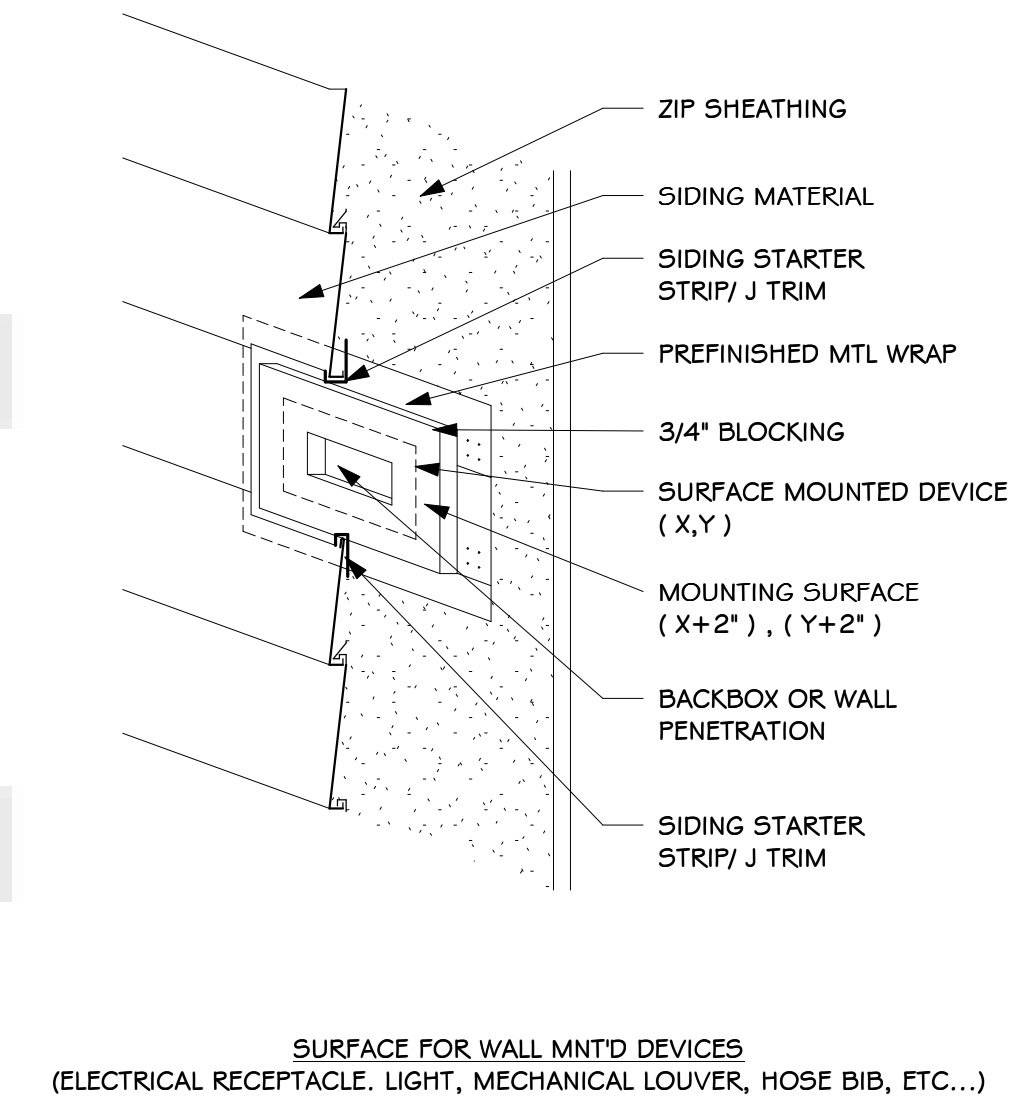

14 EXTERIOR WALL MNT'D DEVICE DETAIL
1 1/2" = 1'-0"

**NORTH LITTLE ROCK
FIRE DEPARTMENT
STATION 8**

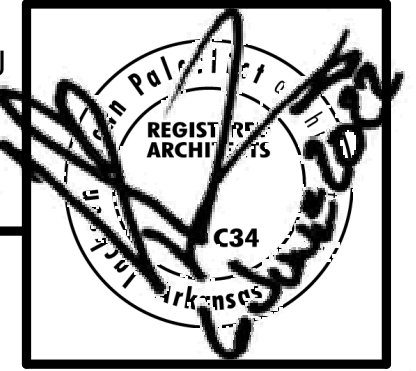

**Jackson
Brown
Palculict
architects**


Date
6/6/22
Revisions

JOB NUMBER 2203


Sheet Title
**MISC.
DETAILS**

Sheet Number
A701


12921 Cantrell Road, Suite 201
Little Rock, AR 72223
501.664.8700 tel
501.664.5189 fax
www.jbparchitects.com

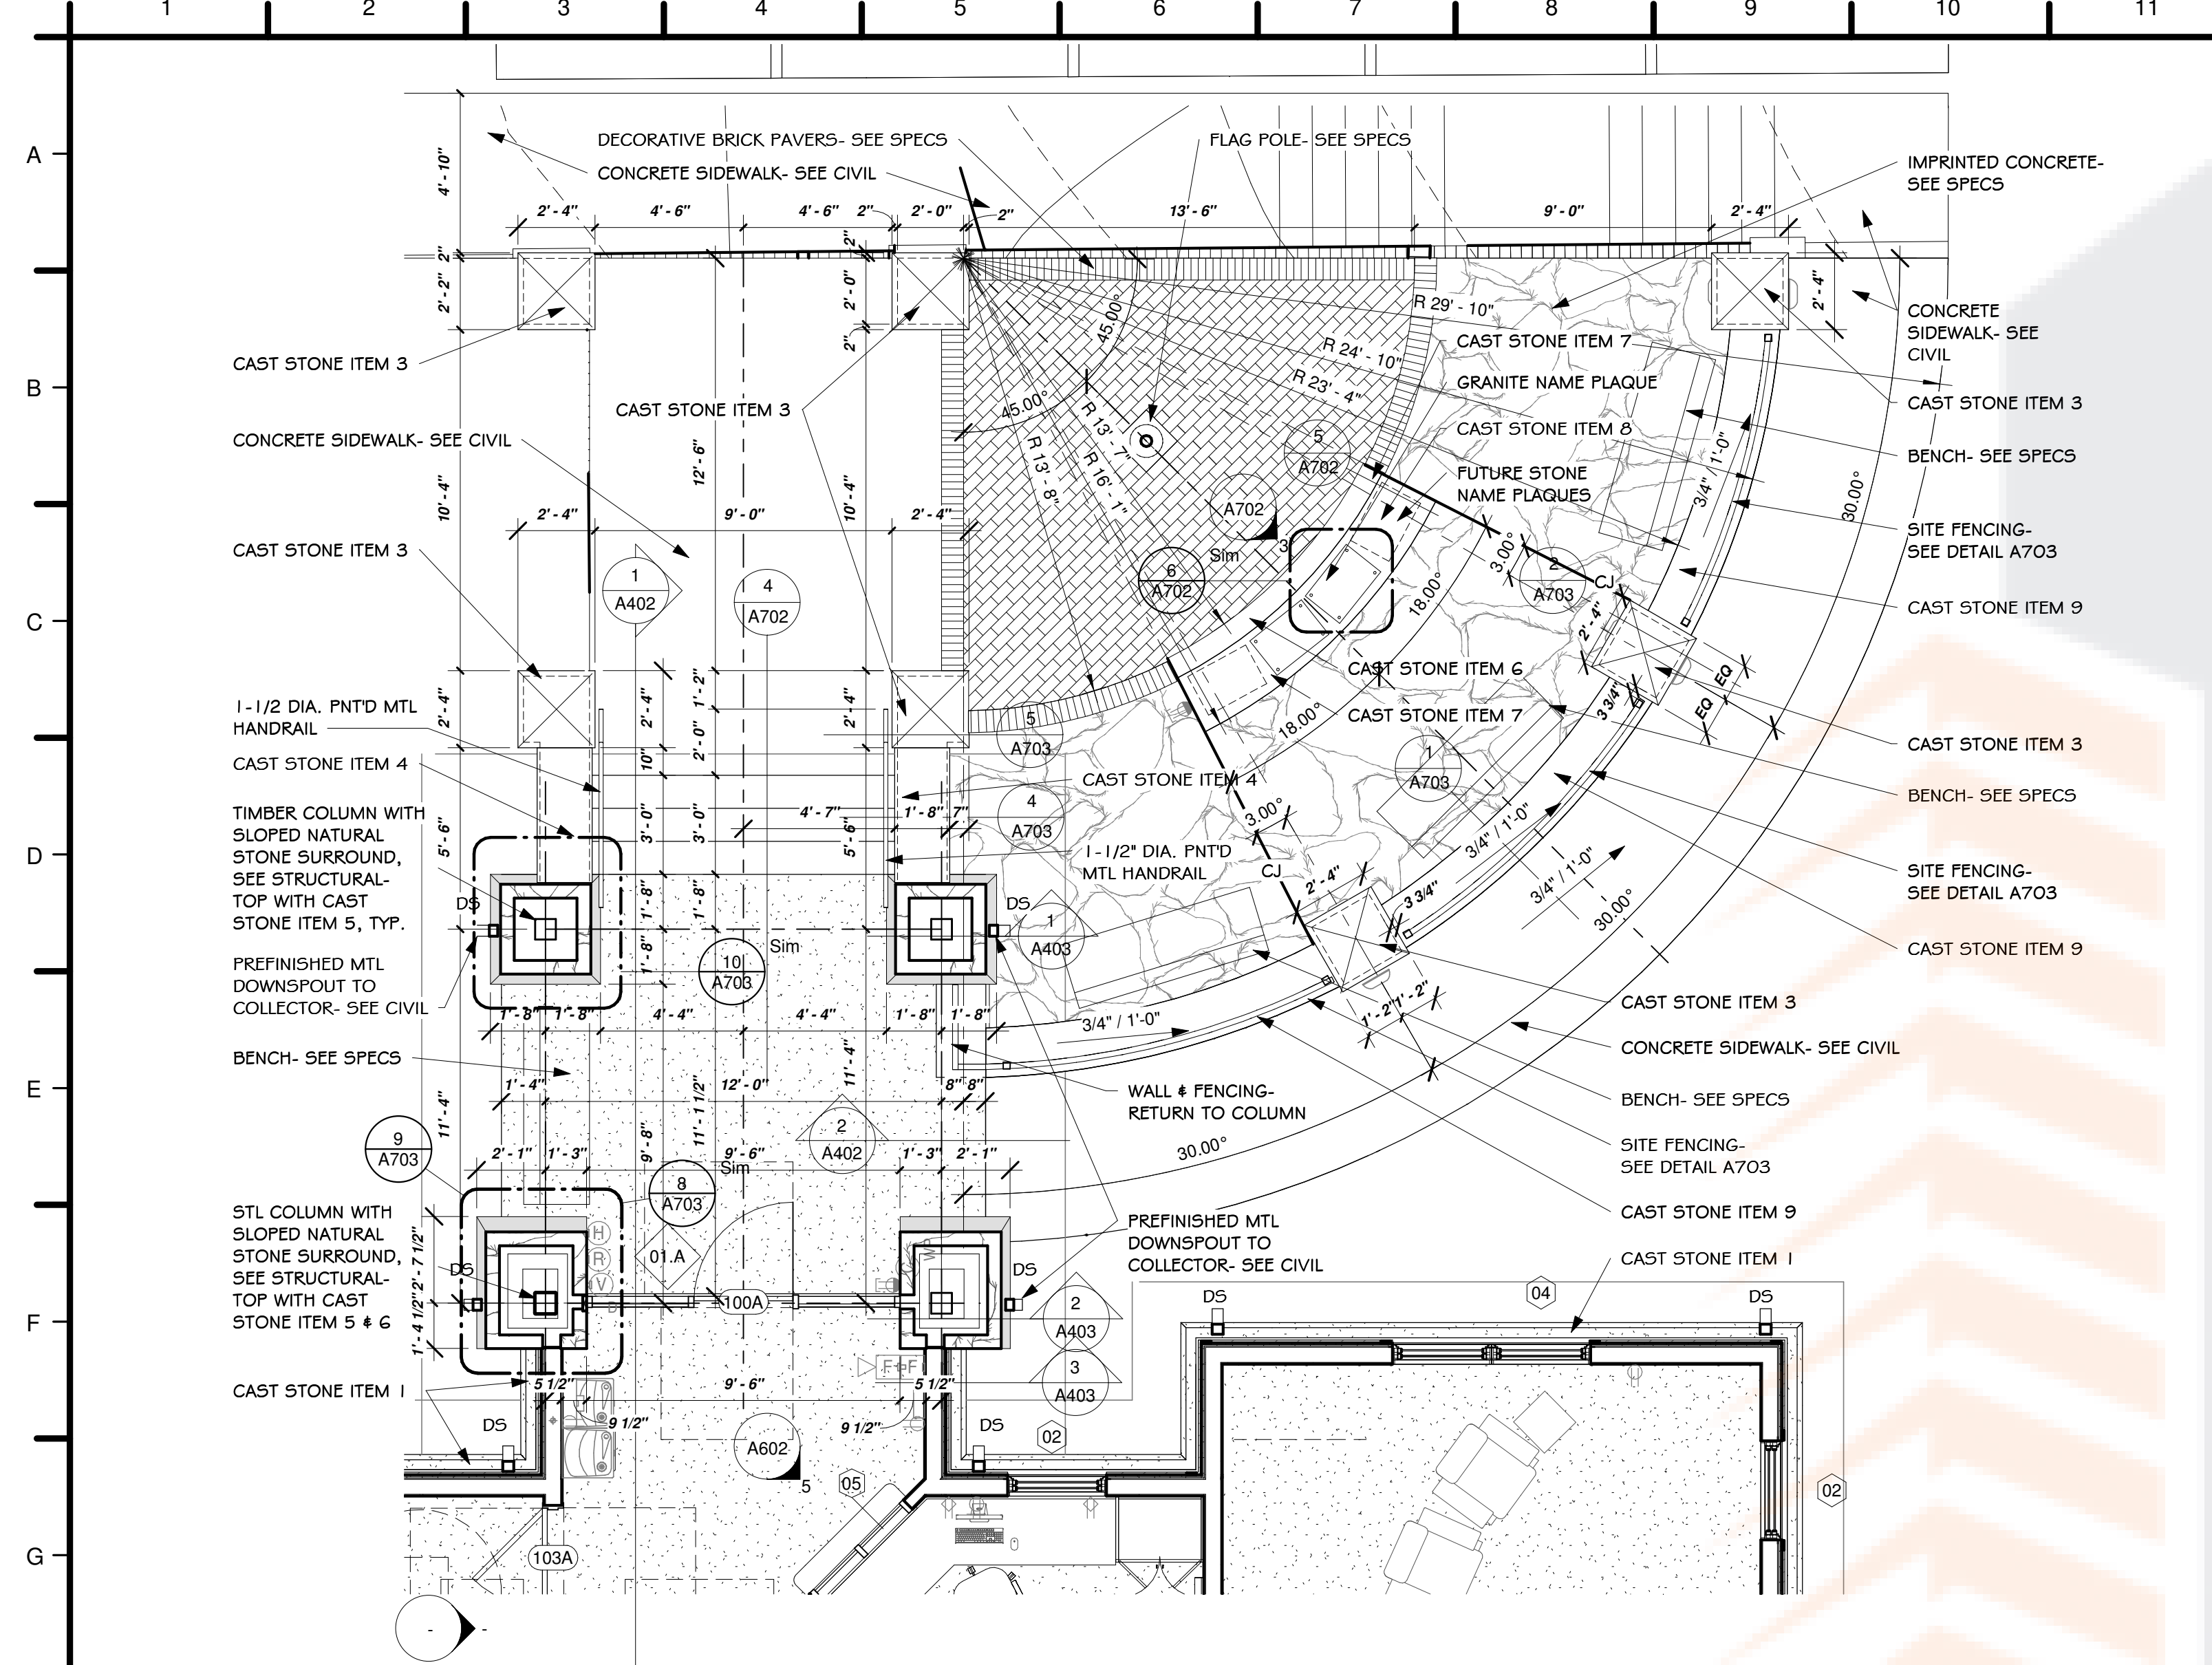


1 ENTRY PLAZA PLAN
1/4" = 1'-0"

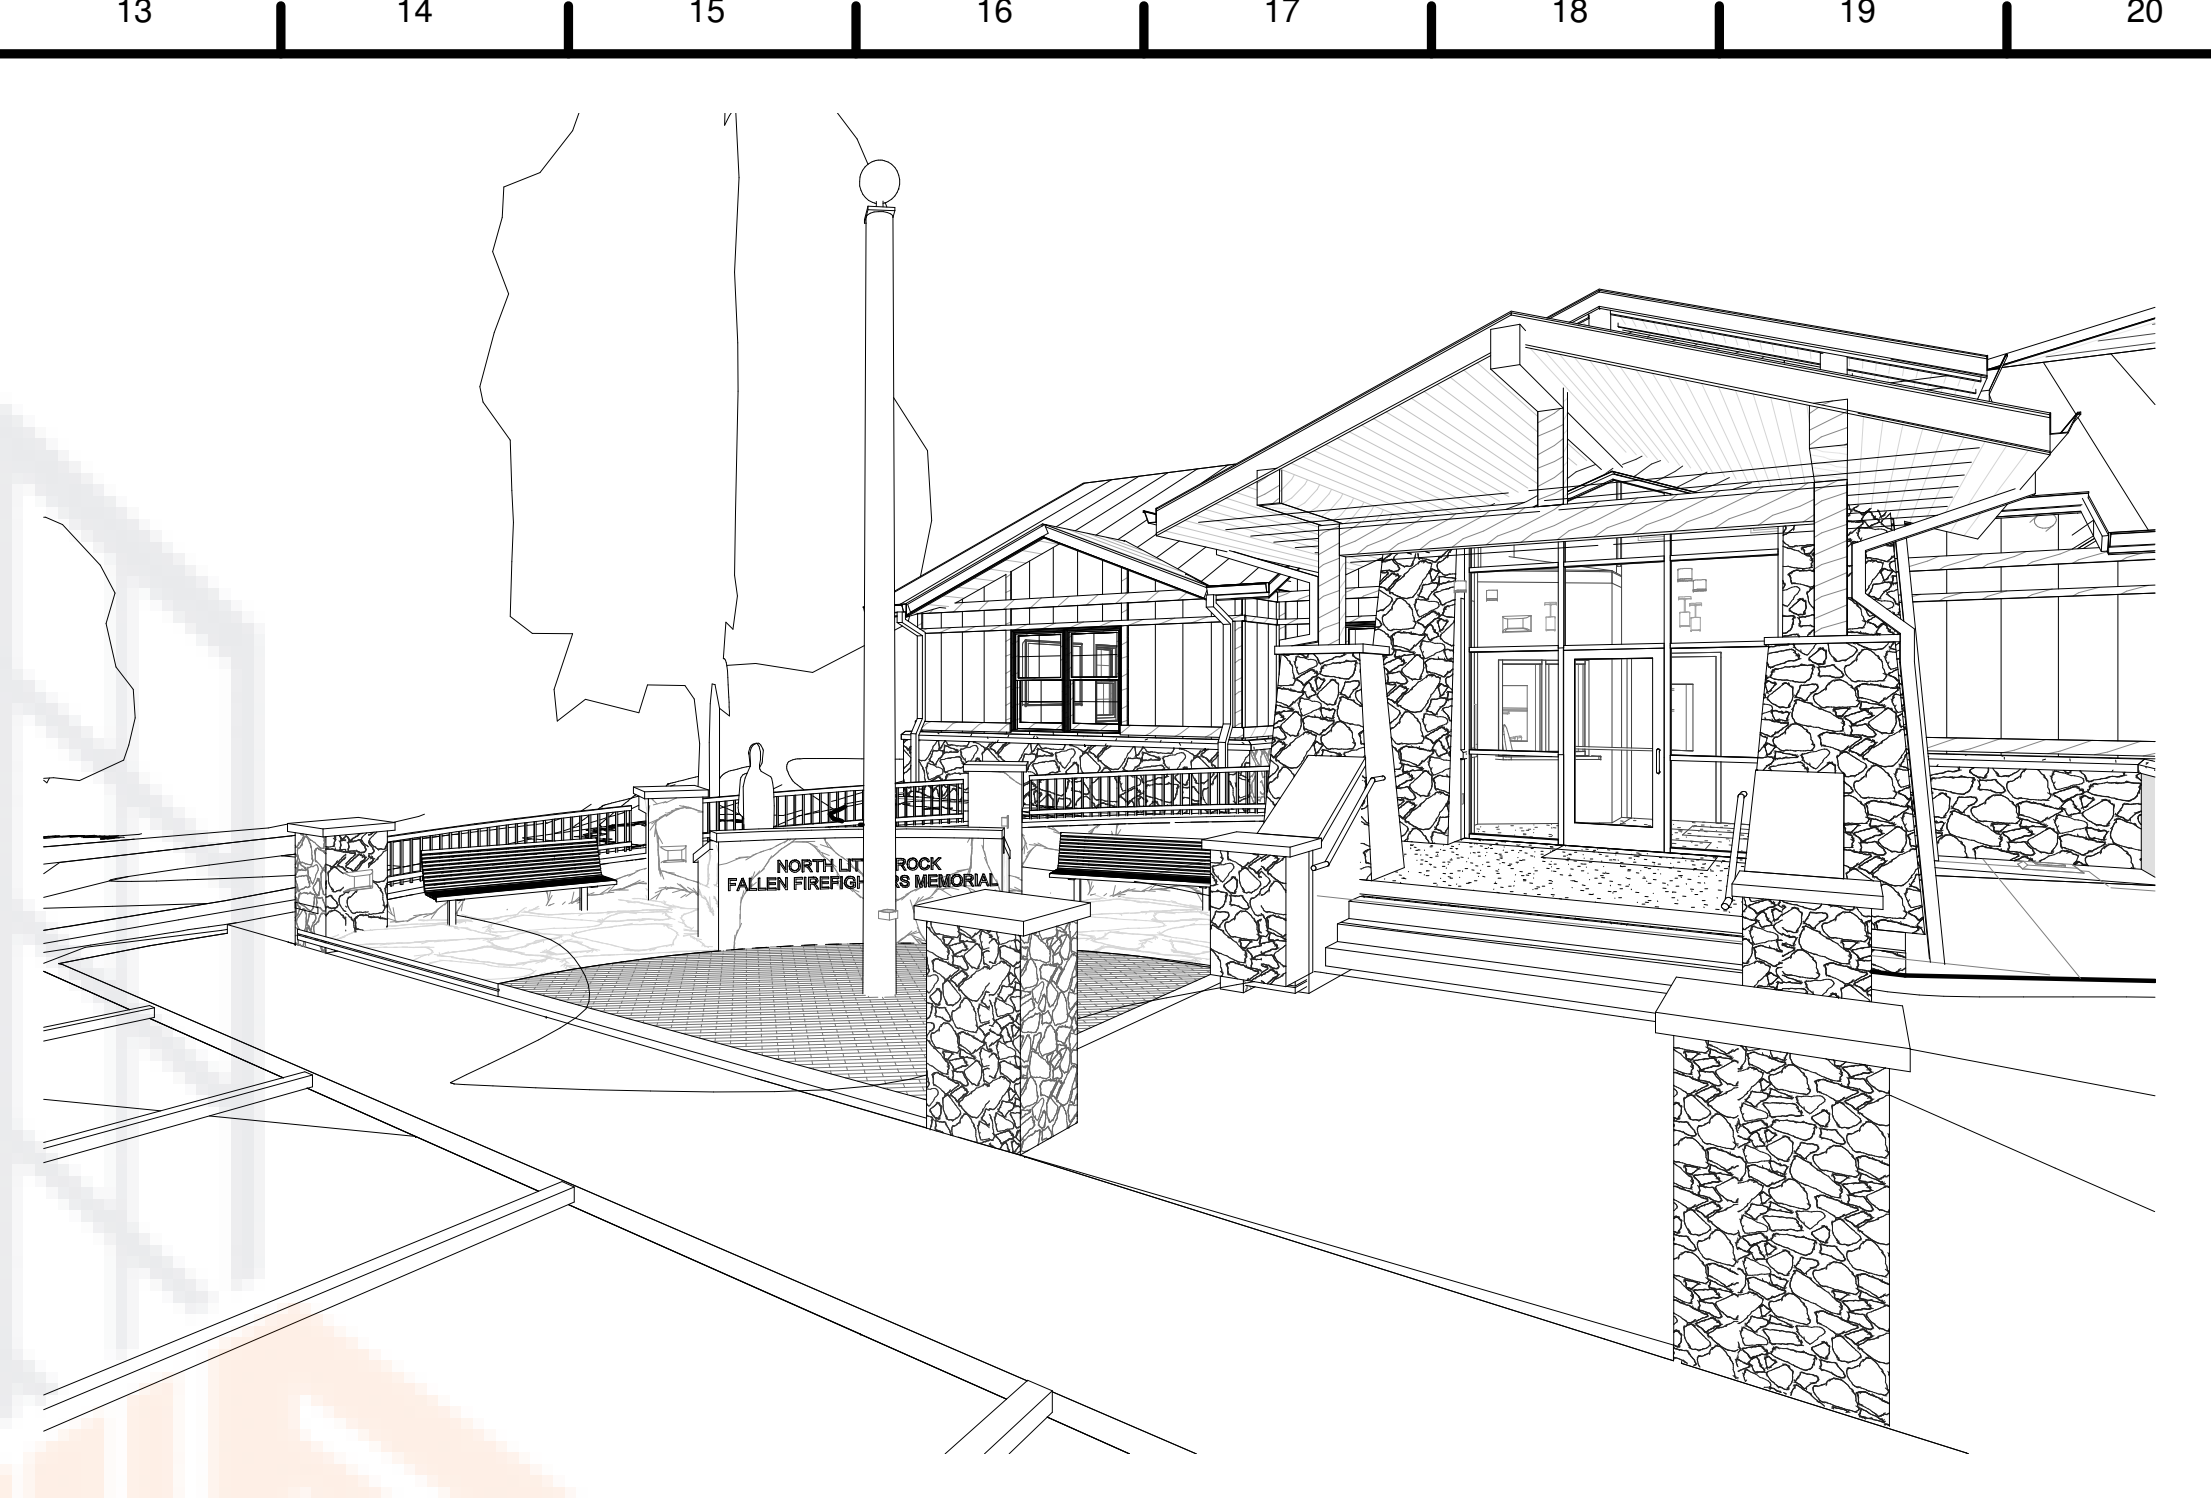


2 MEMORIAL PERSPECTIVE

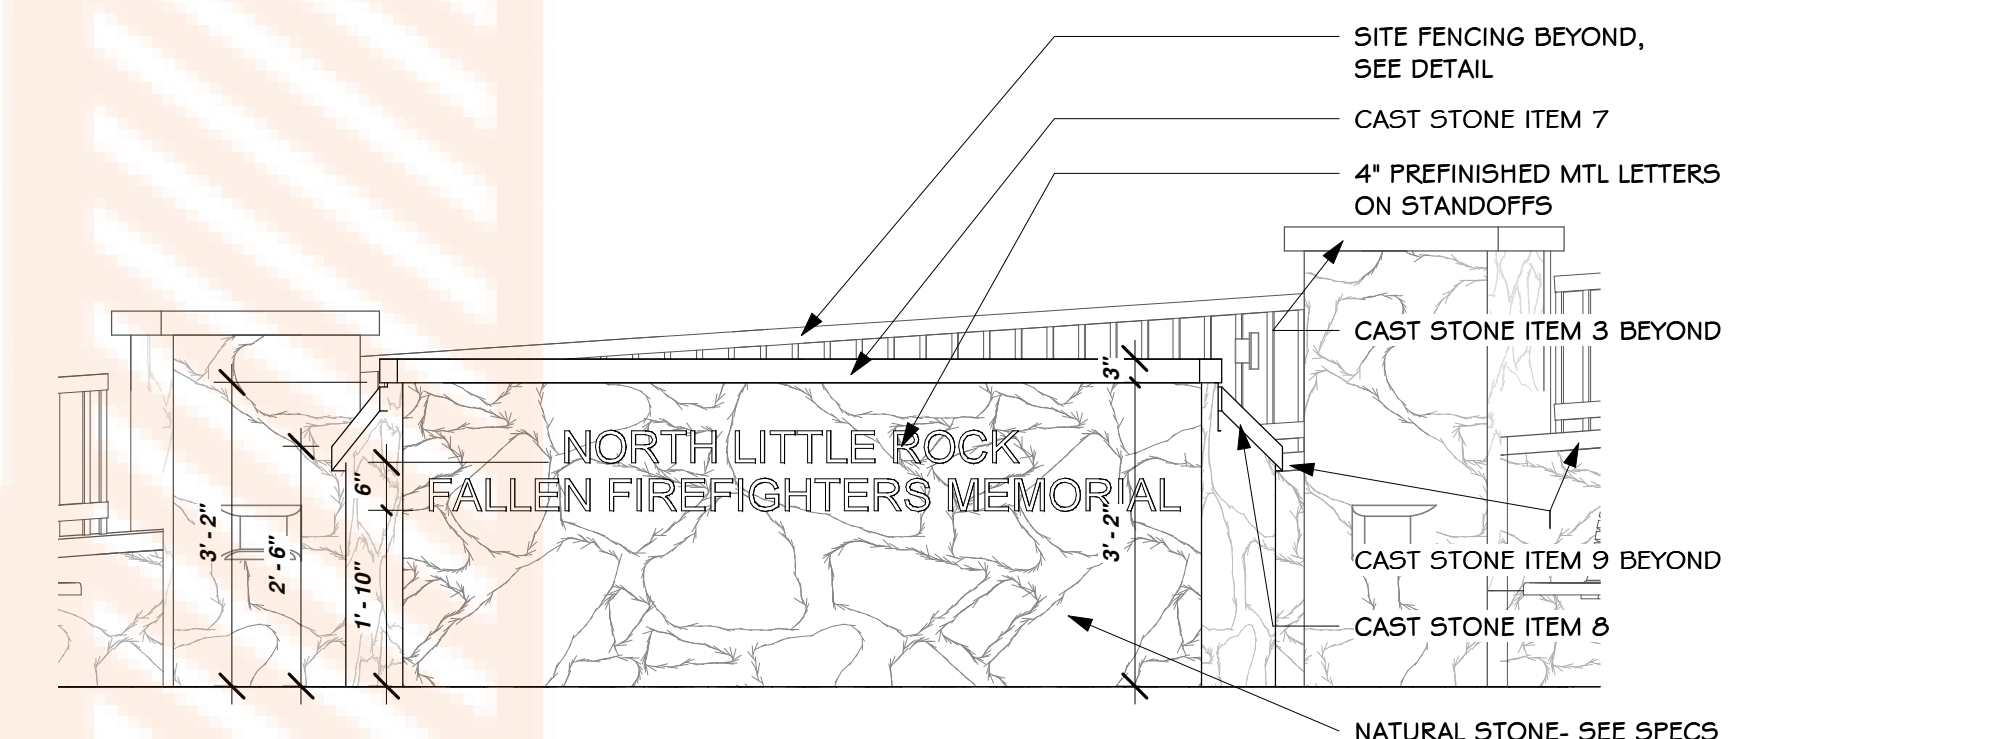


3 MEMORIAL ELEVATION
1/2" = 1'-0"

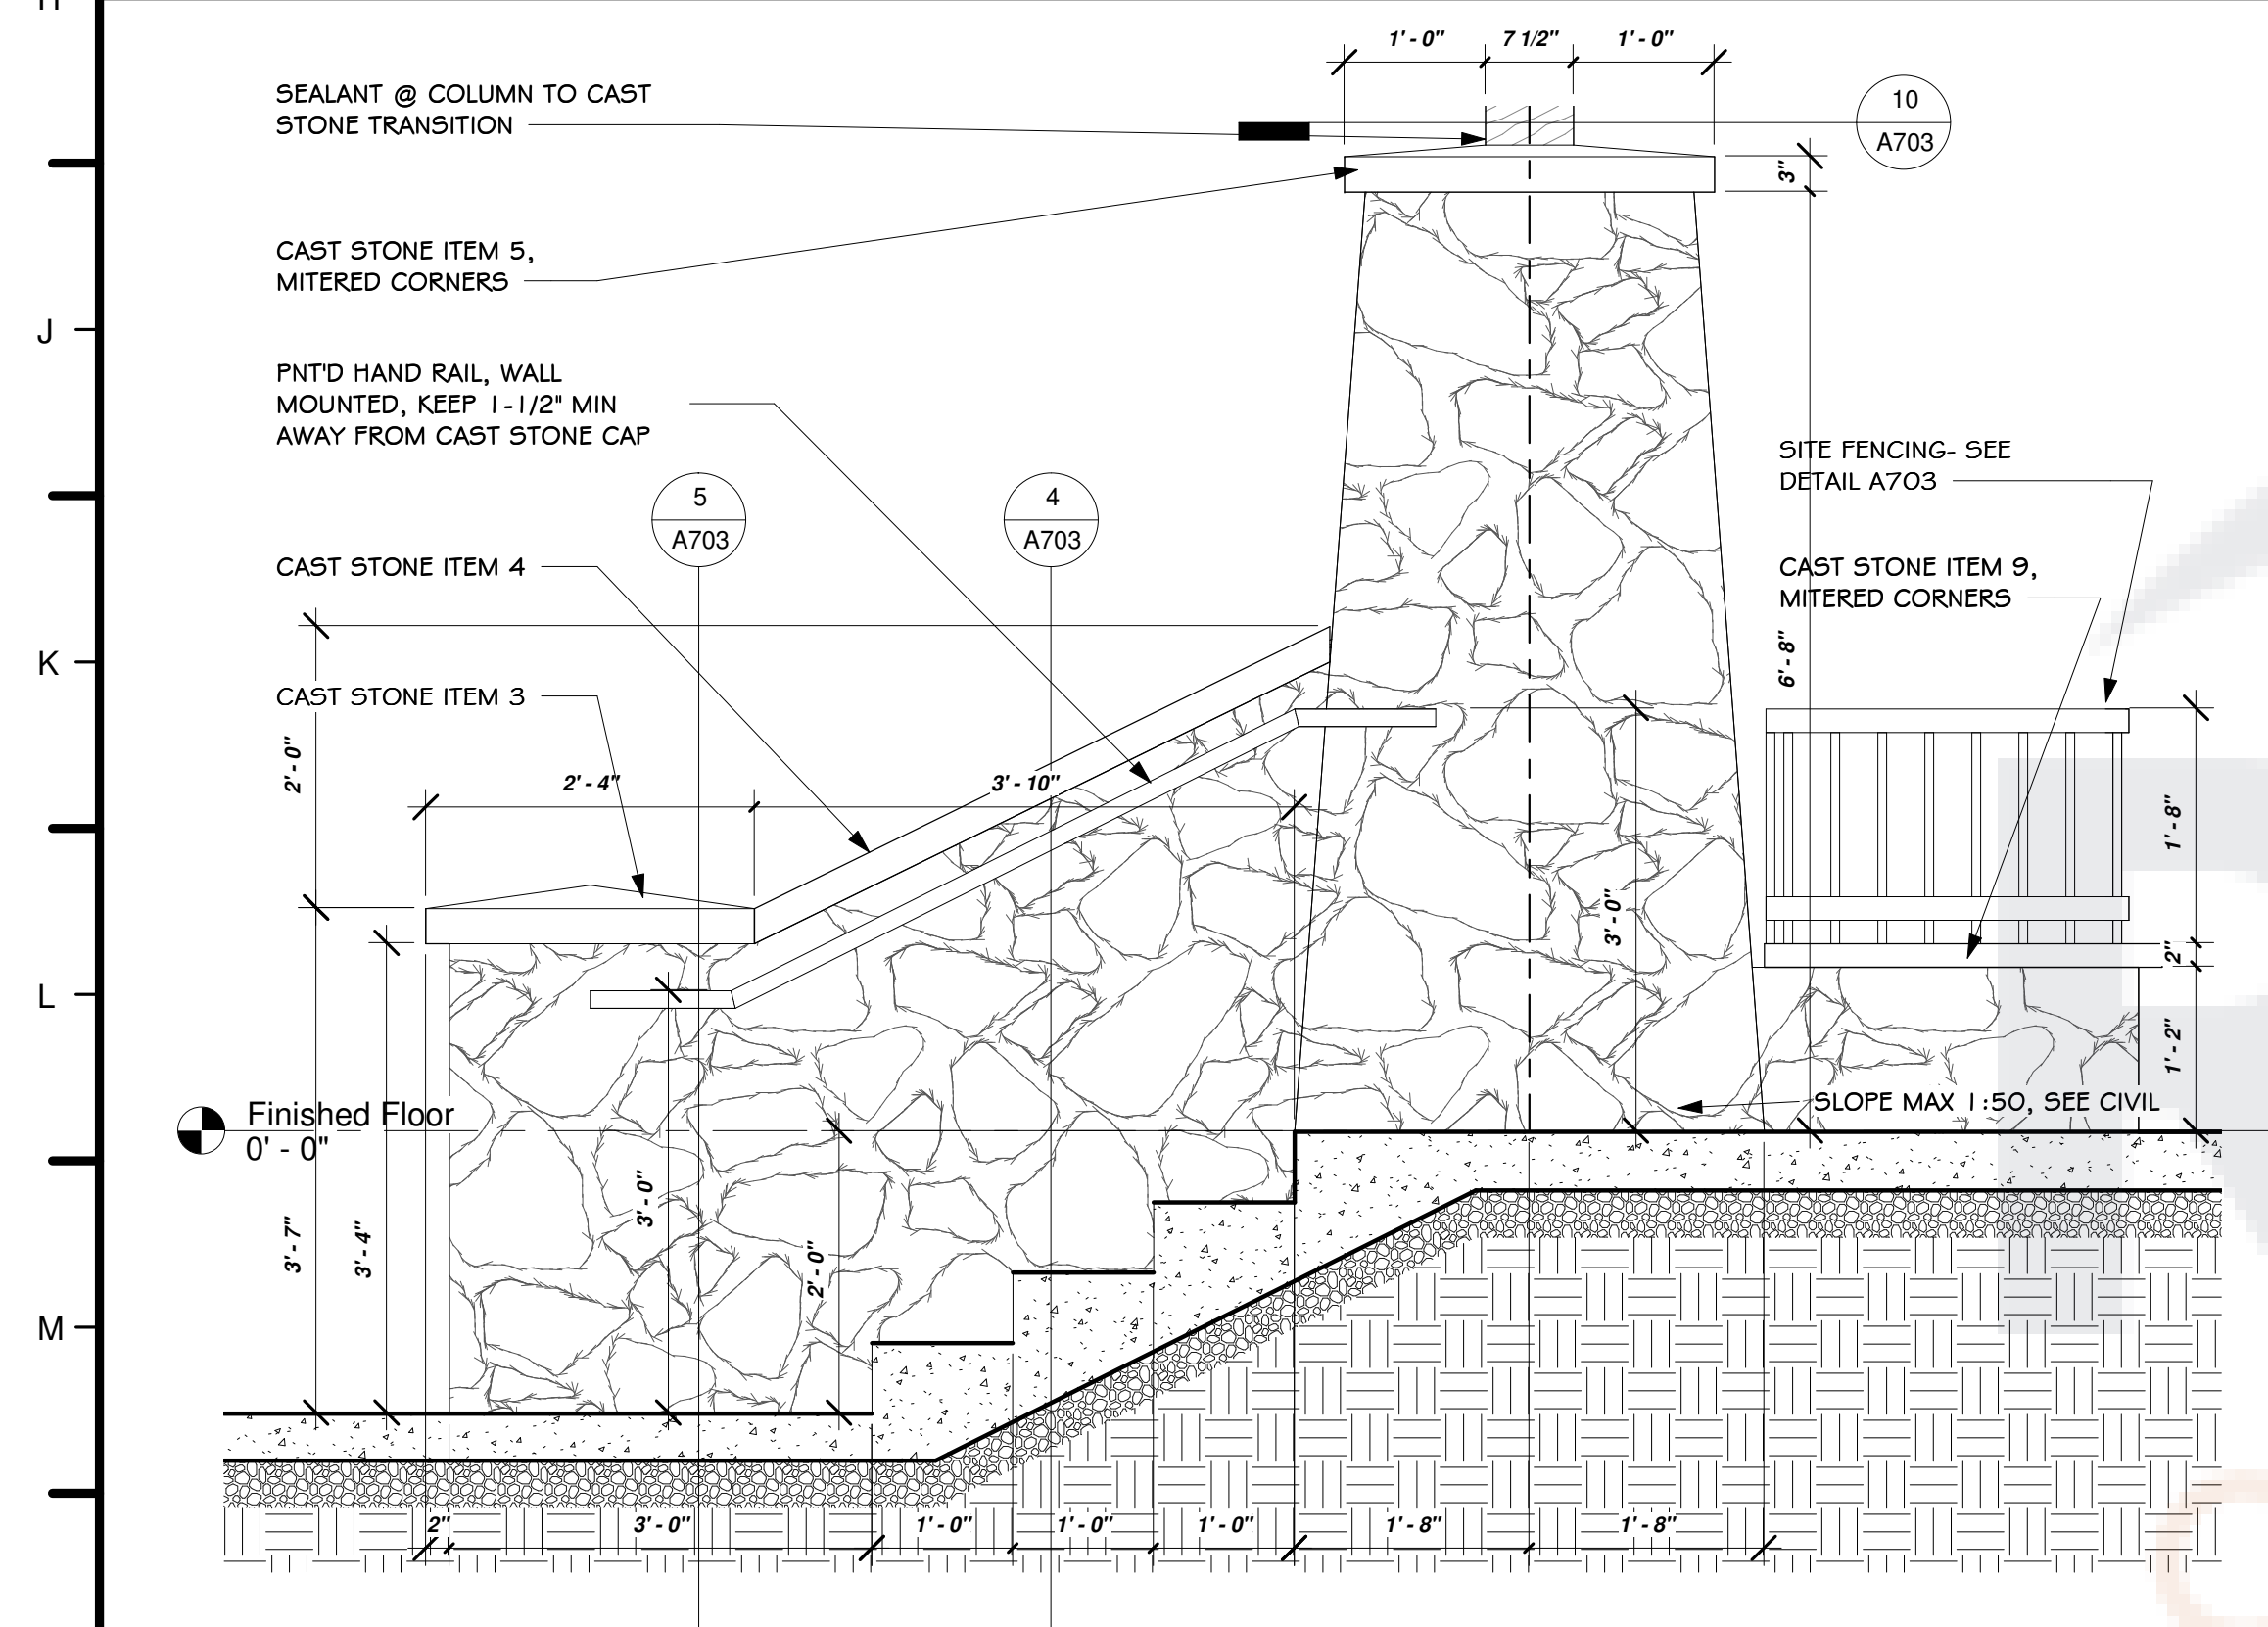

4 ENTRY STAIRS
3/4" = 1'-0"

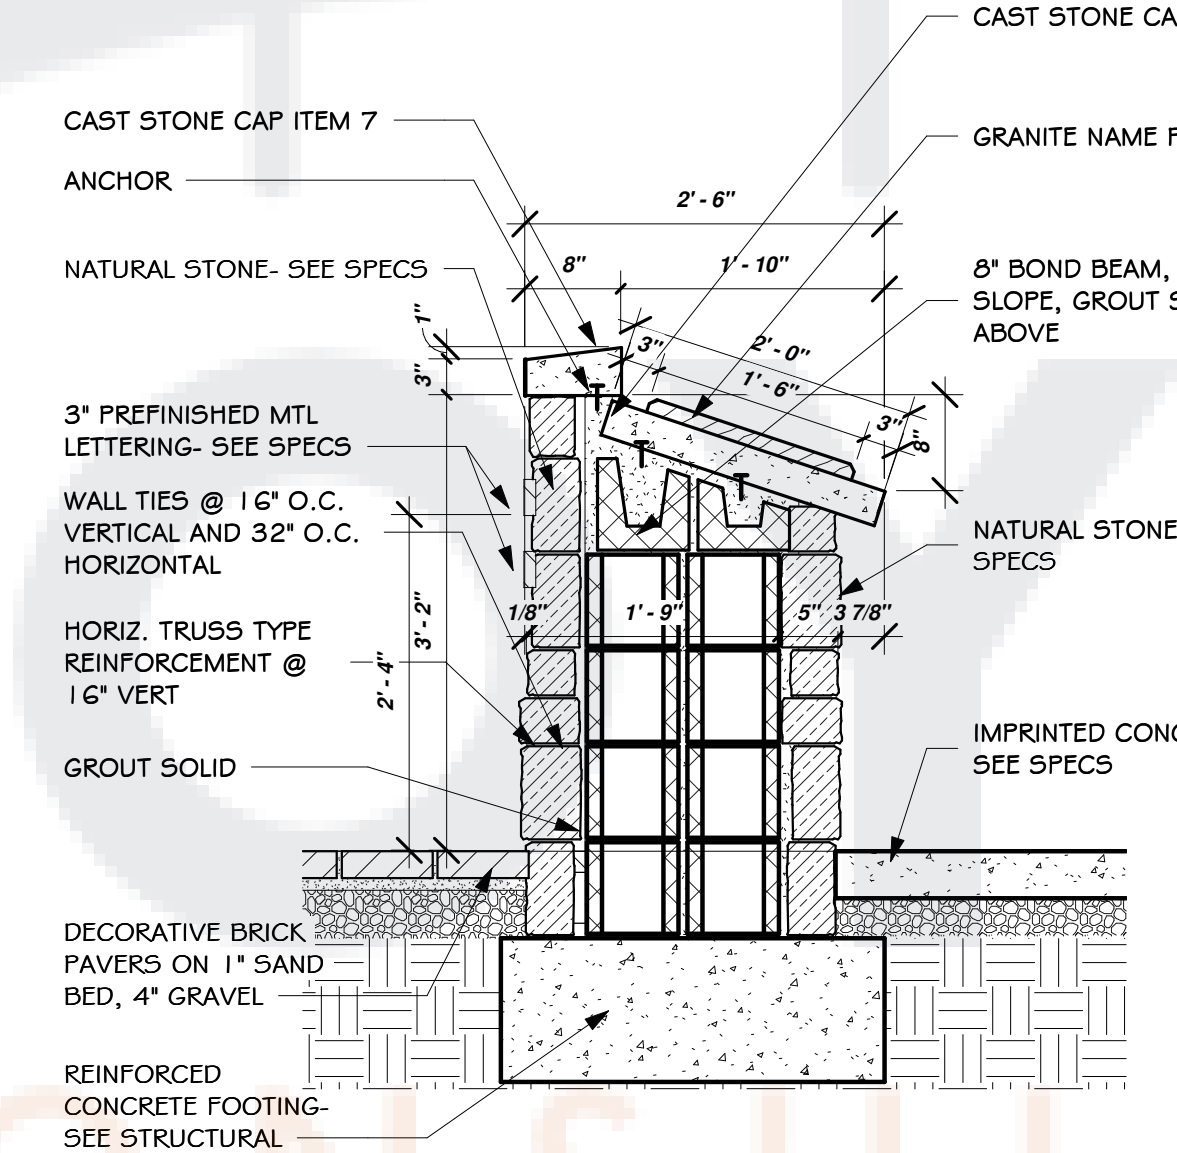


5 MEMORIAL WALL
3/4" = 1'-0"

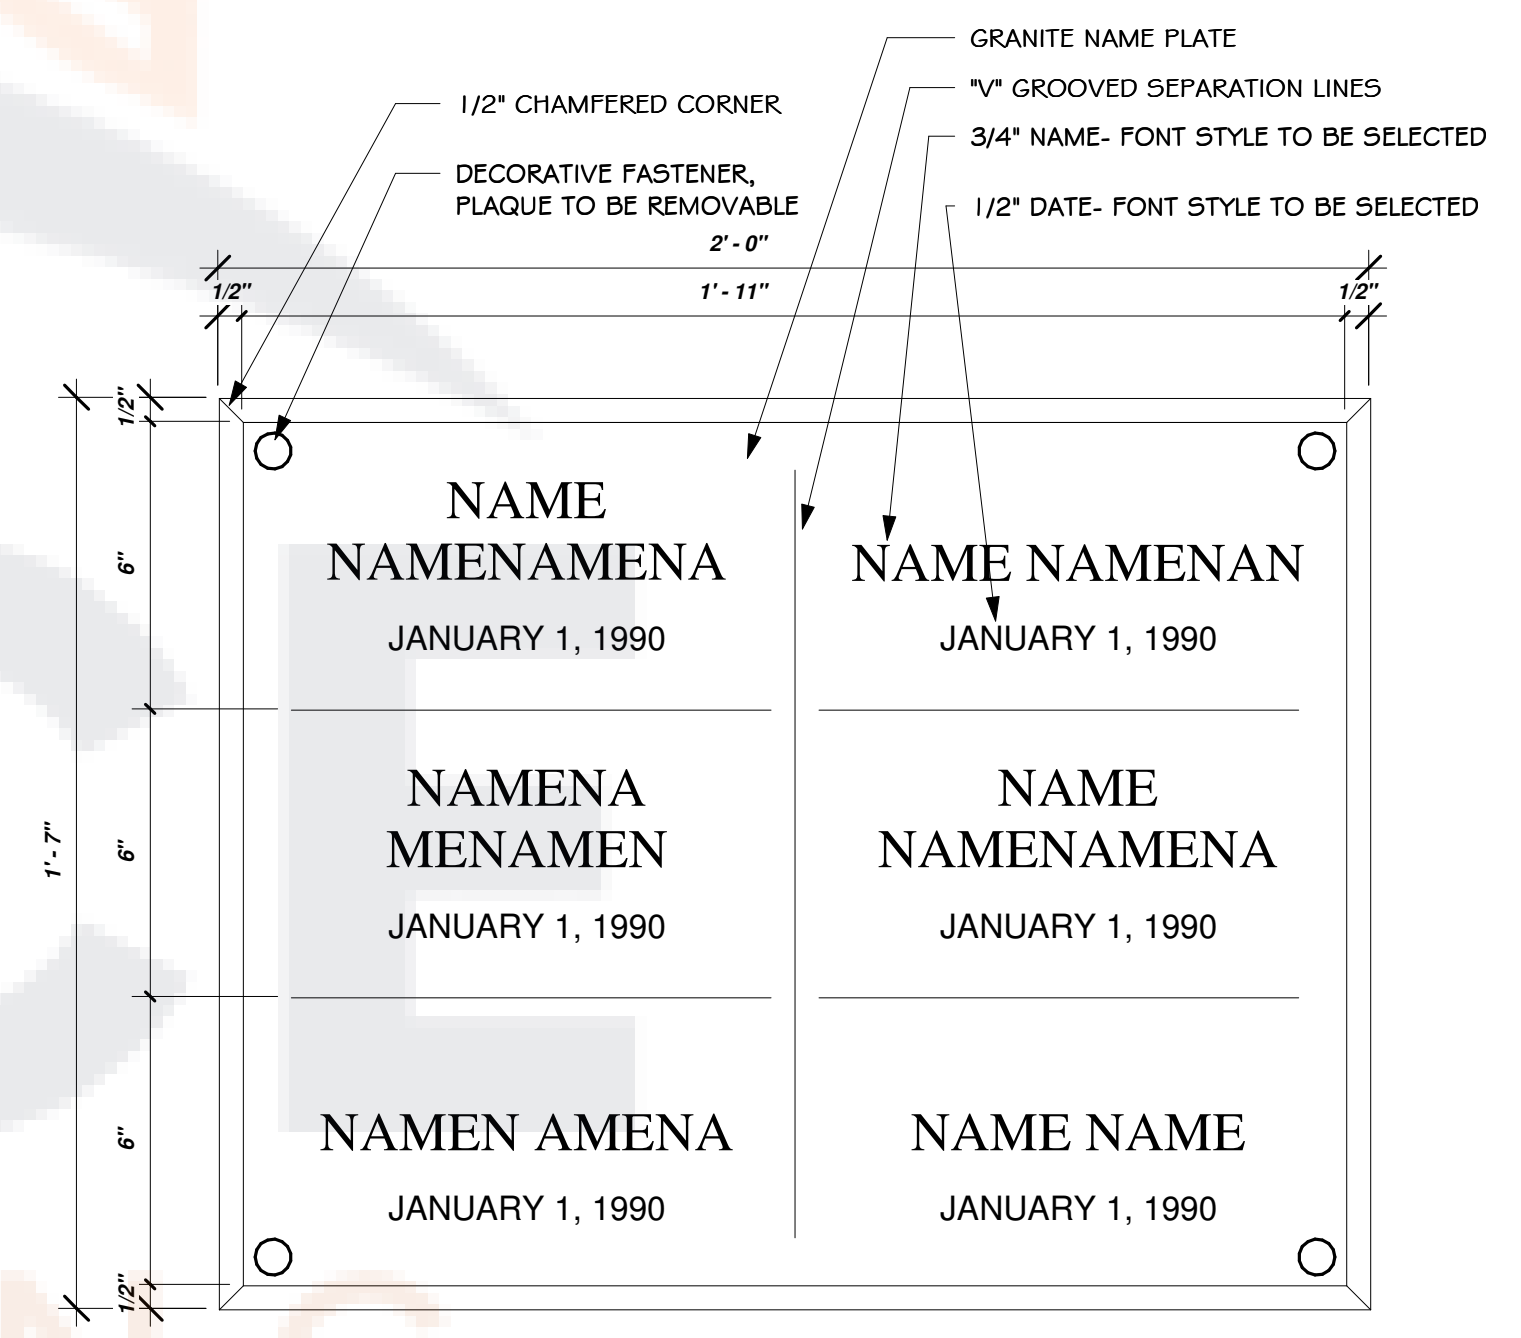

6 GRANITE NAME PLAQUE
3" = 1'-0"

General Notes

NORTH LITTLE ROCK FIRE DEPARTMENT STATION 8

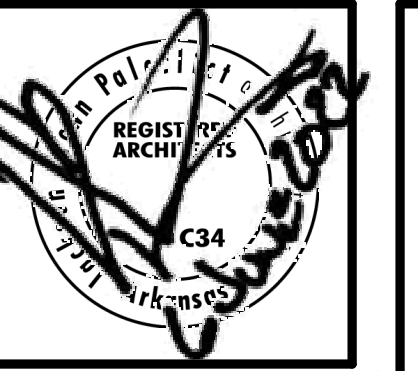

Jackson
Brown
Palculict
architects


Date
6/6/22
Revisions

JOB NUMBER 2203


Sheet Title
**ENTRY
PLAZA
DETAILS**

Sheet Number
A702


12921 Cantrell Road, Suite 201
Little Rock, AR 72223
501.664.8700 tel
501.664.5189 fax
www.jbparchitects.com

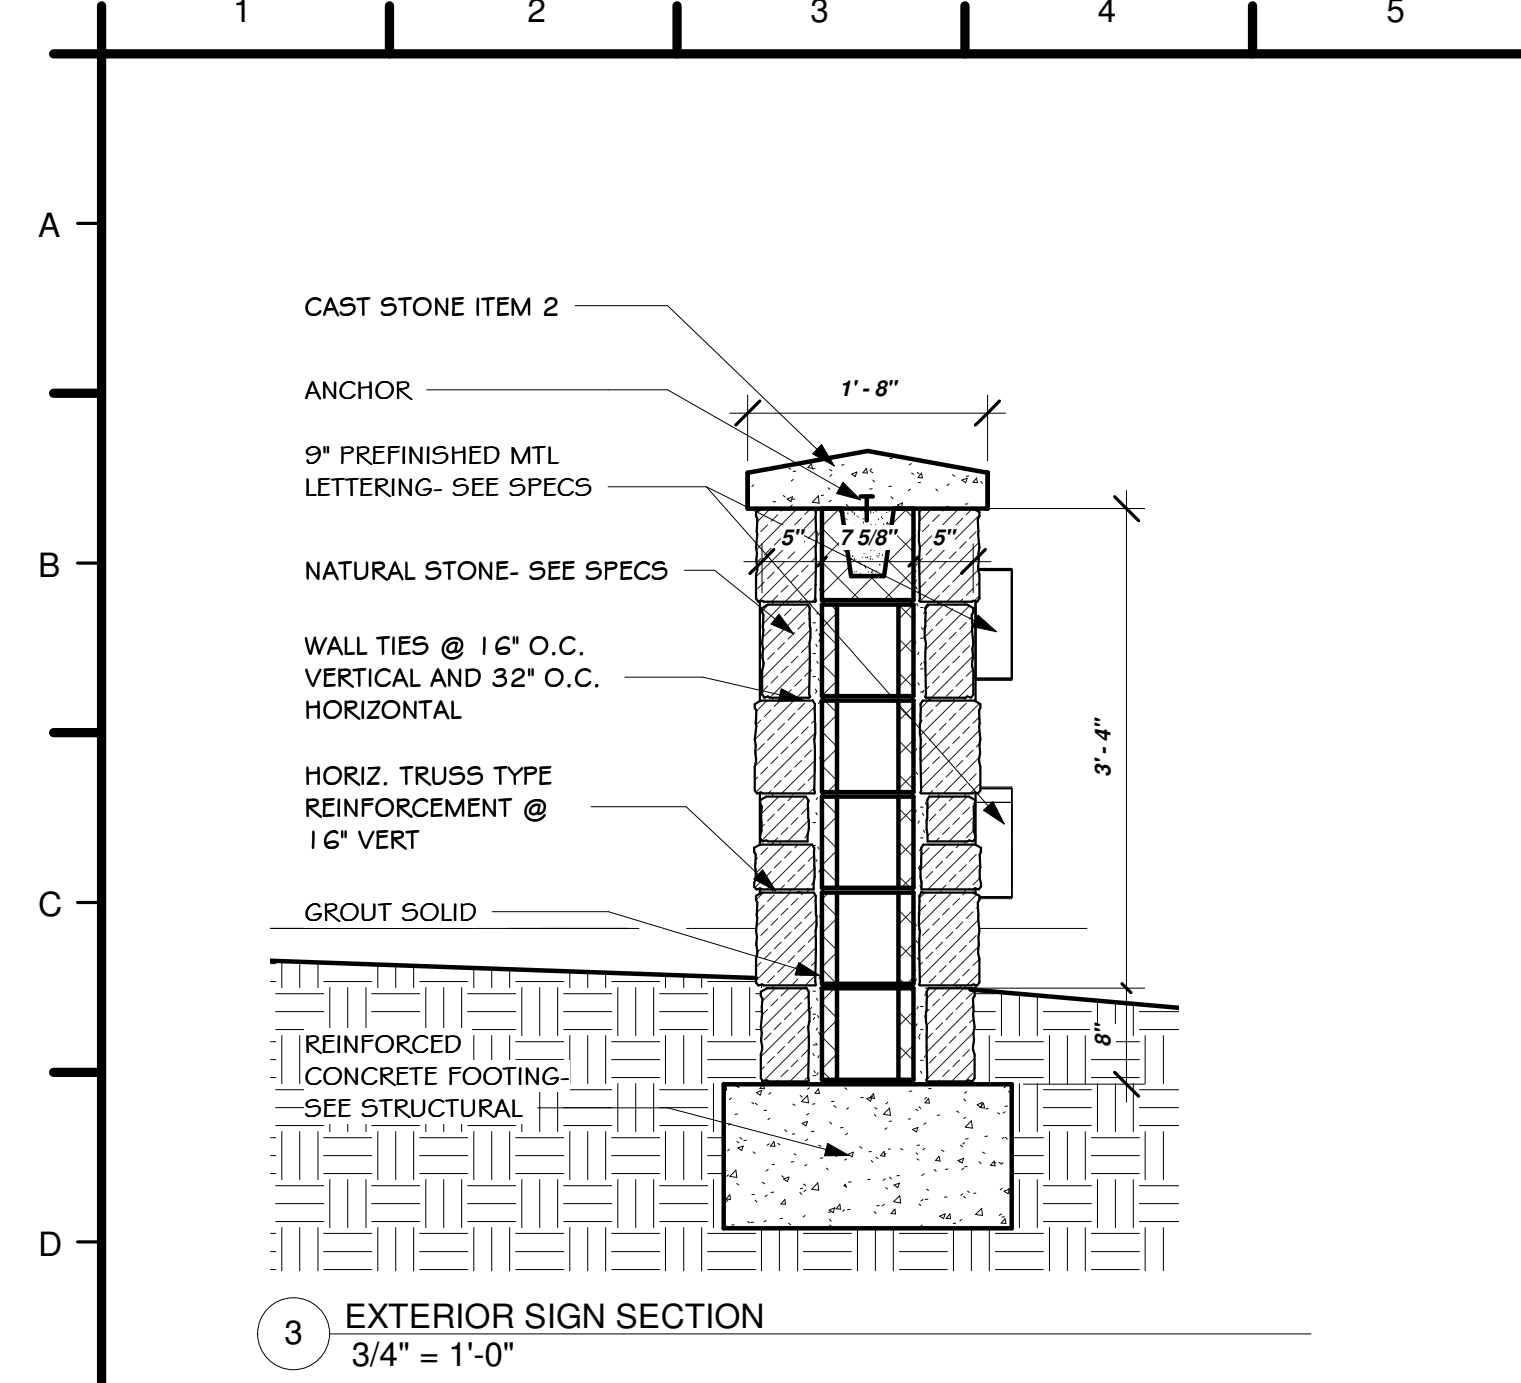


3 EXTERIOR SIGN SECTION
3/4" = 1'-0"

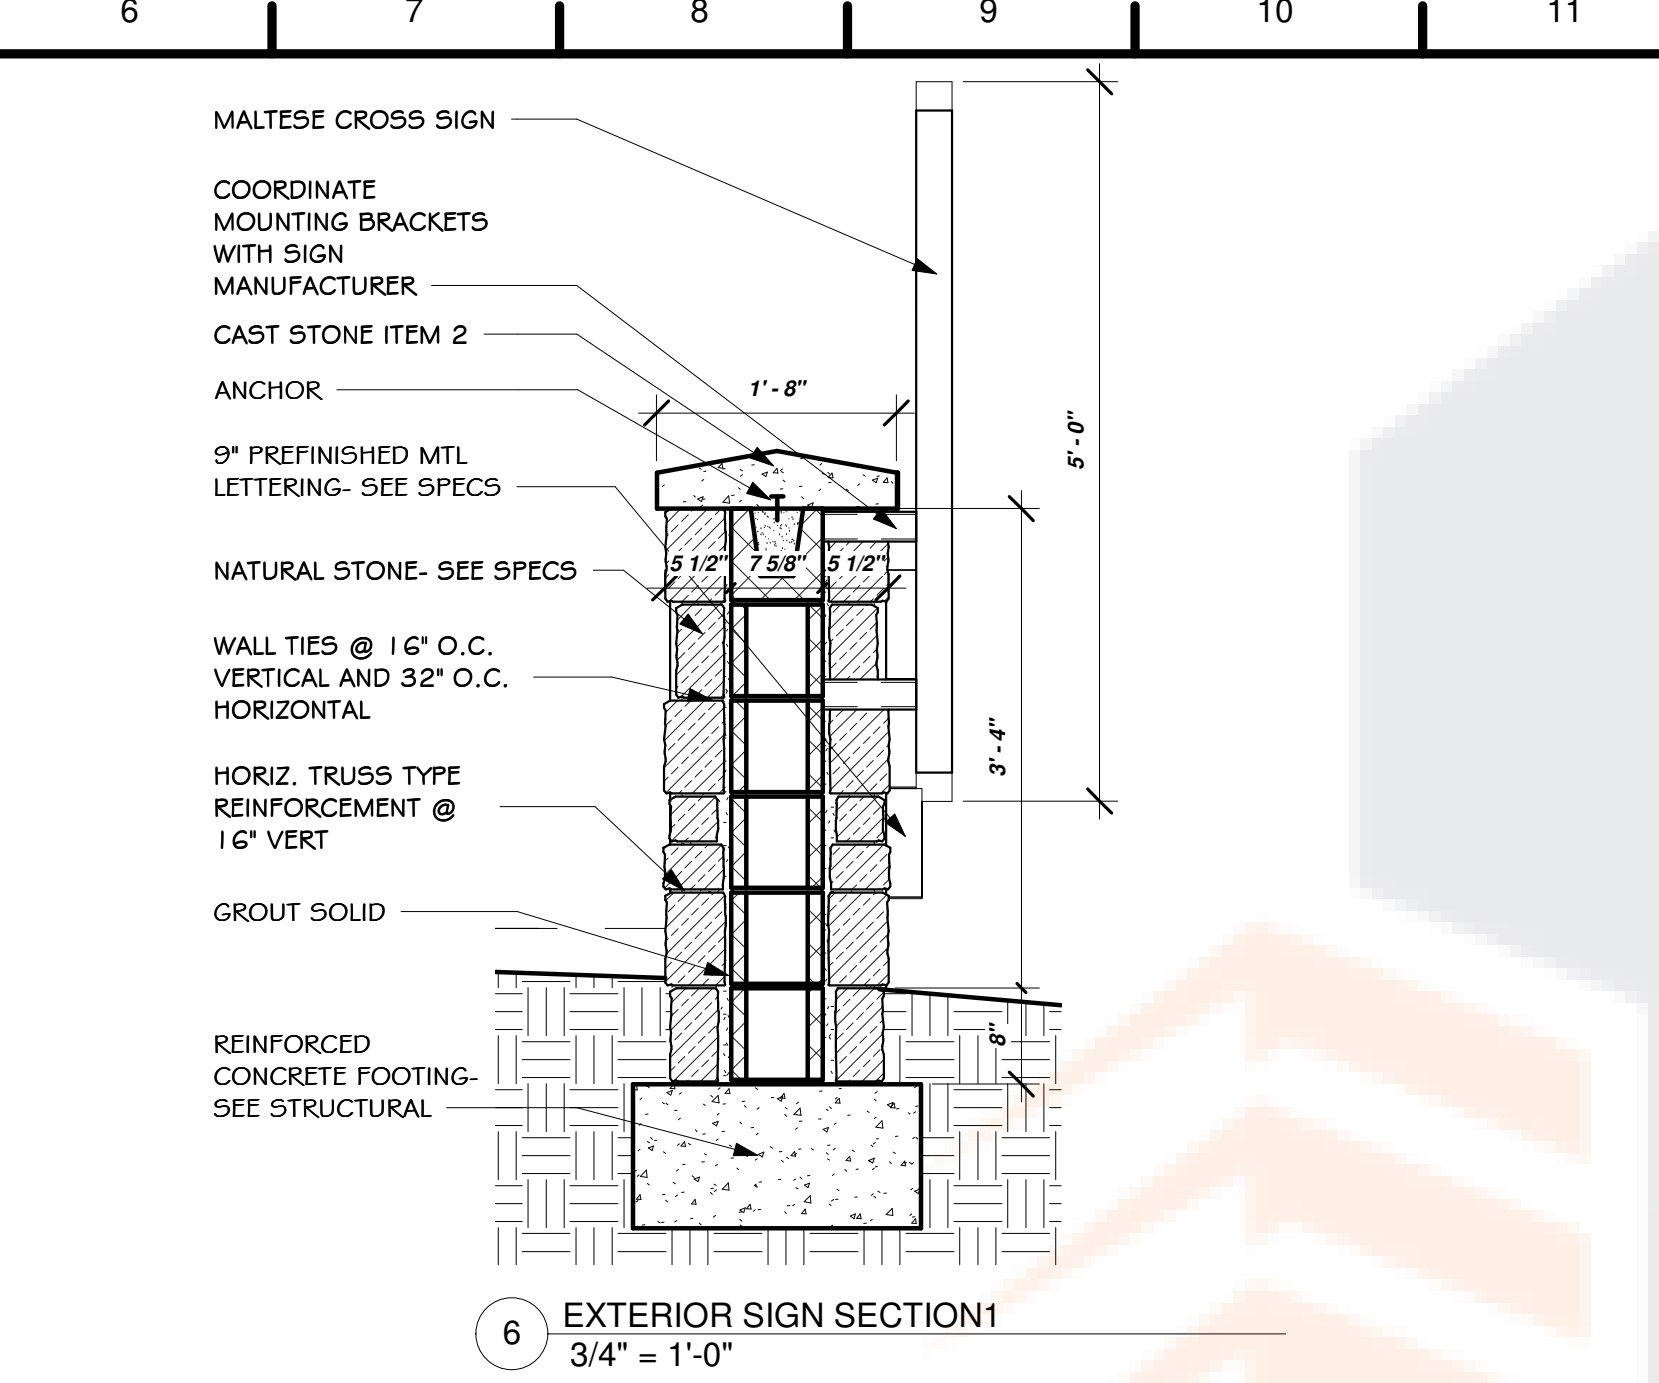


6 EXTERIOR SIGN SECTION
3/4" = 1'-0"

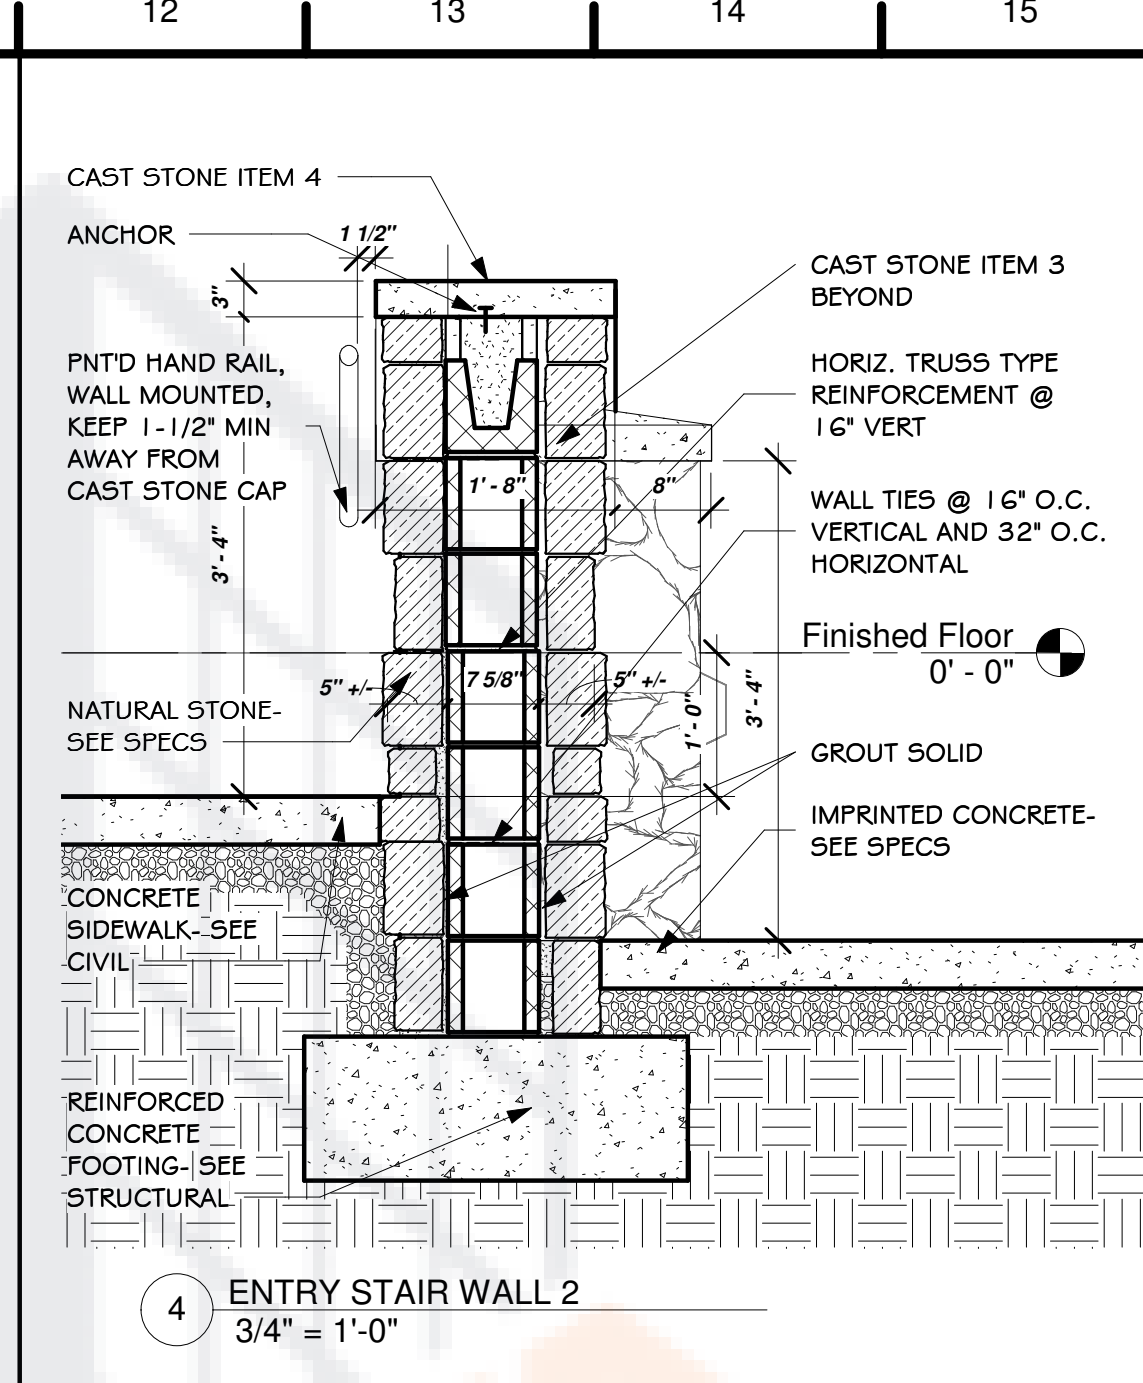


4 ENTRY STAIR WALL 2
3/4" = 1'-0"

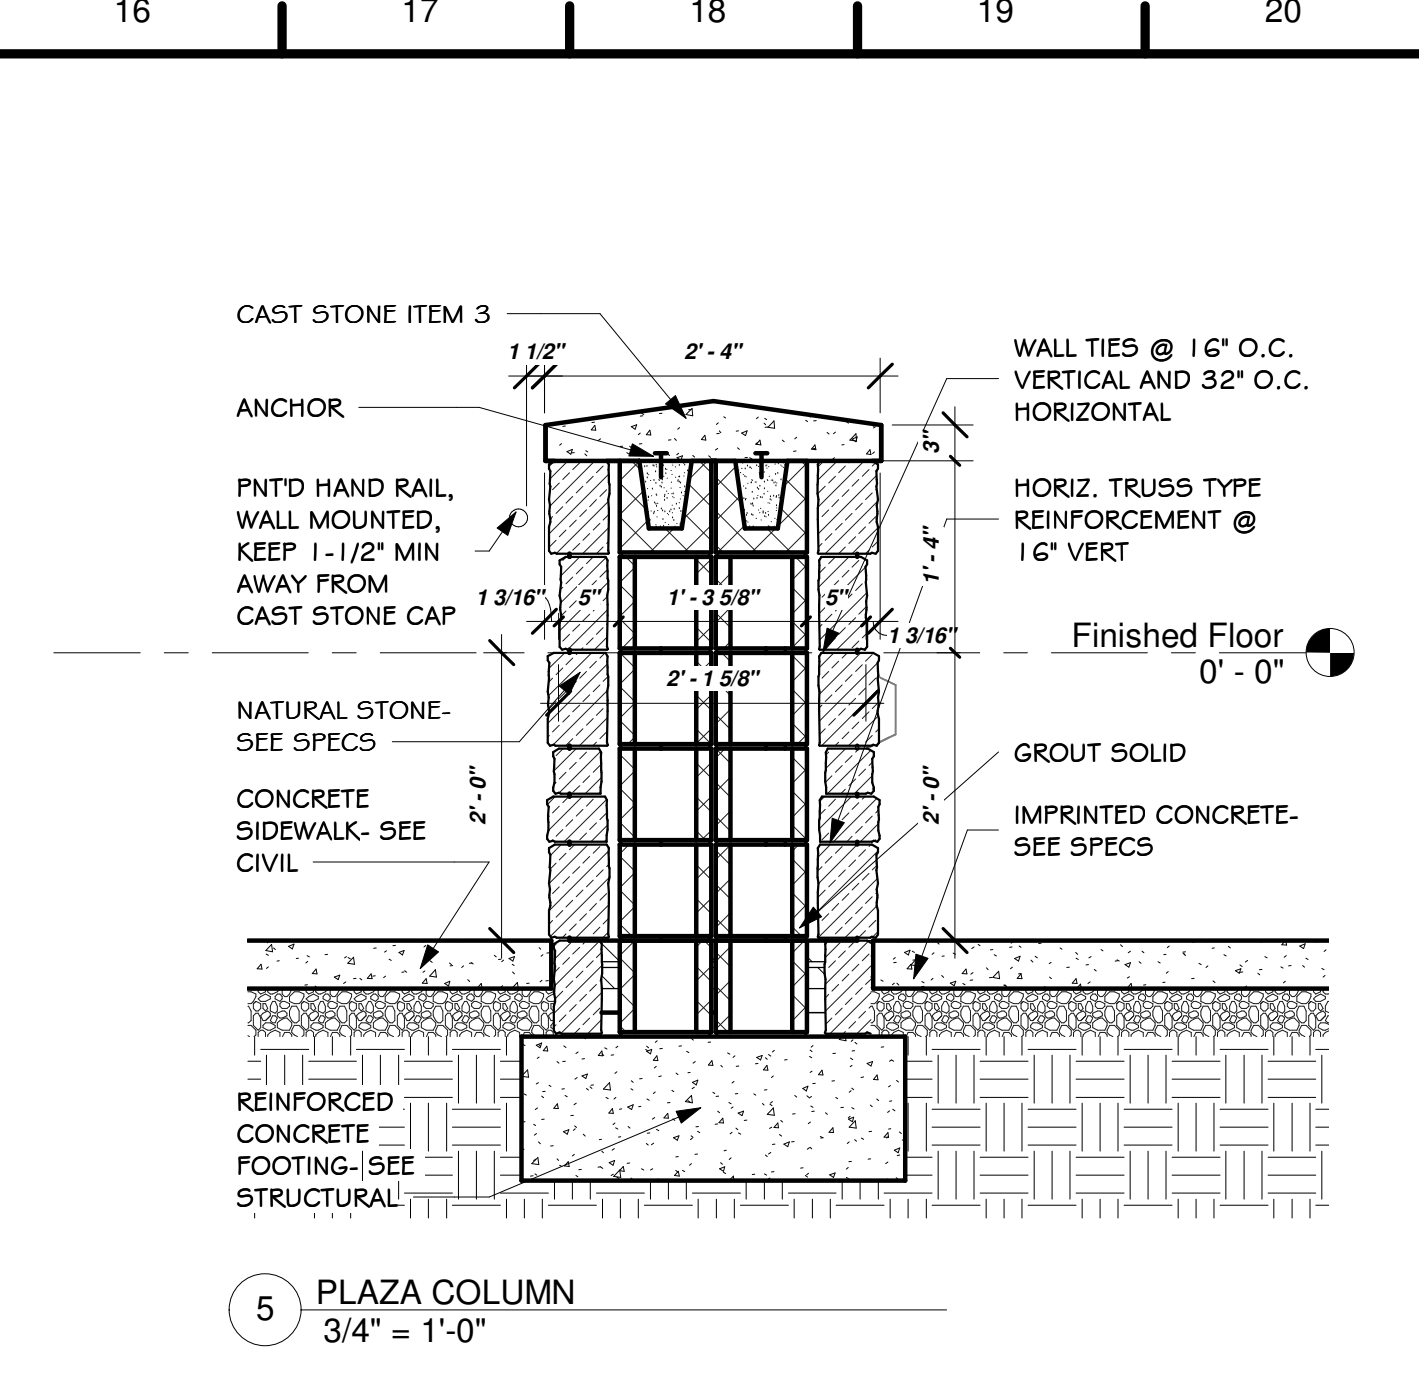


5 PLAZA COLUMN
3/4" = 1'-0"

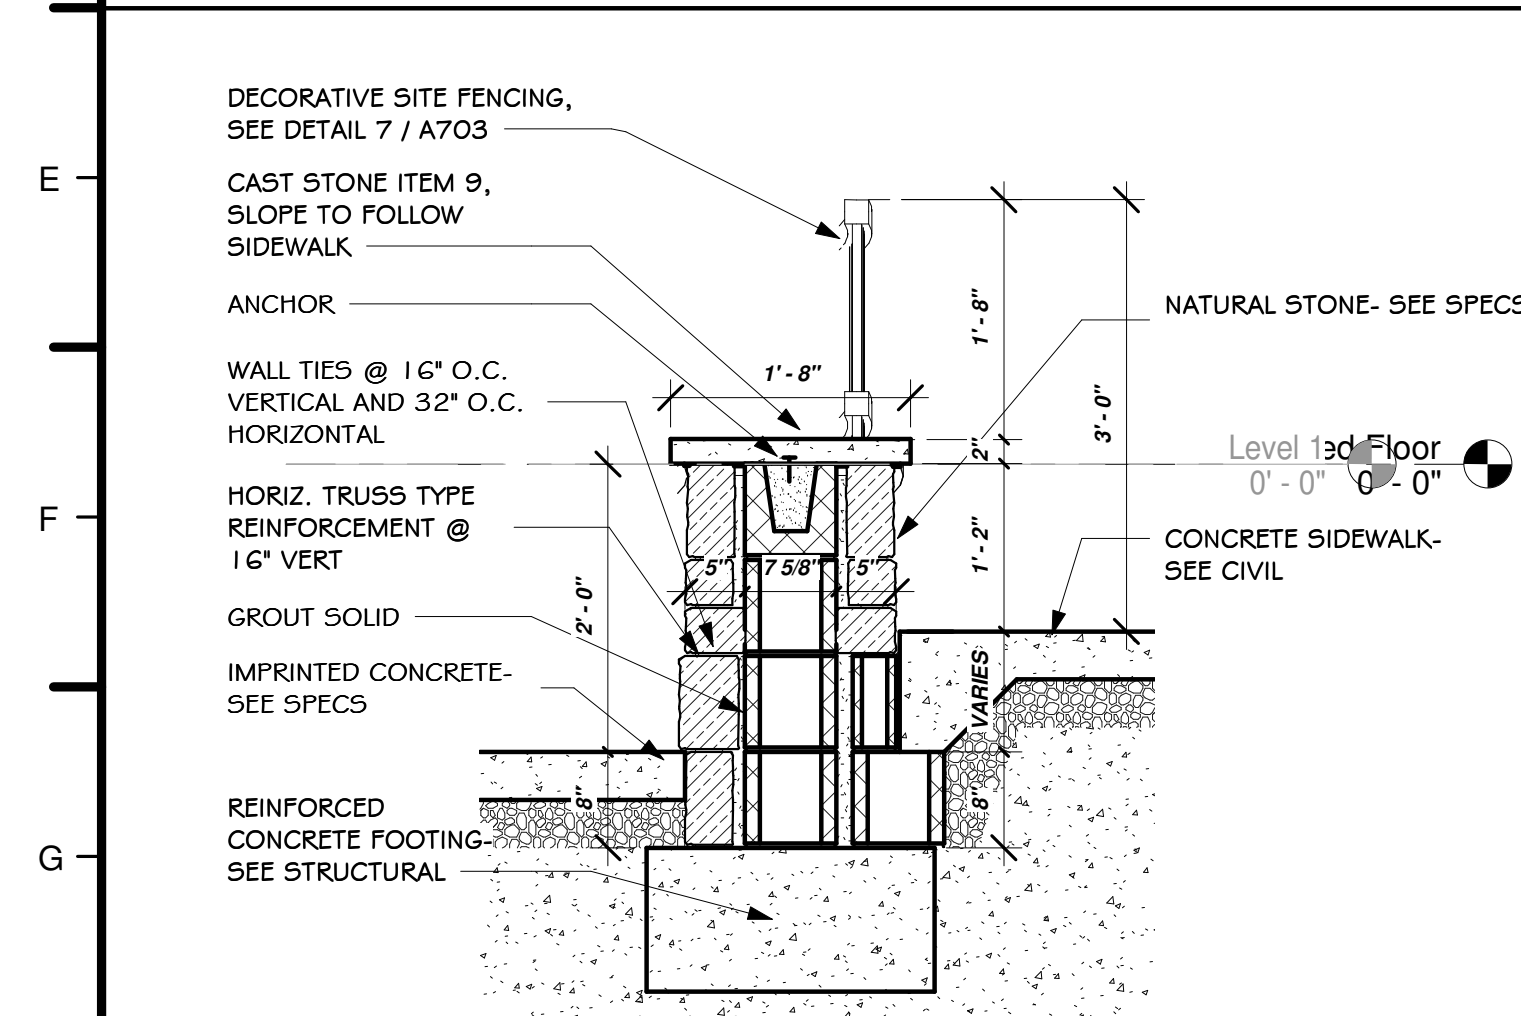


1 SITE WALL 1
3/4" = 1'-0"

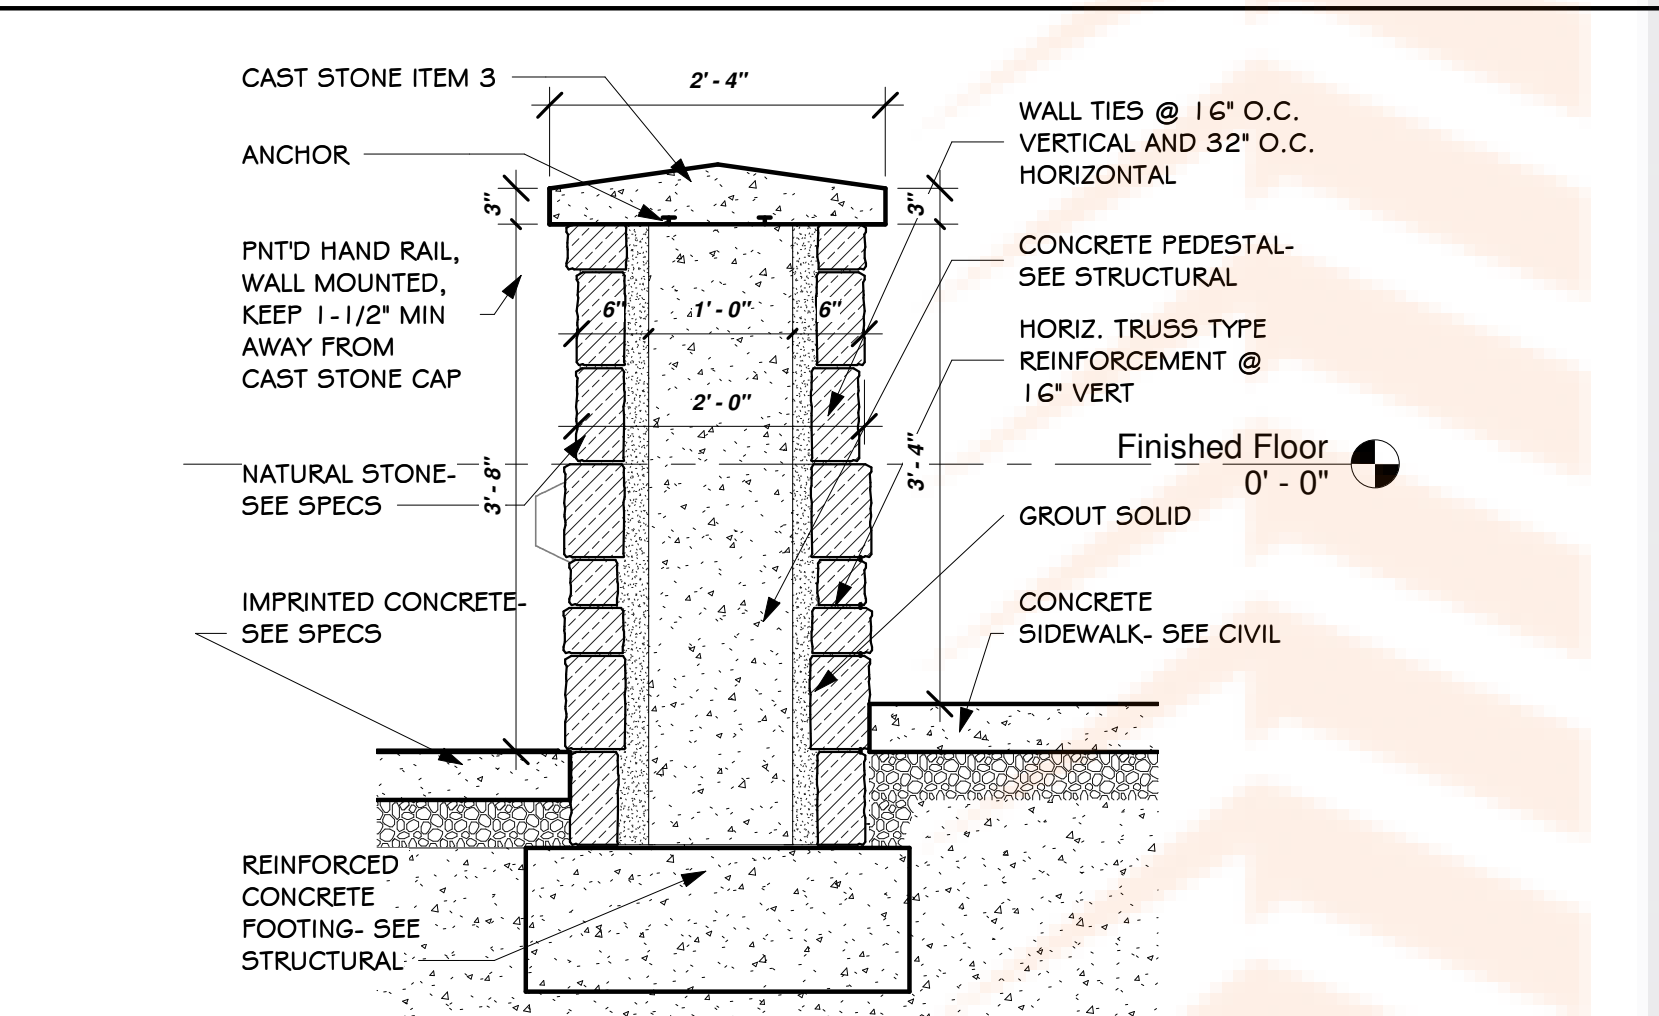


2 SITE WALL 2
3/4" = 1'-0"

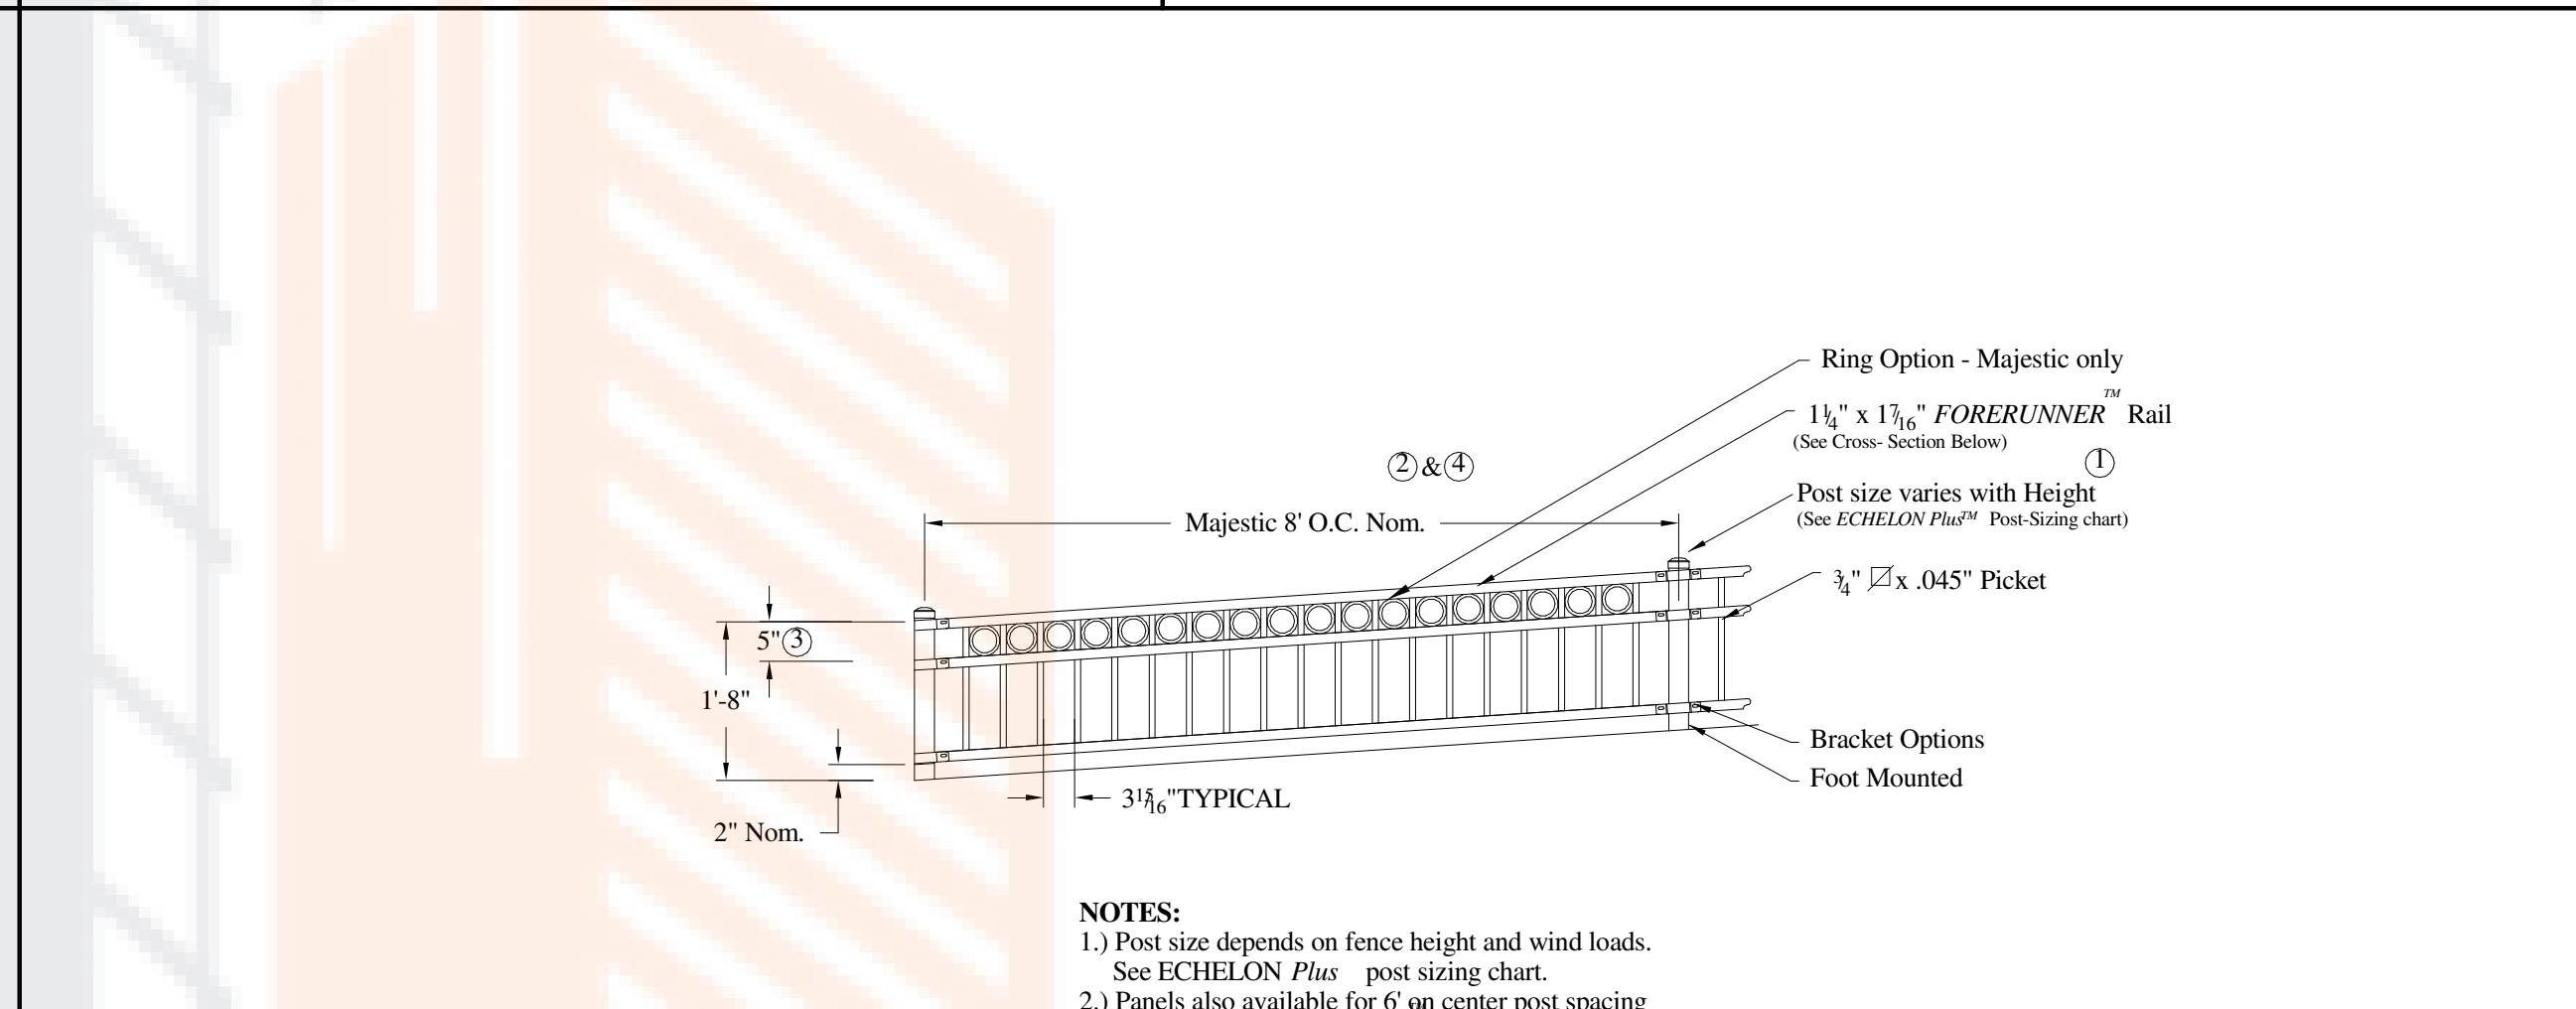


7 MEMORIAL WALL FENCE
1/2" = 1'-0"

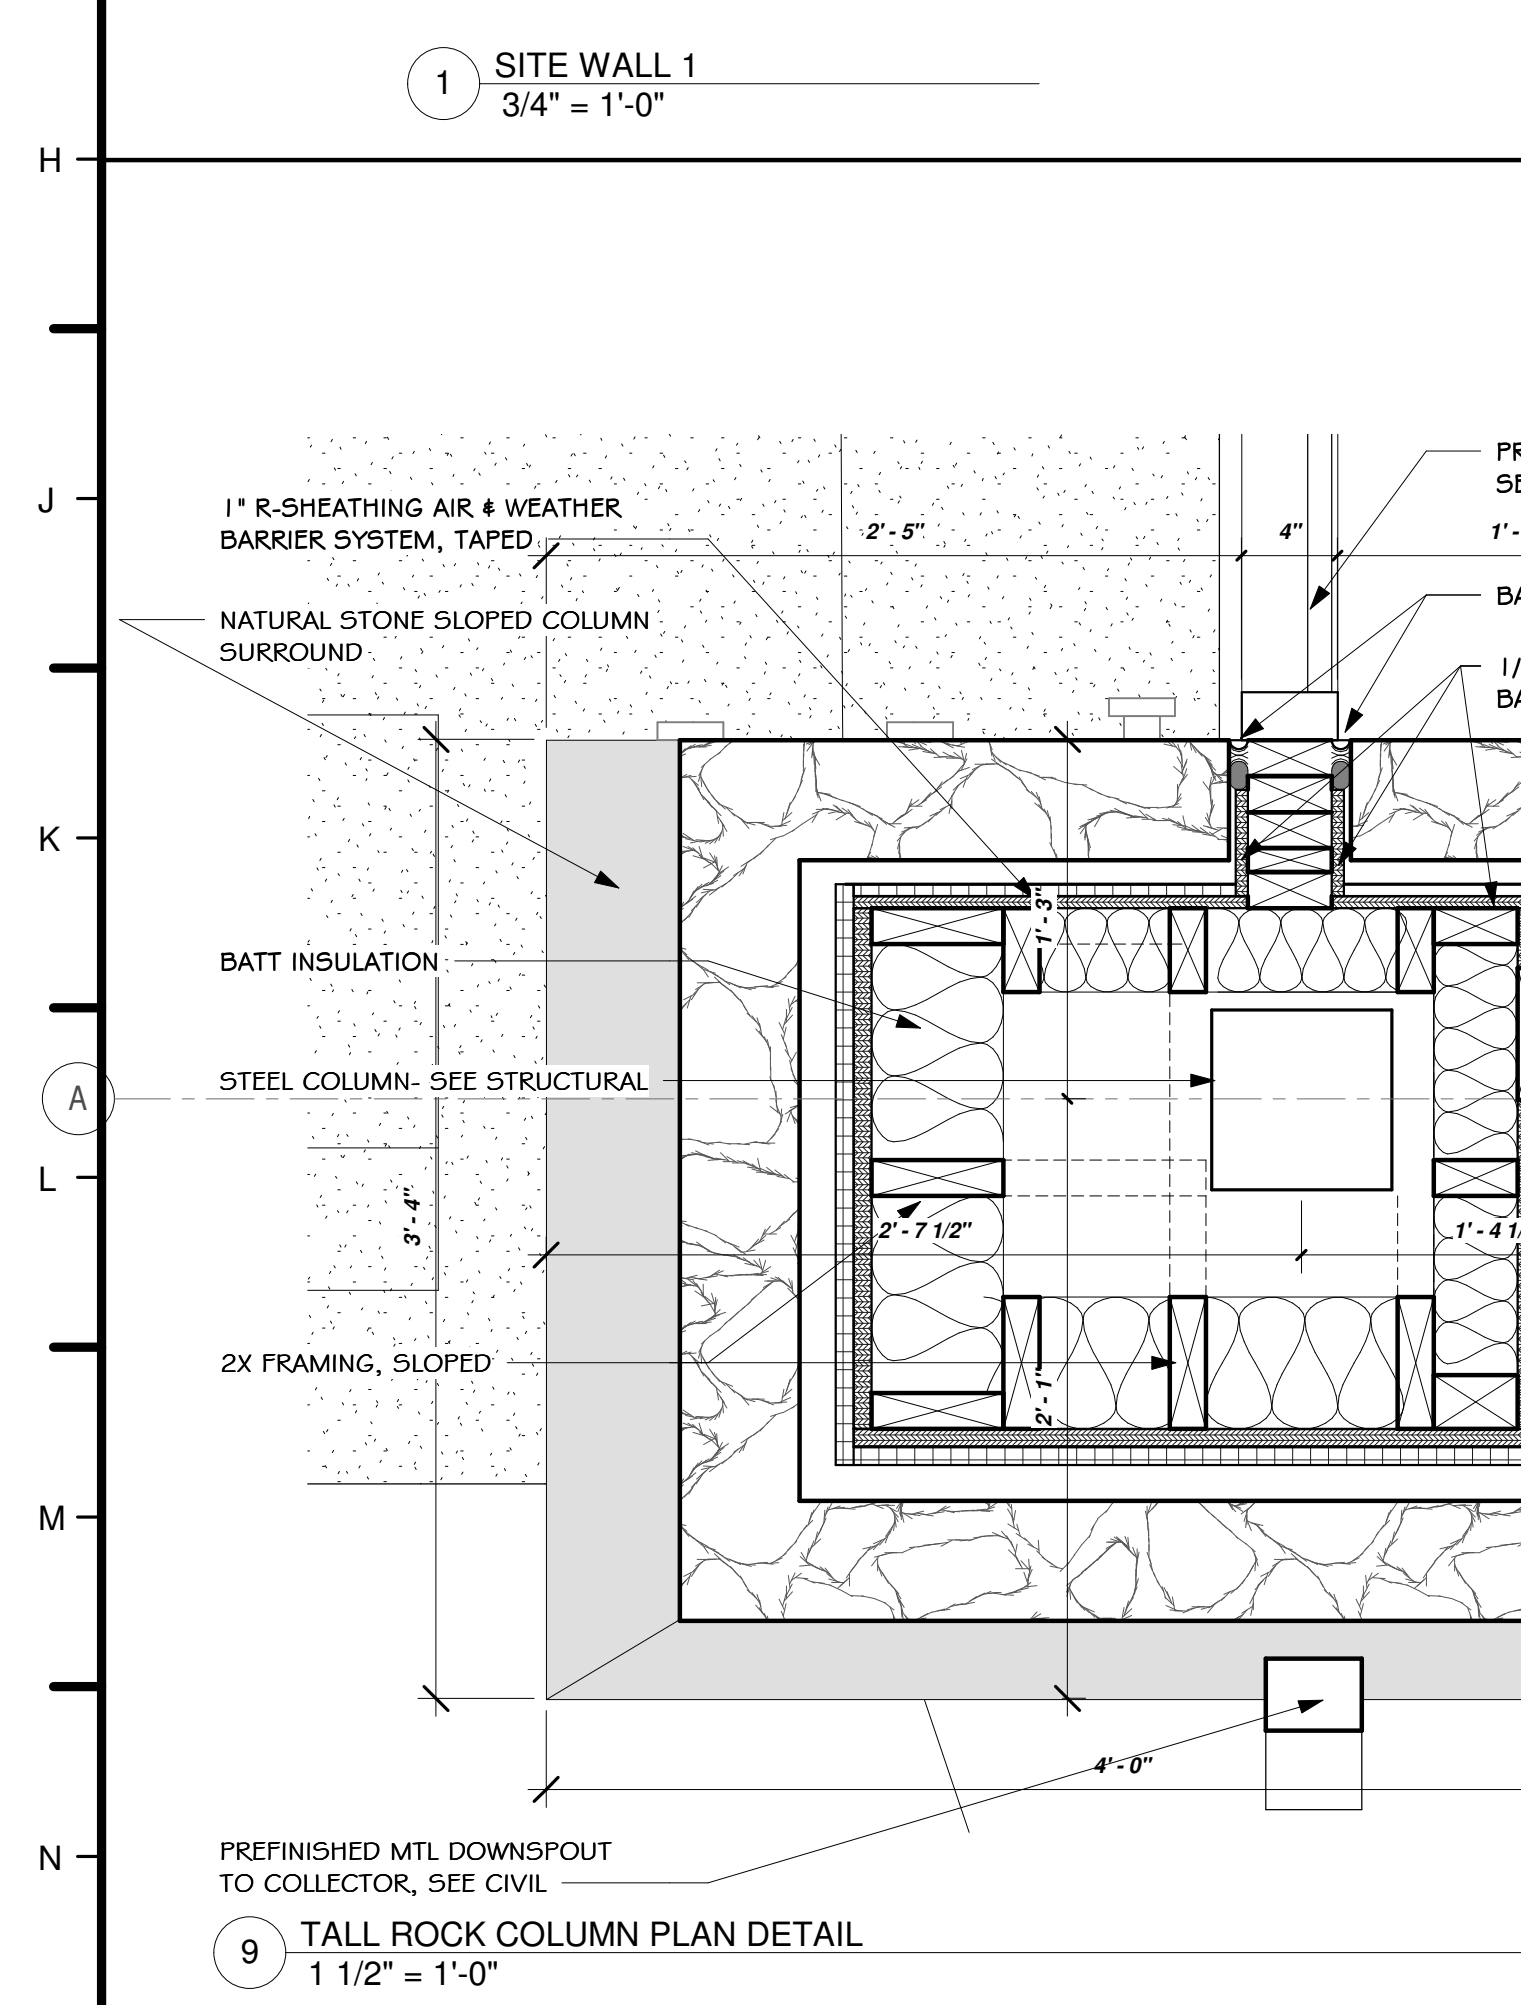

9 TALL ROCK COLUMN PLAN DETAIL
1 1/2" = 1'-0"

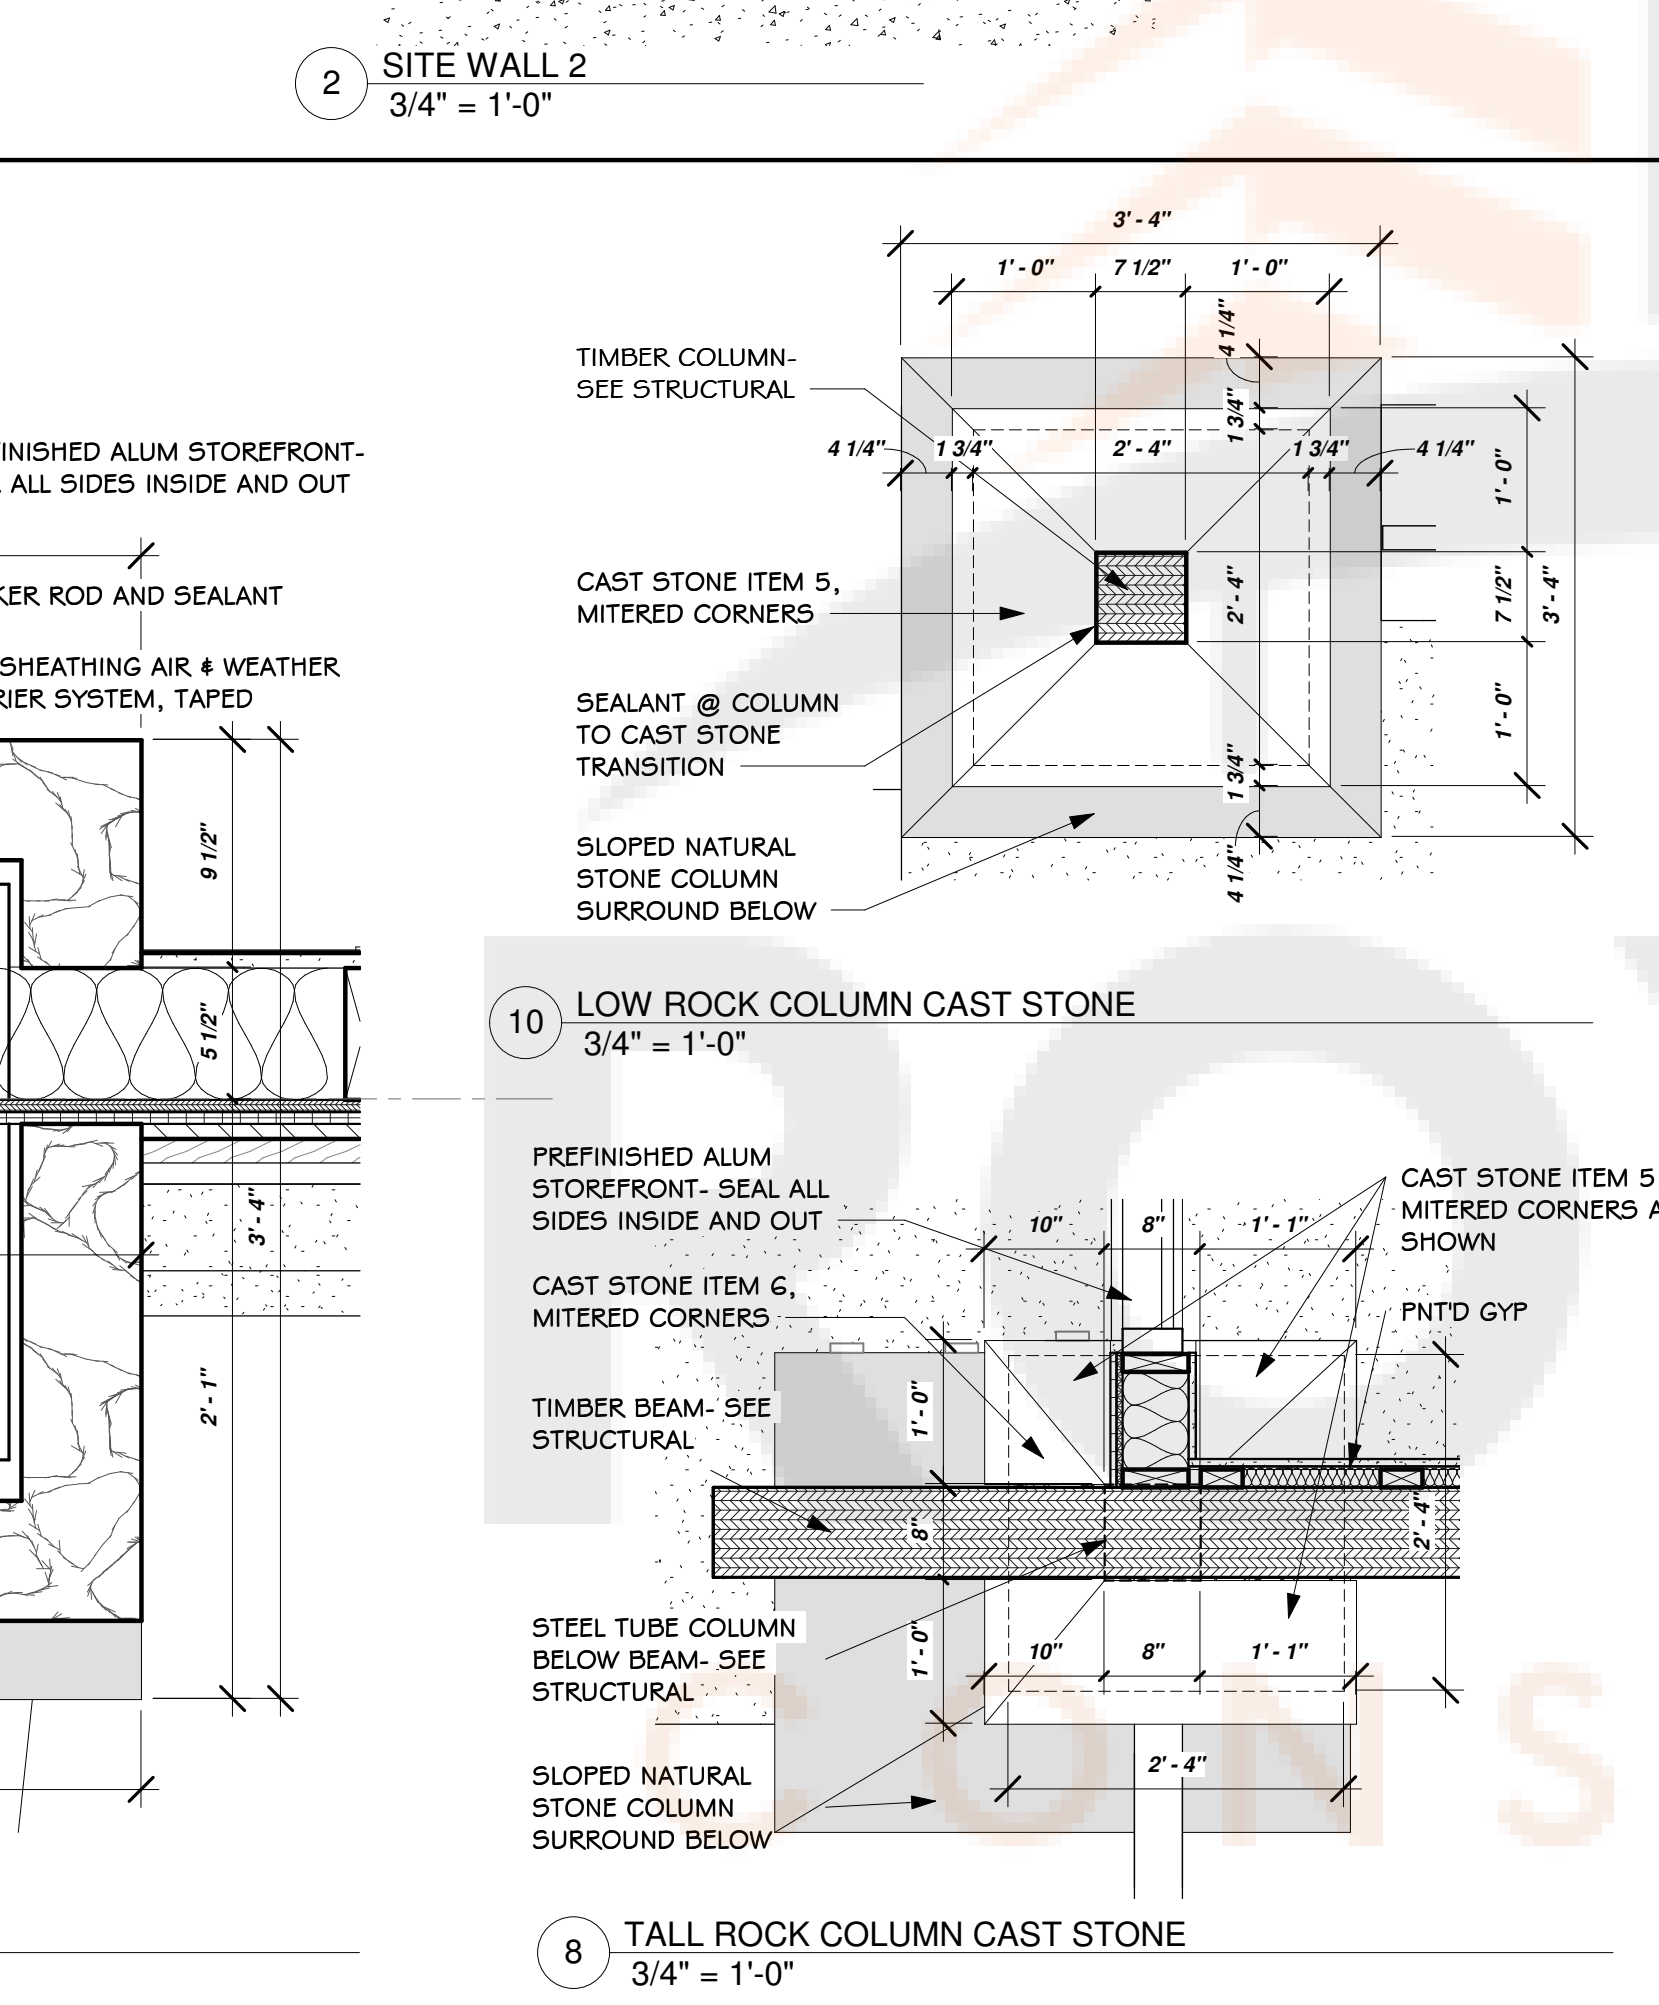


8 TALL ROCK COLUMN CAST STONE
3/4" = 1'-0"

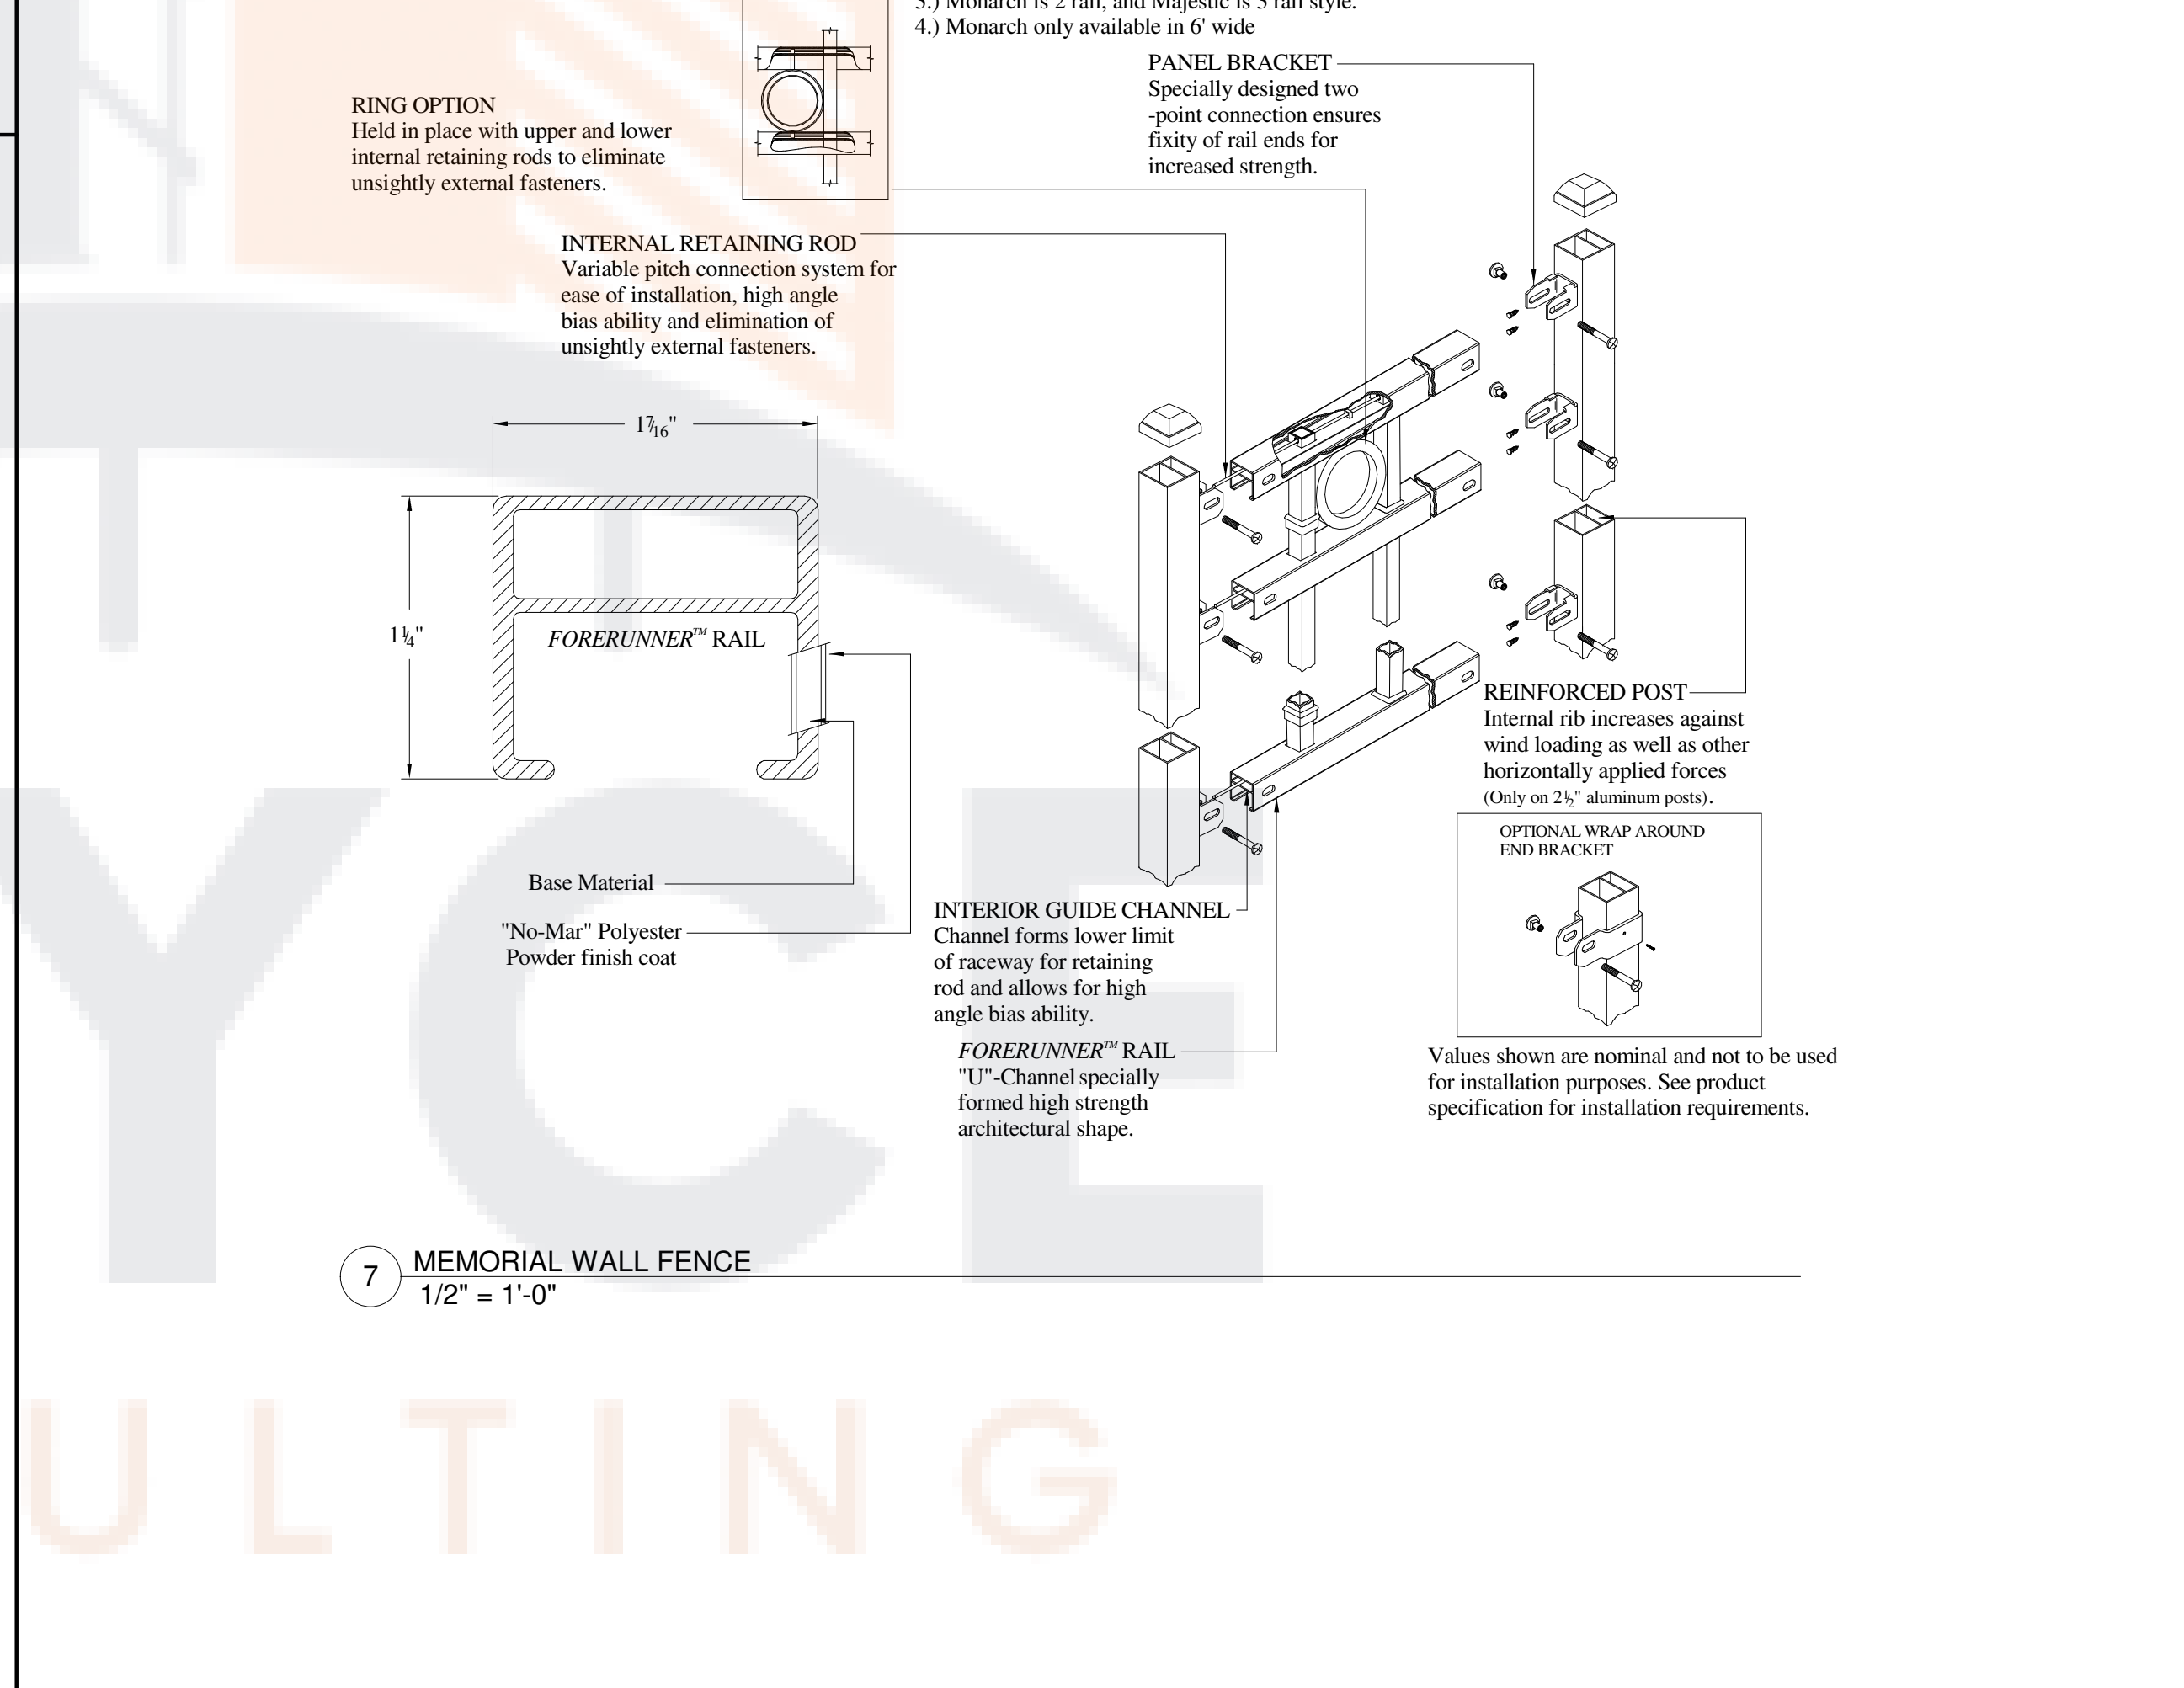

10 LOW ROCK COLUMN CAST STONE
3/4" = 1'-0"

General Notes

**NORTH LITTLE ROCK
FIRE DEPARTMENT
STATION 8**

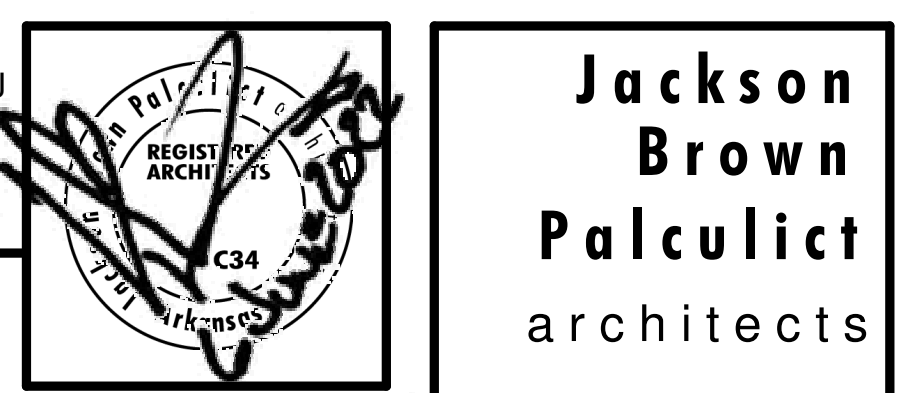

Date
6/6/22
Revisions



JOB NUMBER 2203

Sheet Title
**SITE & FENCING
DETAILS**

Sheet Number
A703


Copyright 2019 JBP

12921 Cantrell Road, Suite 201
Little Rock, AR 72223
501.664.8700 tel
501.664.5189 fax
www.jbparchitects.com

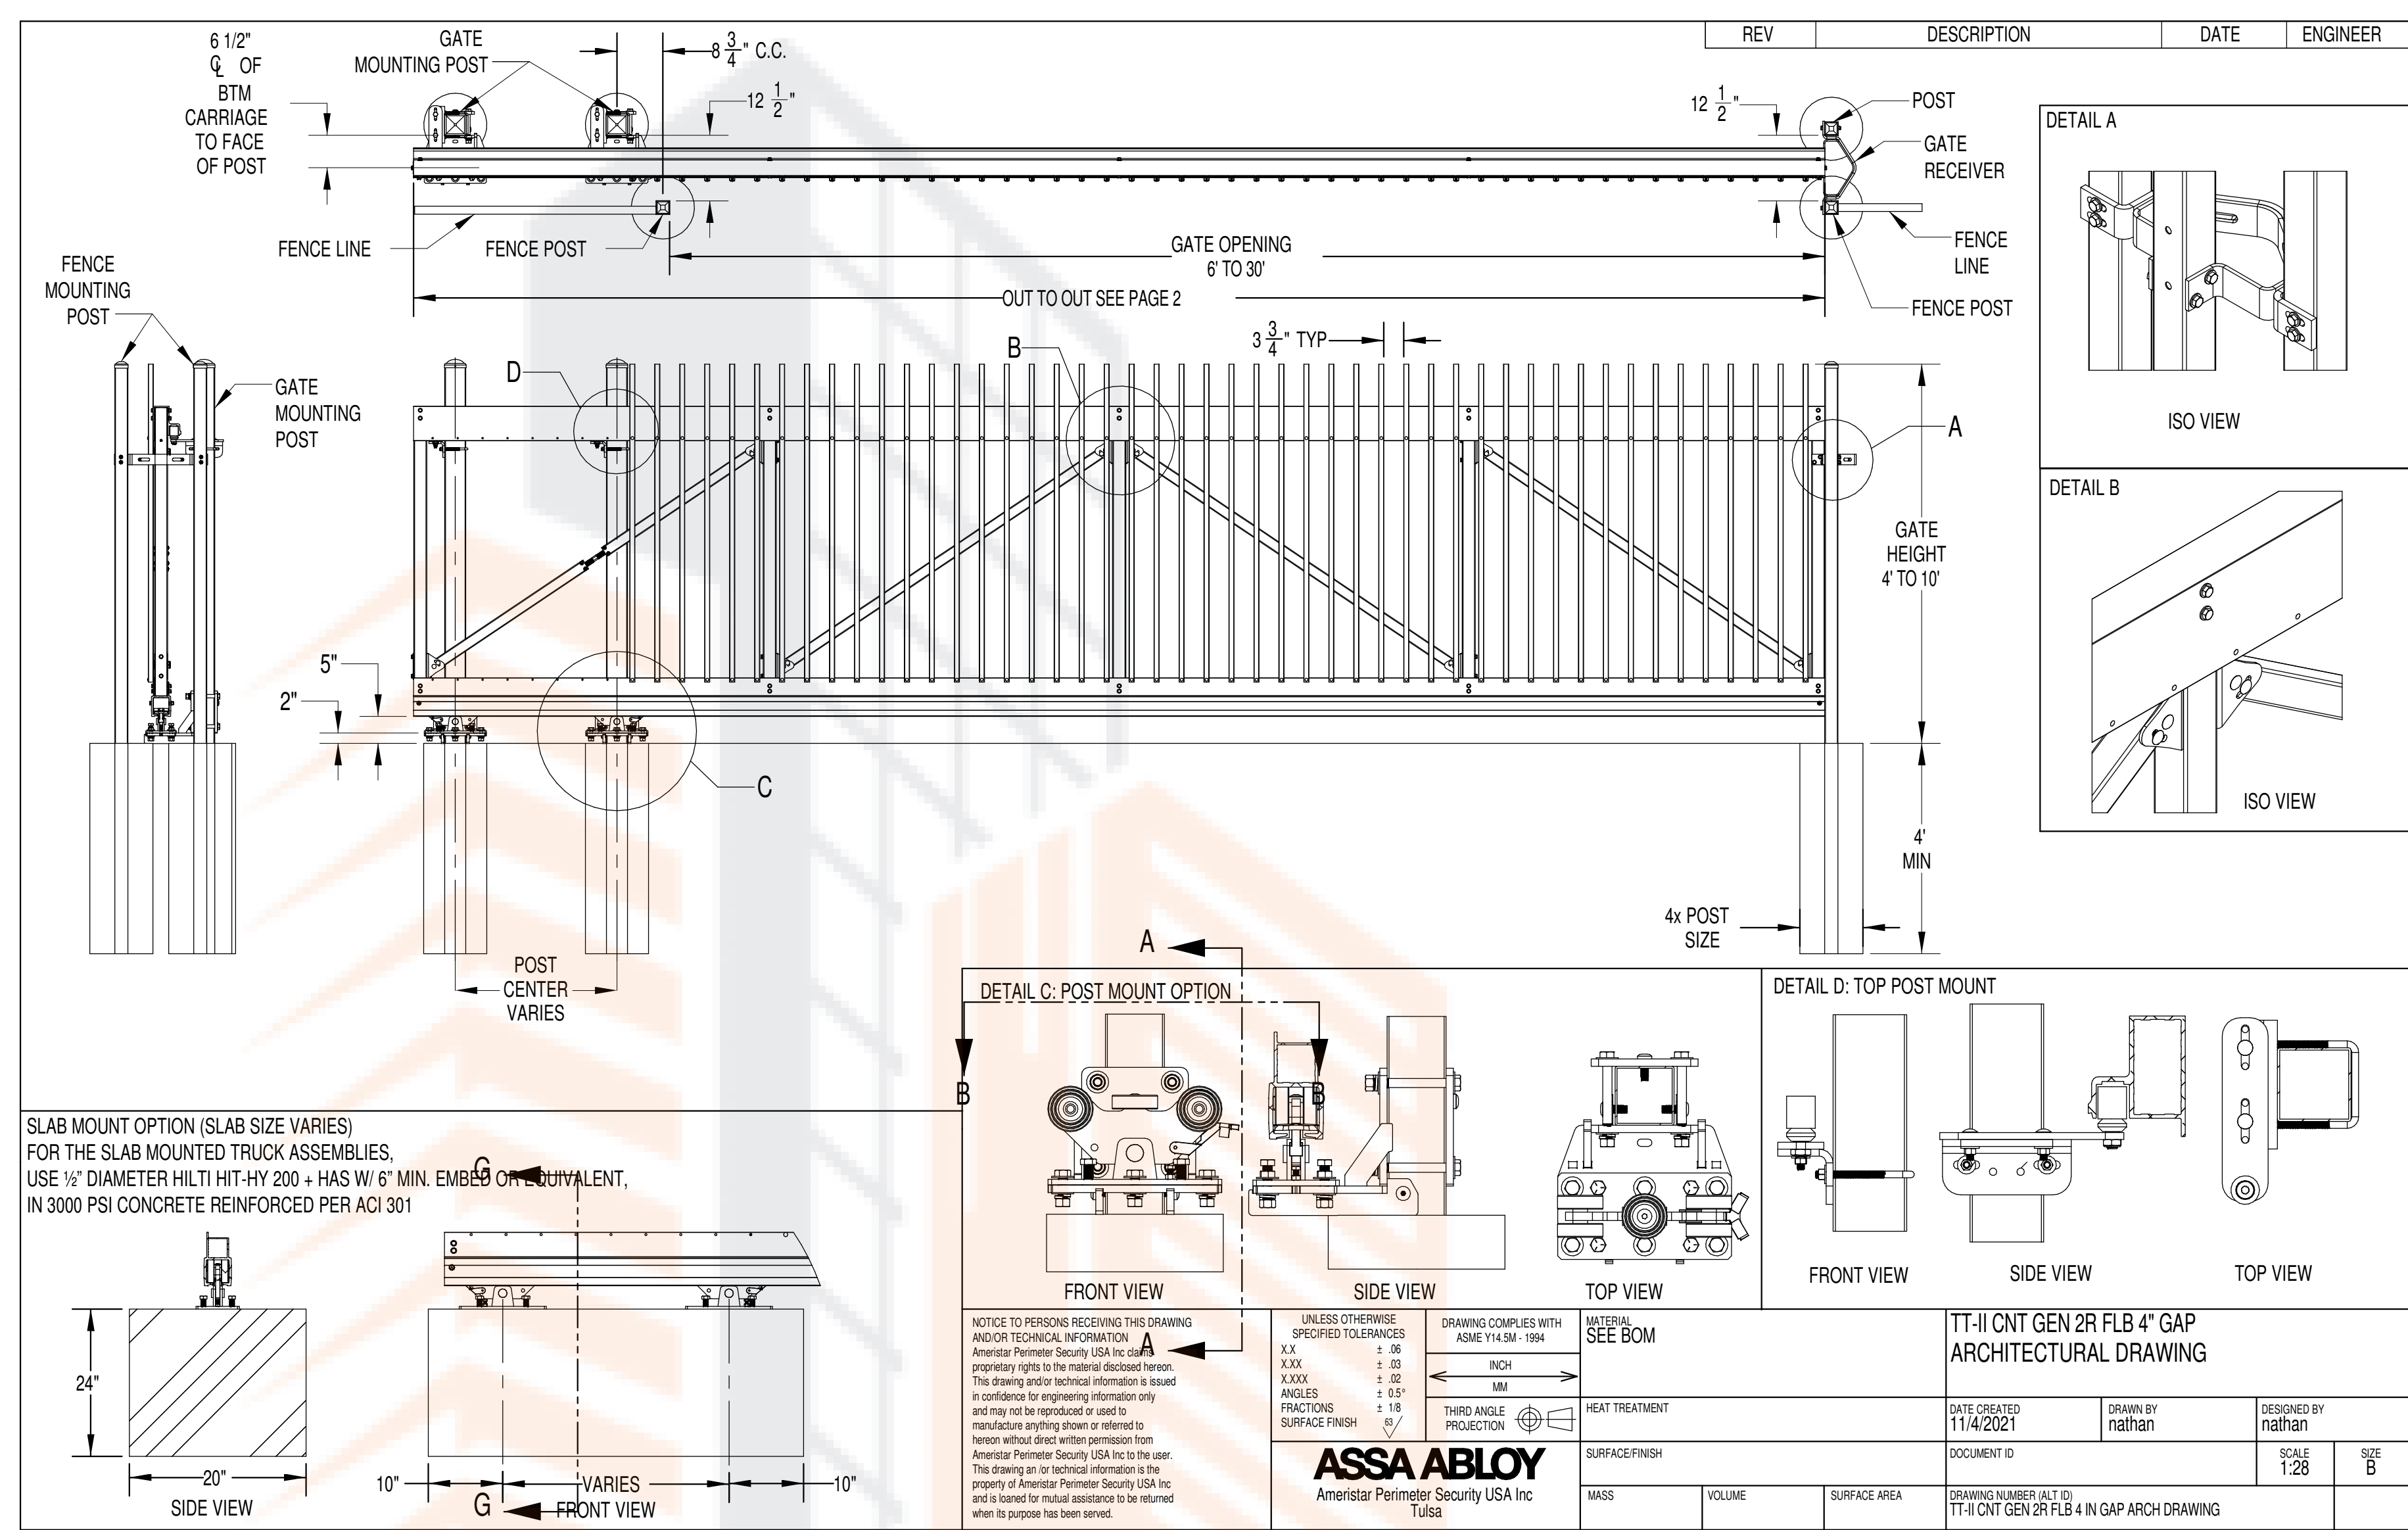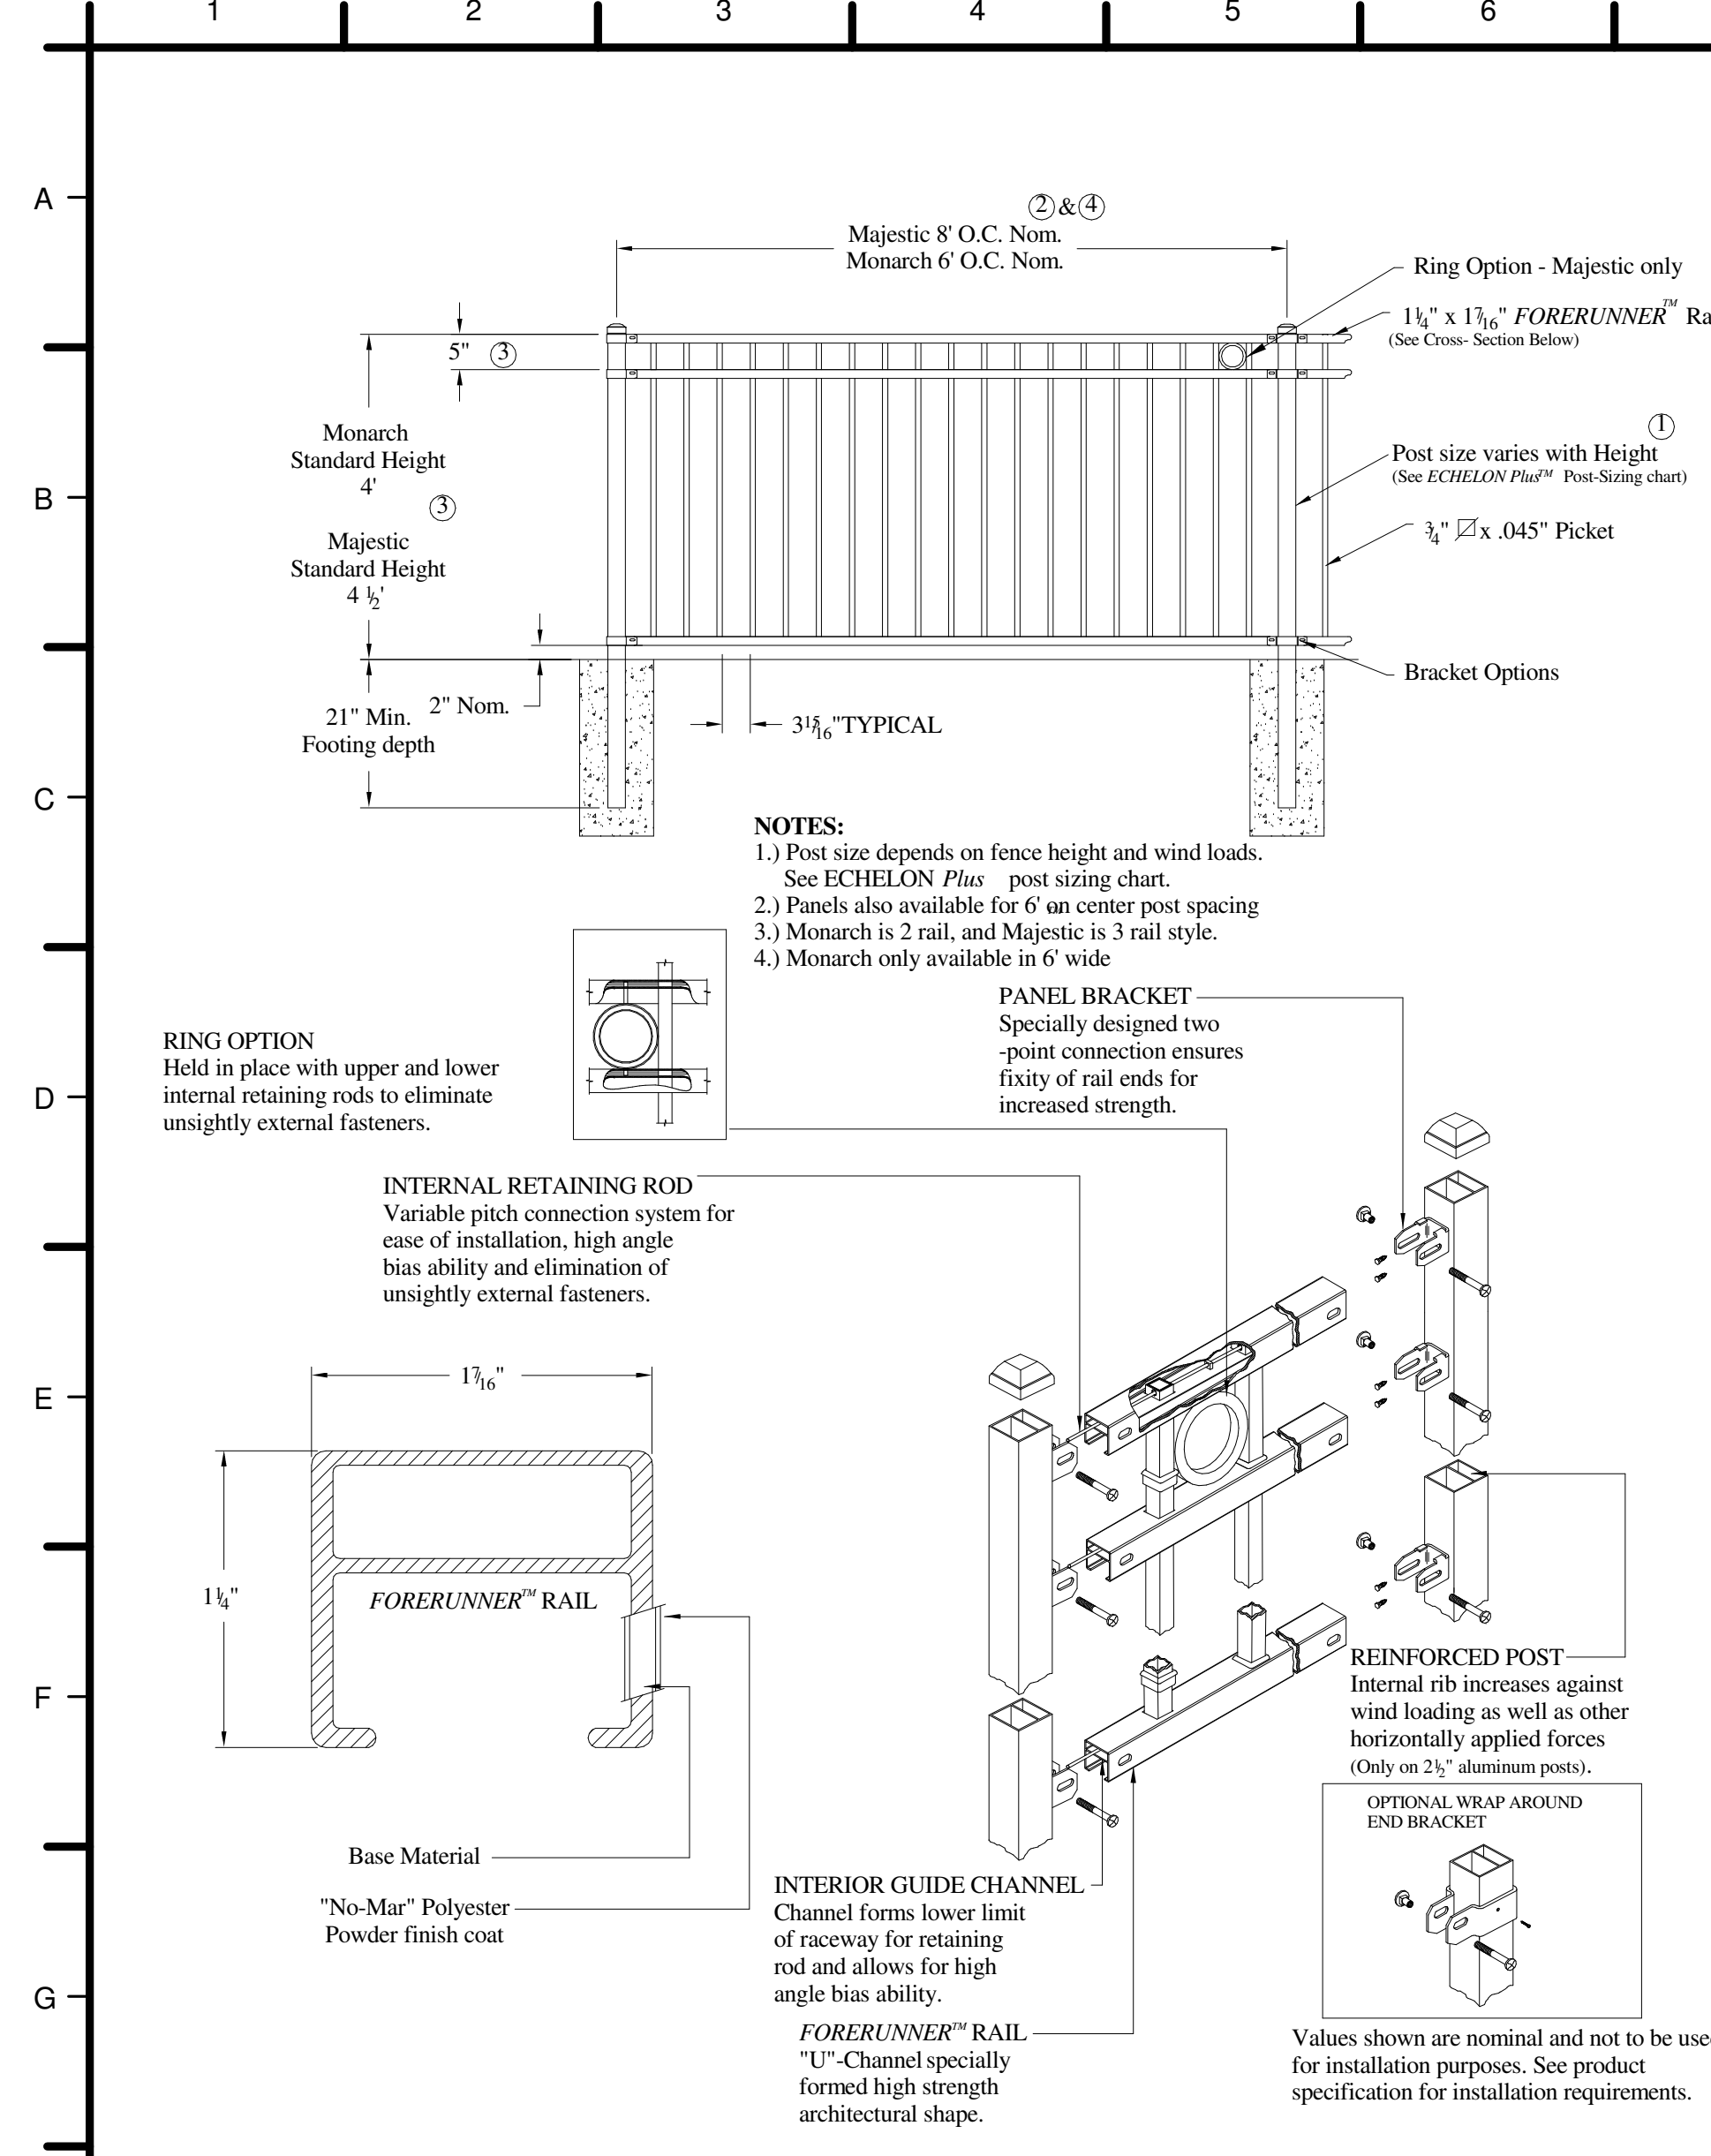

1 SITE FENCING
 1/2" = 1'-0"


2 TRAFFIC GATE
 1/2" = 1'-0"

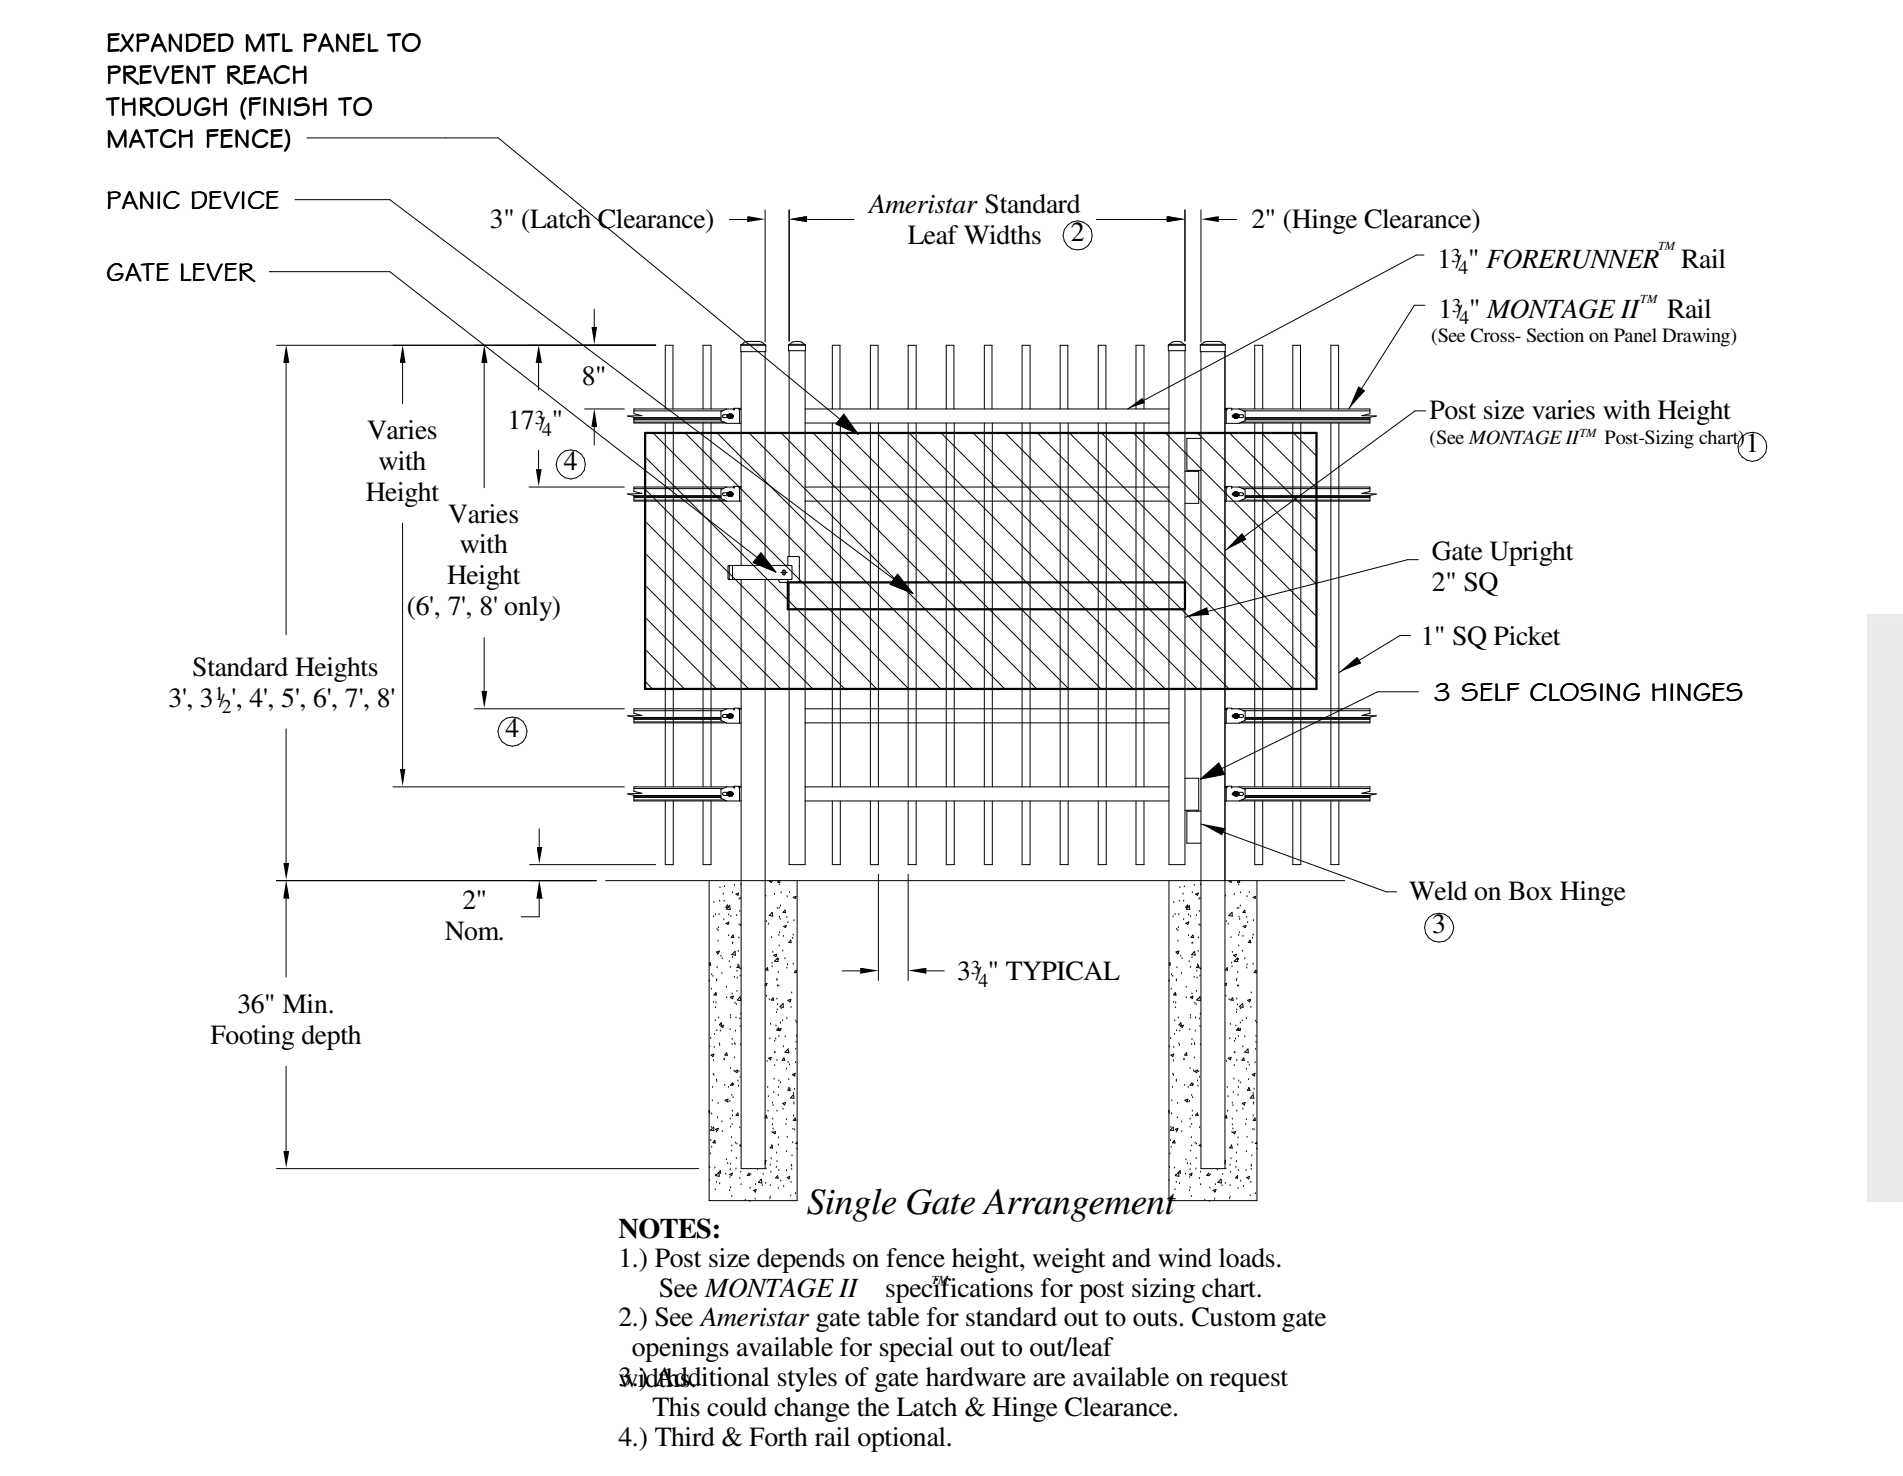

3 MAN GATE
 1/2" = 1'-0"

General Notes

**NORTH LITTLE ROCK
 FIRE DEPARTMENT
 STATION 8**

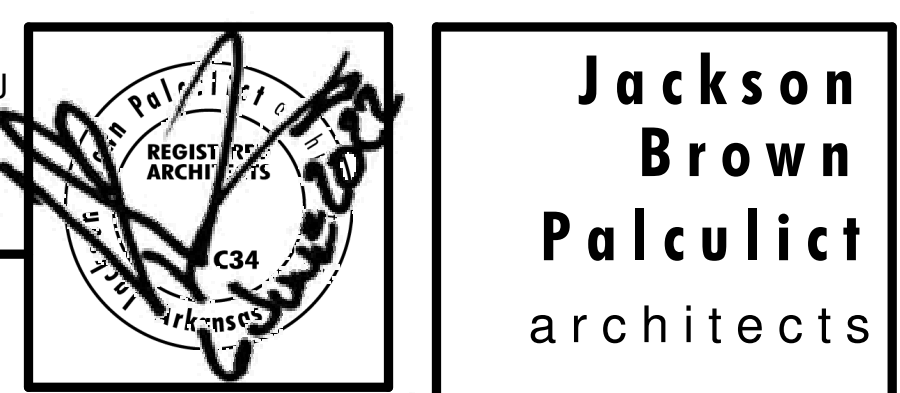

Date
6/6/22
 Revisions

JOB NUMBER 2203

Sheet Title
FENCING DETAILS

Sheet Number
A704

Copyright 2019 JBP

12921 Cantrell Road, Suite 201
 Little Rock, AR 72223
 501.664.8700 tel
 501.664.5189 fax
 www.jbpaarchitects.com

